


- | | |
|---|------------------------------------|
|  | PROPOSED PRIVATE SW DRAINAGE |
|  | PROPOSED SW ACCESS CHAMBER |
|  | PROPOSED SW PPIC |
|  | PROPOSED RAINWATER PIPE |
|  | PROPOSED PRIVATE ROAD GULLY |
|  | PROPOSED DOOR THRESHOLD ACO |
|  | PROPOSED PRIVATE SW FILTER DRAIN |
|  | PROPOSED ATTENUATION TANK |
|  | PROPOSED PRIVATE CWS DRAINAGE |
|  | PROPOSED CWS ACCESS CHAMBER |
|  | PROPOSED PRIVATE FW DRAIN |
|  | EXISTING UU COMBINED SEWER |
|  | PROPOSED VENT PIPES / VENTED COVER |
| YG = | YARD GULLY |
| RG = | ROAD GULLY |
| CO = | CHANNEL OUTLET |
|  | ABANDONED PIPE |
|  | ROADDRAIN |
|  | MULTIDRAIN |
|  | ASSUMED LIMIT OF WORKS |
|  | SITE BOUNDARY |

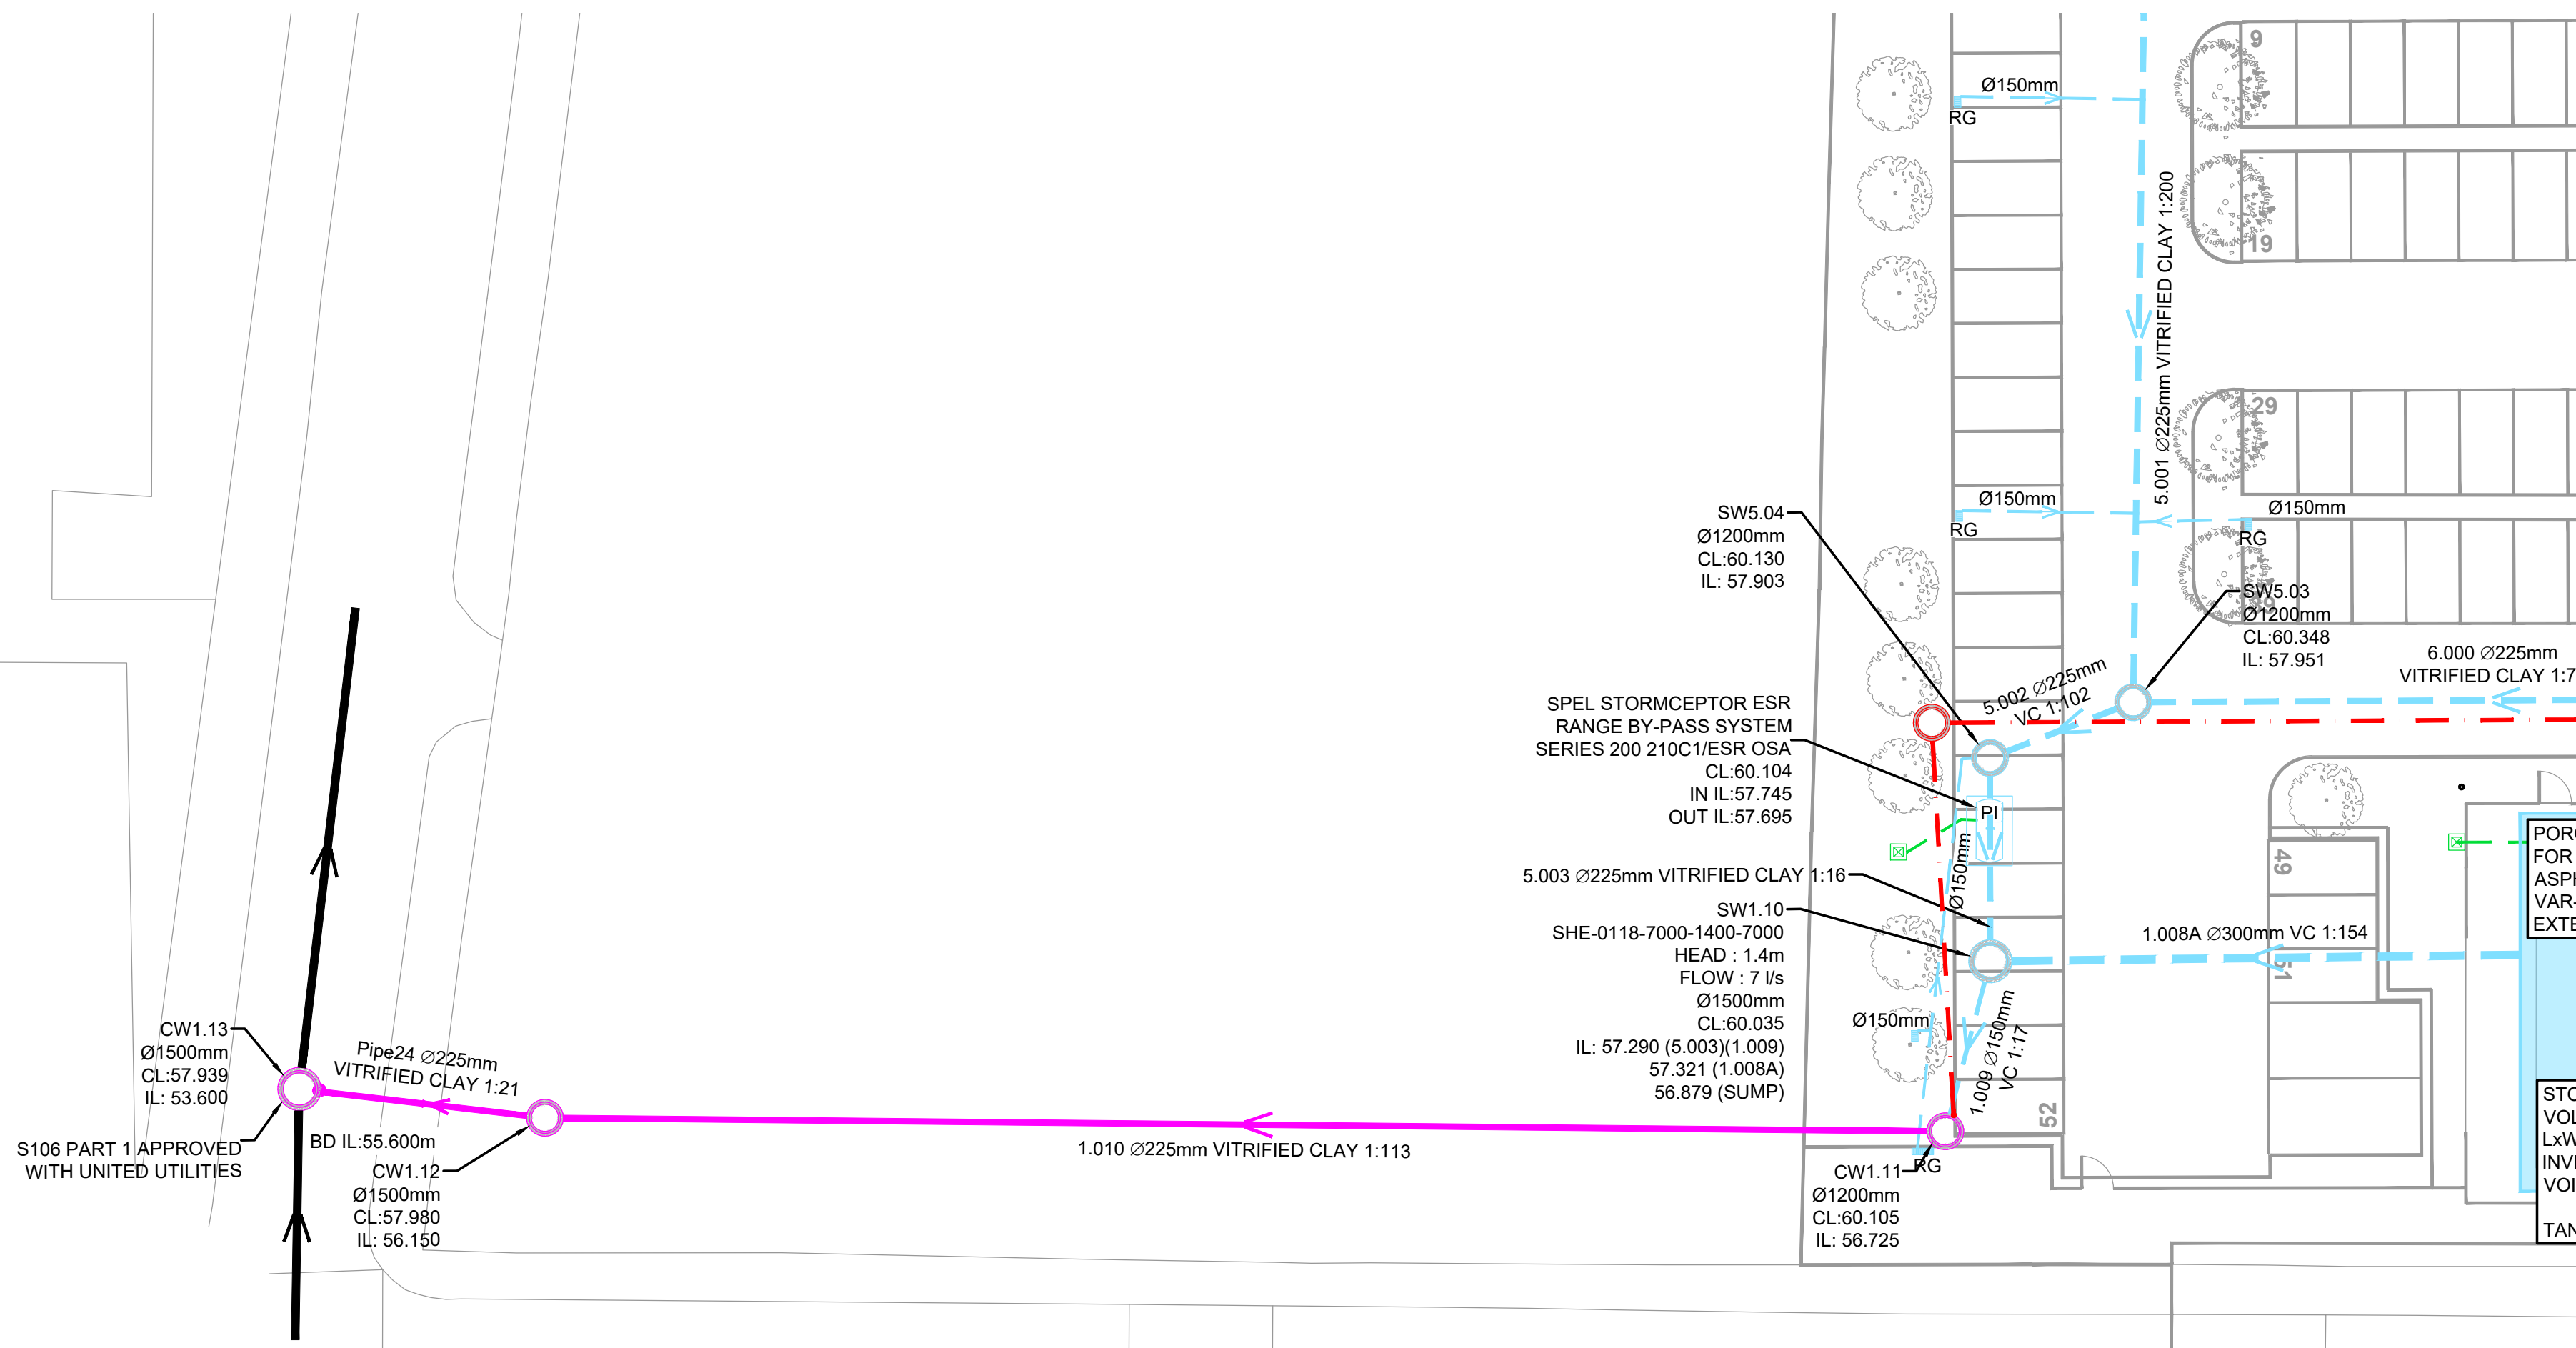

DISCLAIMER NOTES:

- THIS DOCUMENT IS COPYRIGHT OF THE ORIGINATOR AND MUST BE TREATED AS CONFIDENTIAL
- THIS DOCUMENT MUST NOT BE ALTERED, REPRODUCED OR DISTRIBUTED WITHOUT PRIOR WRITTEN CONSENT OF THE ORIGINATOR
- THIS DOCUMENT MUST NOT BE REPRODUCED - THE ORIGINATOR ACCEPTS NO RESPONSIBILITY FOR ANY DISCREPANCIES ARISING AS A RESULT OF THE ORIGINATORS INFORMATION BEING ALTERED BY OTHERS
 - ANY DISCREPANCY MUST BE REPORTED TO THE ORIGINATOR
 - DO NOT SCALE THIS DOCUMENT - USE FIGURED DIMENSIONS ONLY
 - ALL DIMENSIONS MUST BE CHECKED ON SITE PRIOR TO COMMENCEMENT OF ANY RELATED WORKS
- THIS DOCUMENT MUST BE READ IN CONJUNCTION WITH ALL SUPPORTING DOCUMENTS PRODUCED BY THE ORIGINATOR AND OTHER PROJECT DISCIPLINES
- THE ORIGINATOR ACCEPTS NO RESPONSIBILITY FOR THE ACCURACY OF BACKGROUND INFORMATION PRODUCED BY THIRD PARTIES - THIS MUST BE TREATED AS INDICATIVE ONLY
- USERS OF THIS DOCUMENT ARE RESPONSIBLE FOR CHECKING WHICH REVISION IS CURRENT
- THE DOCUMENT STATUS "INFORMATION" OR "PRELIMINARY" INDICATES THAT THIS DRAWING IS FOR REFERENCE PURPOSES ONLY - THE ORIGINATOR WILL ACCEPT NO RESPONSIBILITY FOR THE COMPLETENESS OF INFORMATION UNDER THIS STATUS
- THE DOCUMENT STATUS "RECORD" OR "AS BUILT" HAS BEEN PREPARED, IN PART, BASED UPON INFORMATION FROM VARIOUS OTHERS. WHILE THIS INFORMATION IS BELIEVED TO BE RELIABLE, THE ORIGINATOR ASSUMES NO RESPONSIBILITY FOR THE ACCURACY OF THIS "RECORD" OR "AS BUILT" DOCUMENT OR FOR ANY ERRORS OR OMISSIONS THAT MAY HAVE BEEN INCORPORATED INTO IT AS A RESULT OF INCORRECT INFORMATION PROVIDED TO THE ORIGINATOR. THOSE RELYING ON THE "RECORD" OR "AS BUILT" DOCUMENT ARE ADVISED TO OBTAIN INDEPENDENT VERIFICATION OF ITS ACCURACY

CONSTRUCTION RECORD DRAWING

Note:
The information shown on this Construction Record drawing is based on the latest issued Construction drawings which have been modified as necessary with information supplied by the Contractor to incorporate changes made during construction. Information obtained from third parties has not been verified by Ridge and Partners LLP and may not be wholly accurate. Any party seeking to use this drawing must first verify its fitness for the intended purpose with suitable site inspections/investigations as deemed appropriate.

ALL THRESHOLD DRAINS TO BE ACC
THRESHOLD

ALL SVP AND RWP DROP LOCATIONS
TO BE CONFIRMED BY OTHERS
(M&E STAGE 5 DESIGN T.B.C.)

ALL CONNECTIONS TO HAVE ABOVE
GROUND RODDABLE ACCESS

ALL SW PIPEWORK Ø100mm U.N.O.

No	DATE	DRAWN	REV'D ENG.	AMENDMENT

C07	29.09.25	AP	AM	CONSTRUCTION RECORD
C06	14.08.24	JF	PB	UPDATED INLINE WITH SHEET 1
C05	01.08.24	JF	PB	CARPARK LEVELS AMENDED TO SUIT NEW LAYOUT
C04	13.05.24	JF	PB	CARPARK LEVELS REVERTED TO PREVIOUS REVISION
No	DATE	DRAWN	REV'D ENG.	AMENDMENT

C03	22.02.24	JF	PB	CARPARK LEVELS LOWERED - DRAINAGE UPDATED TO SUIT
C02	23.11.23	JF	PB	TANK POSITION UPDATED - LABELS AD
C01	23.10.23	JF	AM	CONSTRUCTION ISSUE
P02	08.09.23	JF	PB	STAGE 4 ISSUE
P01	25.08.23	JF	PB	STAGE 4 ISSUE
No	DATE	DRAWN	REV'D ENG.	AMENDMENT

STATUS	PURPOSE OF ISSUE
A6	FINAL ISSUE
ED	
COPYRIGHT: The concepts and the information contained in this document are the copyright of Ridge and Partners LLP. Use or copying of the document in whole or in part without written permission of Ridge and Partners LLP constitutes an infringement of copyright.	



CLIENT		ISG	
PROJECT		VARLEY STREET, SEN SCHOOL	
DRAFTER	JF	ENGINEER	PB

TITLE			
PROPOSED COMBINED OUTFALL LAYOUT			
SCALE	SHEET	DRAWING No	REV
1:250	A1	VAR-RDG-XX-XX-DR-C-00502	C07

SAFETY, HEALTH & ENVIRONMENT (SHE) INFORMATION	
In addition to hazards/risks normally associated with the types of work detailed on this drawing, note the following:	
CONSTRUCTION	
1.	UNCHARTED SERVICES MAYBE PRESENT. KNOWN SERVICES ARE SHOWN ON THIS DRAWING.
2.	WORKING OVER EX COAL MINES - COAL AUTHORITY REPORT TO BE USED AND CONTRACTOR TO HAVE SAFE WORK AND GROUND MONITORING METHODS IN PLACE.
MAINTENANCE / CLEANING	
1.	REFER TO
DECOMMISSIONING / DEMOLITION	
1.	REFER TO