
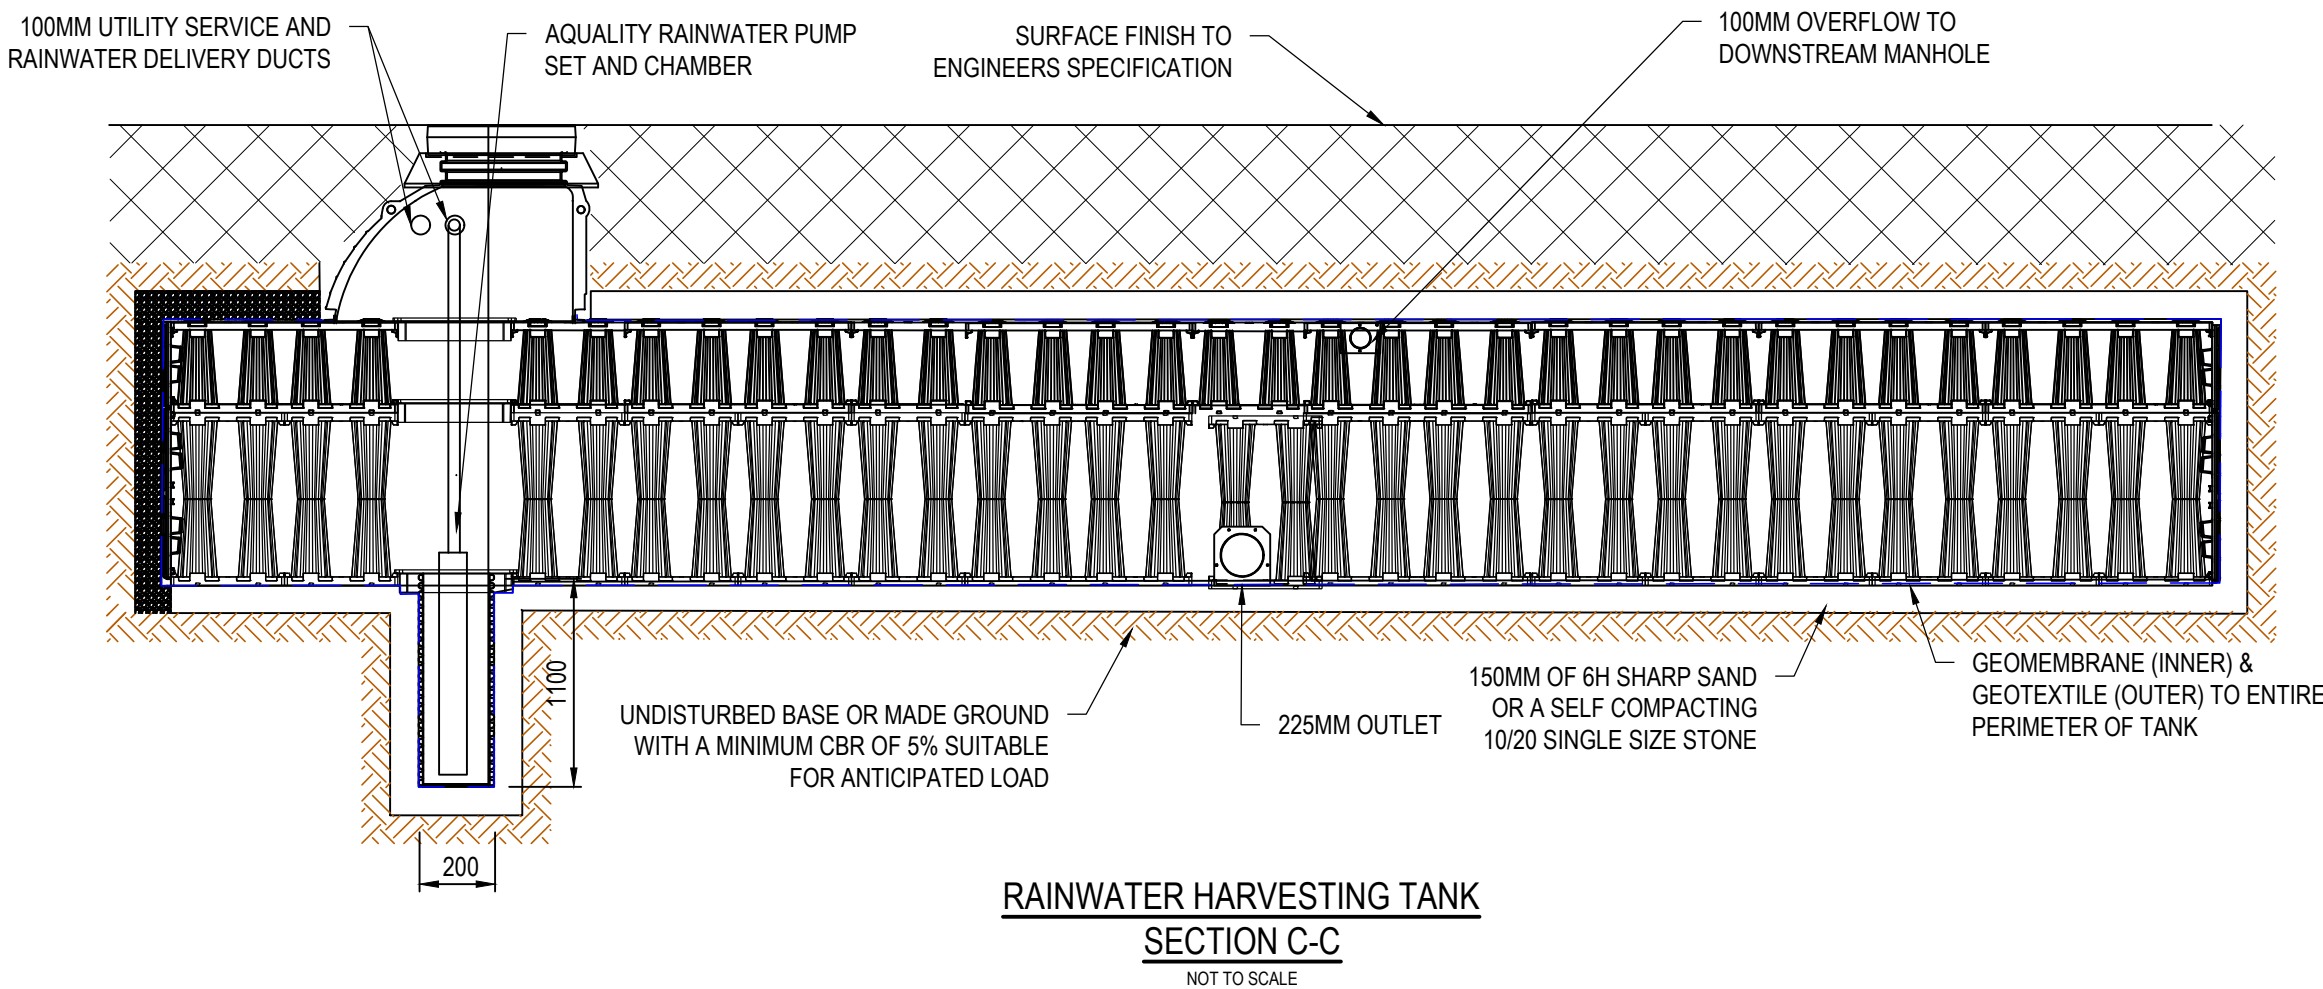
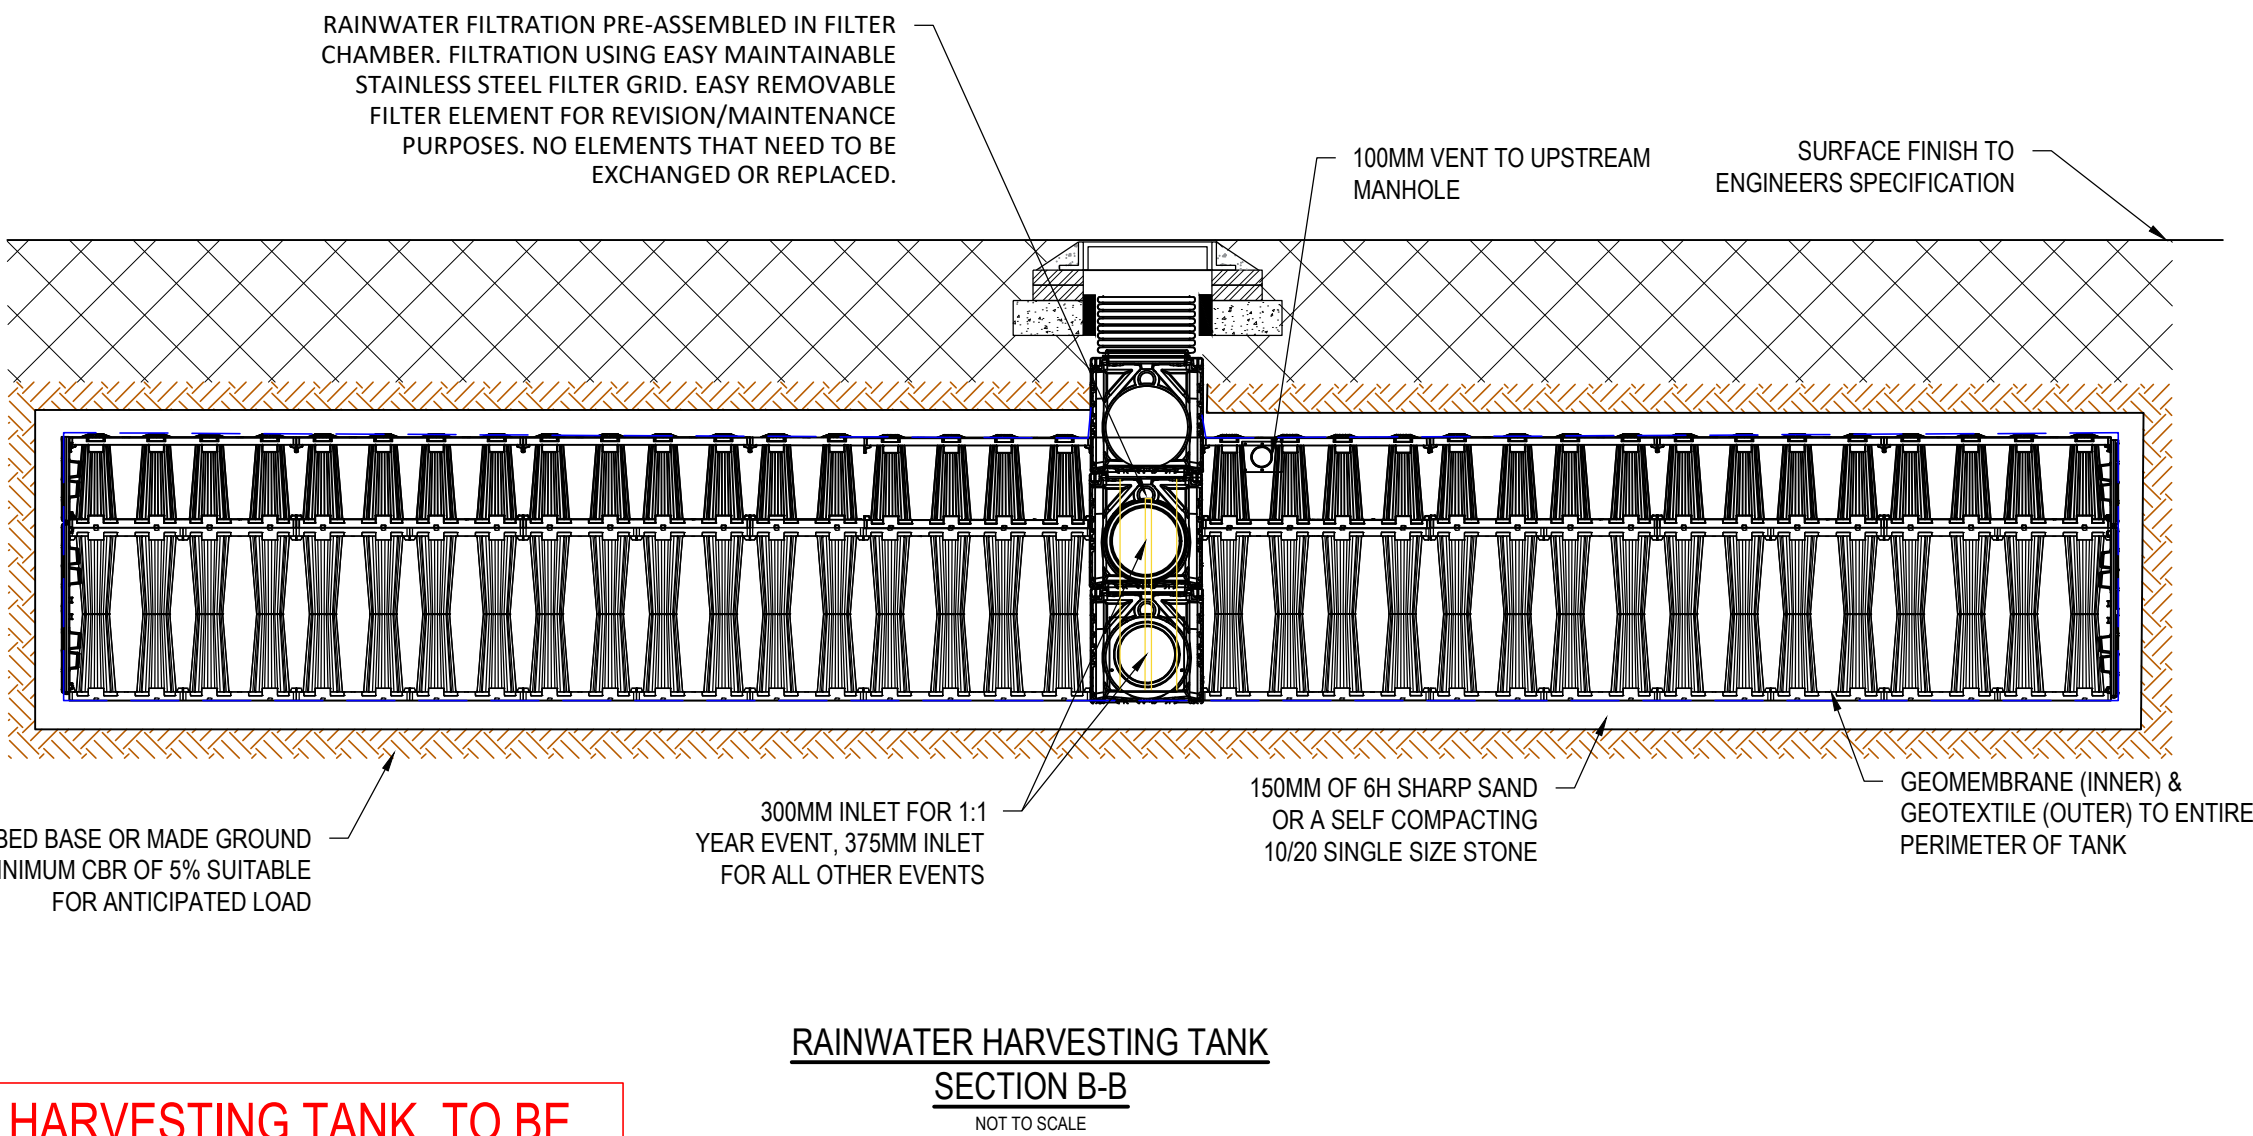


THIS IS A FINAL BURO HAPPOLD DRAWING FOR RECORD PURPOSES ONLY (NOT AS-BUILT) AND SHOULD BE READ IN CONJUNCTION WITH ALL 'AS-BUILT' INFORMATION BY THE RELEVANT SUB CONTRACTORS.

NOTE THAT THERE MAY HAVE BEEN CHANGES OF WHICH BURO HAPPOLD WERE NOT INFORMED, THEREFORE SITE SURVEYS TO ESTABLISH FINAL BUILT ARRANGEMENTS IS RECOMMENDED

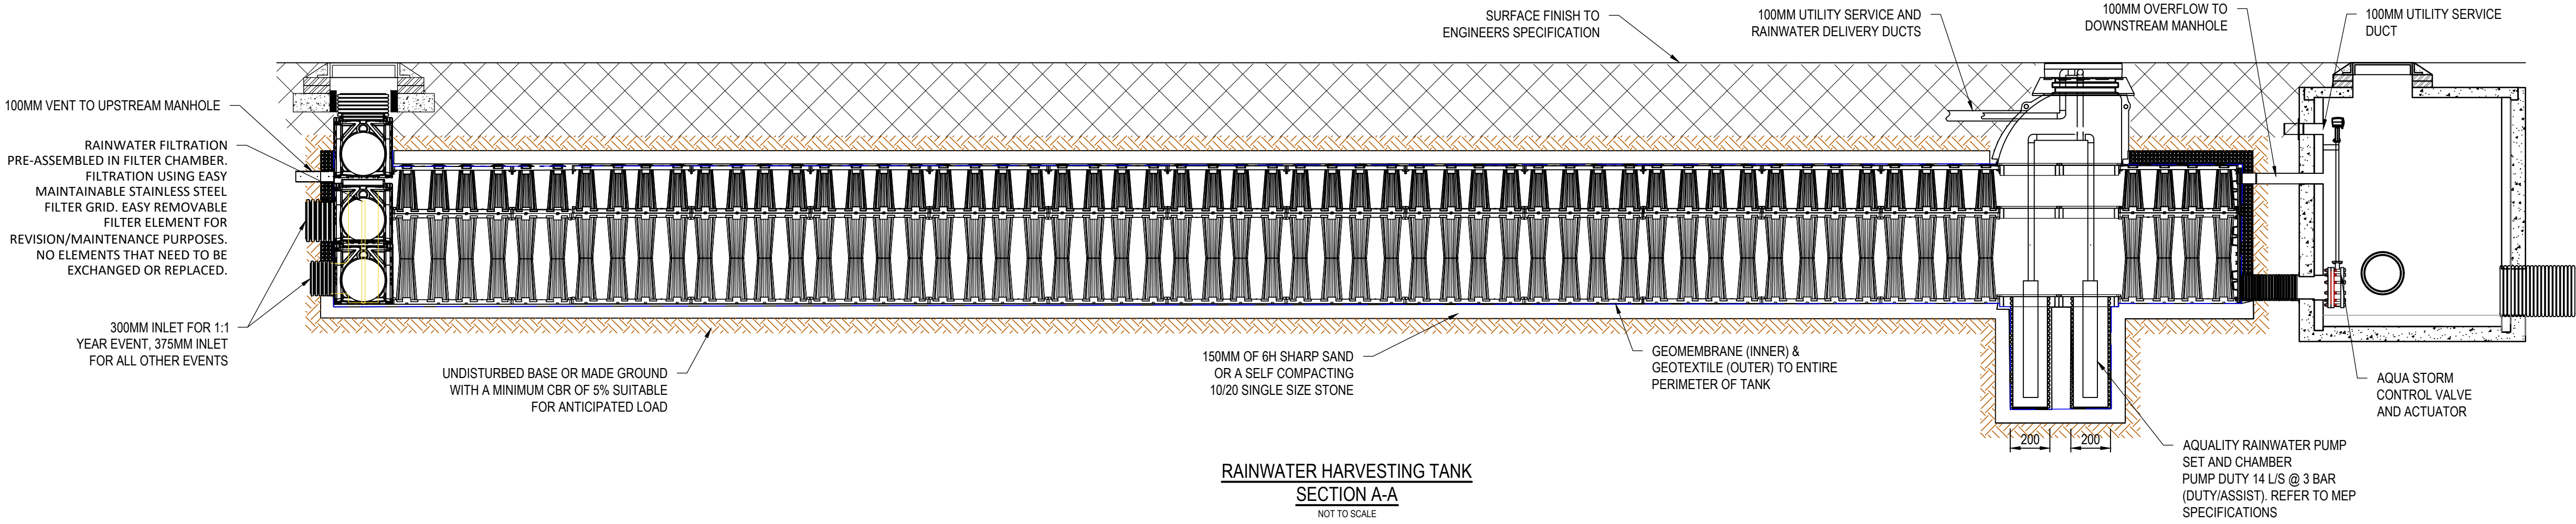

RAINWATER HARVESTING TANK TO BE HANDLED AND INSTALLED IN STRICT ACCORDANCE WITH MANUFACTURERS RECOMMENDATIONS REFER TO DRAWING 0558 FOR PLAN

All Rights reserved. Buro Happold and its group companies assert (unless otherwise agreed in writing) their rights under s.77 to 88 of the Copyright, Designs and Patents Act 1988.	
DO NOT SCALE THIS DRAWING.	
Suitability Code (as defined in ISO 19650-2:2018)	
Work in Progress (WIP)	
S0 - Initial Status	N/A
Shared (Non- Contractual)	
S1 - Suitable for co-ordination	
S2 - Suitable for information	
S3 - Suitable for review & comment	
S4 - Suitable for stage approval	
S5 - Withdrawn	
S6 - Suitable for PIM authorisation	
S7 - Suitable for AIM authorisation	
Published (Contractual)	
A1, A2, A3, Etc - Authorised and accepted	
B1,B2,B3, Etc, - Partial sign-off (with comments)	
Published (AIM Acceptance)	
CR - As constructed record document	
SAFETY HEALTH AND ENVIRONMENTAL INFORMATION	
IN ADDITION TO THE HAZARDS/RISKS NORMALLY ASSOCIATED WITH THE TYPES OF WORK DETAILED ON THIS DRAWING, NOTE THE FOLLOWING	
CONSTRUCTION	
EXCAVATIONS IN CONTAMINATED GROUND	
FINAL CONNECTION TO LIVE SEWER	
MAINTENANCE/CLEANING/OPERATION	
HYDRO-BRAKE FLOW CONTROL DEVICE	
ATTENUATION TANK	
RAINWATER HARVESTING TANK EQUIPMENT	
DECOMMISSIONING/DEMOLITION	
NO UNUSUAL RISKS	

Notes

CR01	CR	AJH	29.04.24	CONSTRUCTION RECORD
C01	KH	AH	30.07.21	A4 AUTHORISED AND ACCEPTED
P01	FR	AH	03.07.20	STAGE 4a TENDER
Rev	Appr	Dm	Date	Description

Camden Mill
Lower Bristol Road
Bath BA2 3DQ
UK

Tel: +44 (0)1225 320 600
Fax: +44 (0)8707 674 148
Email: 0042841@burohappold.com
Web: www.burohappold.com

Co-op Live

titleDRAINAGE DETAILS
SHEET 9

purpose of issue
RECORD

scale1:20	drawnFR	job no.	Suitability					
dateJul-20	checkedAH	0042841	CR					
reference	project code	originator	volume	level	type	role	number	rev.
	BRA-BHE-XX-XX-DR-C-0559							CR01