



01 VERTICAL SECTION
Scale 1:5

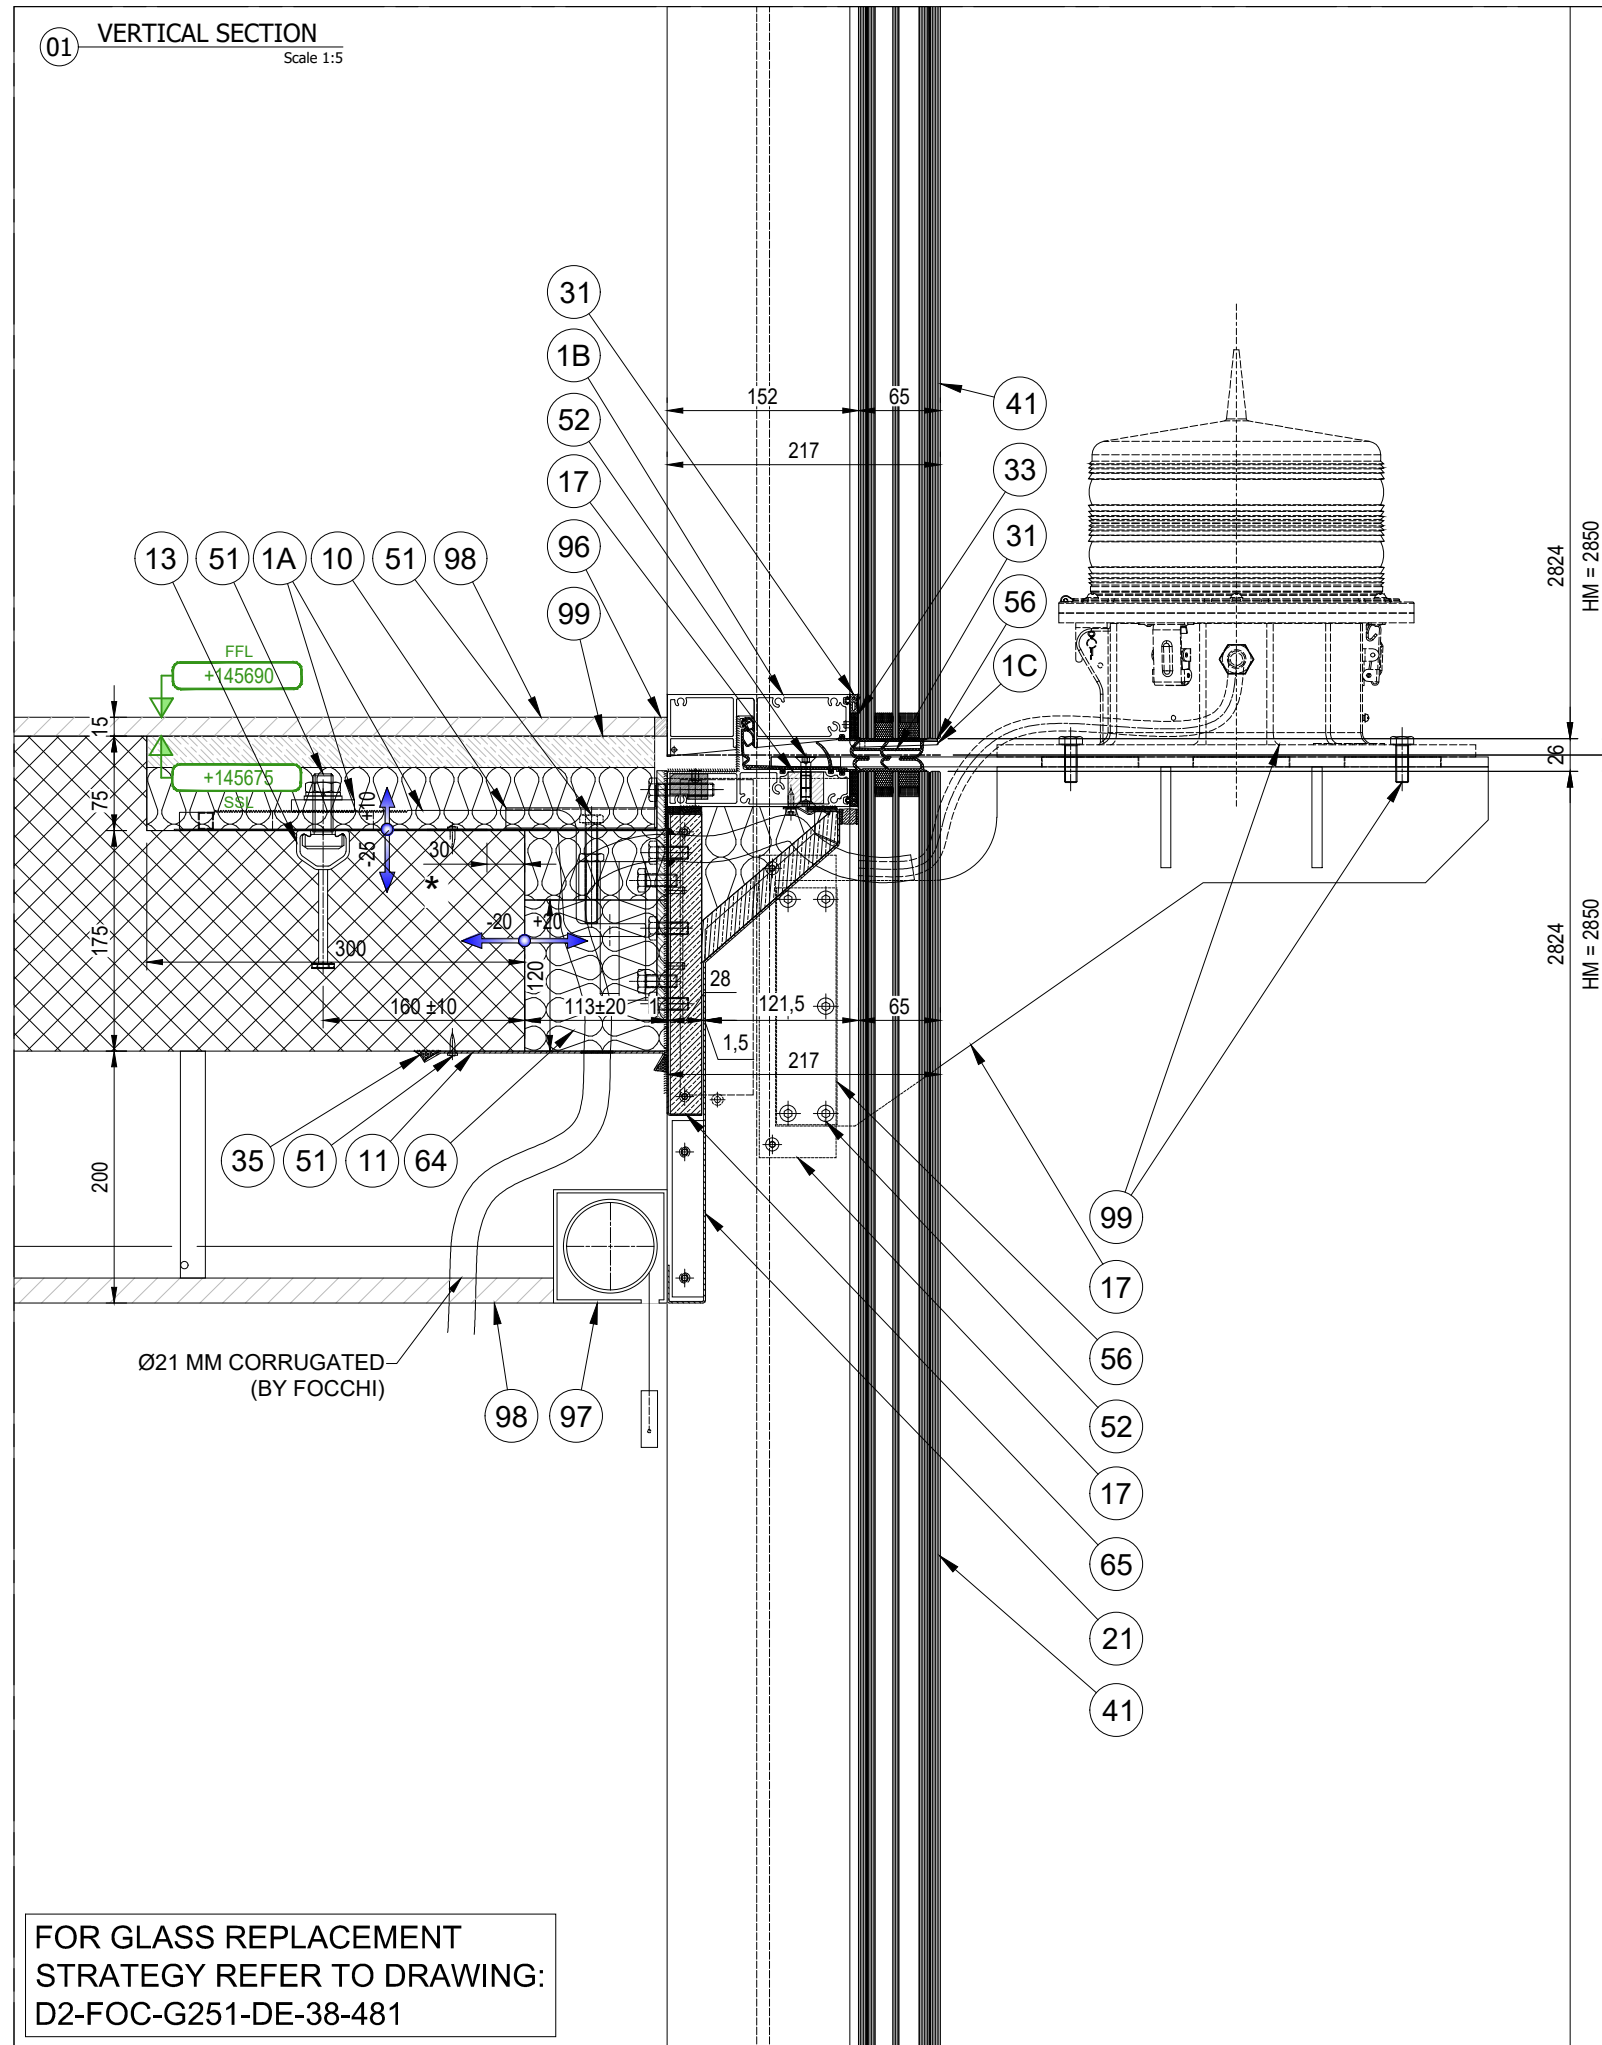


FOR GLASS REPLACEMENT
STRATEGY REFER TO DRAWING:
D2-FOC-G251-DE-38-481

 
02 HORIZONTAL SECTION
Scale 1:5

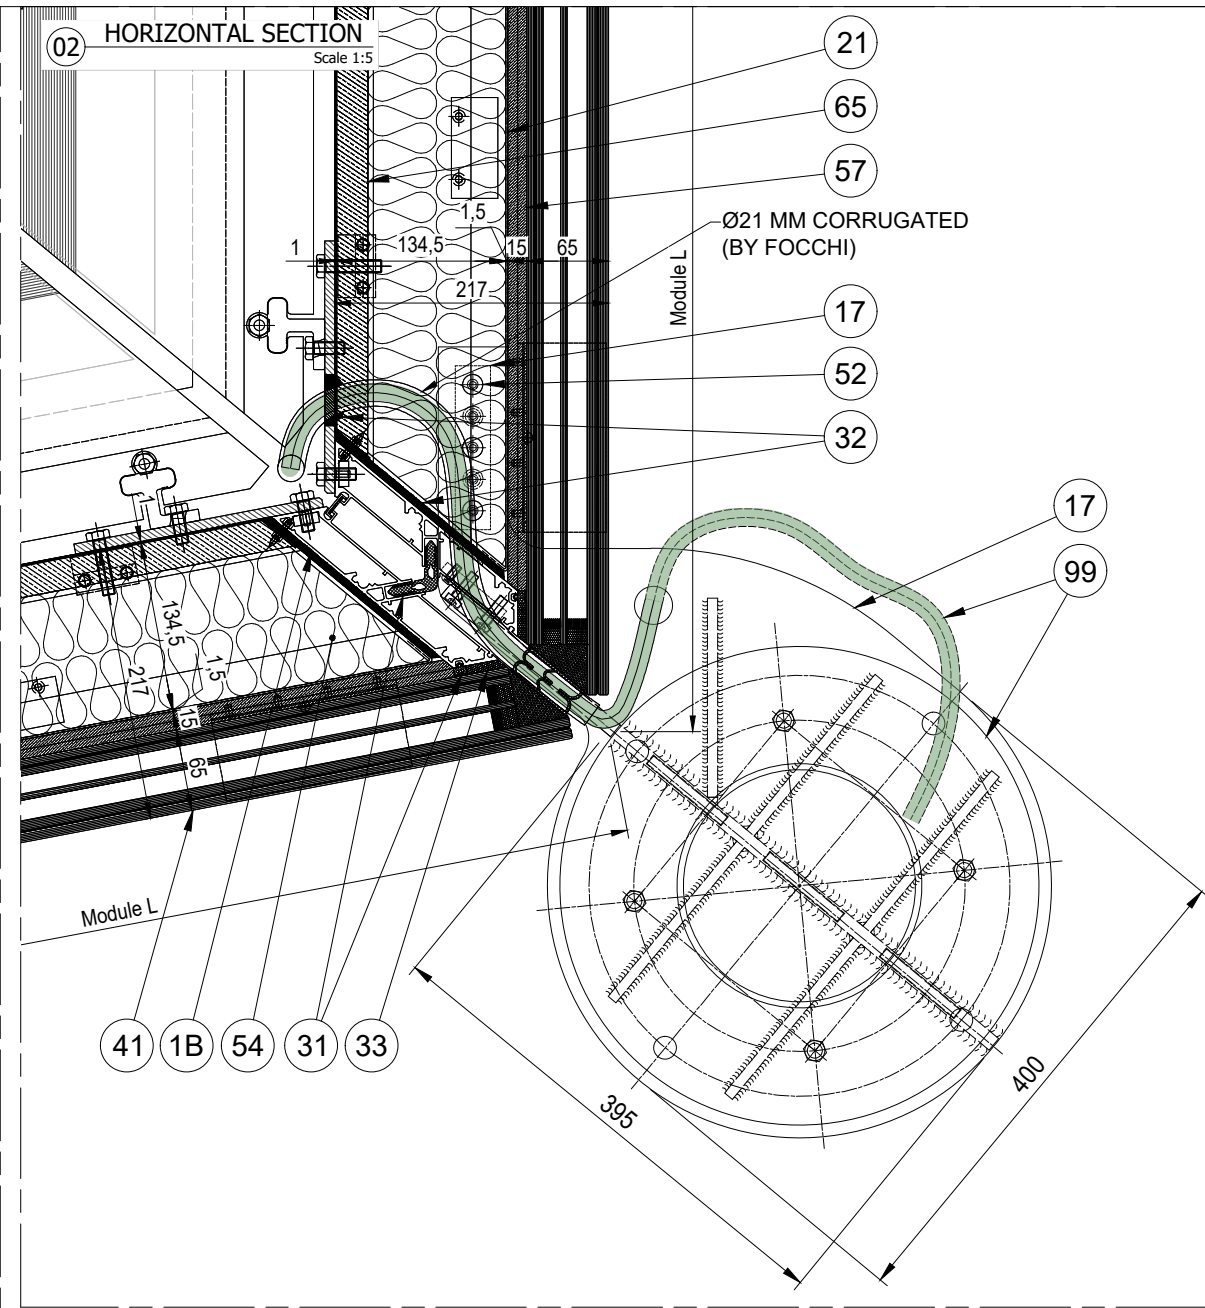

Aircraft warning lights distribution plan

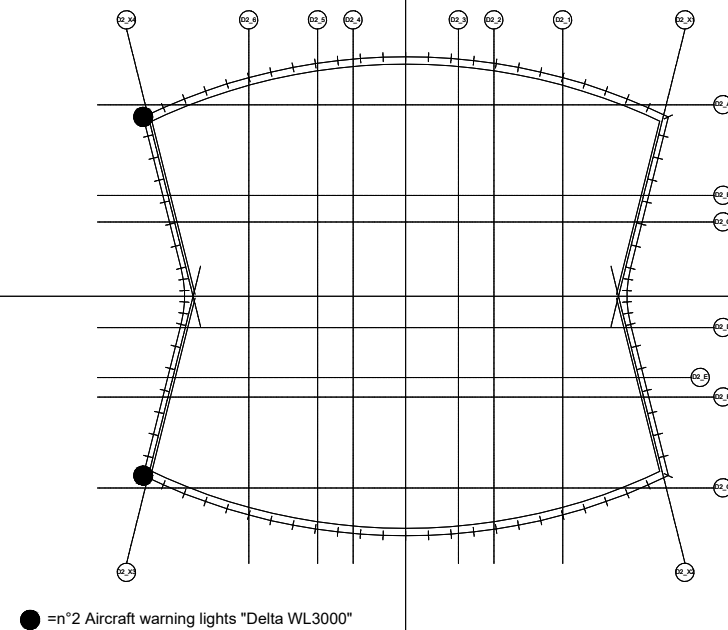

● = n°2 Aircraft warning lights "Delta WL3000"

<div></div> <div>D2 - AIRCRAFT WARNING LIGHTS DISTRIBUTION PLAN AND DETAILS L38</div>	Title :													
	Project : Trinity D2 - Manchester		Rev	Date	Drawn by:	Approved by:	Description	File : D2-FOC-G251-DE-38-480		Issue: -				
	Refer to : D1D2-UT@focchi.it		P01	23/06/2023	FDC	G. LASI	First Issue	Scale :		Job :				
	Architect : SIMPSON HAUGH AND PARTNERS		AB1	10/01/2025	FDC	G. LASI	AS BUILT	1:150 @ A3		220170				
	Client : RENAKER BUILD LTD		C01	21/06/2024	FDC	G. LASI	FOR CONSTRUCTION	Dwn.:		Rev.:				
Package : Curtain Wall		C02	08/05/2024	FDC	G. LASI	See red clouds	D2-FOC-G251-DE-38-480		AB1					