



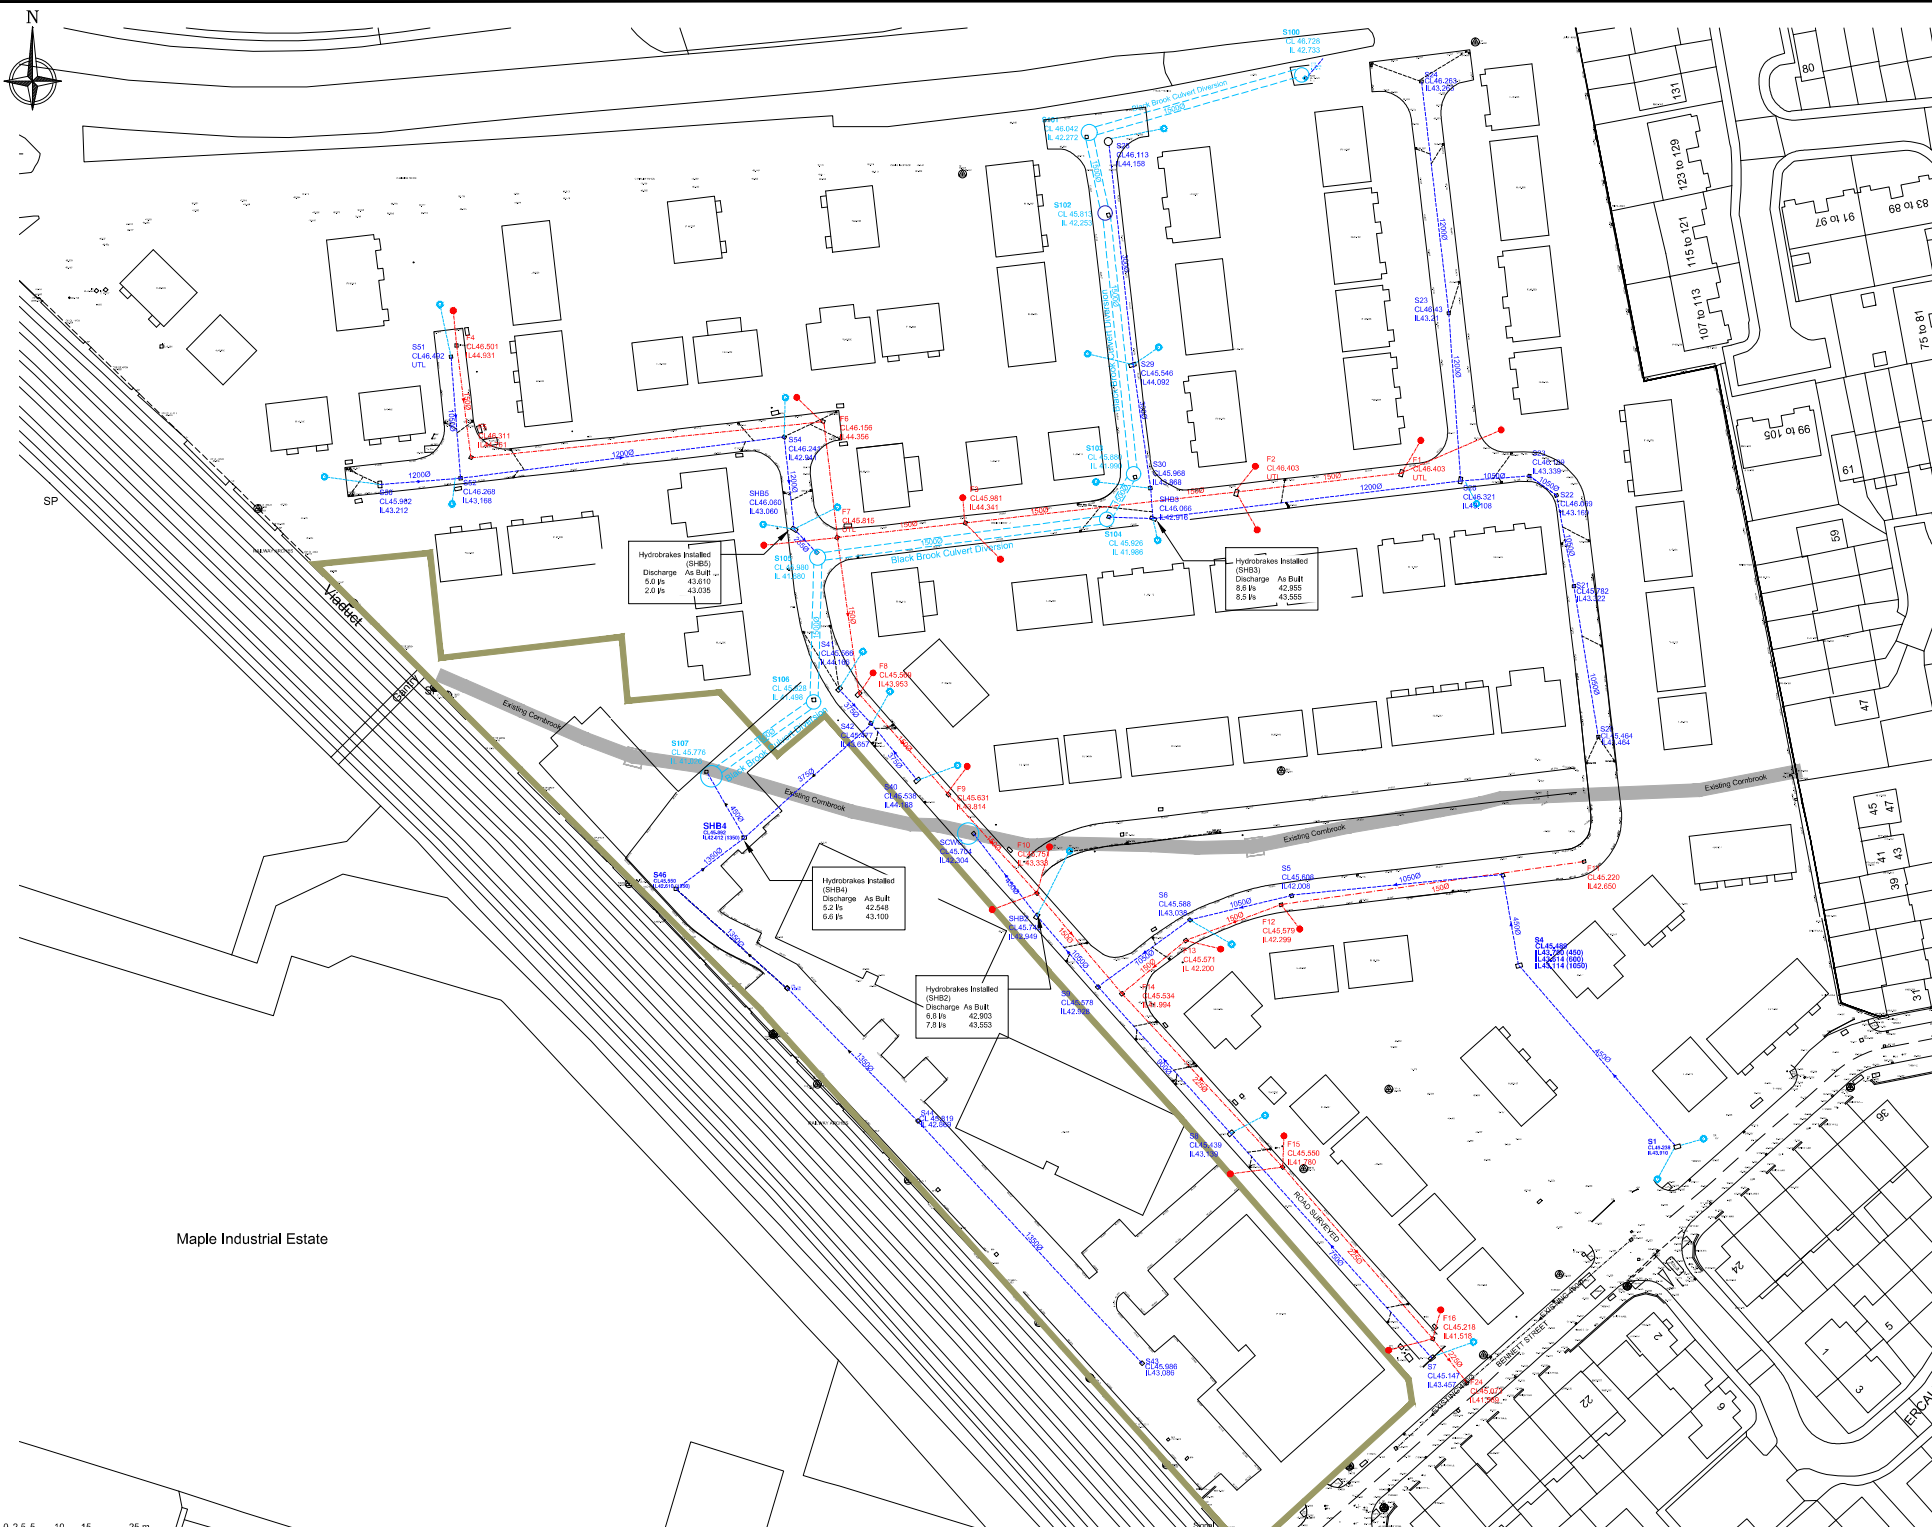

Maple Industrial Estate

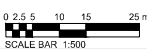

1	10/01/2025	As-Built & As-Constructed	Drainage
2			
3			

Development	
Bennett Street	
Location	
Manchester	
Working Name	
Drawing No.	
Drainage As-Built	
Job No.	Drawing No.
006	77
Revision	Scale 1:500
B	
Drawn By	Date
SE	7/7/2025
Checked by	Date Checked

1st Floor, 103 Dalton Avenue, Birchwood Park,
Warrington WA3 6YE
T: 01925 363108 W: www.kellenhomes.com

**KELLEN
HOMES**