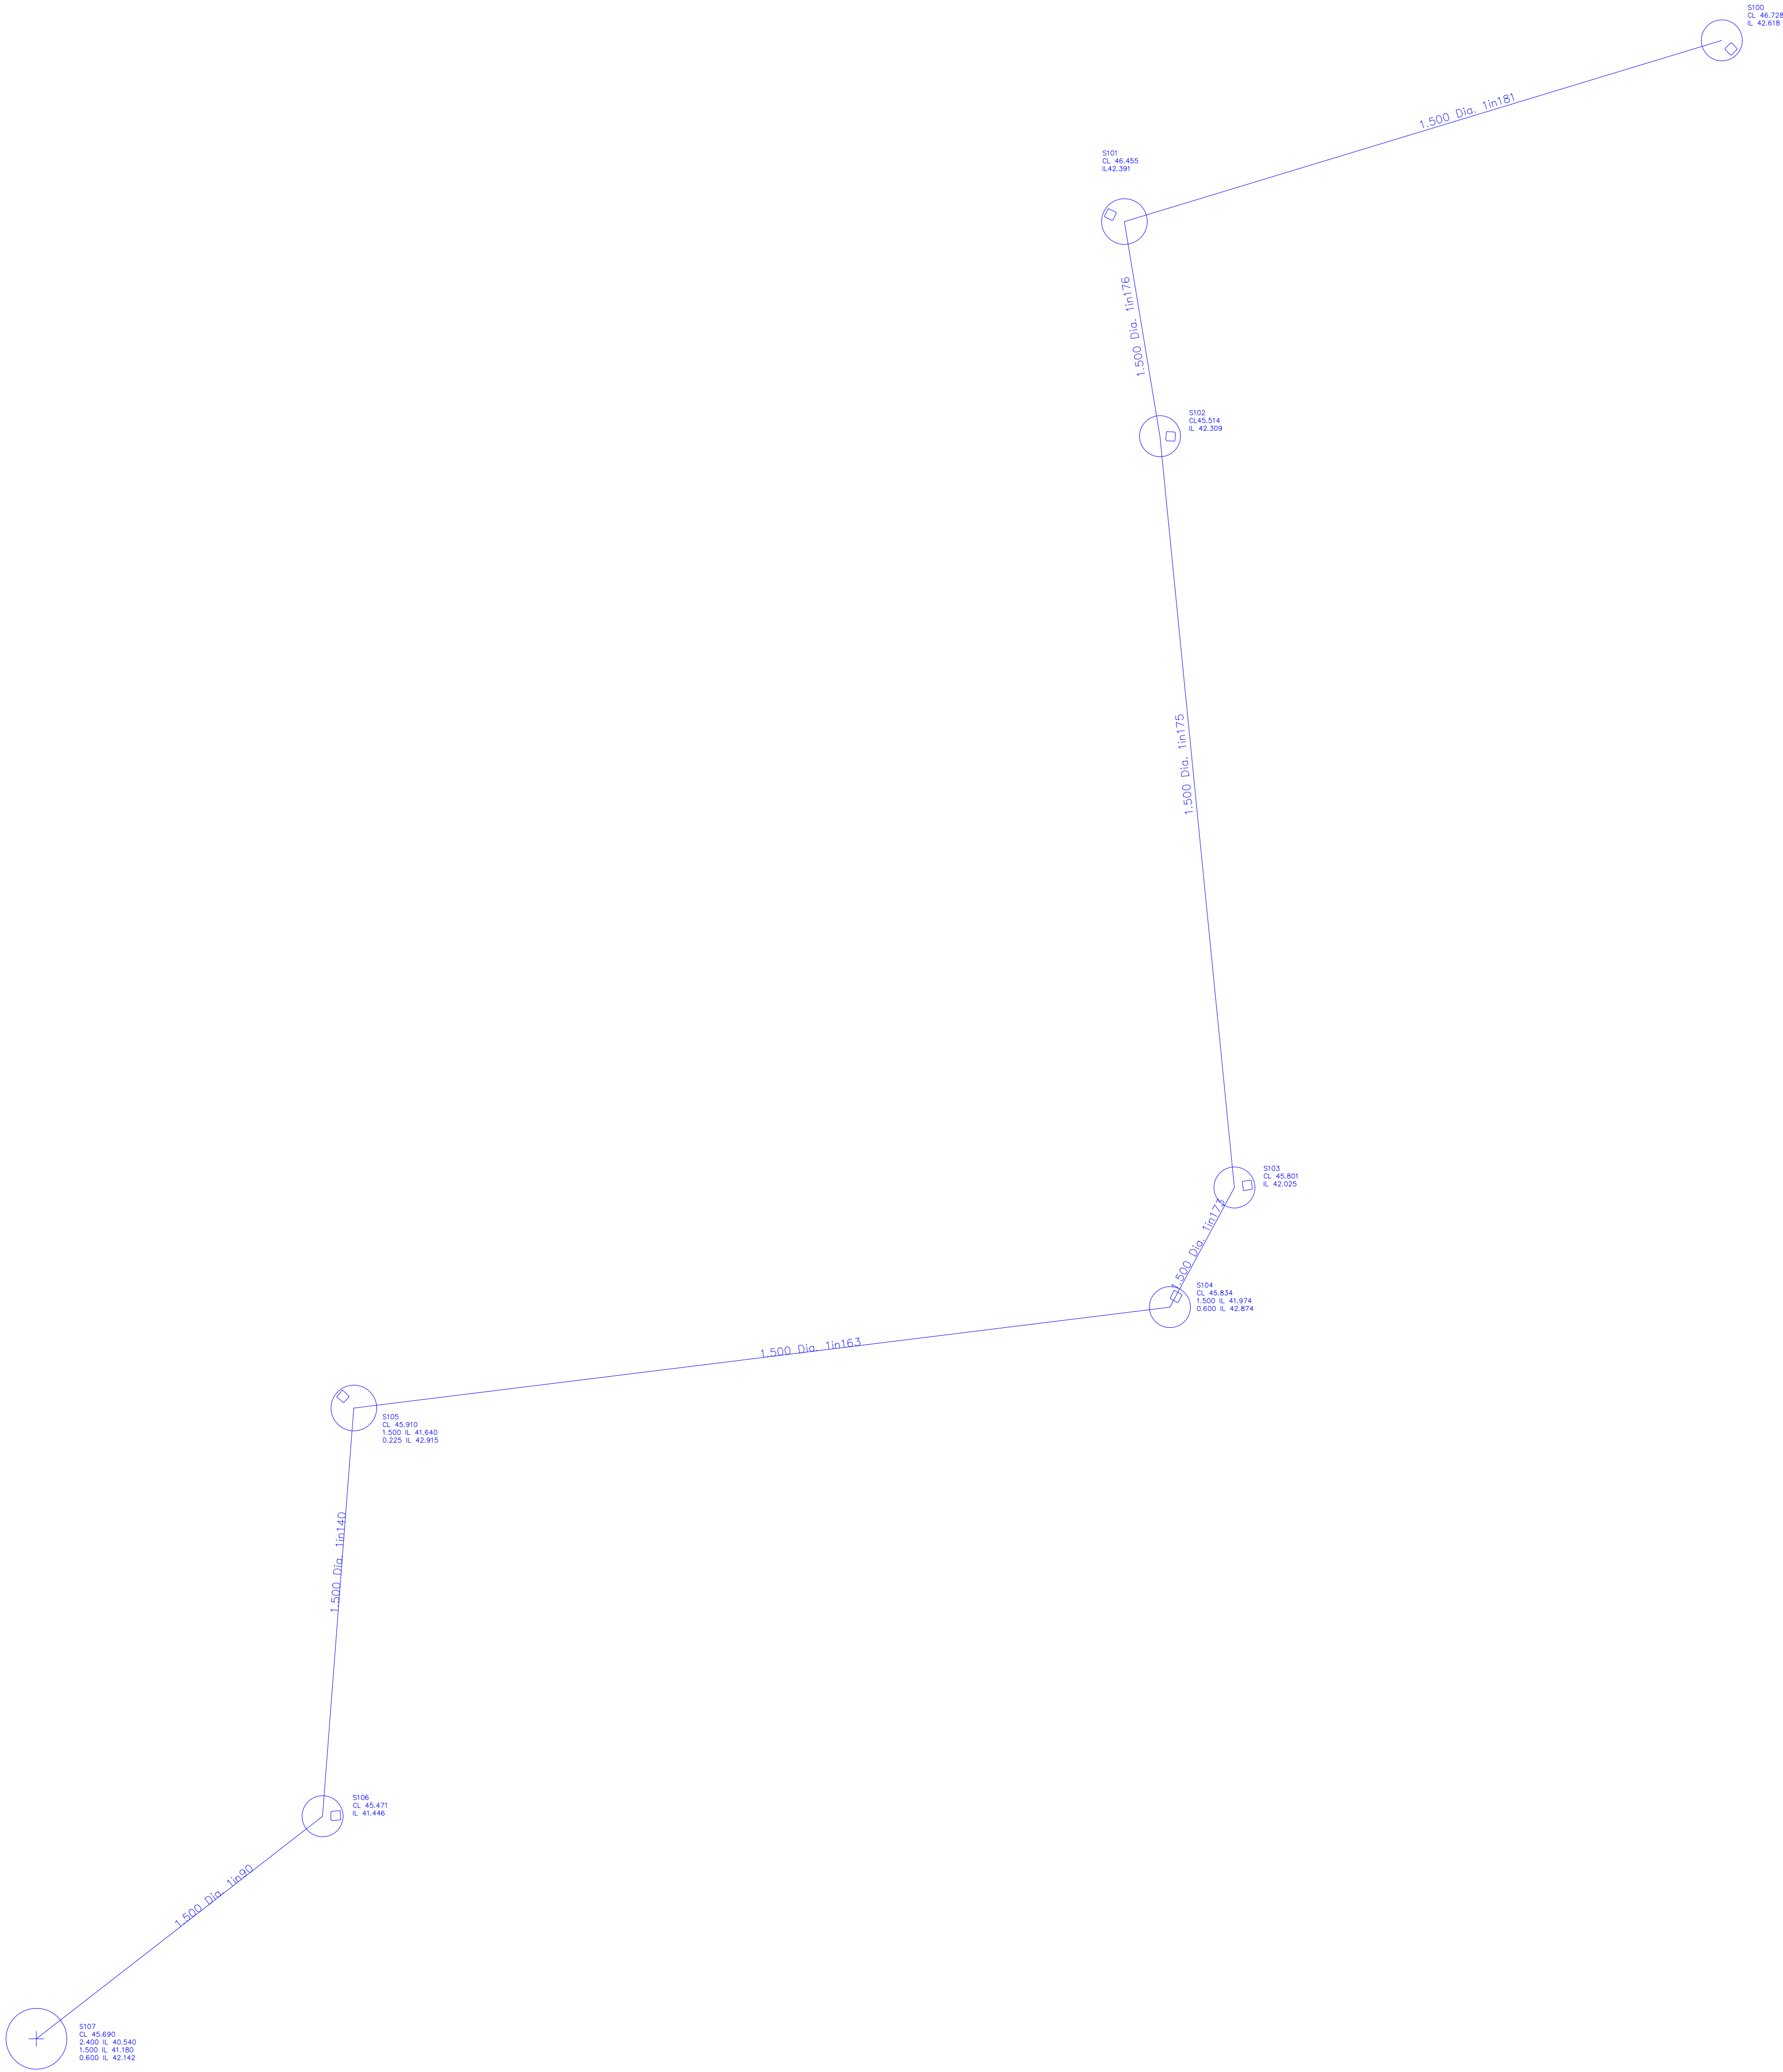


CLIENT
Kellen Homes

PROJECT TITLE
Bennett Street
Manchester

DRAWING DETAIL
Surface Water
Culvert Diversion As Built

PROJECT ENGINEER	DATE	28-Jul-23
DRAWN	SCALE	Shown @ A1
KM		

DRAWING NUMBER	REVISION
Drawing Number	Rev