
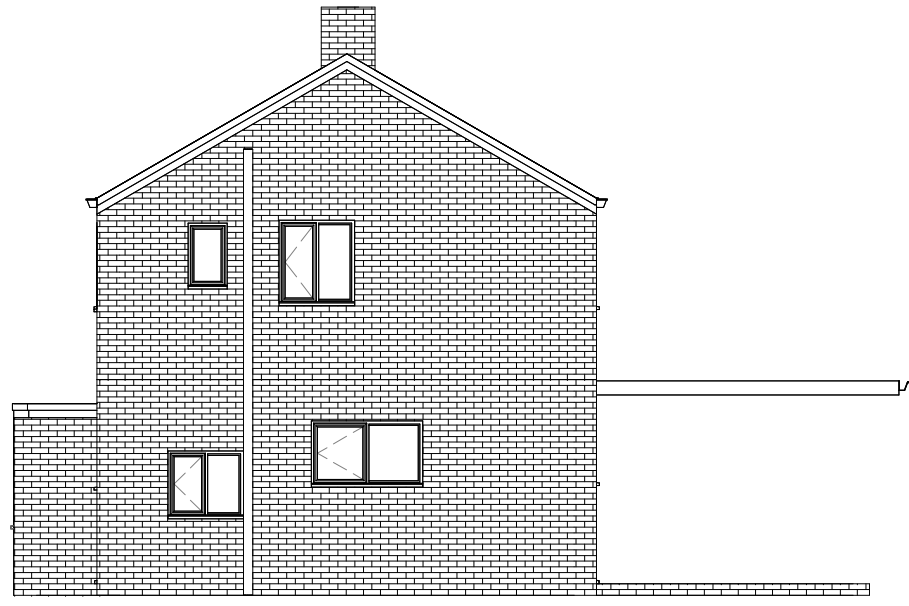
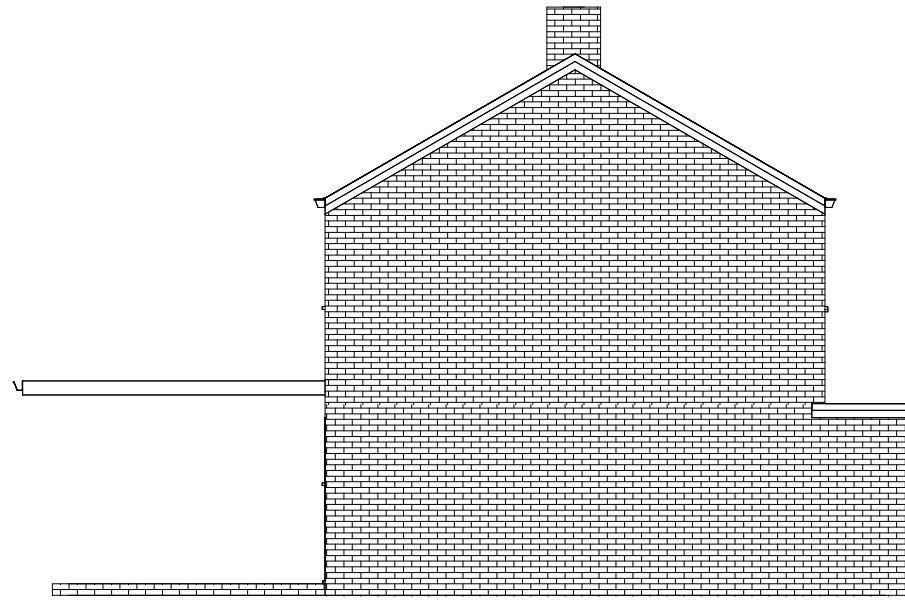


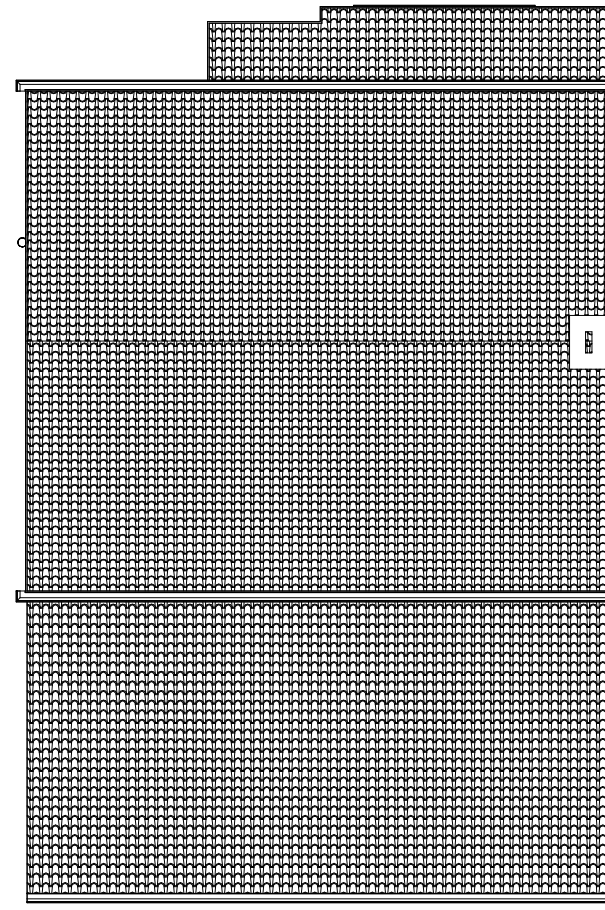

Existing Front
1 : 100

Existing Rear
1 : 100

Existing Side I
1 : 100

Existing Side II
1 : 100

Existing Roof
1 : 100

Scale: @ A1.
Dimensions must be checked by
contractor before work is commenced.

This drawing remains the property of
Belal Rashid Technical Architecture
and should not be reproduced in full or
in part without prior consent from
Belal Rashid Technical Architecture.



Scale 1:50



Scale 1:100

Notes:

At the time of inspection, the single-storey
rear structure had been demolished, with
only the roof and two courses of brickwork
remaining.

Client:

Mr. Abdul Naeem Dar

Project:

Extension


Project Address:

35 Benmore Rd
Manchester M9 6LQ
United Kingdom

Drawing Name: Existing (as-built)
Drawing Number: A101
Drawing Date: 01/01/26
Author: M.Tamzid. B.Rashid

Belal Rashid Technical Architecture
11 Queen Street
Oldham
Greater Manchester
OL1 1RD

Web: www.brta.co.uk
Email: info@brta.co.uk
Tel: 0161 241 9650

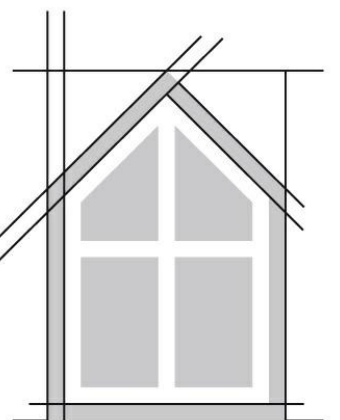

BRTA