



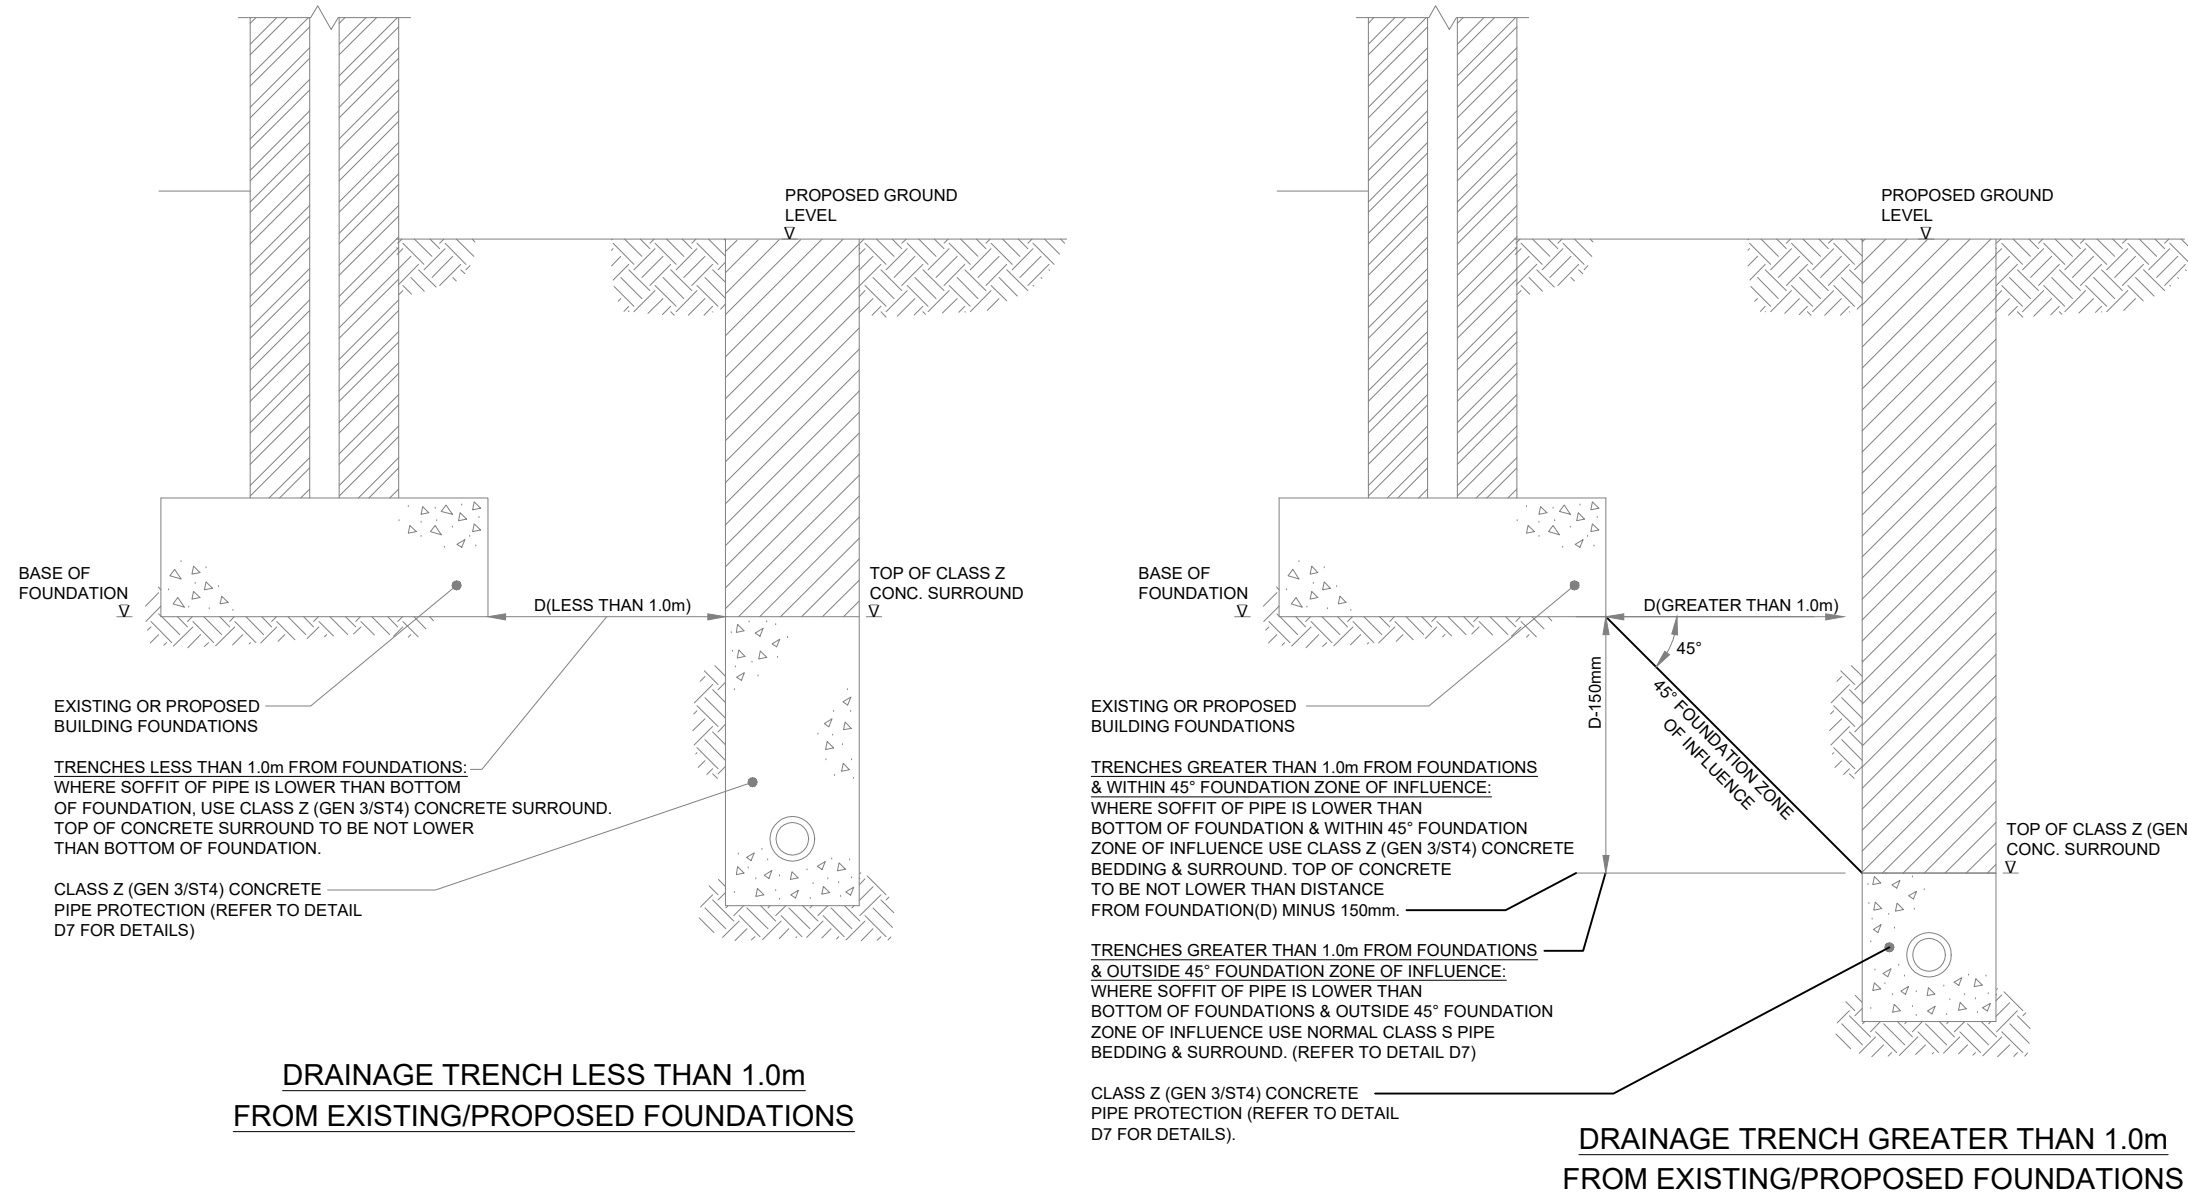


PIPE PROTECTION ADJACENT TO EXISTING/PROPOSED FOUNDATIONS

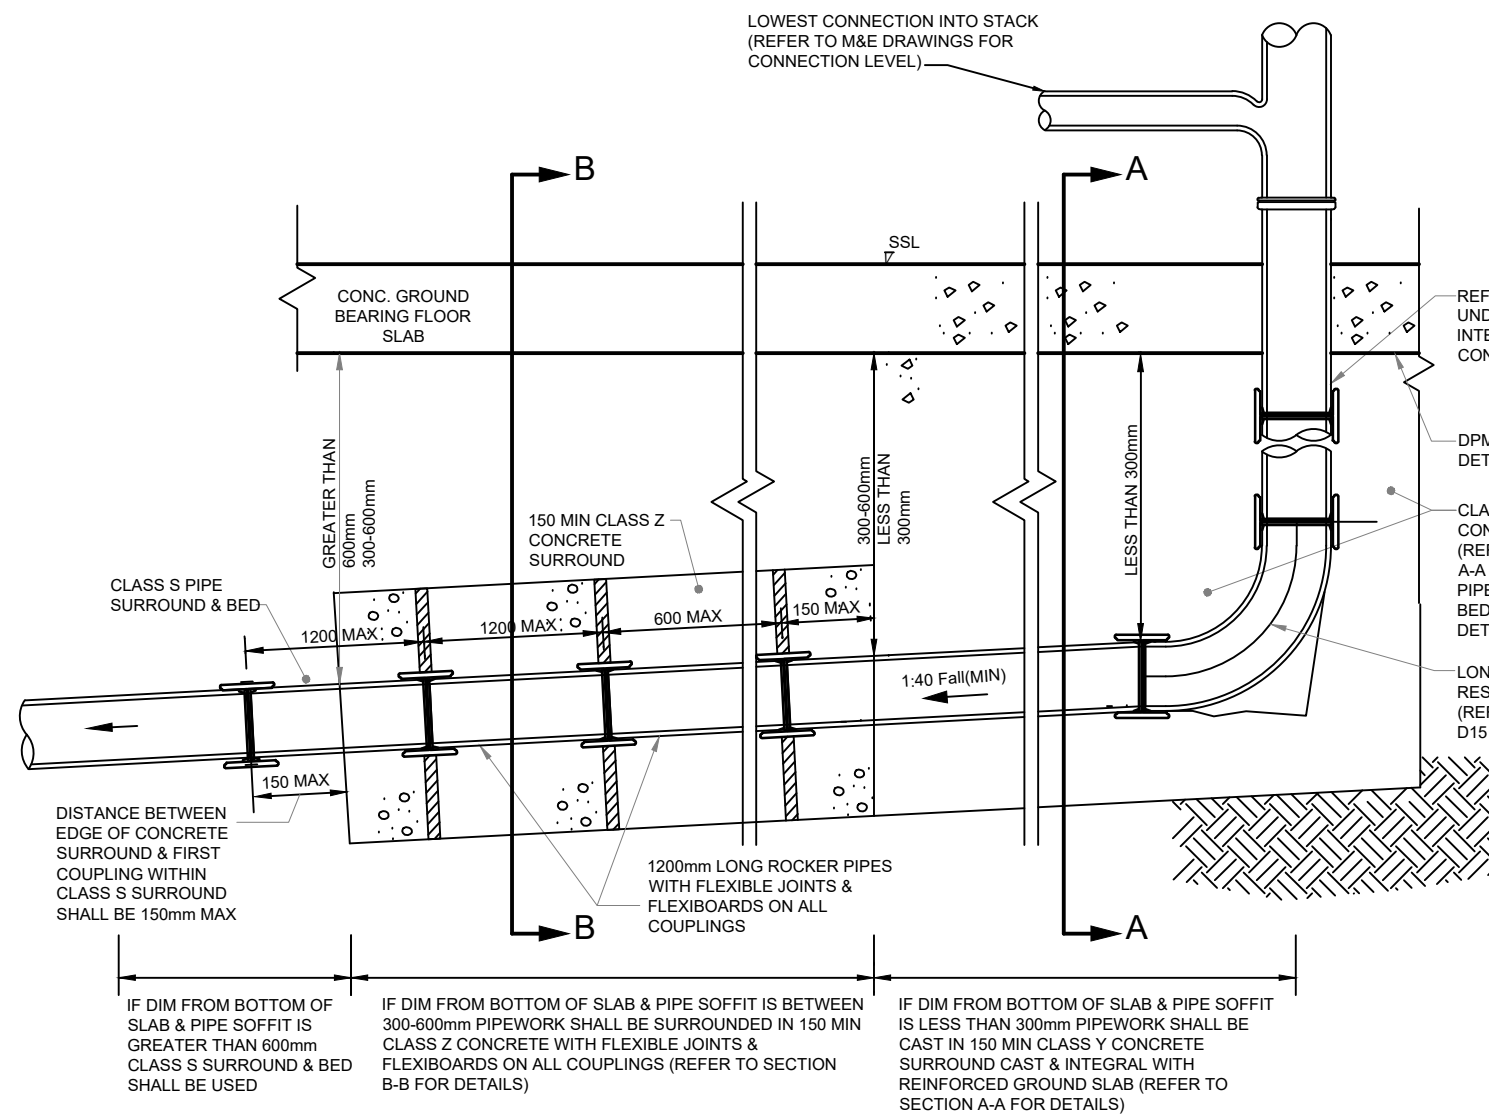


SECTION C-C


TYPICAL UNDERSLAB PIPE BEDDING DETAILS FOR PIPEWORK UNDER GROUND BEARING SLAB (FOR ALL UNDER SLAB PIPE DEPTHS)

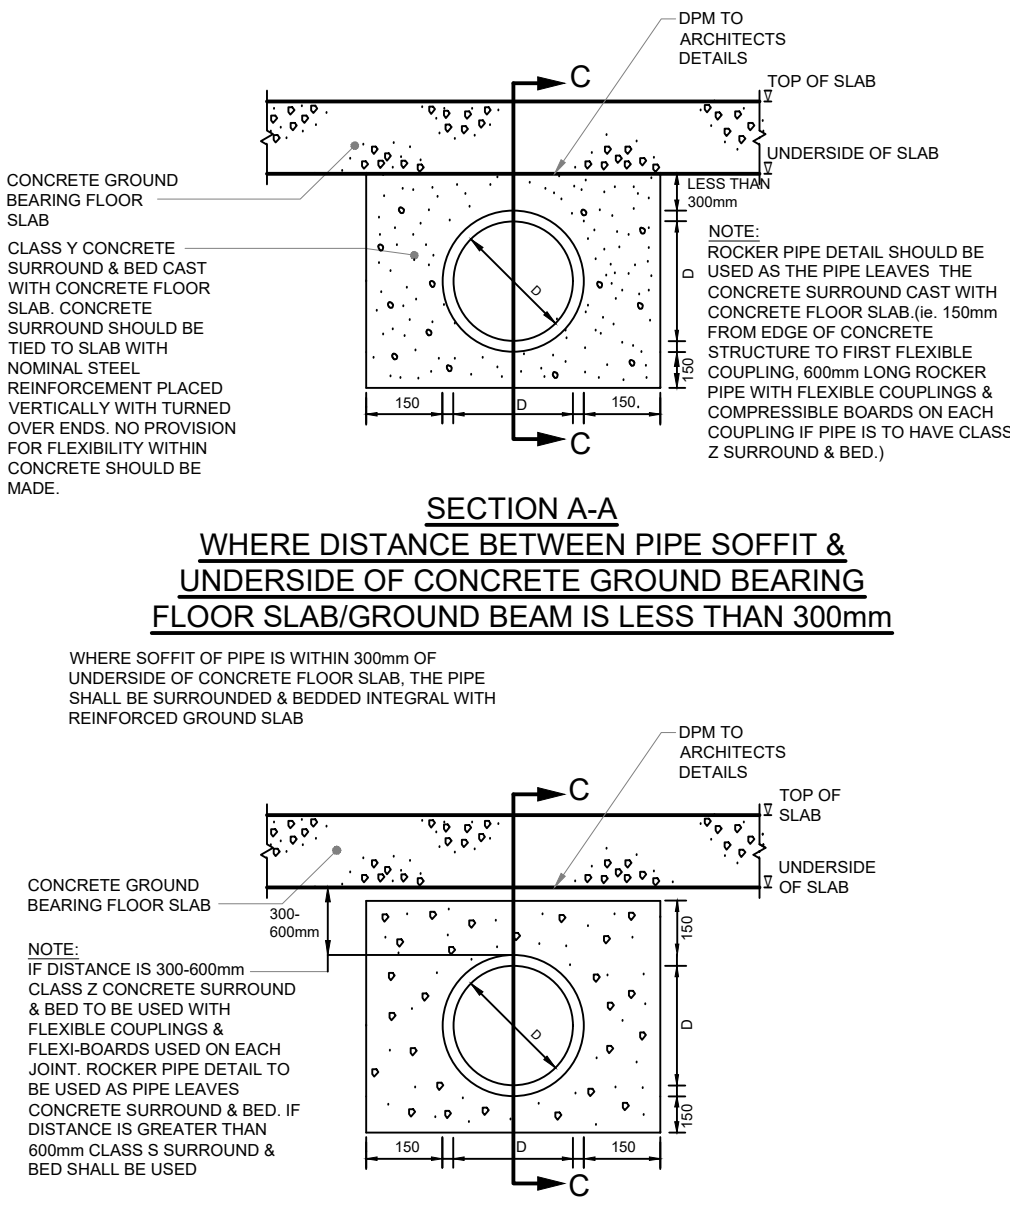


SECTION B-B. WHERE DISTANCE BETWEEN PIPE SOFFIT & UNDERSIDE OF CONCRETE GROUND BEARING FLOOR SLAB/GROUND BEAM IS GREATER THAN 300mm

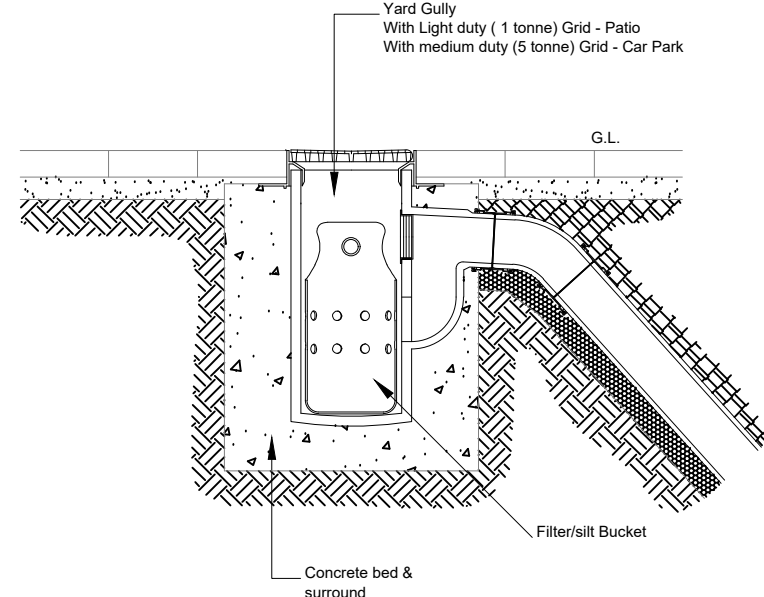


EXTERNAL SW GULLY DETAIL

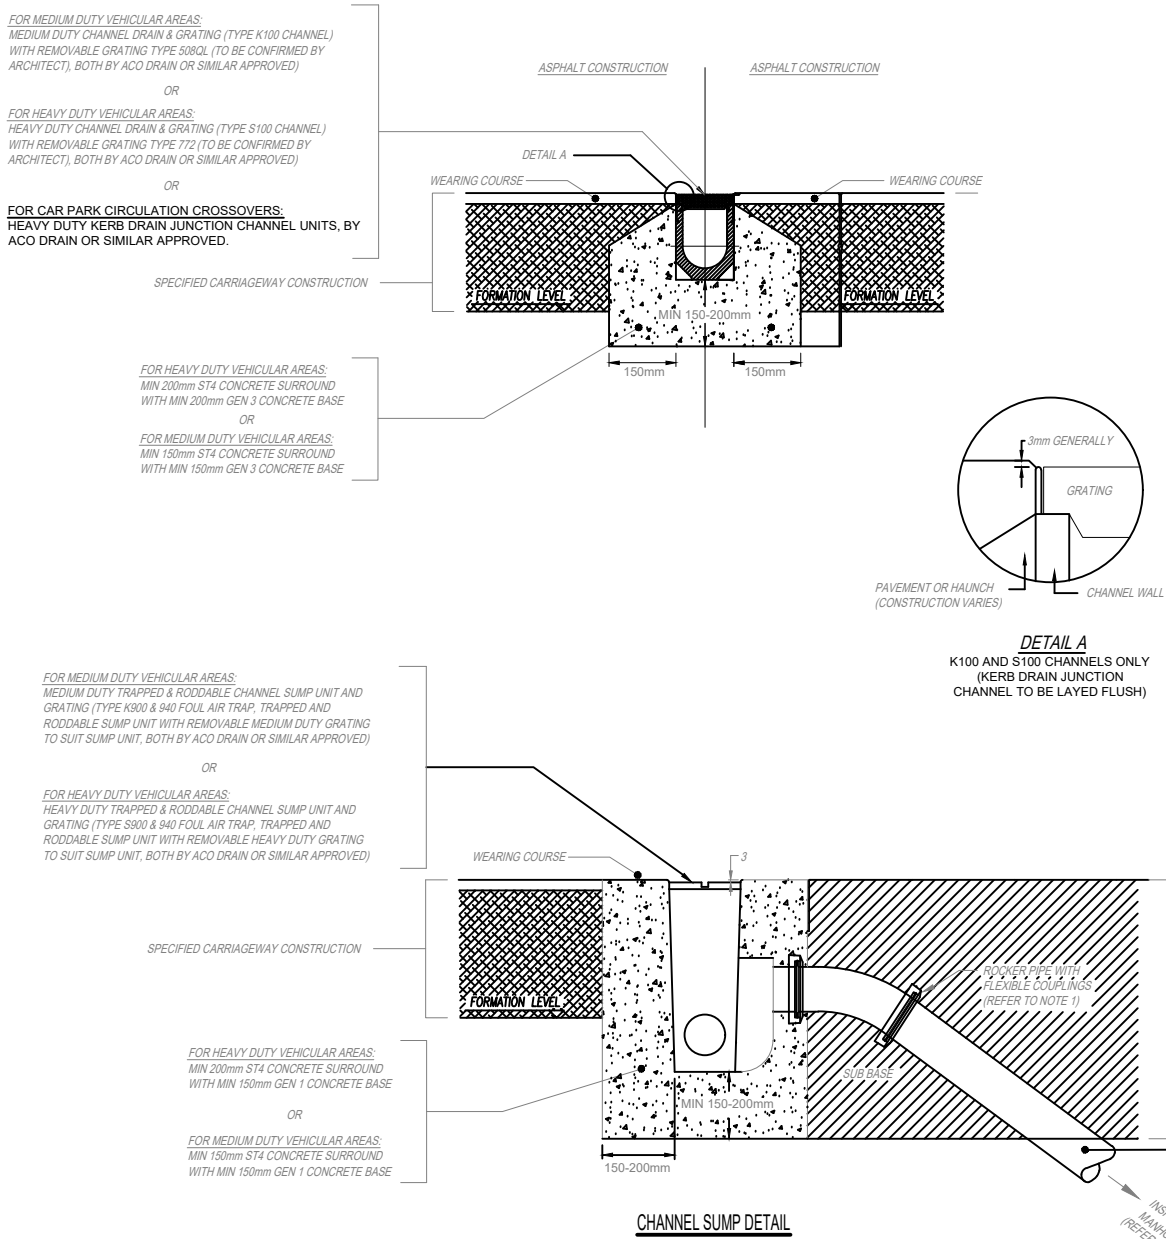


TYPICAL EXTERNAL CHANNEL DRAIN & TRAPPED REMOVABLE SUMP UNIT DETAILS

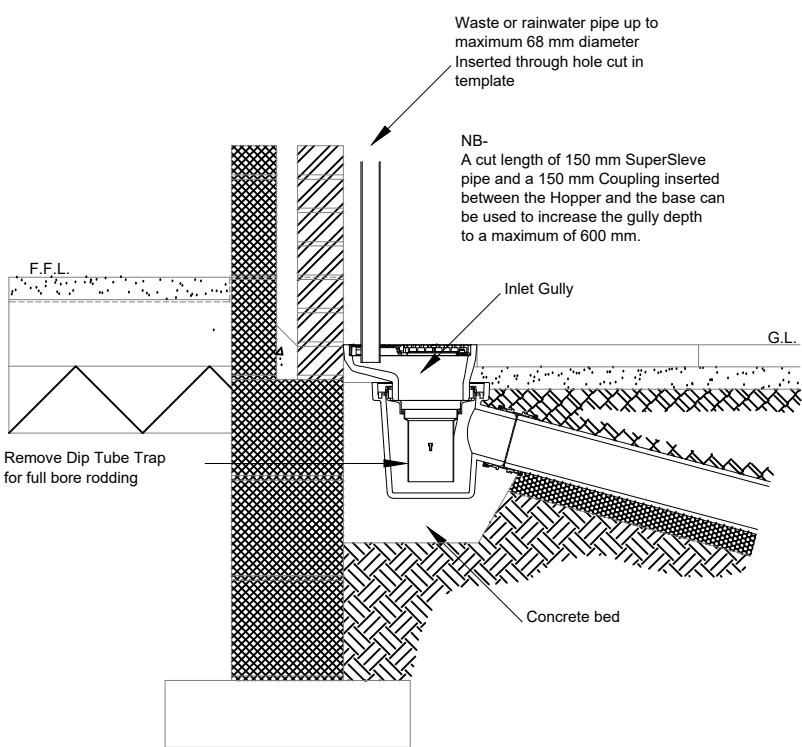

TYPICAL RAINWATER PIPE AND BACK INLET GULLY DETAIL

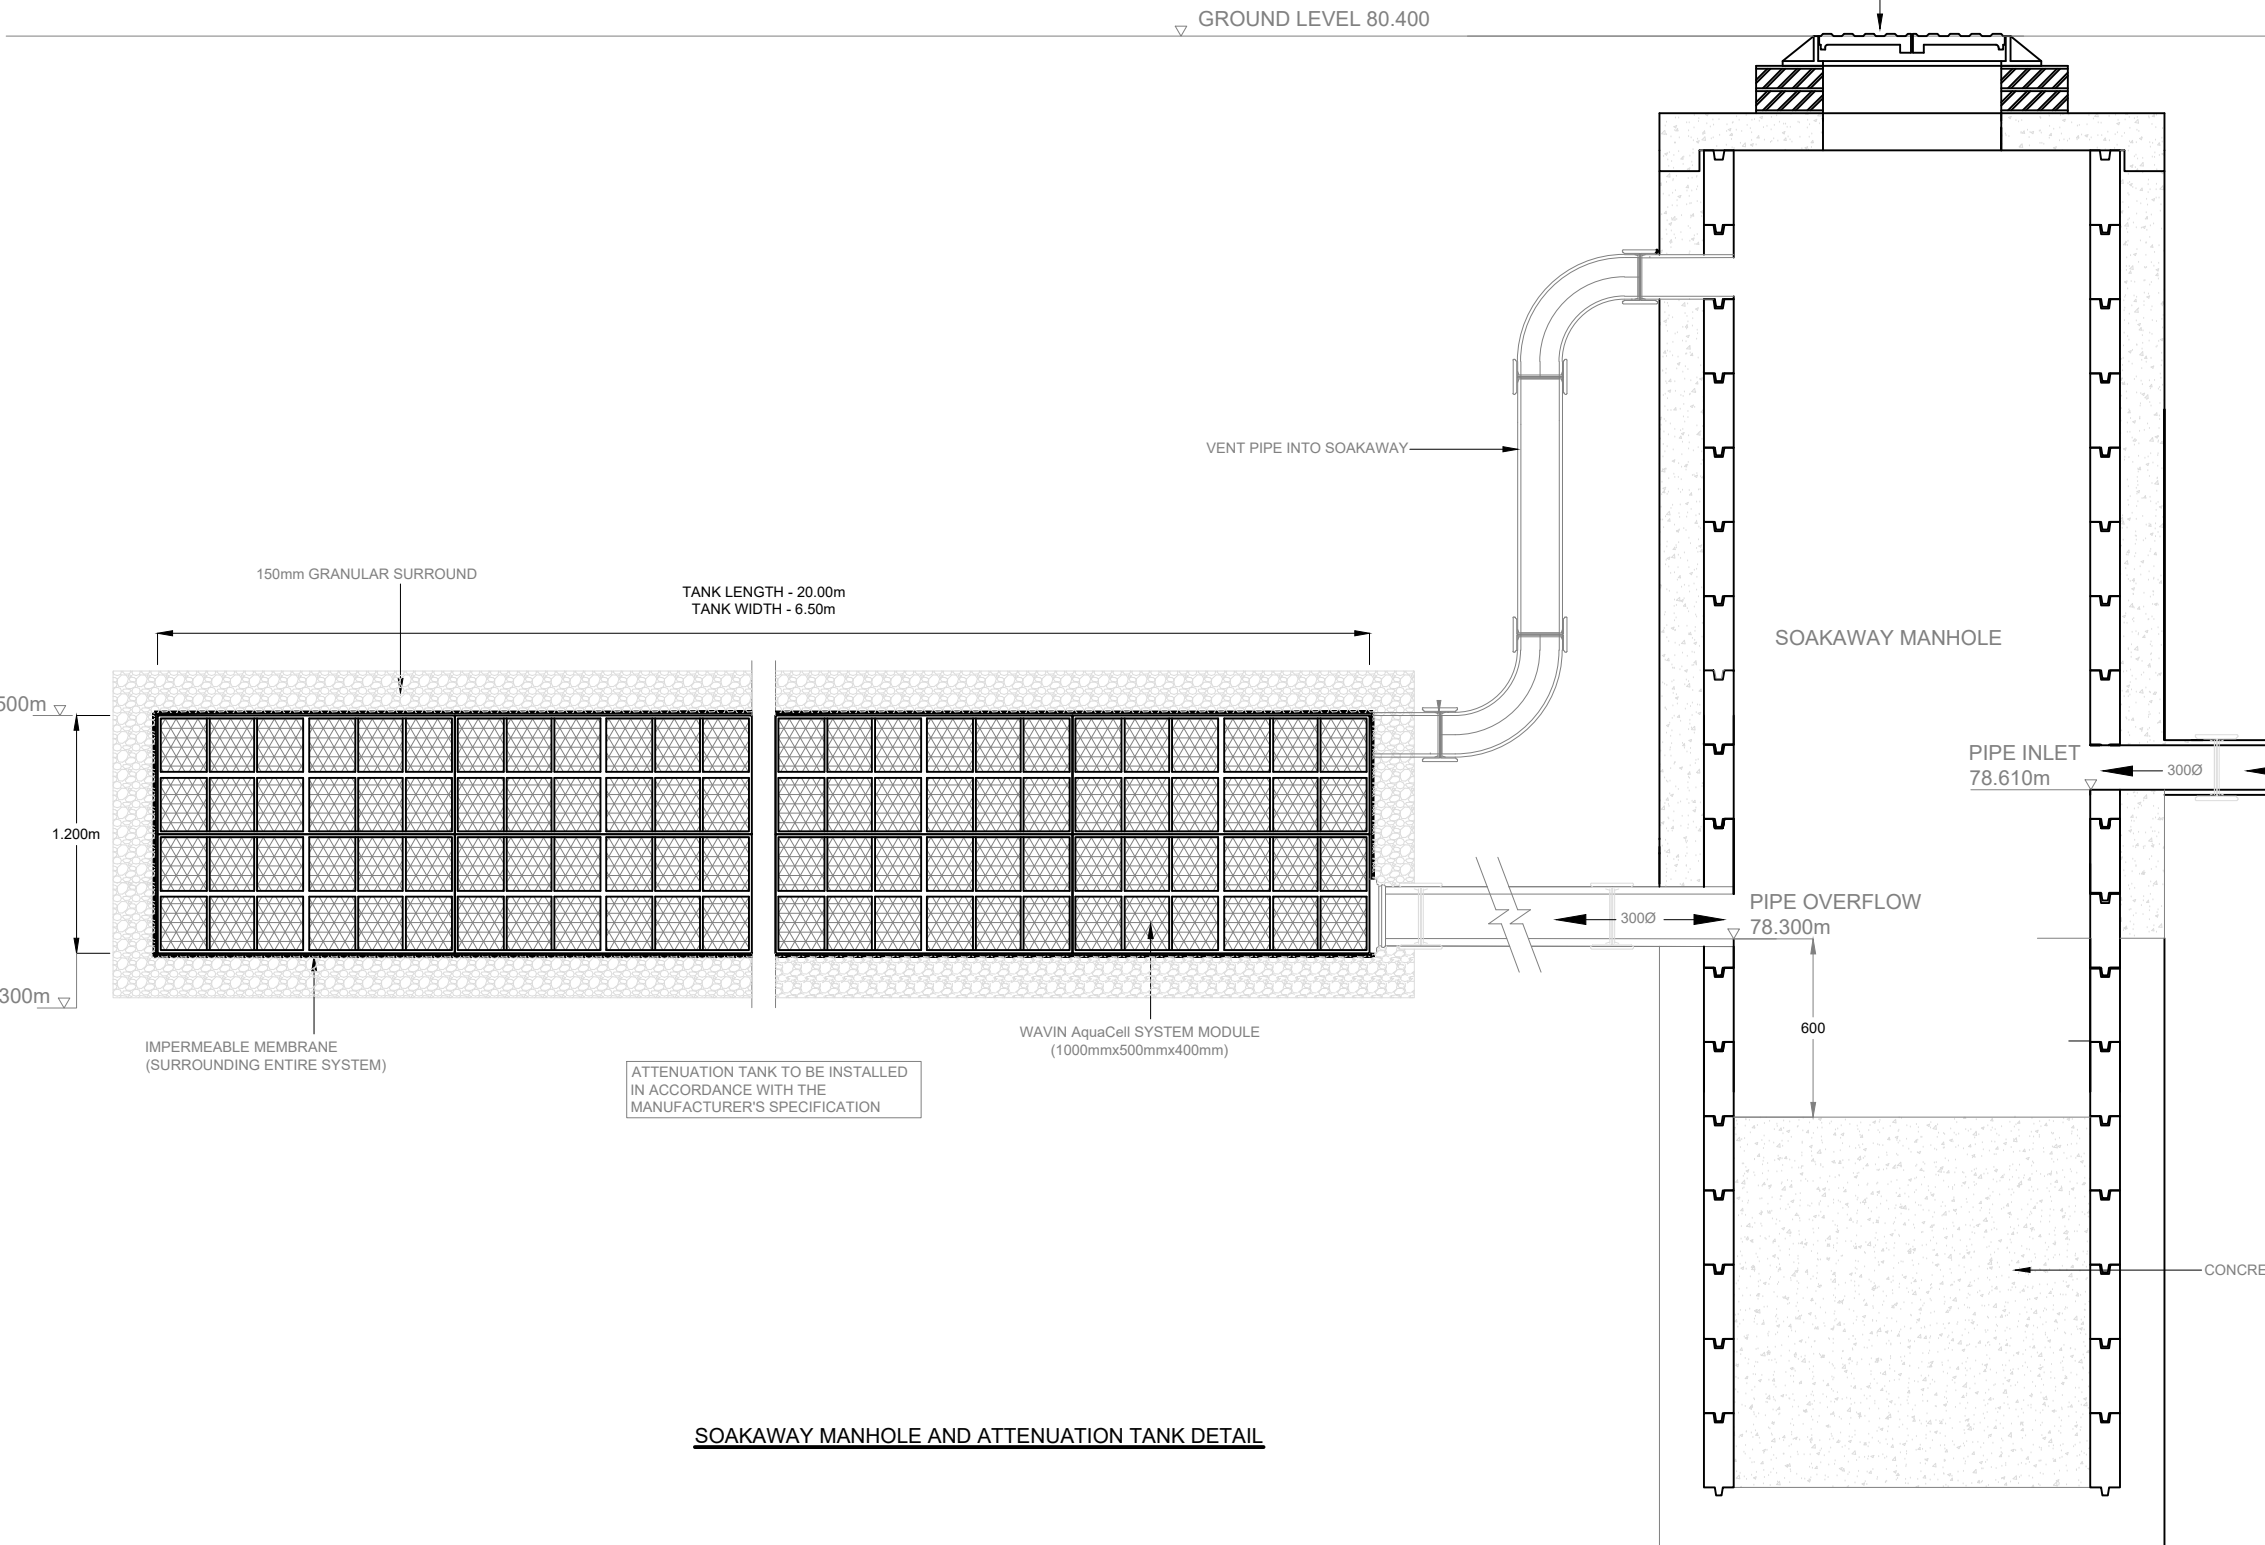

SOAKAWAY MANHOLE AND ATTENUATION TANK DETAIL

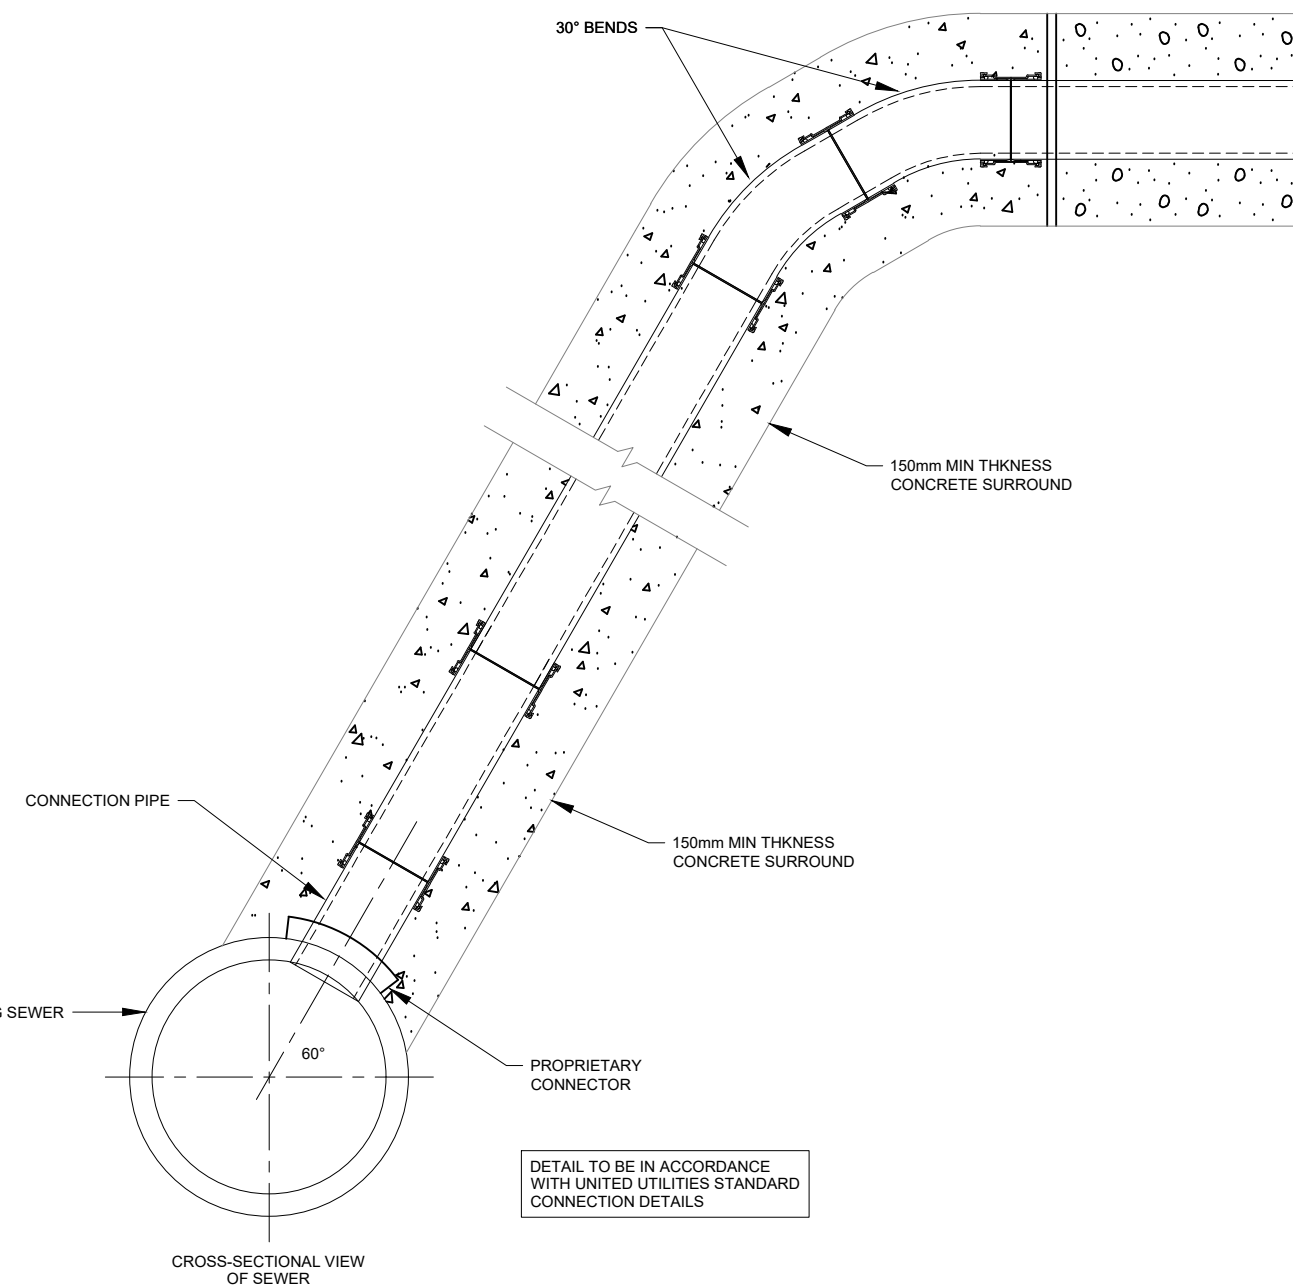

CONNECTION TO EXISTING TO SEWER

FINAL ISSUE

This drawing is ©Bradshaw Gass & Hope LLP and is not to be copied, reproduced or re-distributed either in whole or in part without the prior written permission of the originator.

The originator shall have no responsibility for any liability, loss, cost, damage or expense arising from or relating to any use of this document other than for its intended purpose on this project.

This drawing shall be read in conjunction with all other relevant drawings, specifications and associated documentation. Any discrepancies, errors or omissions are to be reported to the originator before proceeding with work.

All dimensions are to be checked on site by the contractor prior to proceeding with any work.

Hazard Identification

ref	hazard	date

FINAL ISSUE - "AS CONSTRUCTED" DRAWINGS REPRESENT THE BUILDING AS DOCUMENTED AT THE TIME OF COMPLETION. THEY ARE PROVIDED FOR RECORD PURPOSES ONLY AND MAY NOT REFLECT SUBSEQUENT ALTERATIONS OR CONCEALED CONDITIONS. THE CONSULTANTS INSPECTIONS WERE LIMITED TO PERIODIC SITE OBSERVATIONS AND DID NOT CONSTITUTE EXHAUSTIVE VERIFICATION. NO LIABILITY IS ASSUMED FOR DISCREPANCIES, MODIFICATIONS OR RELIANCE BEYOND THEIR INTENDED REFERENCE USE

C3	FINAL ISSUE - AS CONSTRUCTED	HM	23.10.25
C2	SOAKAWAY MANHOLE AMENDED	HM	07.04.25
C1	CONSTRUCTION ISSUE	HM	04.03.25
ref	revision	by	date

BGH Architects
Consulting Engineers
Quantity Surveyors

21 Silverwell Street
Bolton
BL1 1PR
t: 01204 525321
email: bgh@bolton.co.uk
www.bghbolton.co.uk

Bradshaw Gass & Hope LLP

client
ROBERTSON CONSTRUCTION LTD

project
BLACKLEY FIRE STATION

drawing
**DRAINAGE DETAILS
SHEET 2**

drawn by	DMC	date	MARCH 2025
checked by		date	
scale	N.T.S		A1
dwg no	BFS-BGH-XX-XX-DR-C-0154	rev	C3