


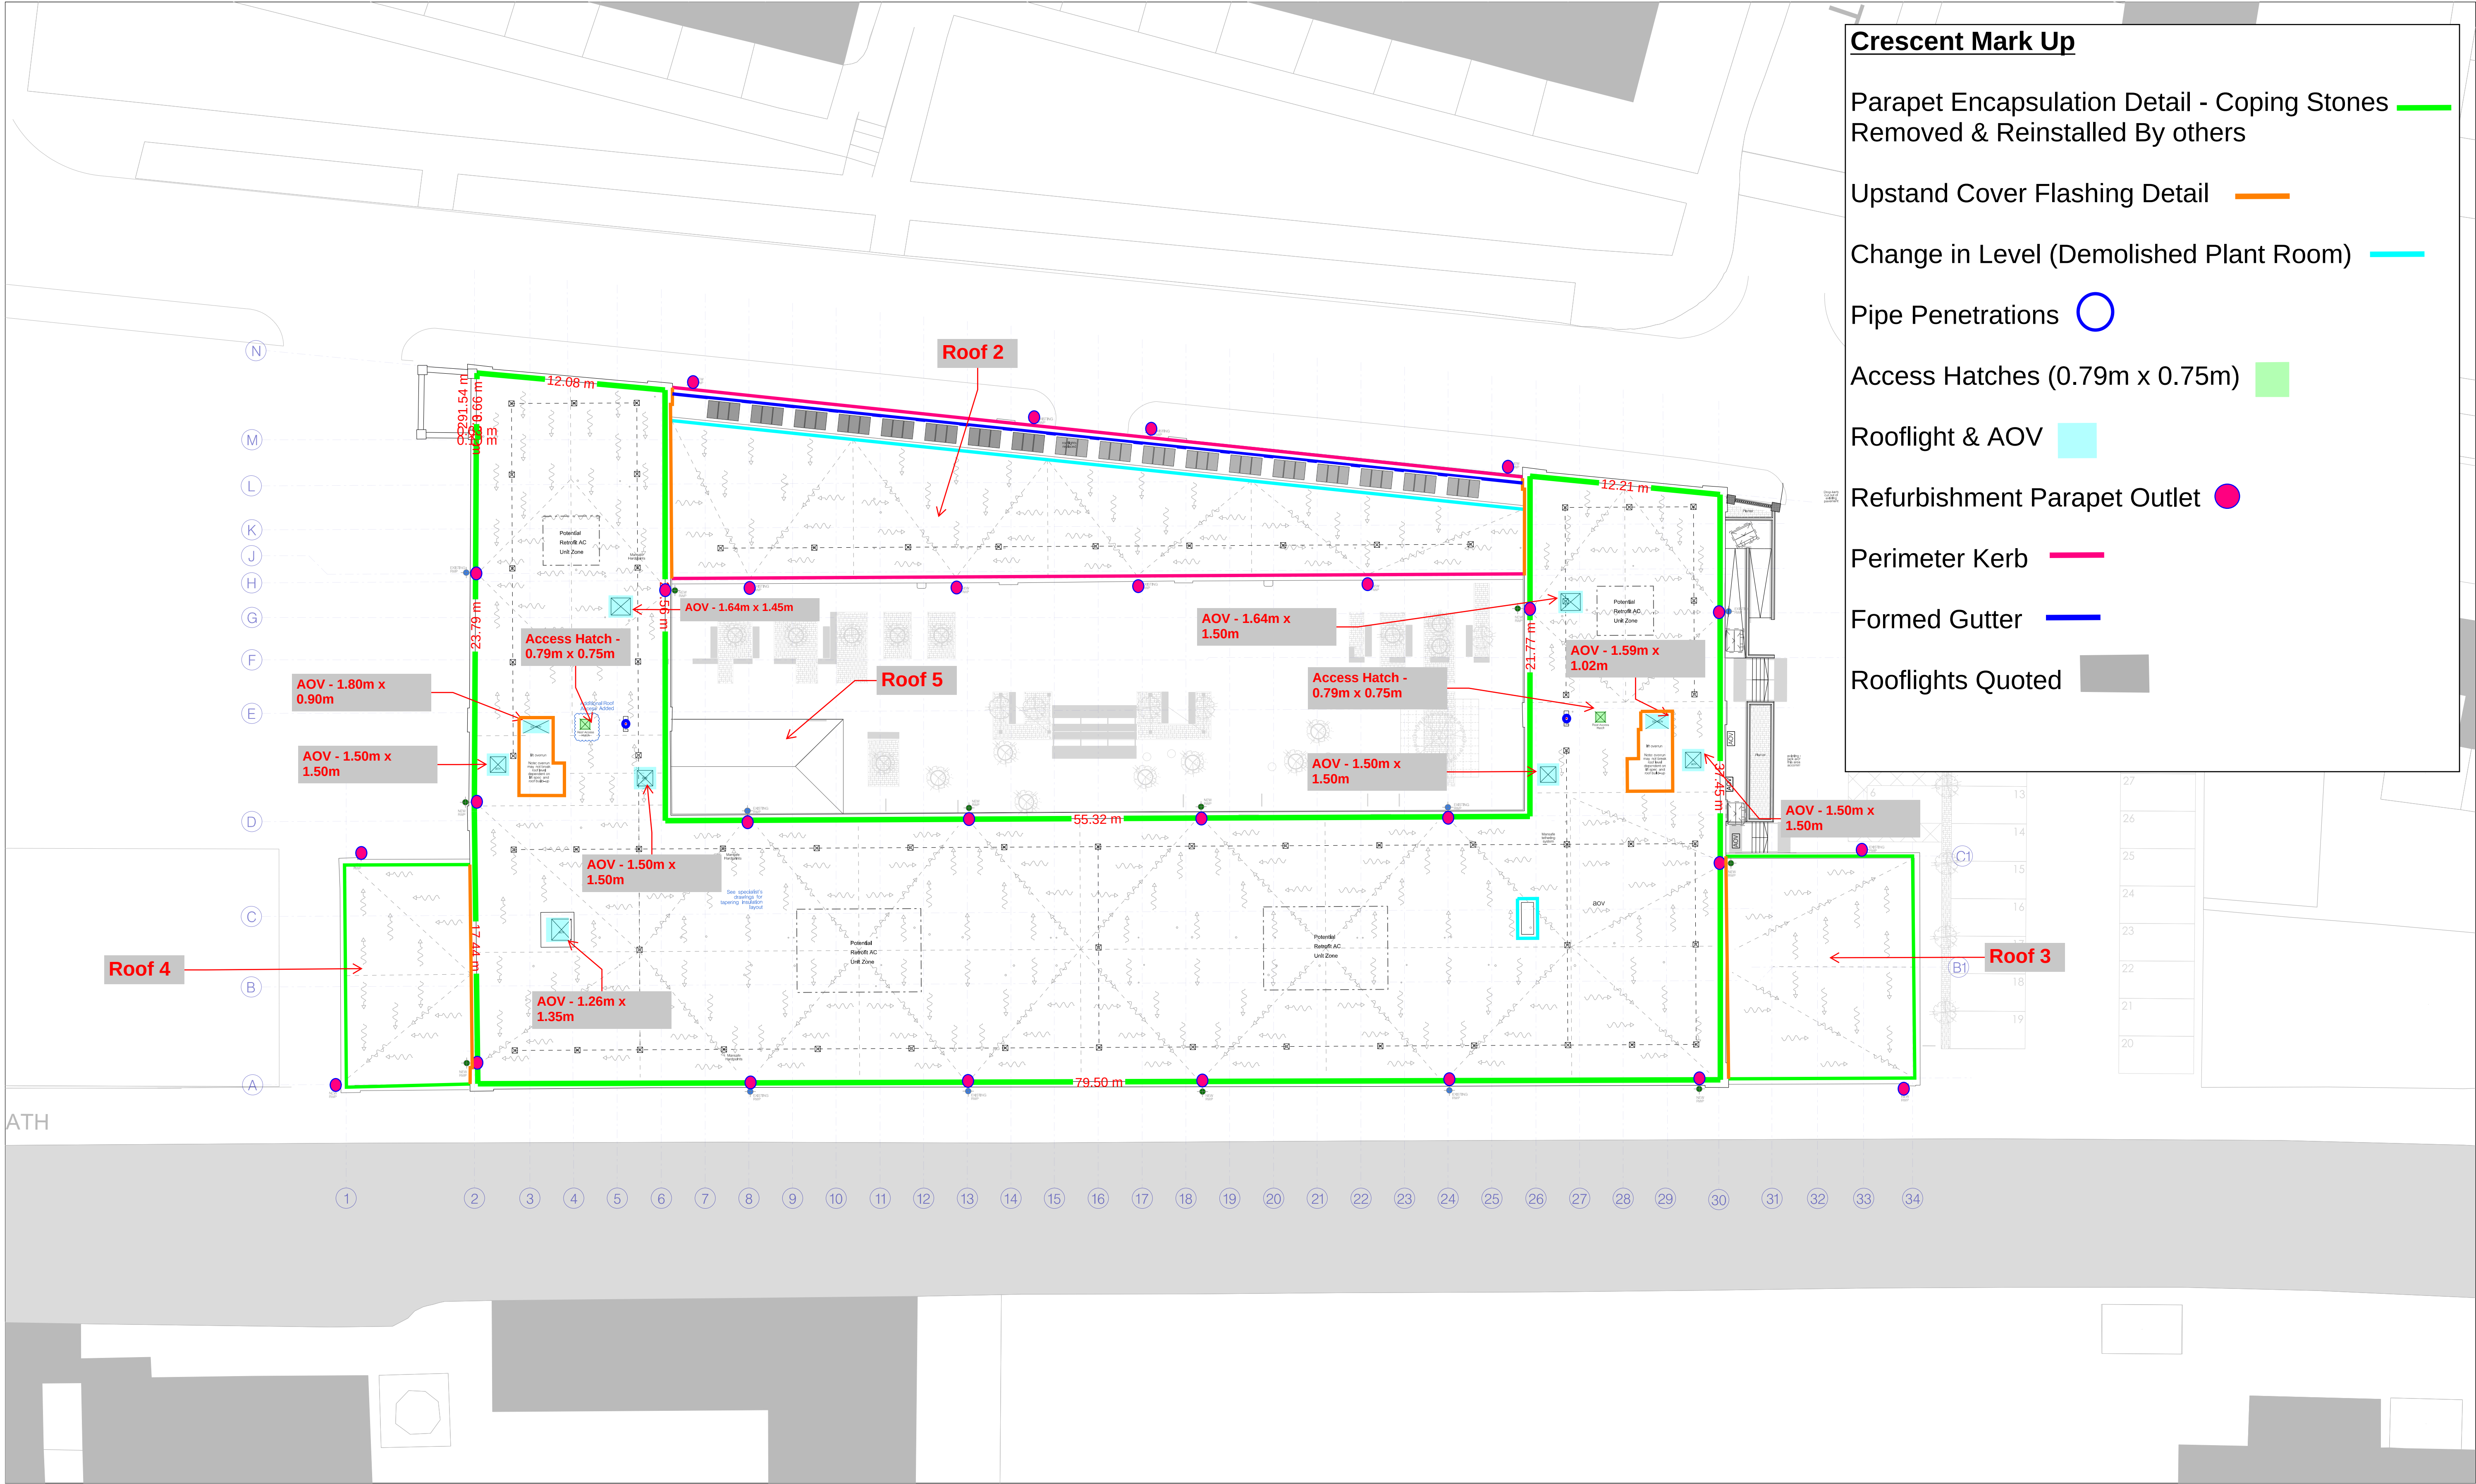

Crescent Mark Up

Parapet Encapsulation Detail - Coping Stones Removed & Reinstalled By others

Upstand Cover Flashing Detail

Change in Level (Demolished Plant Room)

Pipe Penetrations

Access Hatches (0.79m x 0.75m)

Rooflight & AOV

Refurbishment Parapet Outlet

Perimeter Kerb


Formed Gutter

Rooflights Quoted

hodd+partners
SGI Studios
1 Kelso Place
Manchester M15 4LE
t: +44(0)161 832 9842
e: mail@hoddandpartners.com
w: www.hoddandpartners.com

revisions + notes:
P1 03/08/2023 FIRST ISSUE
P2 08/11/2023 Smoke vent outlets updated, Lift overruns amended, Drainage falls added.
P3 07/05/2024 Mansafe system anchor points added to replace parapet railing, Indicative existing and new RWP positions.
P4 25/10/2024 A/C retrofit zones added, AOV moved, additional access hatch at Core 1
P5 05/02/2025 Team Issue

DO NOT SCALE
Work to annotated dimensions only.
Read drawing in conjunction with relevant specification,
Structural Engineers' and Services Engineers' drawings.
Confirm all dimensions before commencement of any
work on site or fabrication.

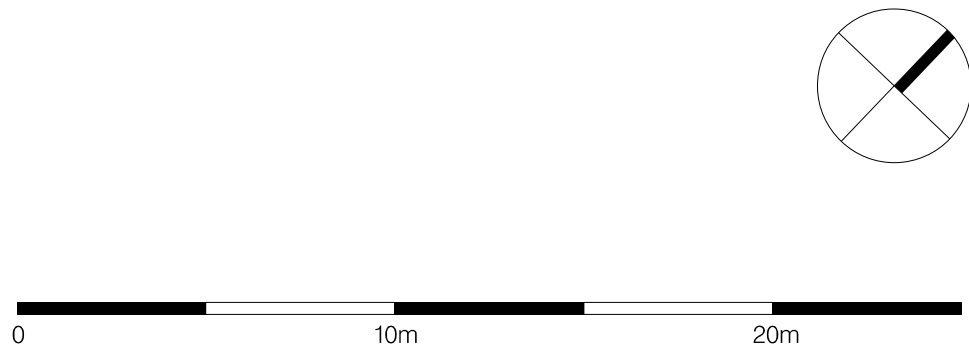

client: ARROWSMITH BRUNSWICK SQUARE LTD. date: NOV 2024
project: BRUNSWICK MILL DEVELOPMENT PHASE 1 scale: 1:200 @A1 drawn by: TC
title: PROPOSED ROOF PLAN drawing number: L(20)207
status: STAGE 4 - FOR INFORMATION job number: 0586 revision: P5