




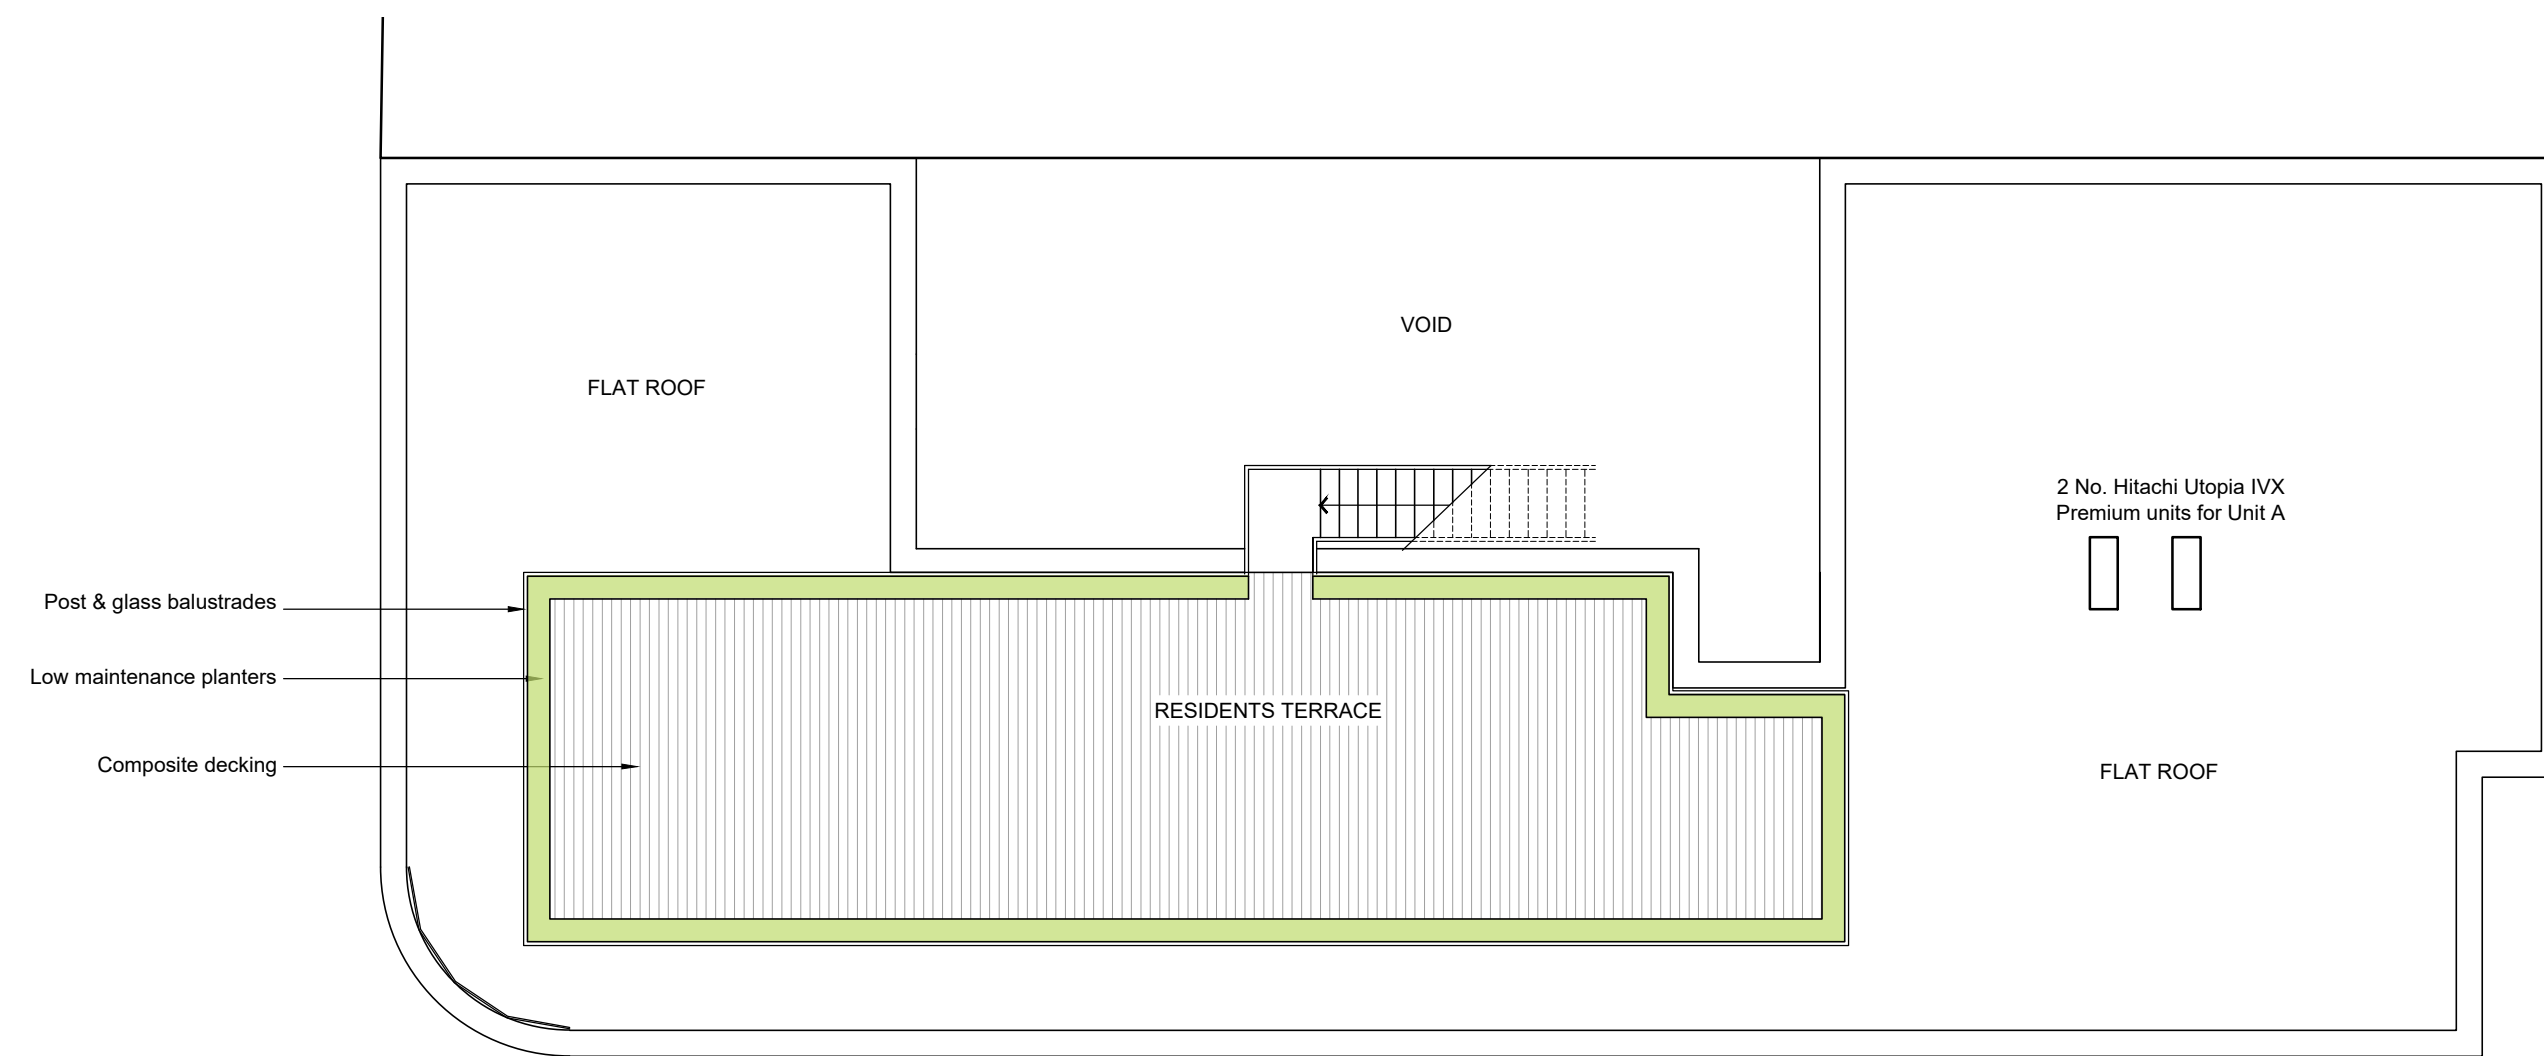


ROOF TERRACE PLAN 1:100

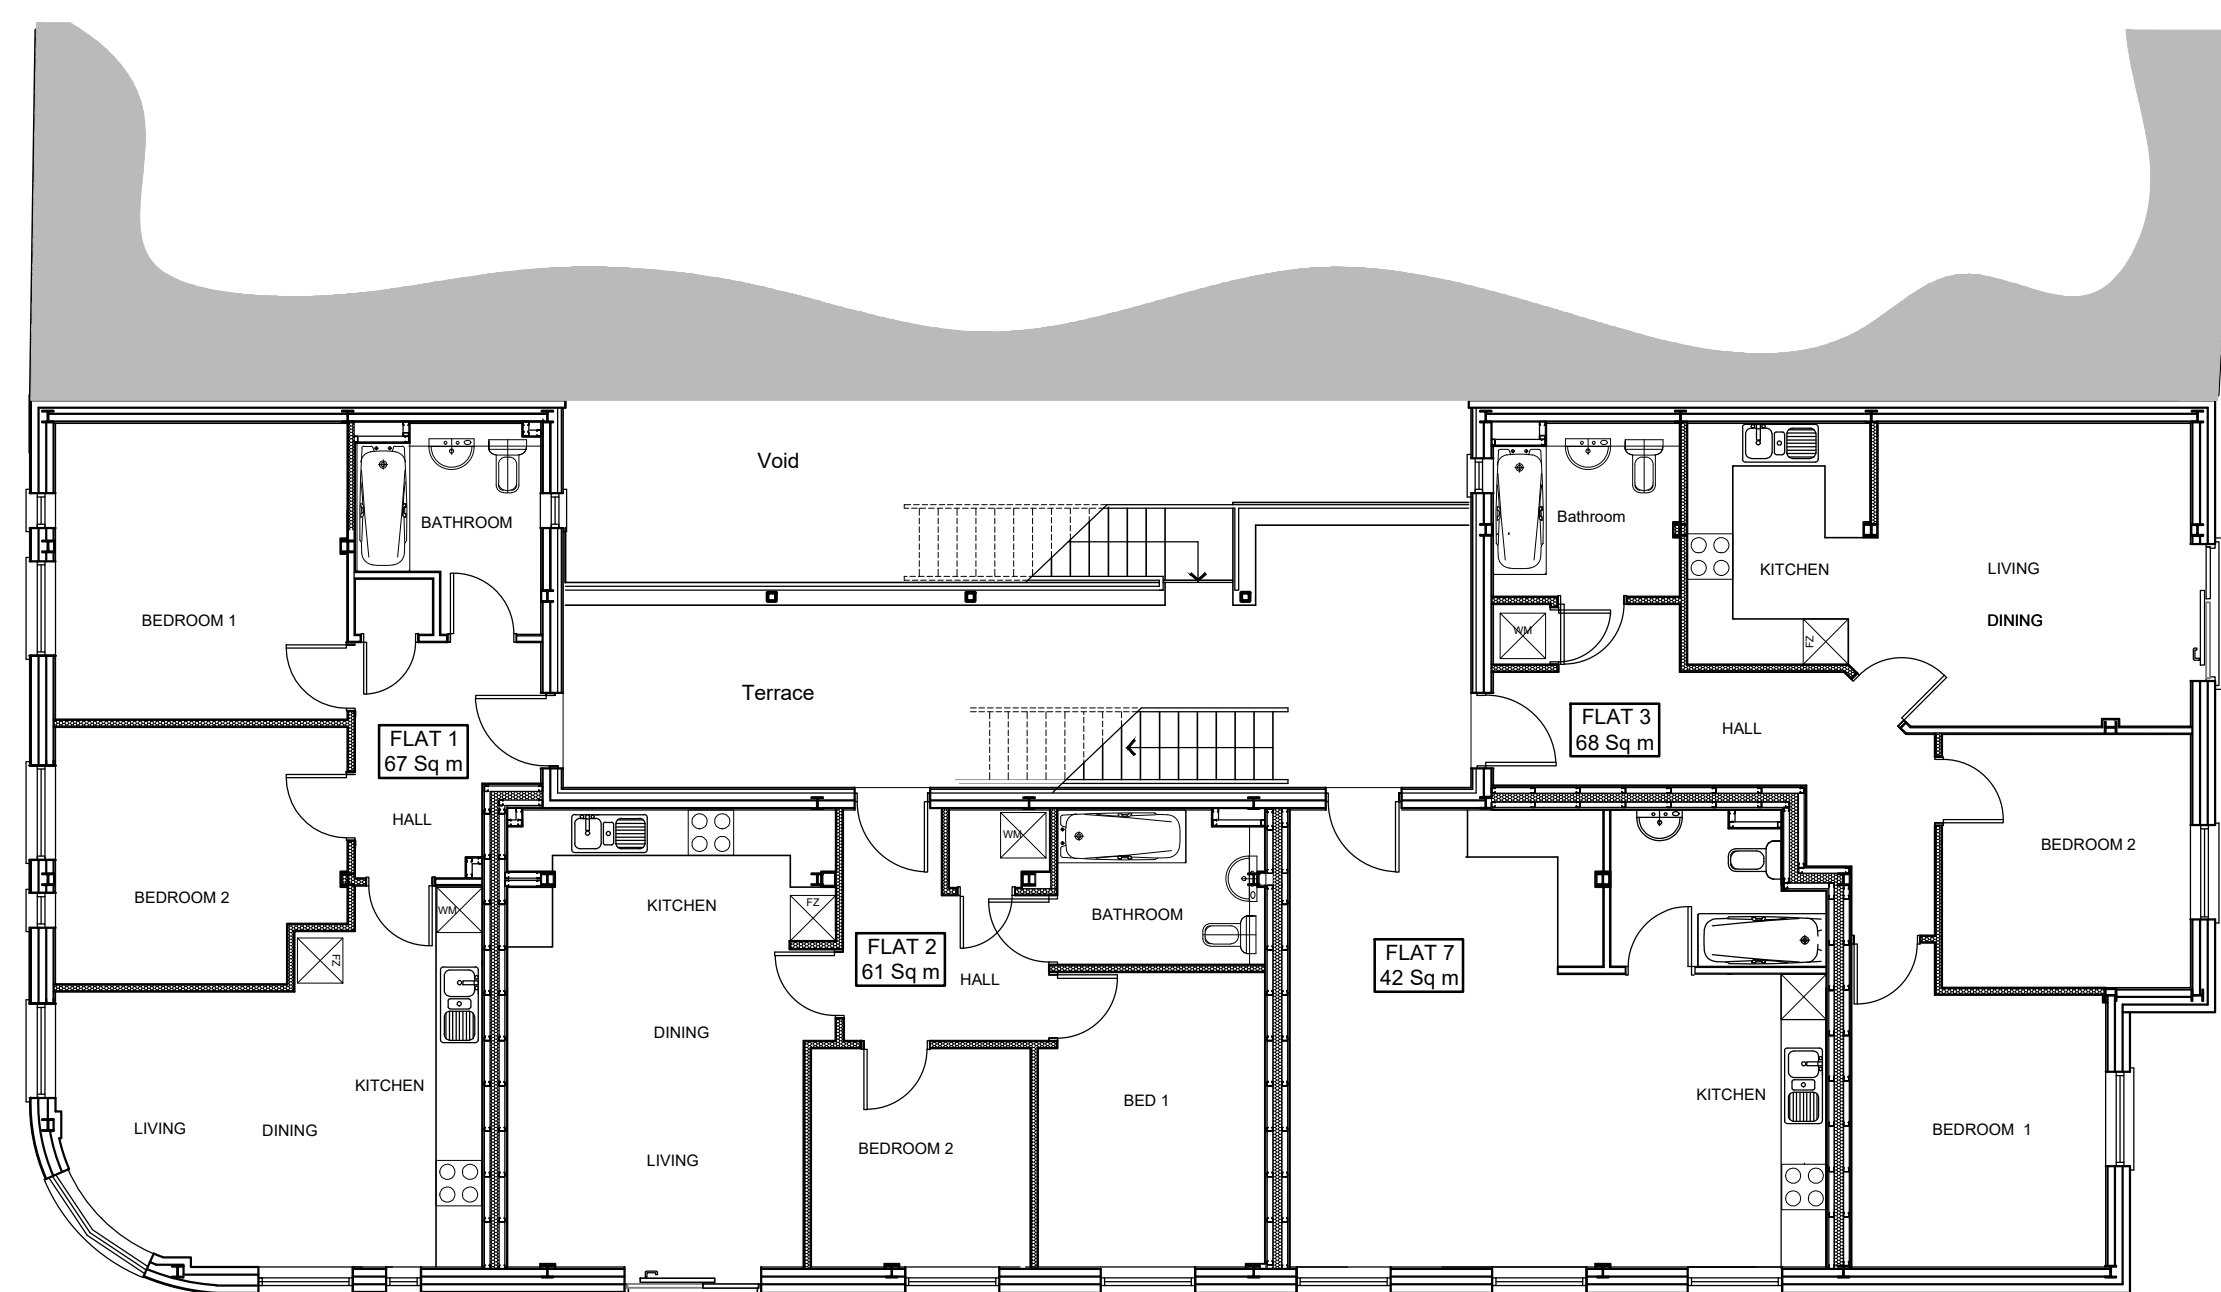

FIRST FLOOR PLAN 1:100

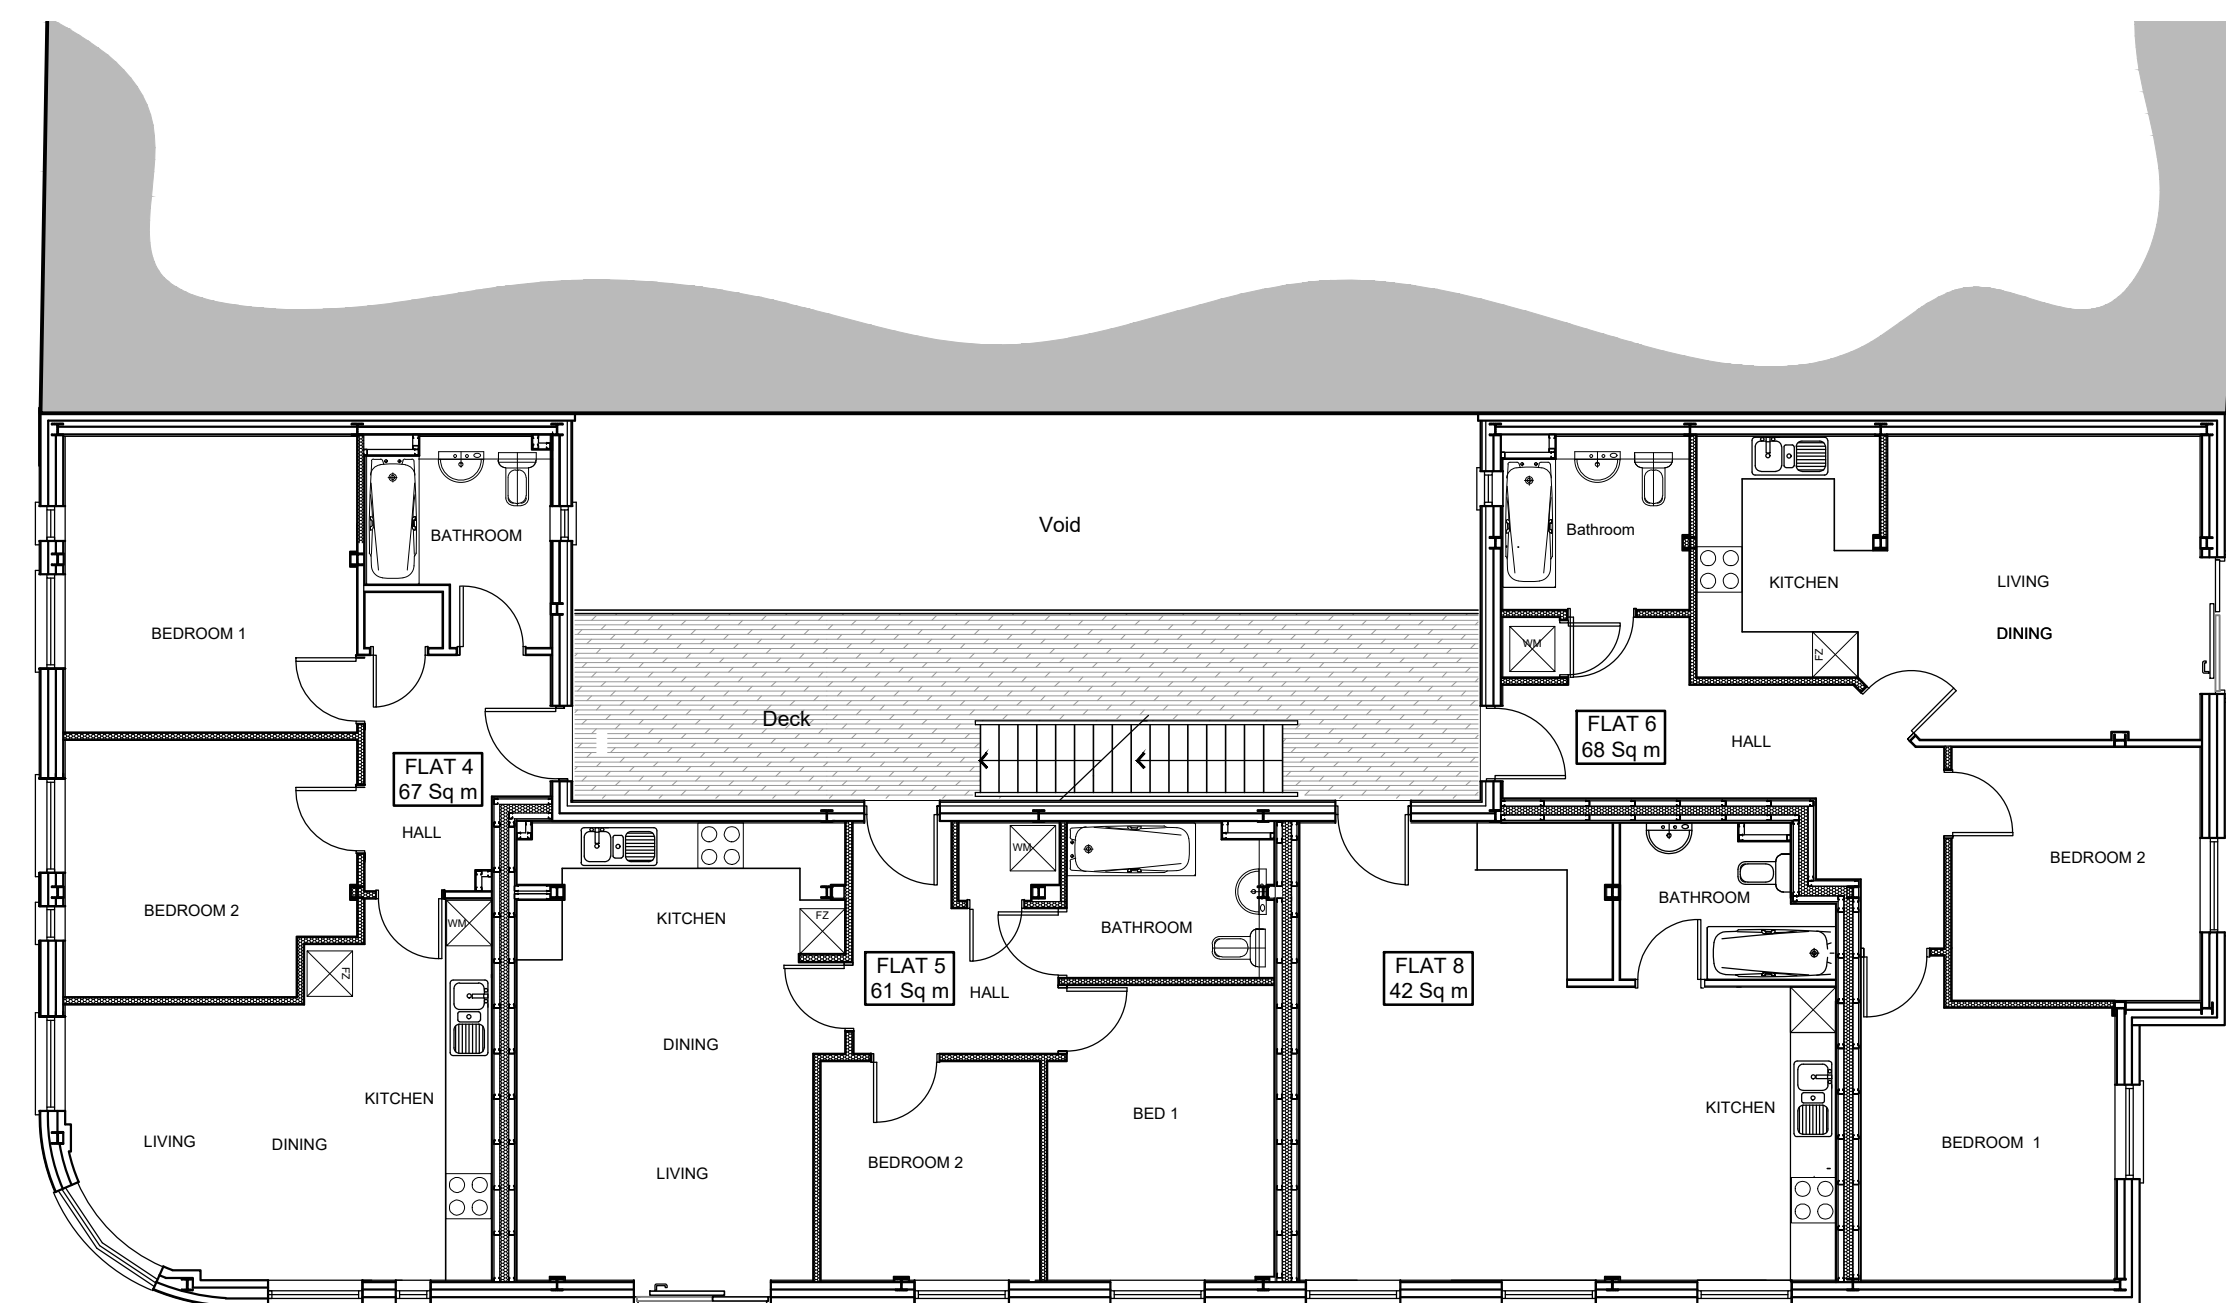

SECOND FLOOR PLAN 1:100

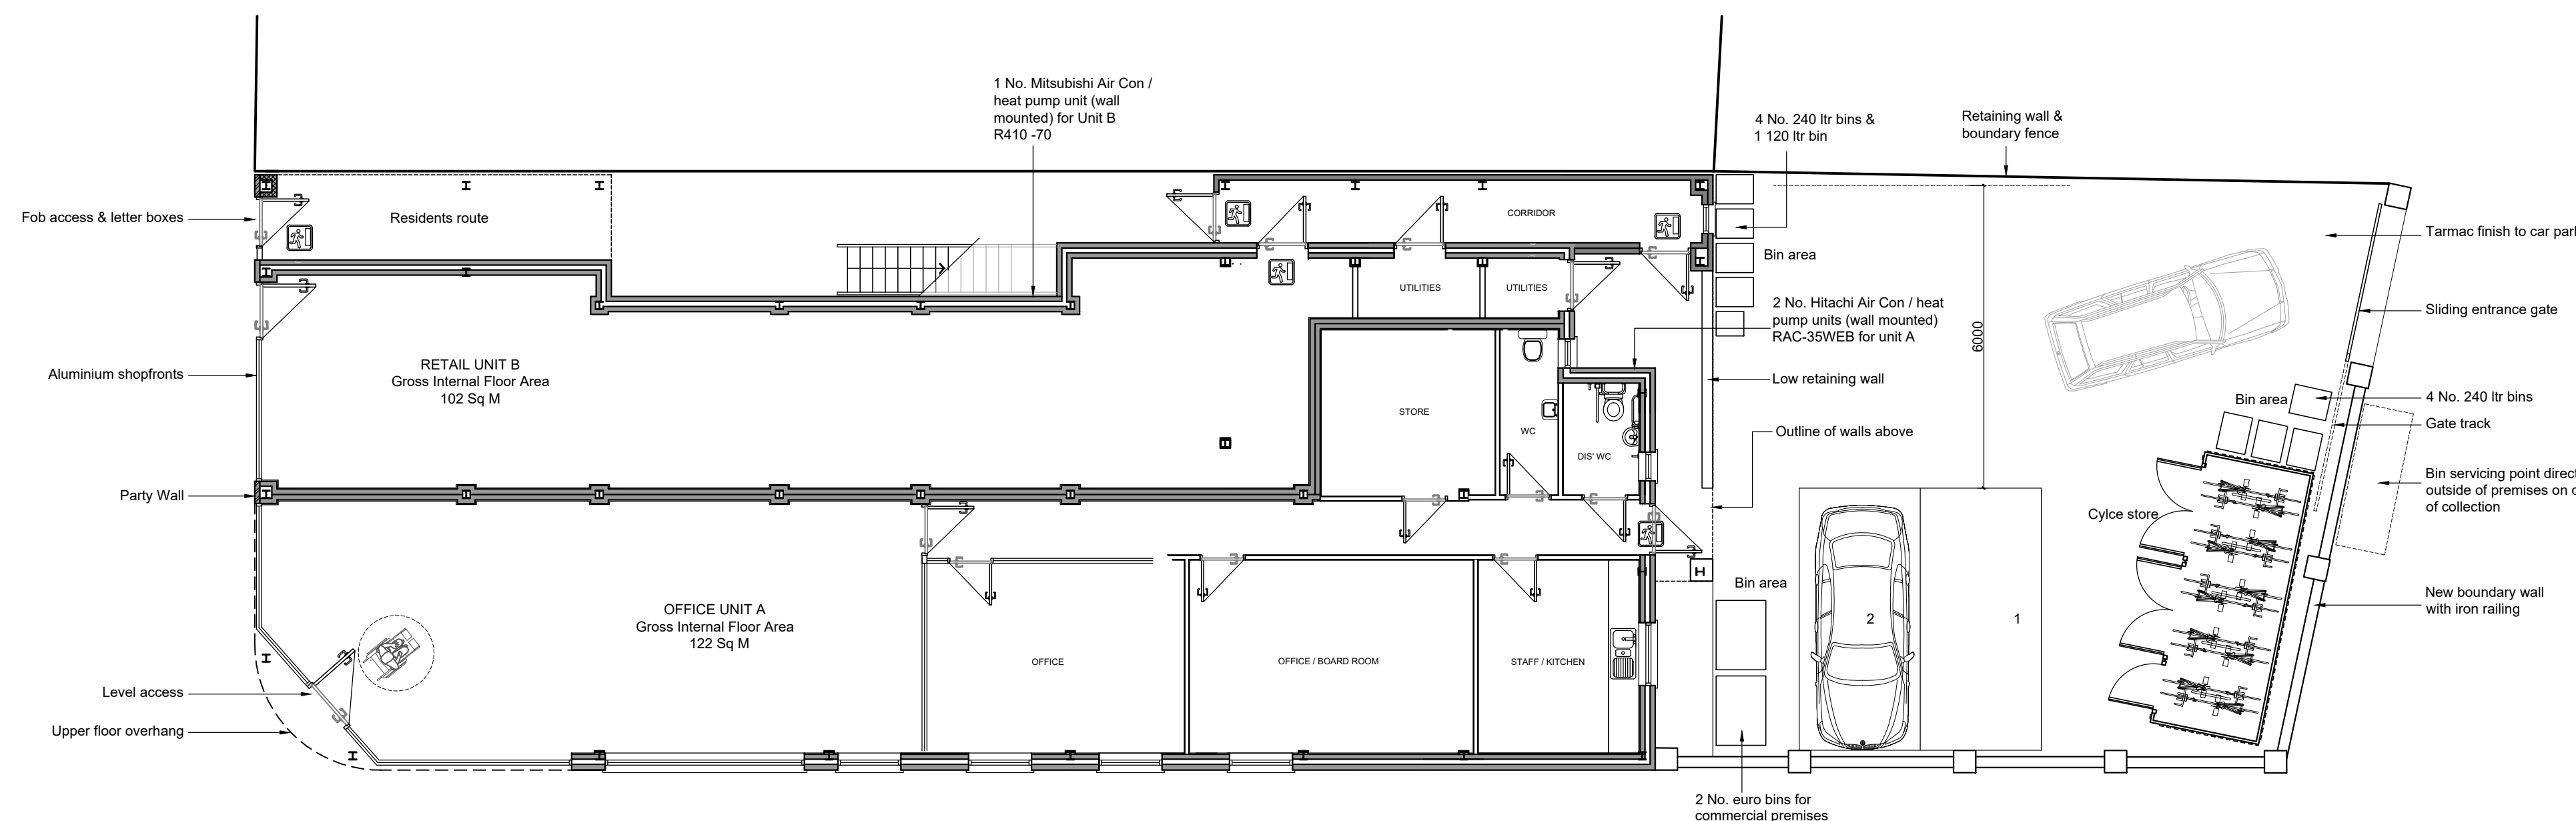

SITE / GROUND FLOOR PLAN 1:100



Location Plan 1:1250

Rev.	Date	Description
A	01/05/20	Minor revision to bin area, bicycle store & terrace balustrade
B		
C		
D		
E		

archirama Architecture & project management Archirama Ltd 3 Park Gate Ave, Withington, Manchester M20 3BZ Tel: 07378 171 006, email: mail@archirama.co.uk	
Client	ROYAL TRAVEL
Project / Site	Land adjacent to 587C Stockport Road, Longsight Manchester
Drawing Title	As built site & floor plans
Client Ref	PR
Drawn By	01/07/25
Checked By	01/07/25
Scale	1:100@A1
Drawing No	PL04
Sheet	A