


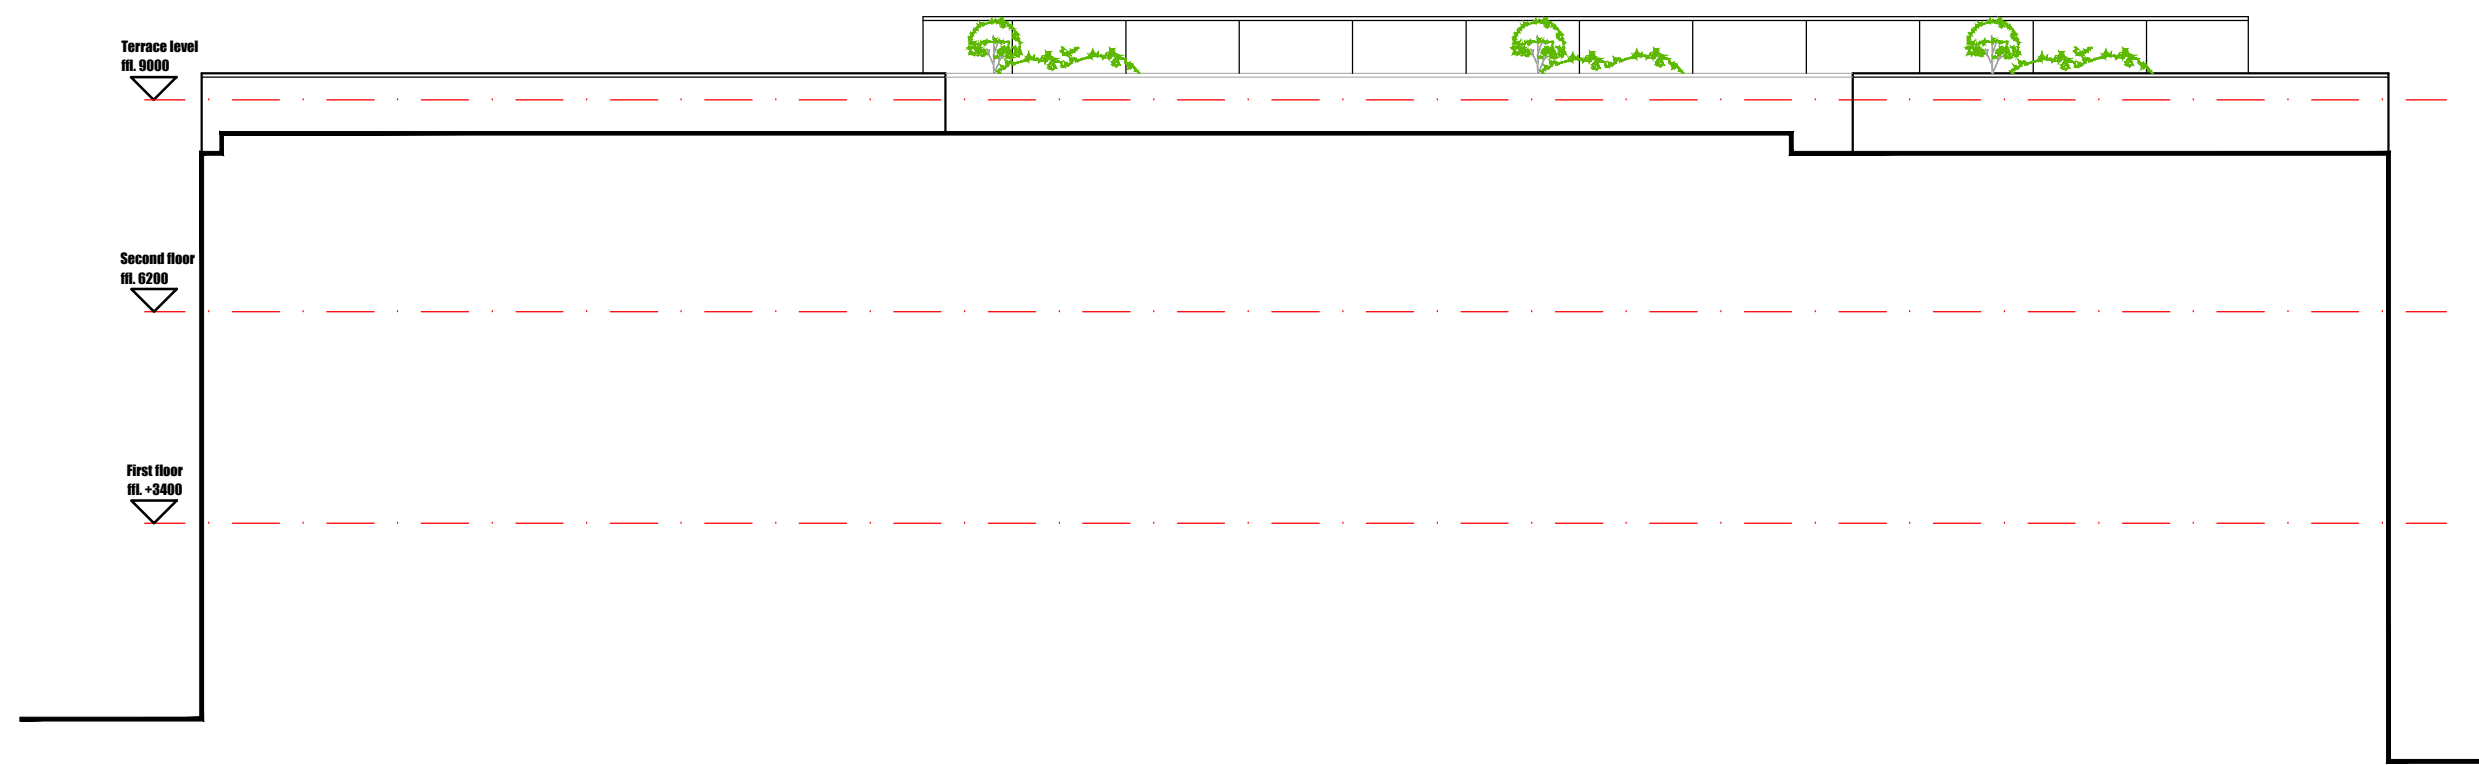


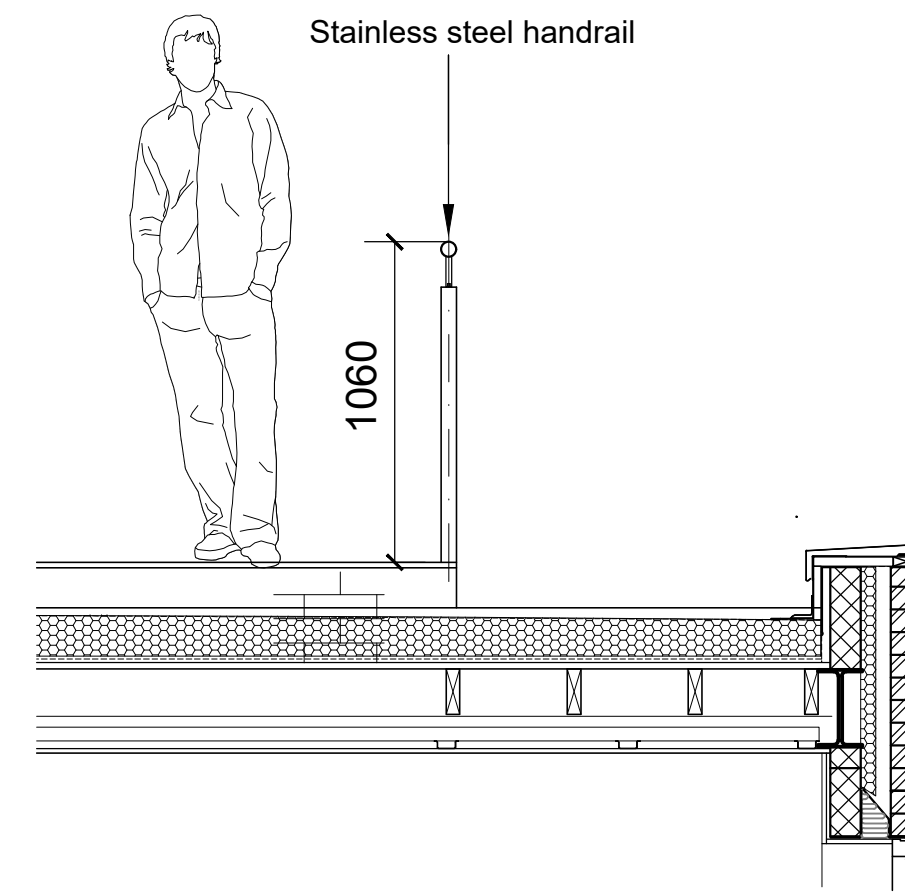


CROSS SECTIONAL SIDE (NORTH) ELEVATION 1:100

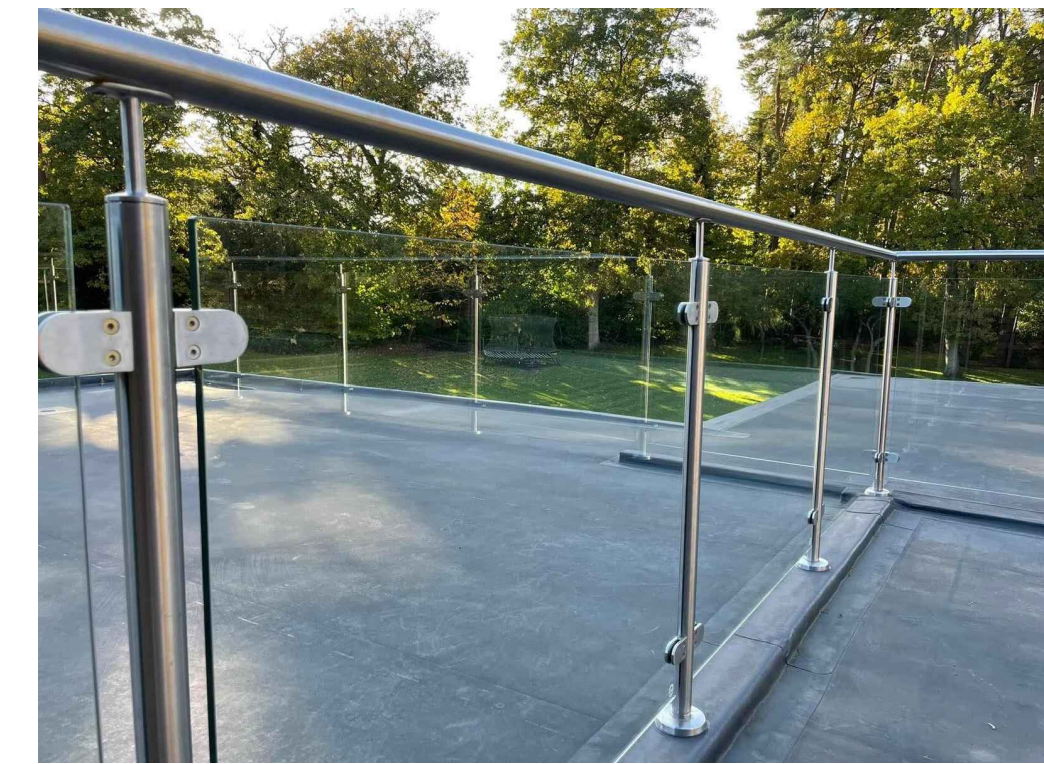


TERRACE BALUSTRADE DETAIL 1:25

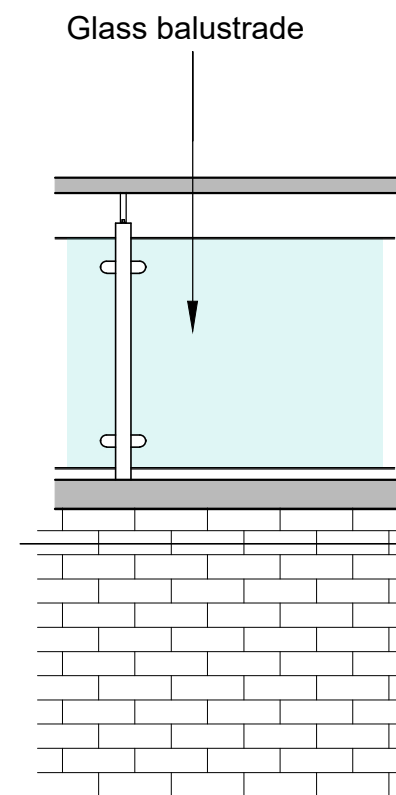


BALUSTRADE DETAIL NTS

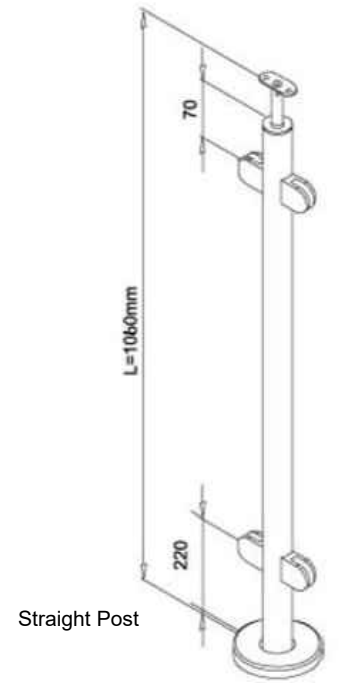


FRONT (SOUTH WEST) ELEVATION 1:100

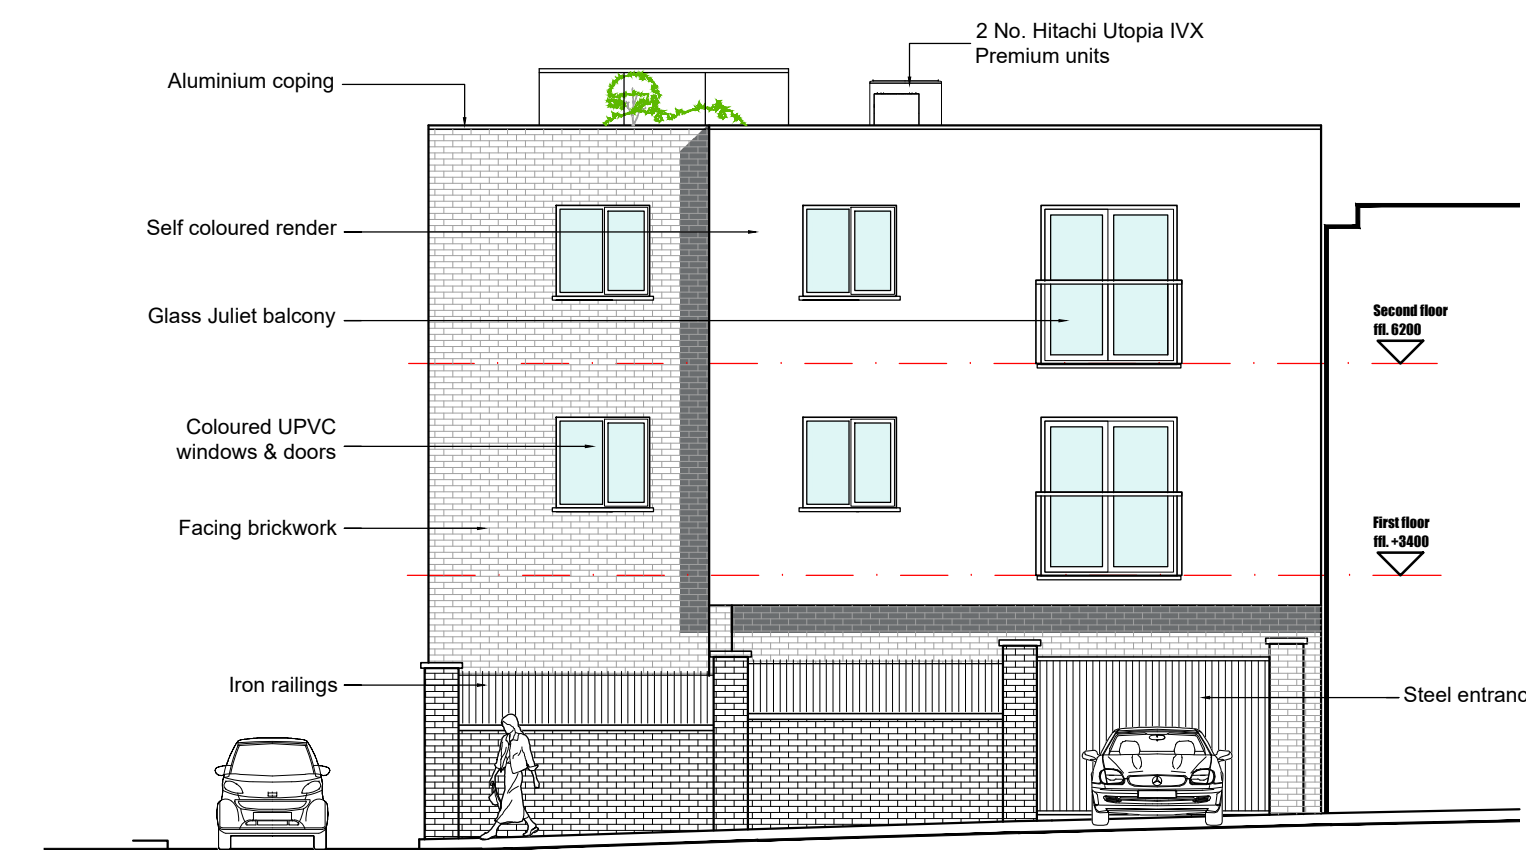


REAR (NORTH EAST) ELEVATION 1:100

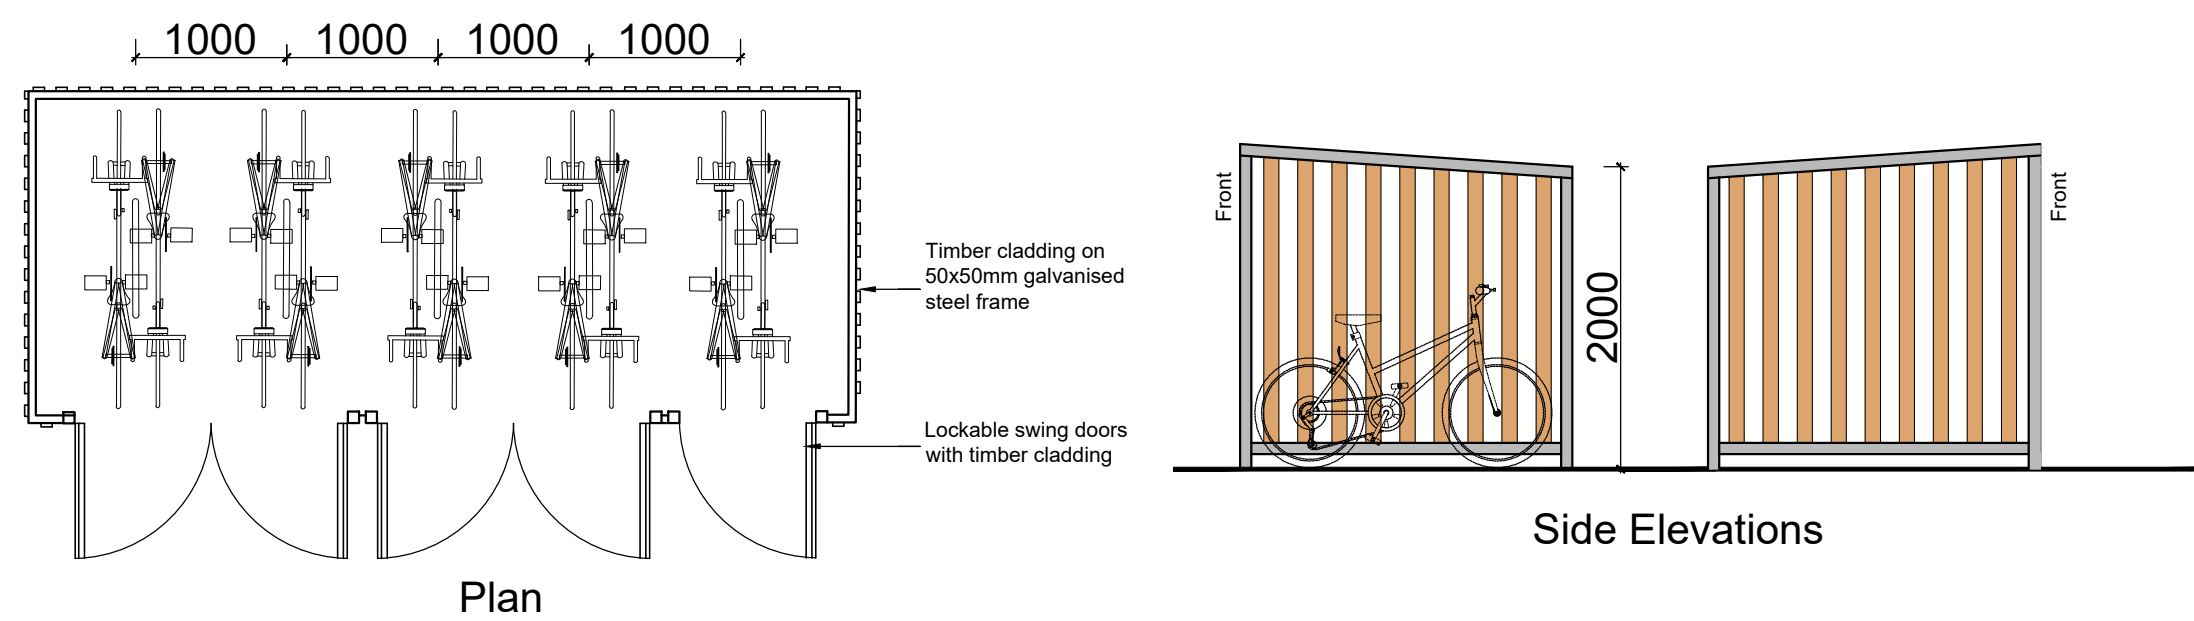

BICYCLE STORE 1:50

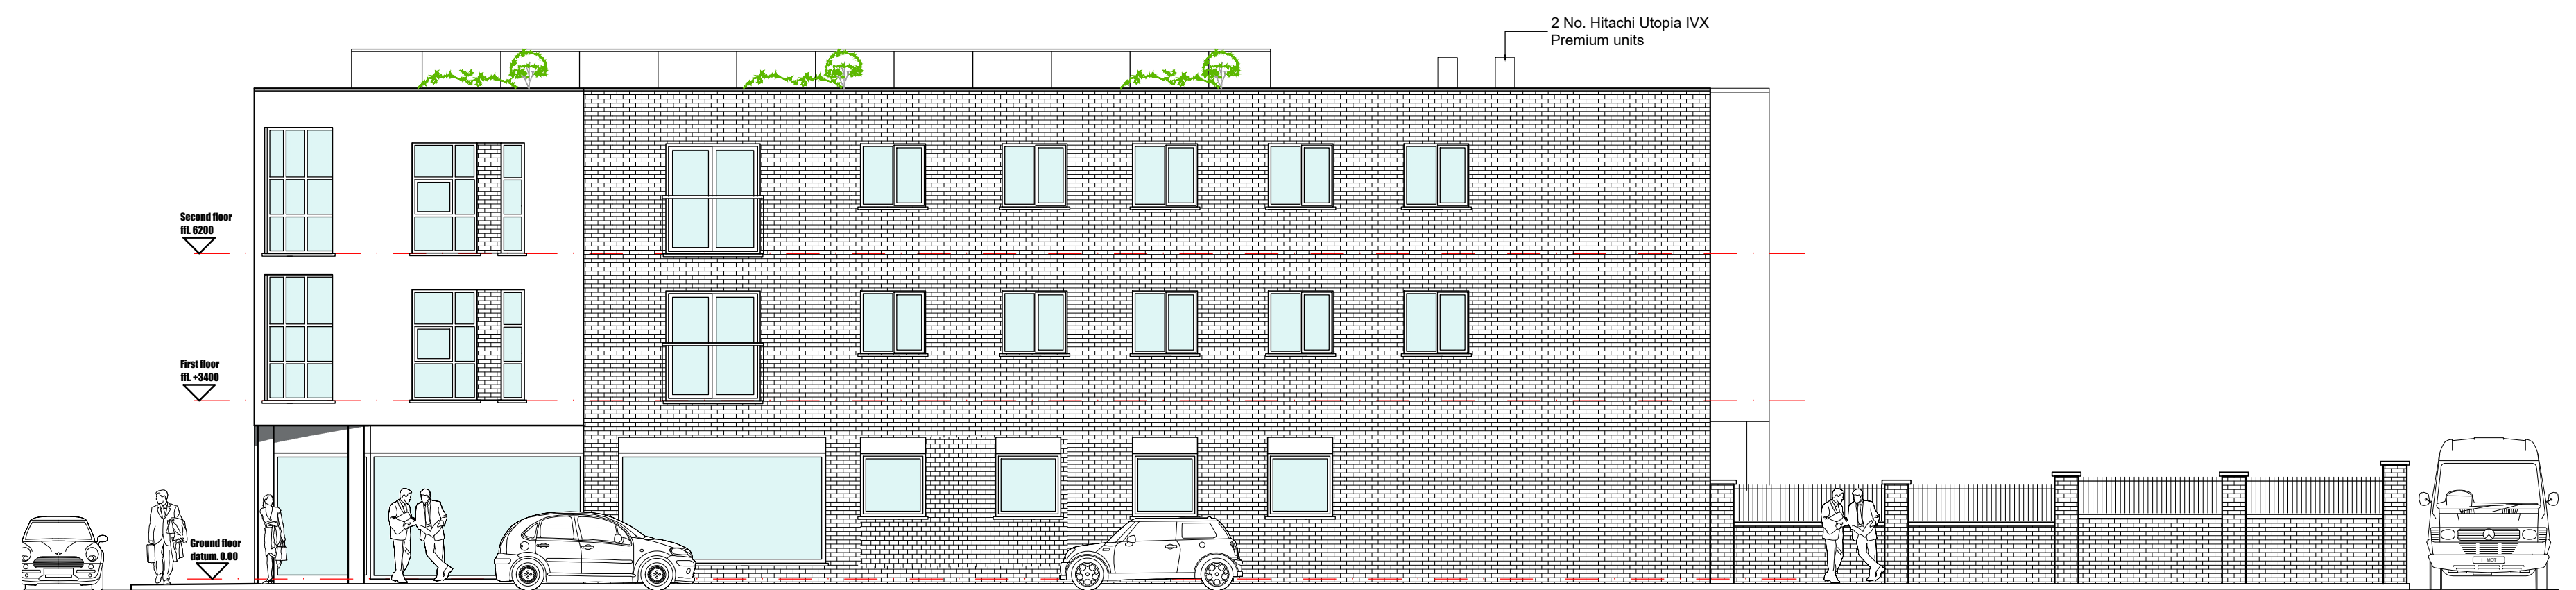

BROOK TERRACE (SOUTH EAST) ELEVATION 1:100

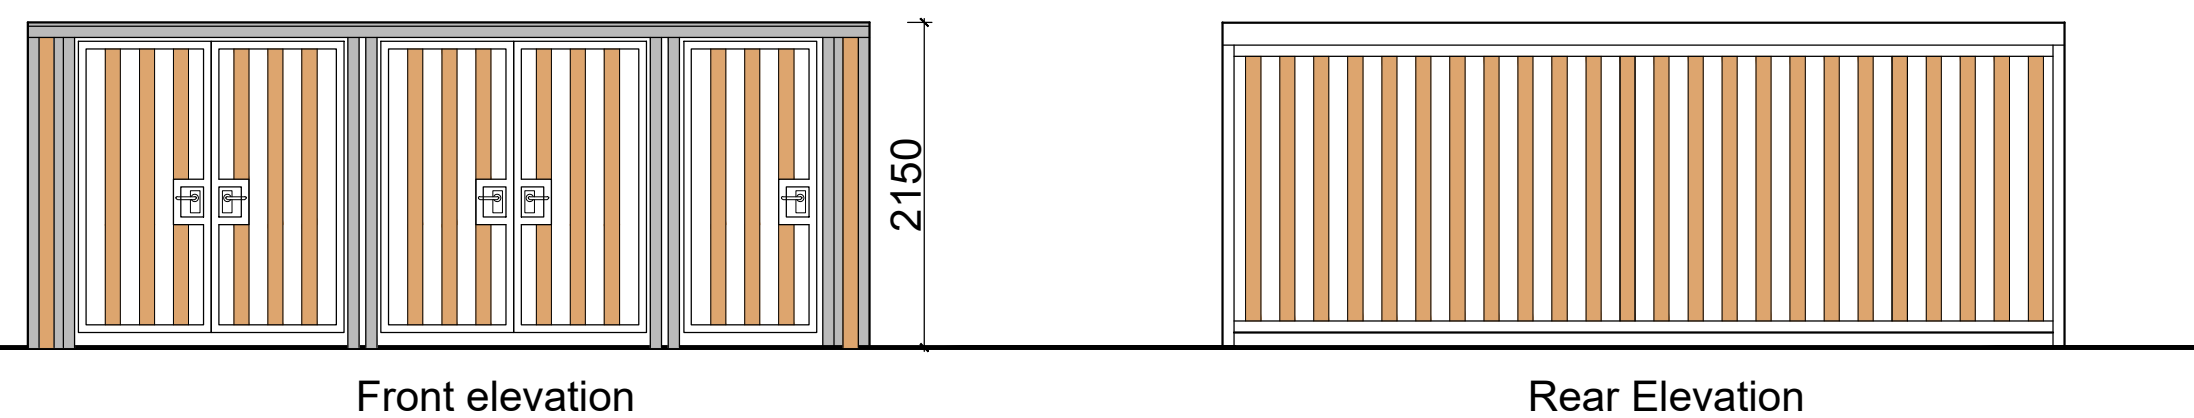

Rev.	Date	Description
A	01/05/20	Minor revision to terrace balustrade to suit comments by planner
B		
C		
D		
E		

archirama Architecture & project management Archirama Ltd 3 Park Gate Ave, Withington, Manchester M20 3BZ Tel: 07793 171 006 email: mail@archirama.co.uk	
Client	ROYAL TRAVEL
Project Site	Land adjacent to 587C Stockport Road, Longsight Manchester
Drawing Title	As built Elevations & balustrade & bicycle store details
Drawn By	FR
Checked By	01/07/25
Scale	1:100@A1
Drawing No	PL05
Sheet	A