




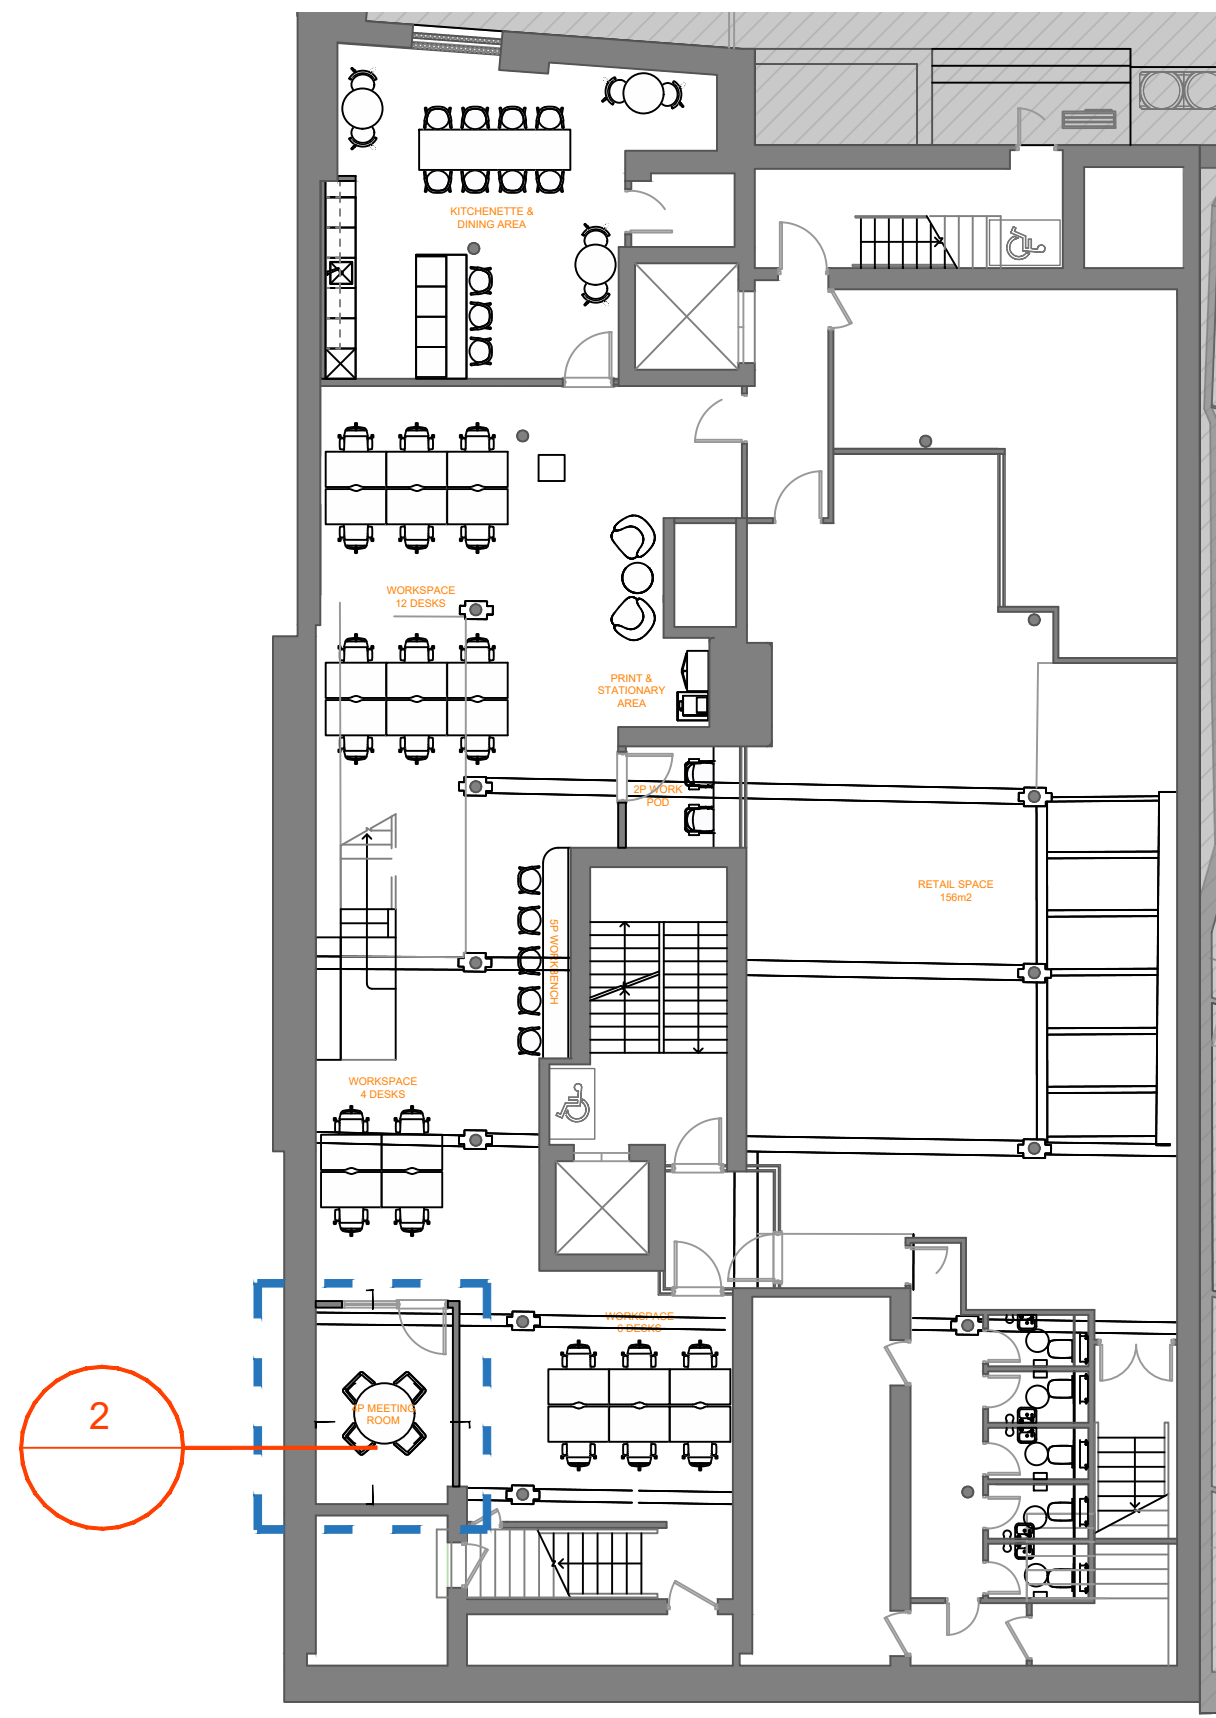


1 LOWER GROUND FLOOR PLAN
SCALE: 1:150 @A1

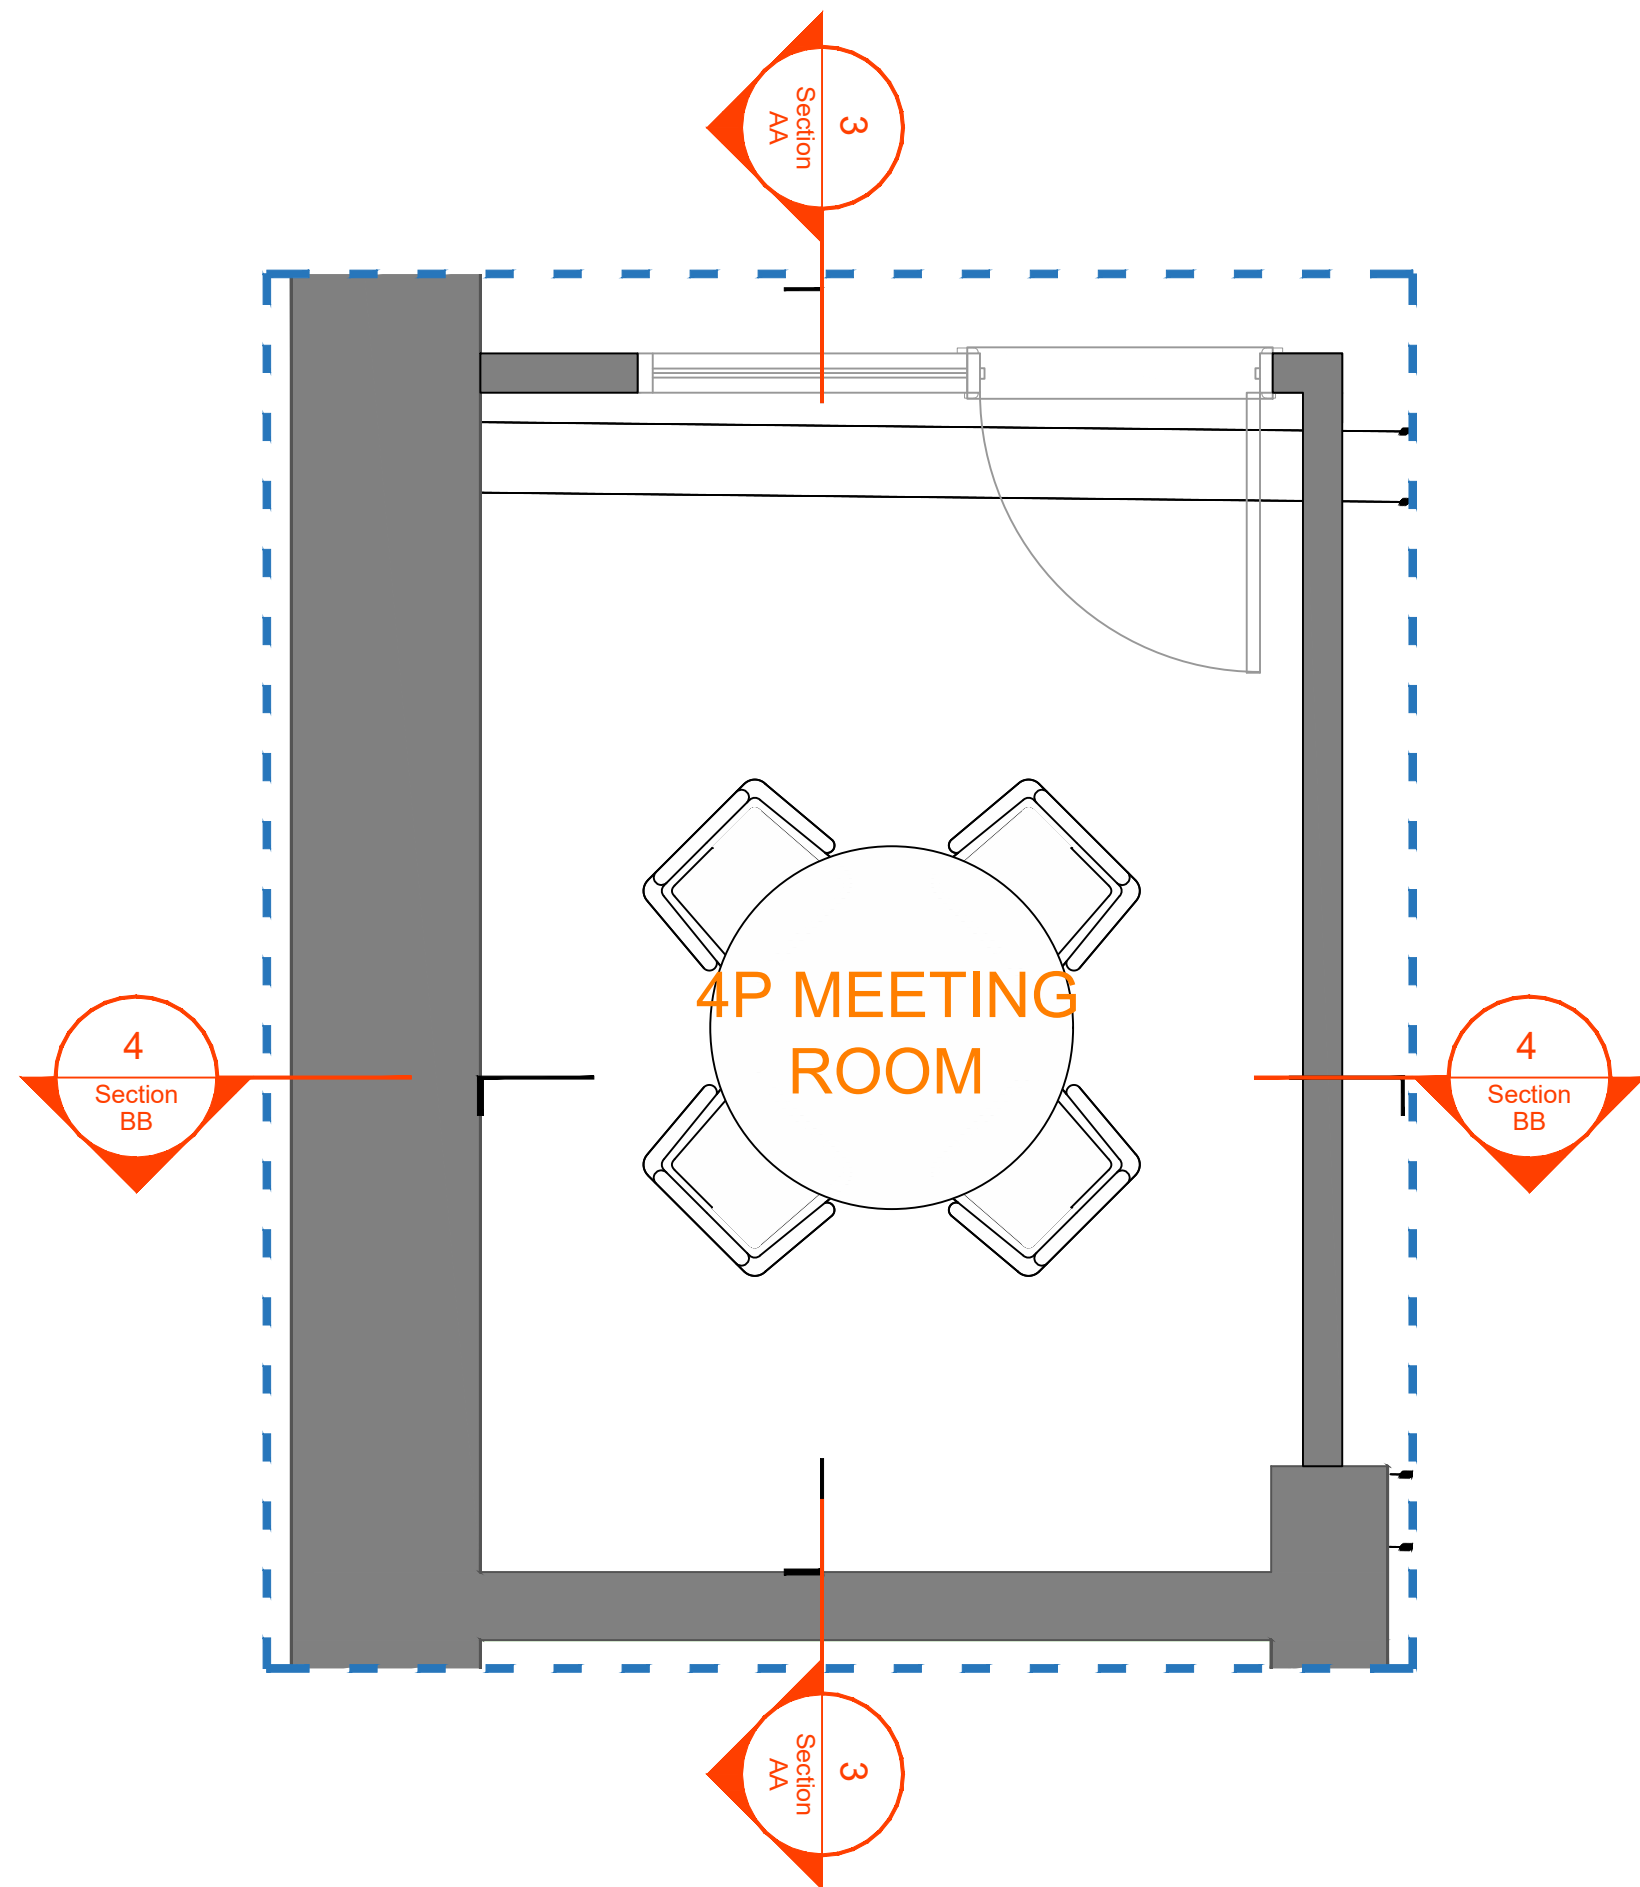


2 LGF MEETING ROOM GENERAL ARRANGEMENT PLAN
SCALE: 1:25 @A1

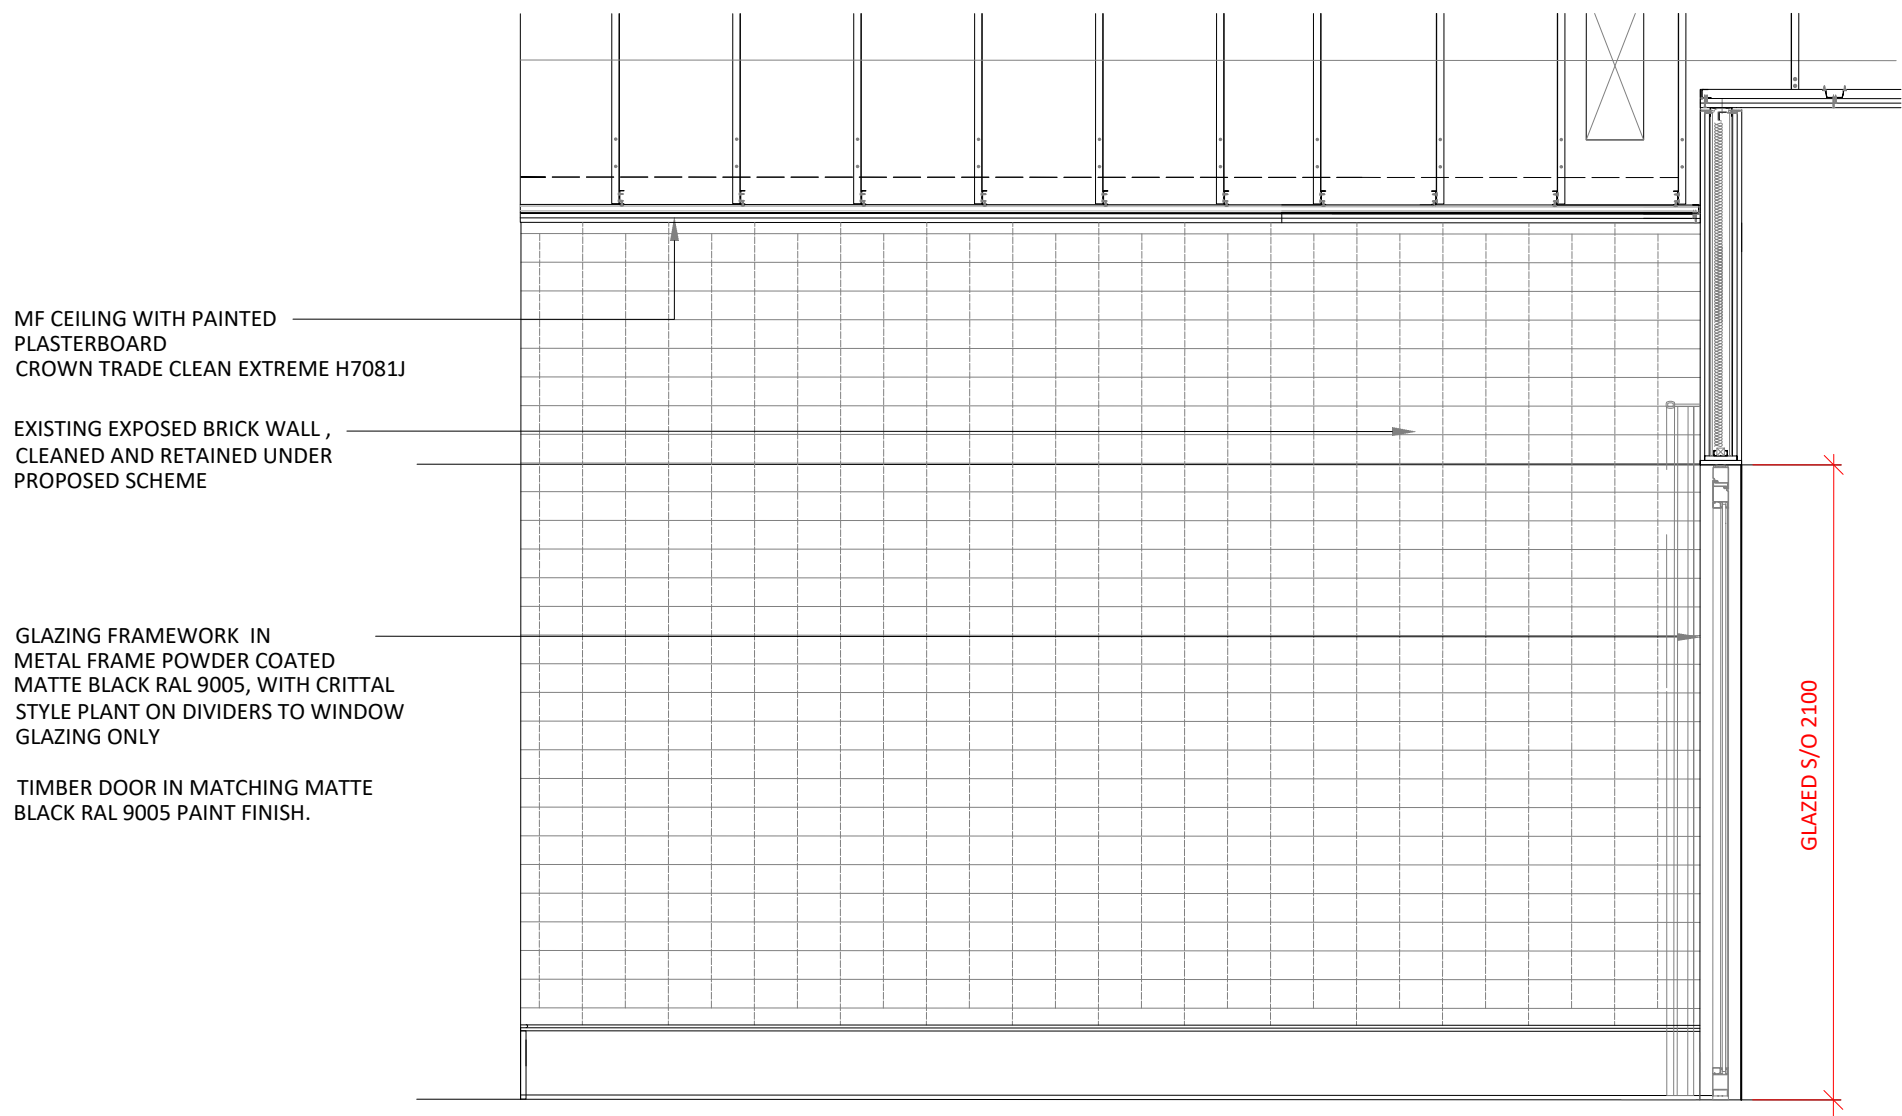

3 LGF MEETING ROOM SECTION AA
SCALE: 1:25 @A1

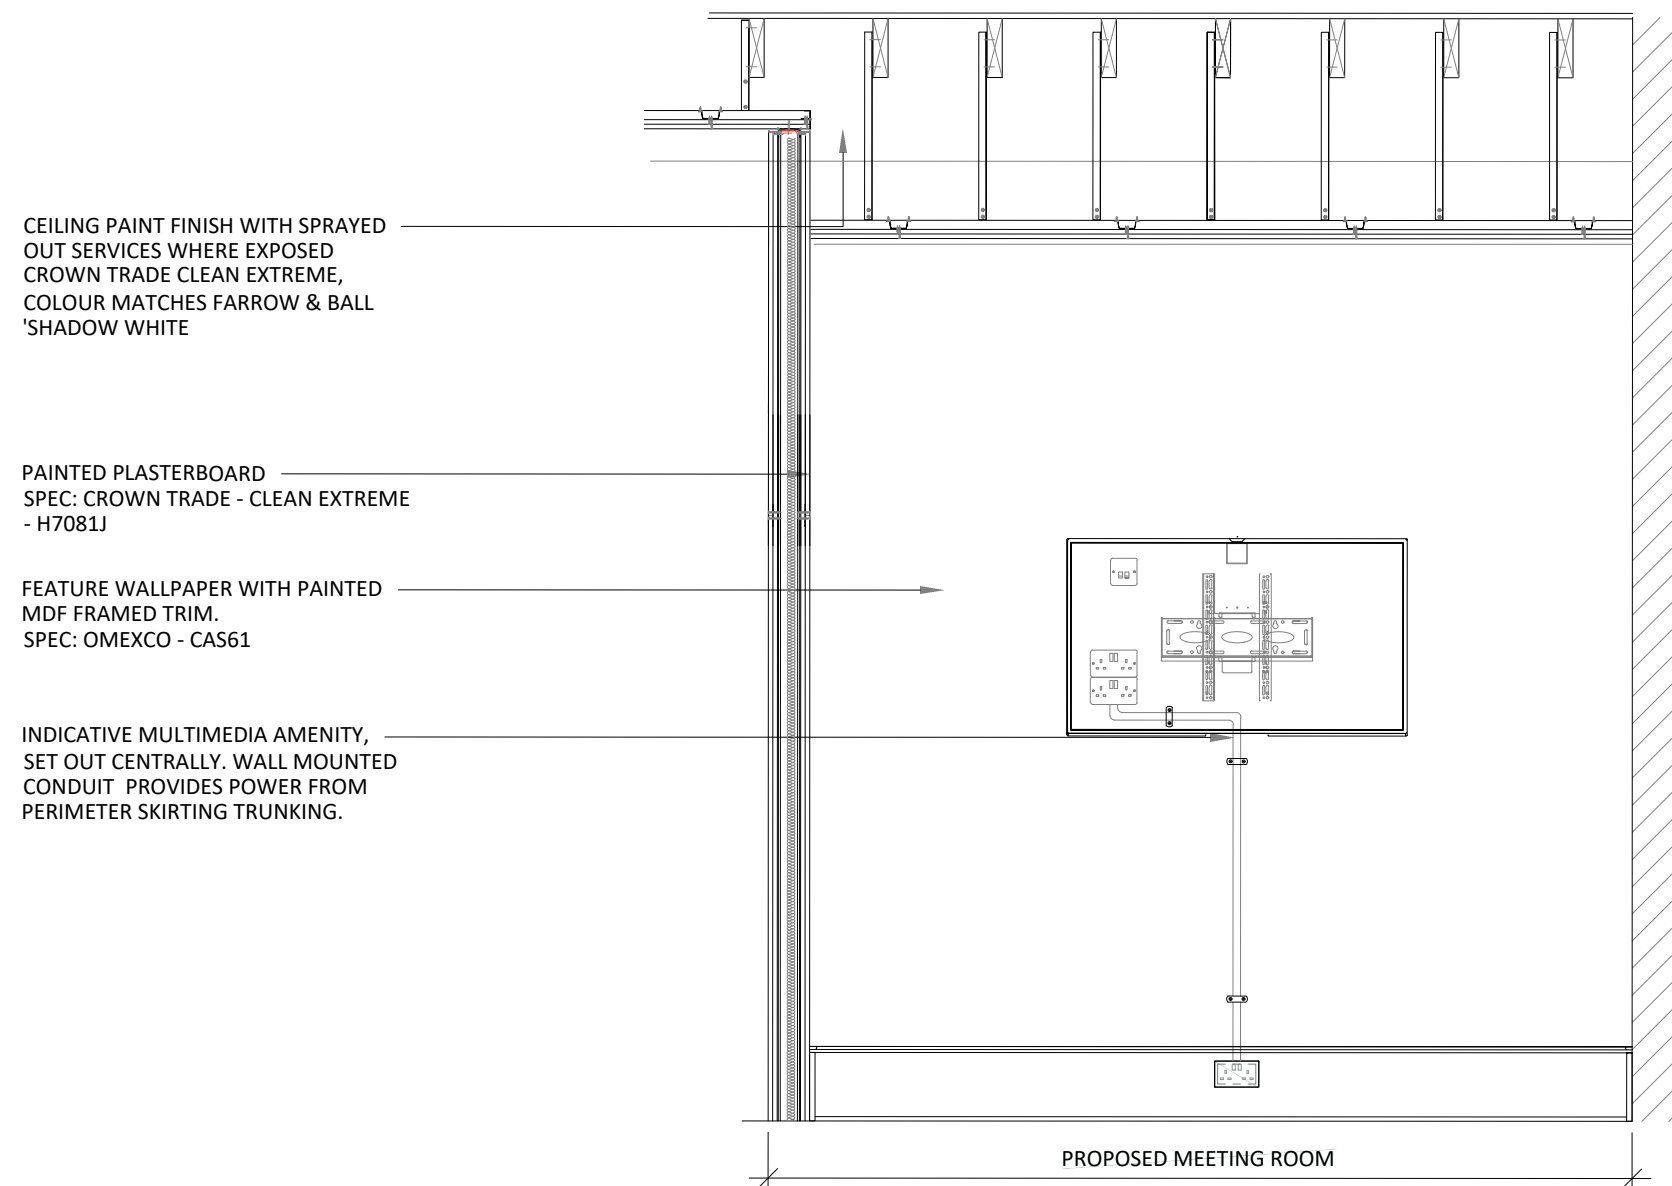


4 LGF MEETING ROOM SECTION BB
SCALE: 1:25 @A1

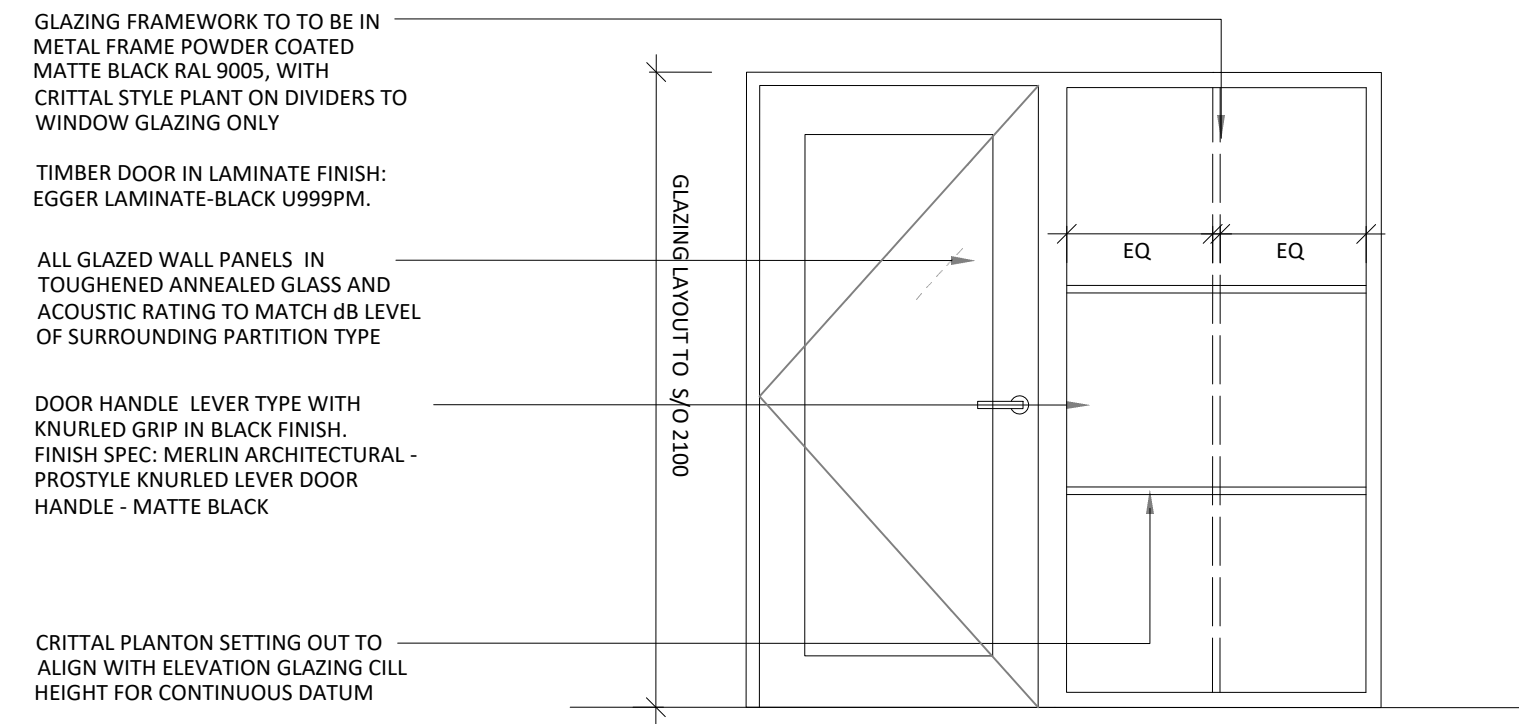

5 LGF MEETING ROOM GLAZING ELEVATION A
SCALE: 1:25 @A1

P01	FIRST ISSUE	24.09.26
REV	DESCRIPTION	DATE

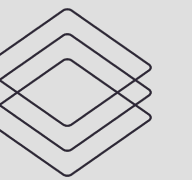

CubicWorks

CUBICWORKS LTD, A COMPANY REGISTERED IN ENGLAND & WALES,
REGISTRATION NUMBER 12154582

AS BUILT

PROJECT MANAGER:	DATE:
S.A.	24.09.26

DRAWING ADDRESS:
113-115 PORTLAND STREET
LOWER GROUND FLOOR

DRAWING TITLE:
MEETING ROOM DETAILS

DRAWING NO:
XXXX-CW-PS-LGF-DR-I-5501

PROJ. NO:	ORIGINATOR	SCALE:	REV:
XXXX	A.T.	VARIOUS@A1	P01

SUITABILITY:
AS BUILT