



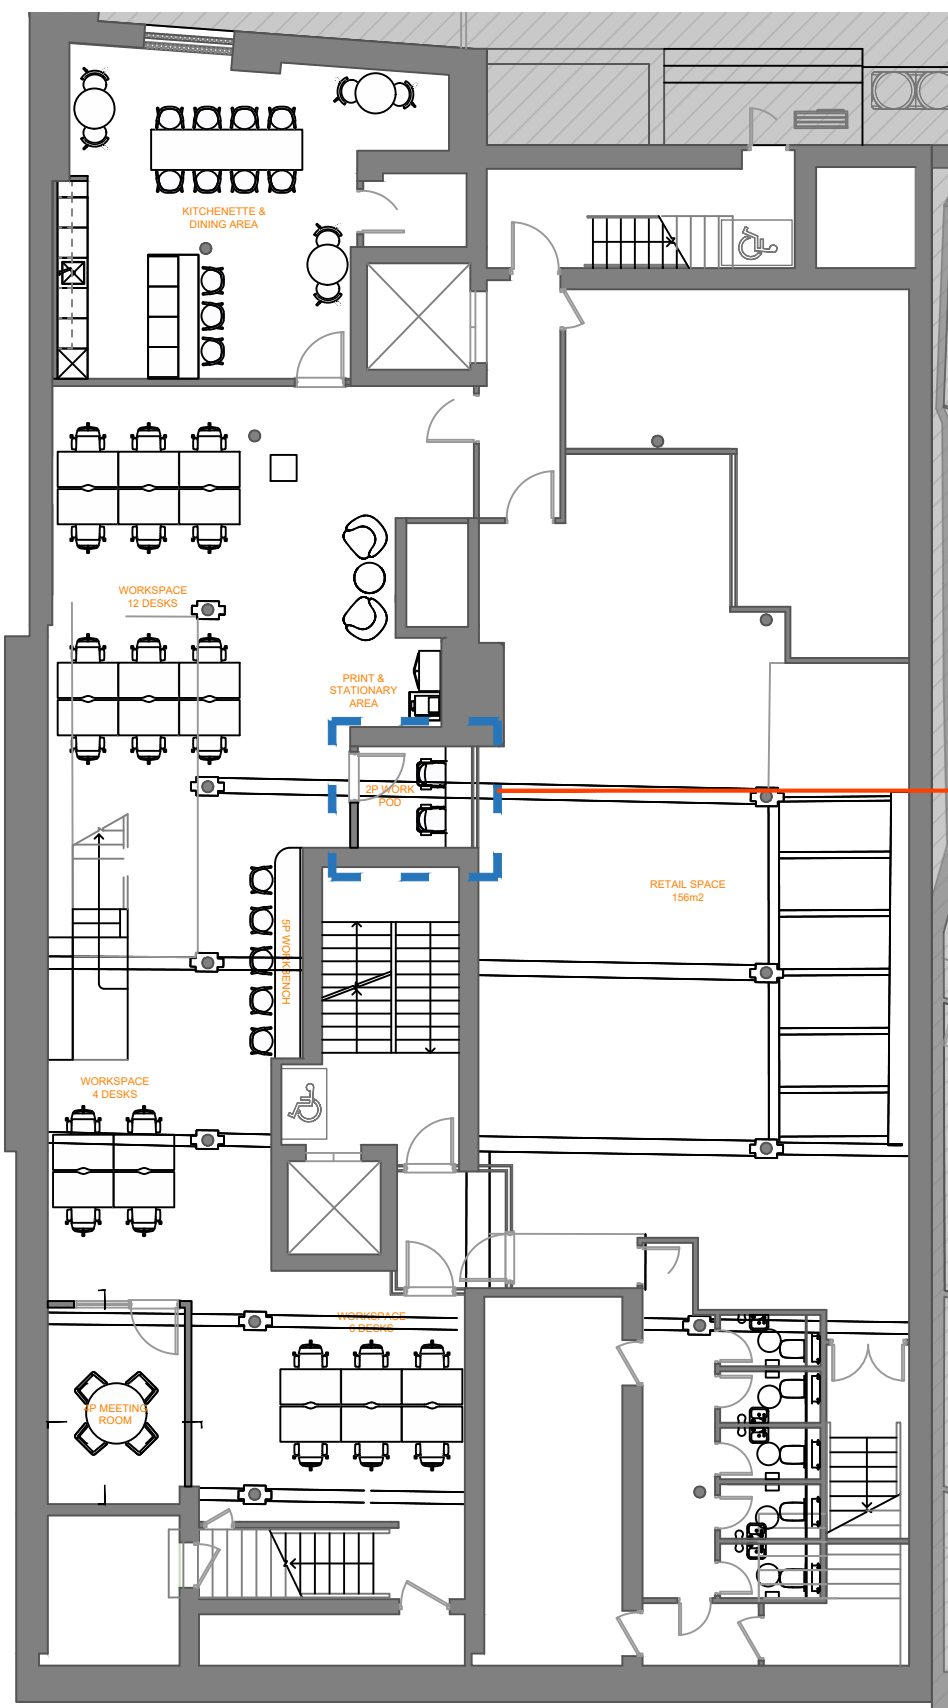


1 LOWER GROUND FLOOR PLAN

SCALE: 1:150 @A1

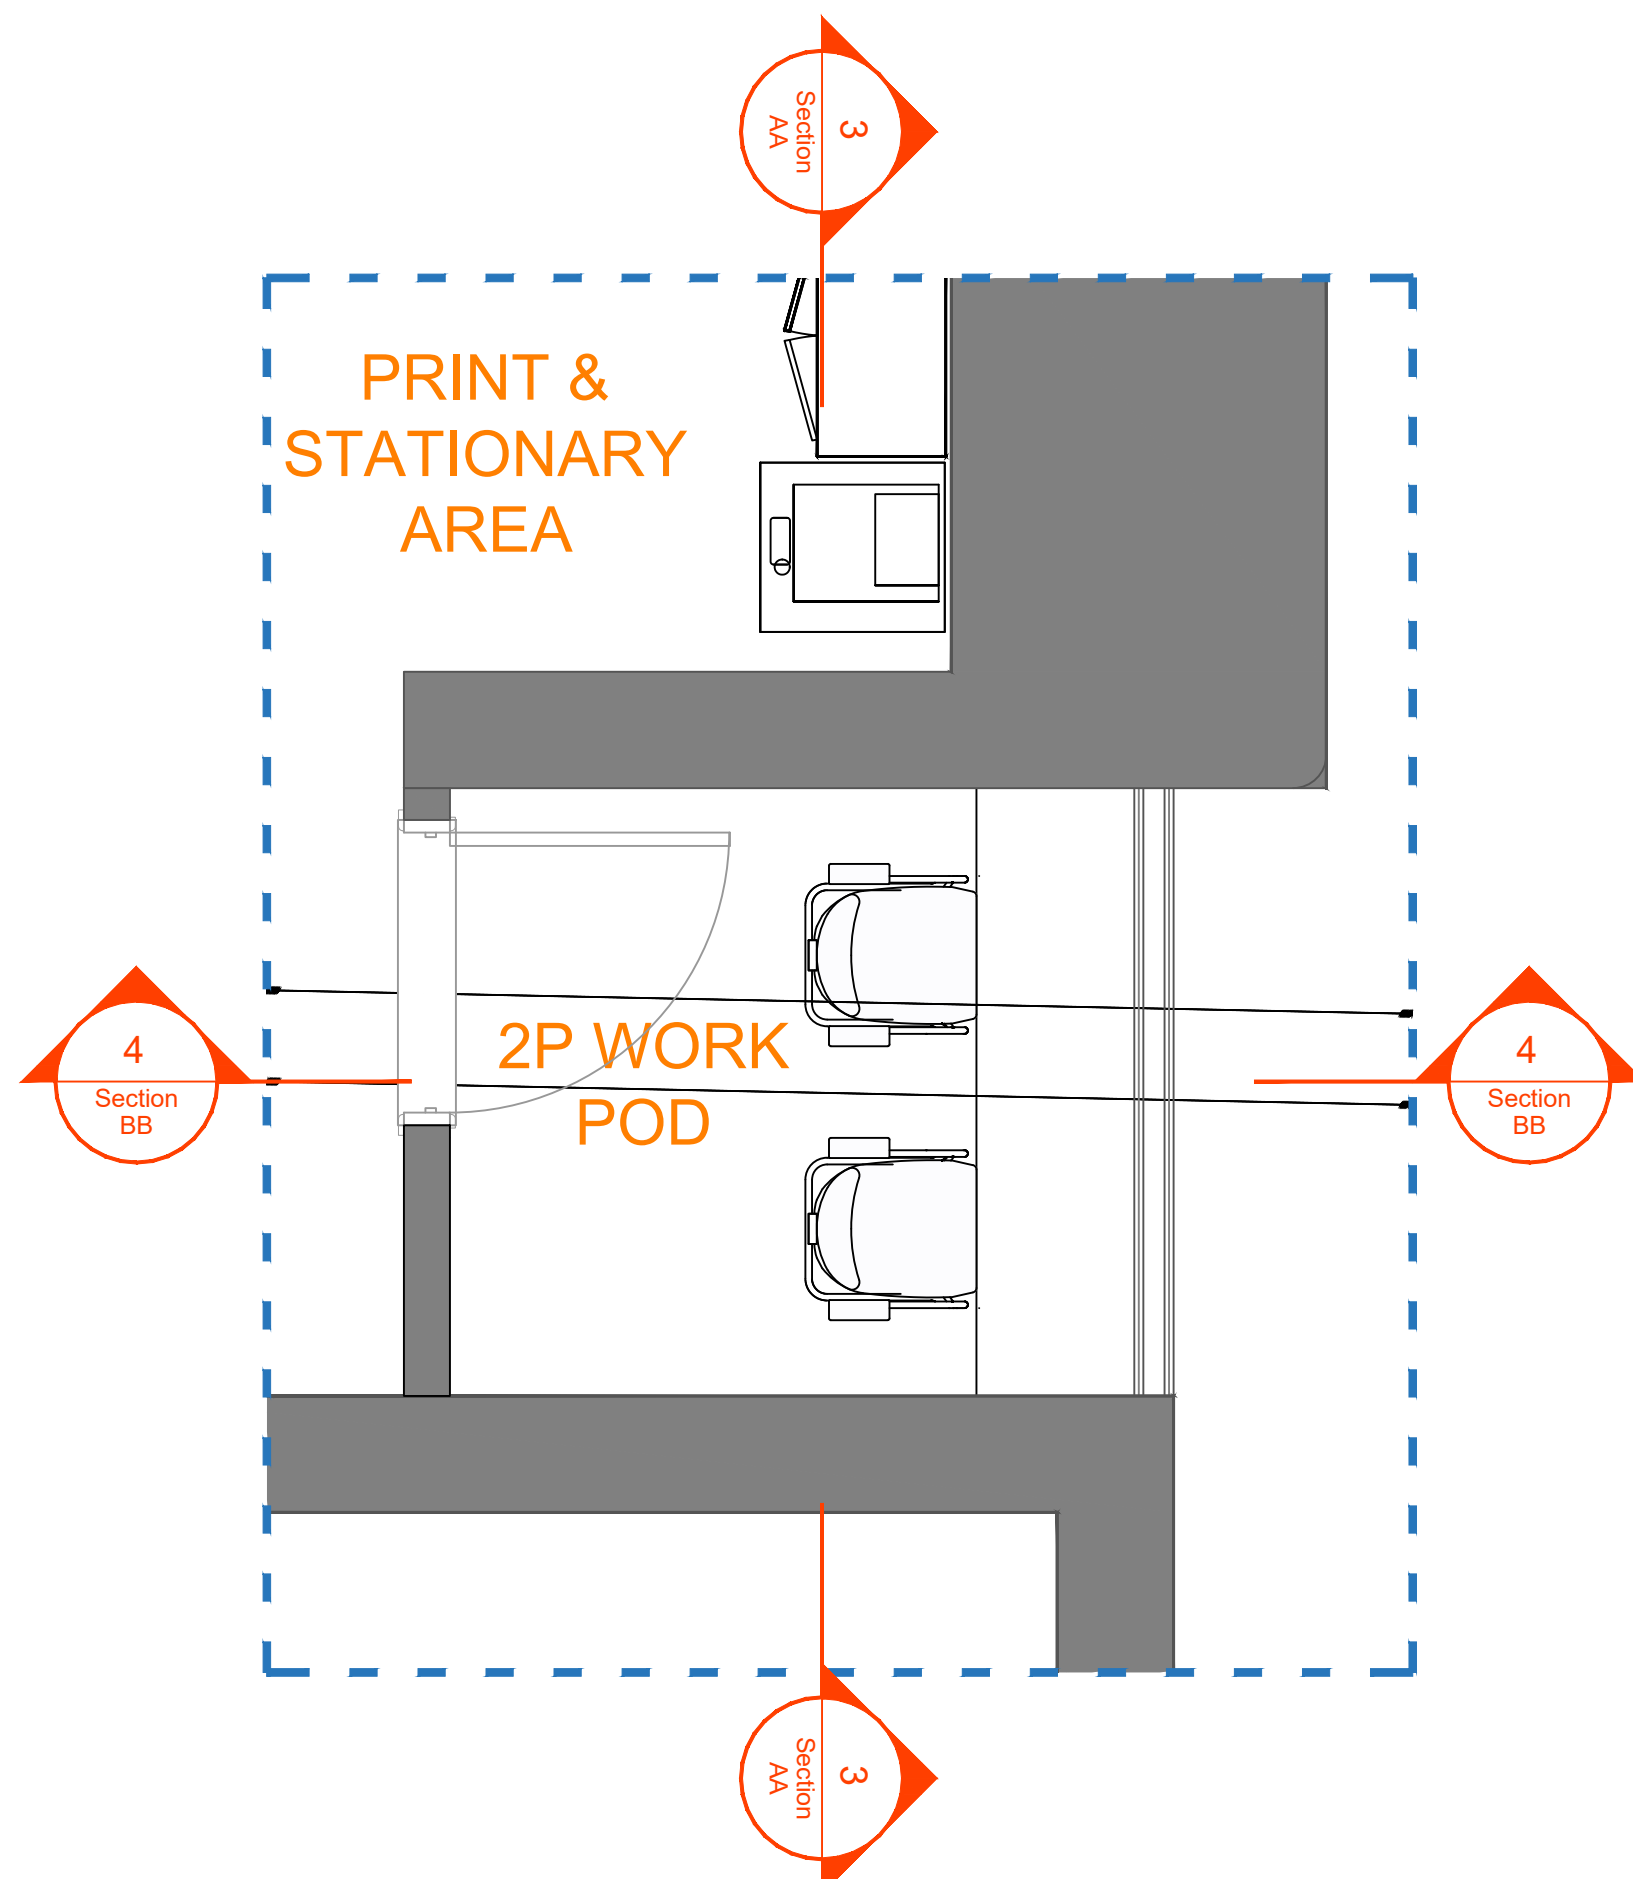


2 LGF WORK POD GENERAL ARRANGEMENT PLAN

SCALE: 1:25 @A1

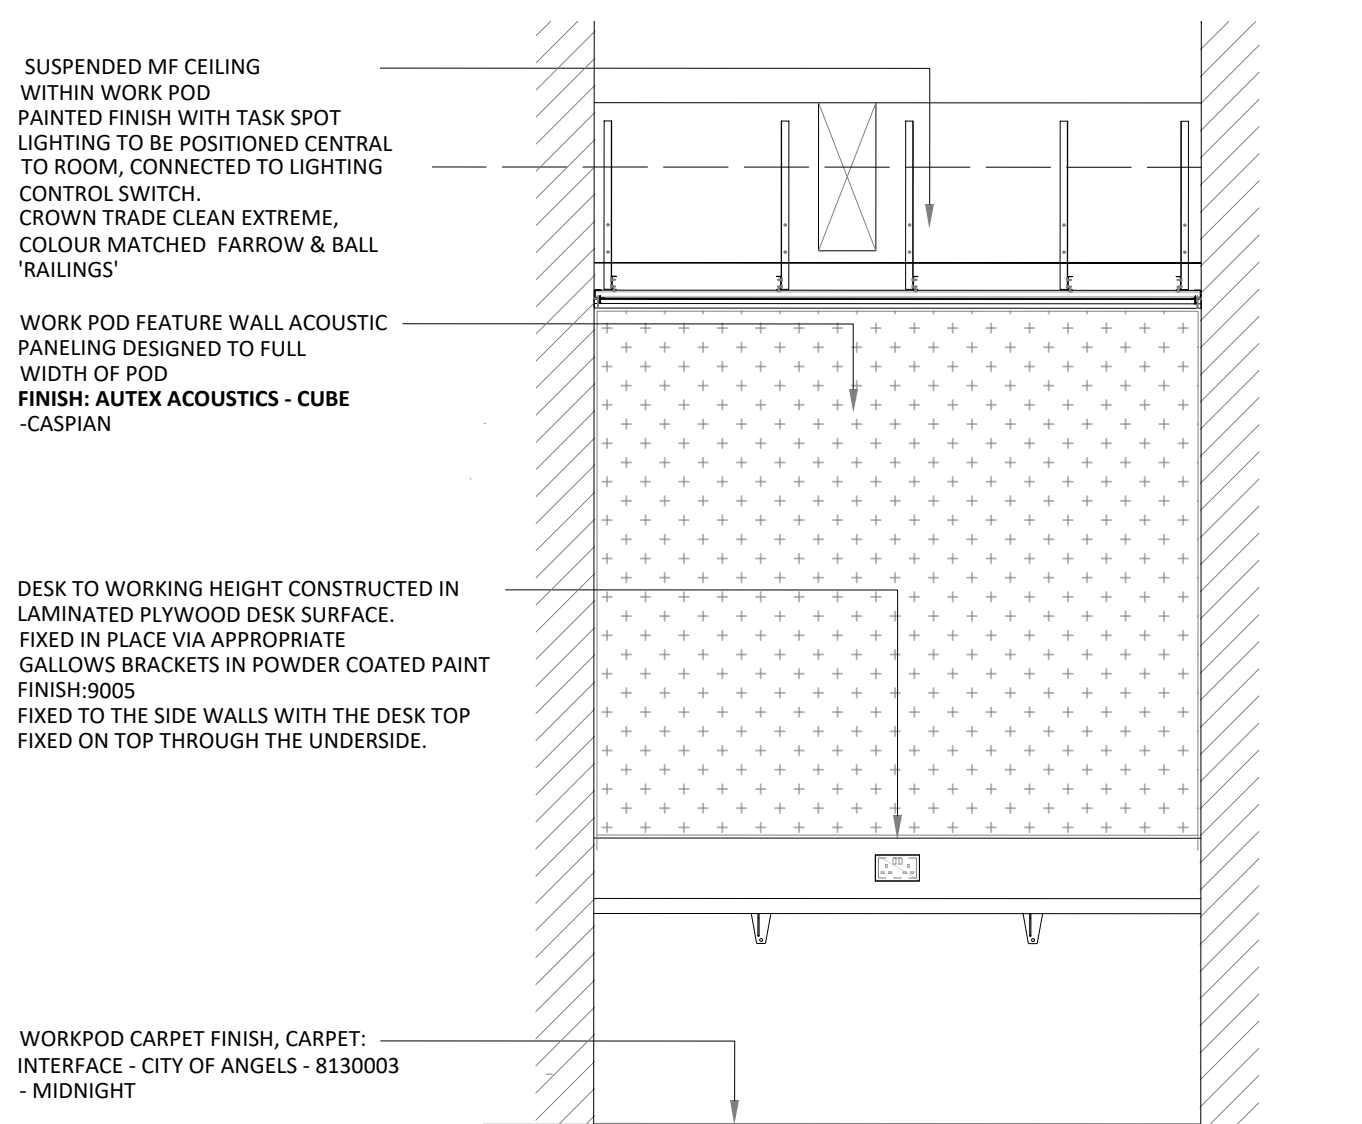


3 LGF WORK POD SECTION AA

SCALE: 1:25 @A1

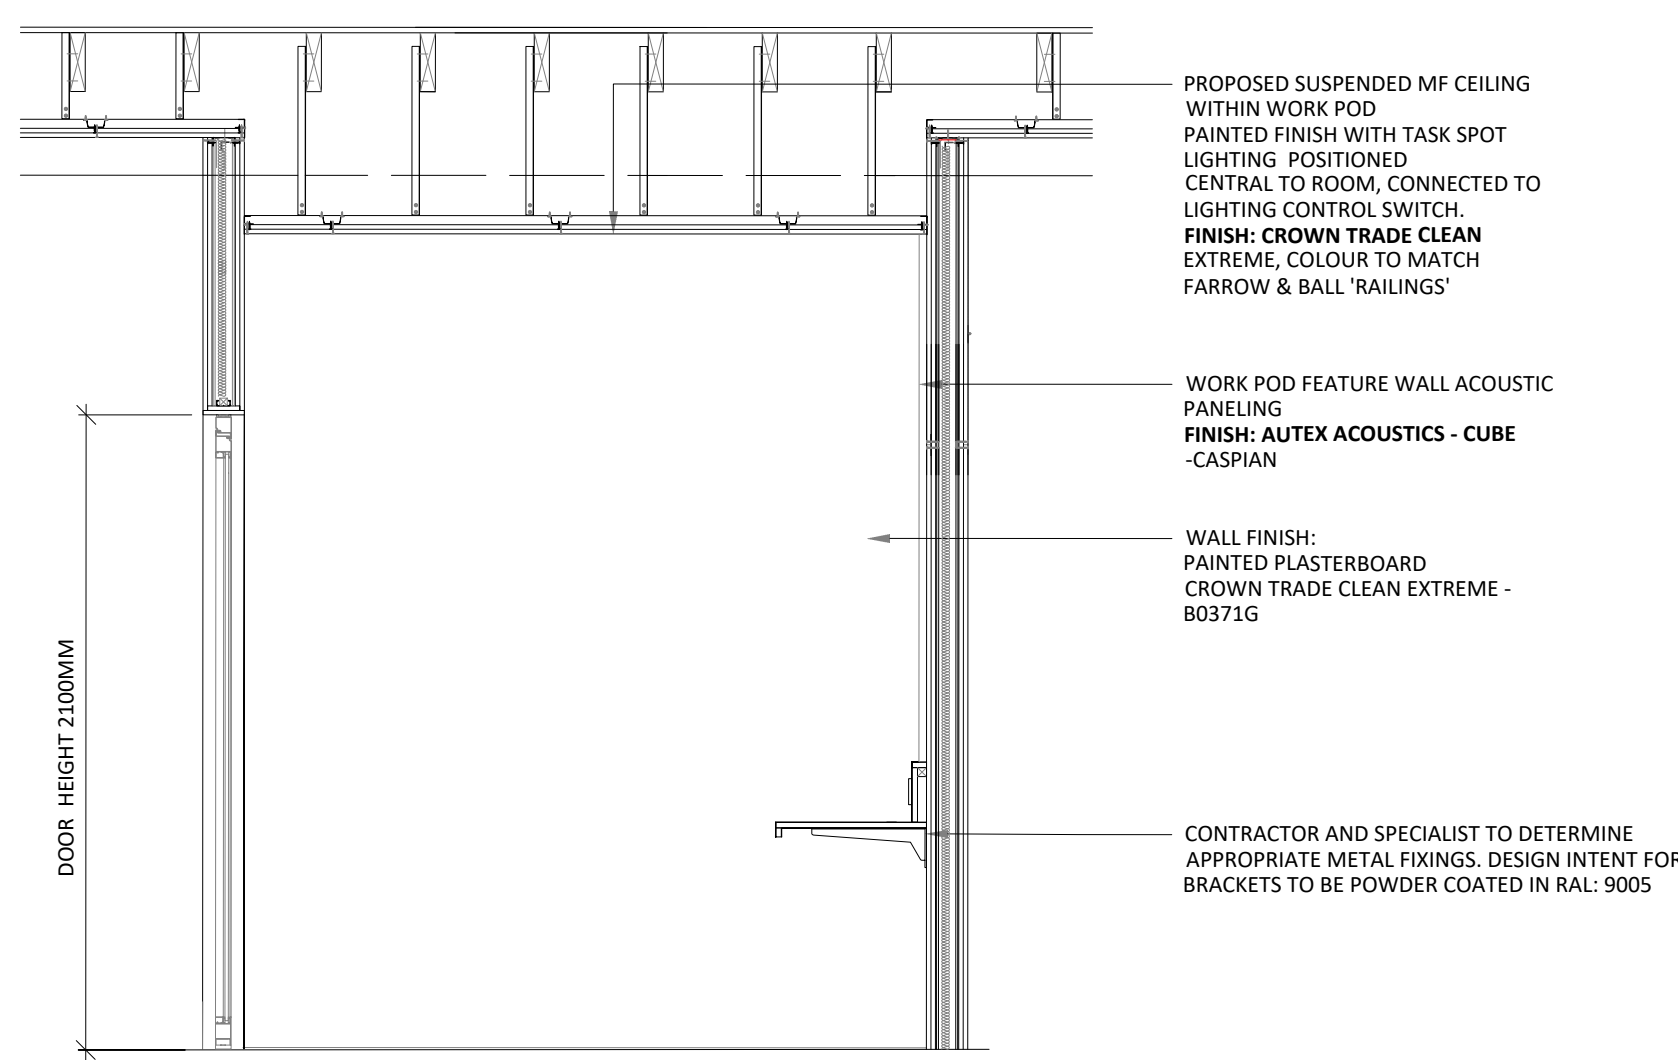


4 LGF WORK POD SECTION BB

SCALE: 1:25 @A1

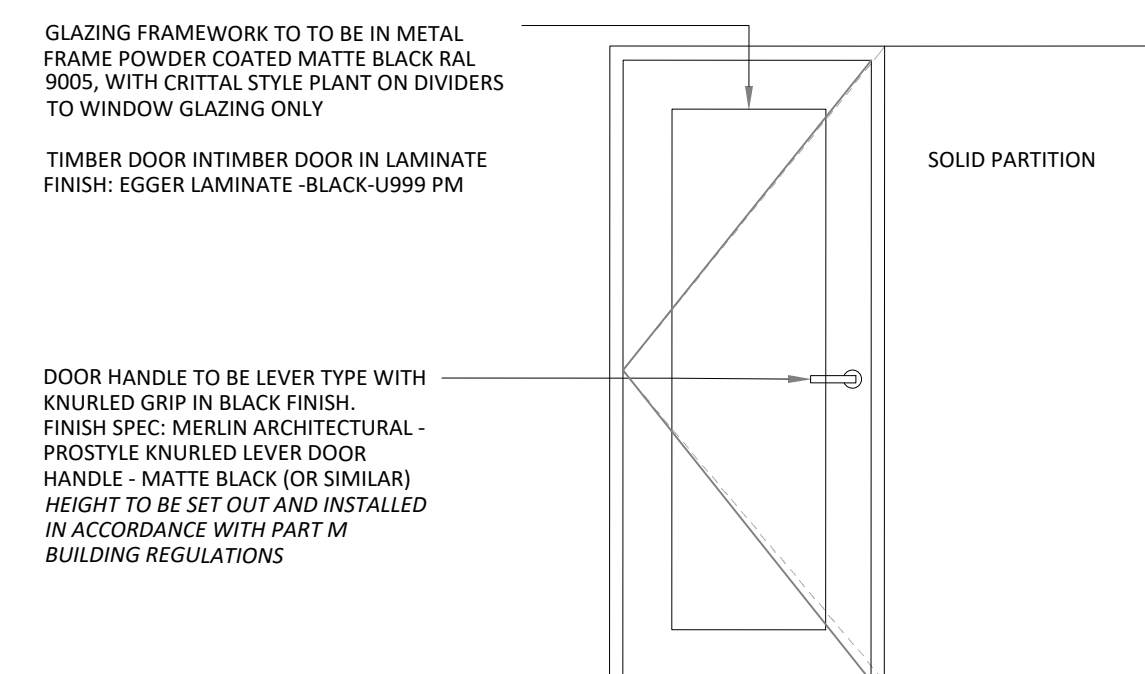

5 LGF WORK POD ELEVATION A

SCALE: 1:25 @A1

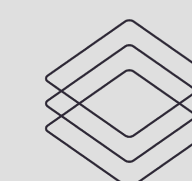

CubicWorks

CUBICWORKS LTD, A COMPANY REGISTERED IN ENGLAND & WALES,
REGISTRATION NUMBER 12154552

AS BUILT

PROJECT MANAGER: S.A. DATE: 24.09.26

DRAWING ADDRESS: 113-115 PORTLAND STREET
LOWER GROUND FLOOR

DRAWING TITLE: WORK POD DETAILS

DRAWING NO: XXXX-CW-PS-LGF-DR-I-5502

PROJ. NO: XXXX ORIGINATOR: A.T. SCALE: VARIOUS@A1 P01 REV: VARIOUS@A1 P01

SUITABILITY: AS BUILT