




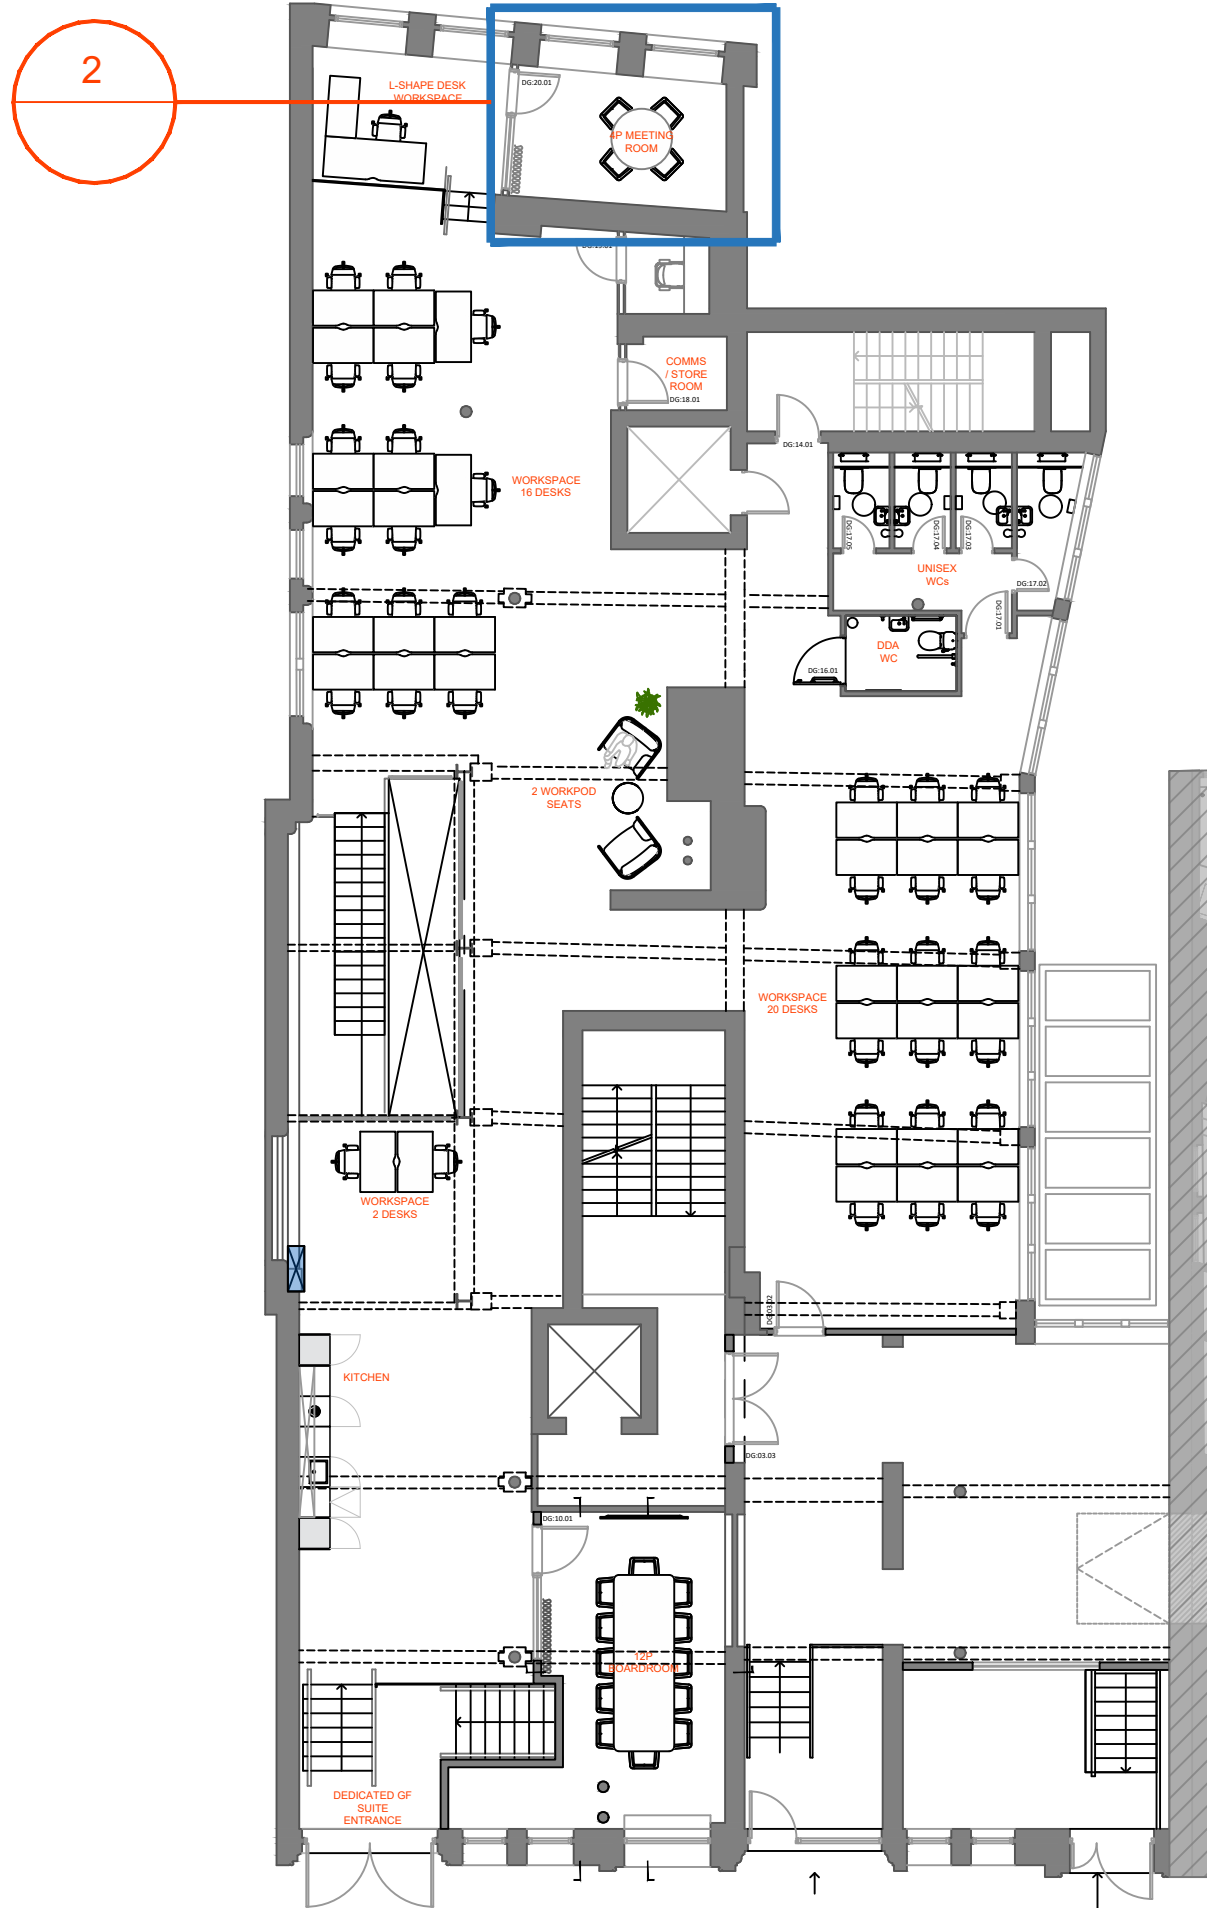


1 GROUND FLOOR PLAN
SCALE: 1:150 @A1

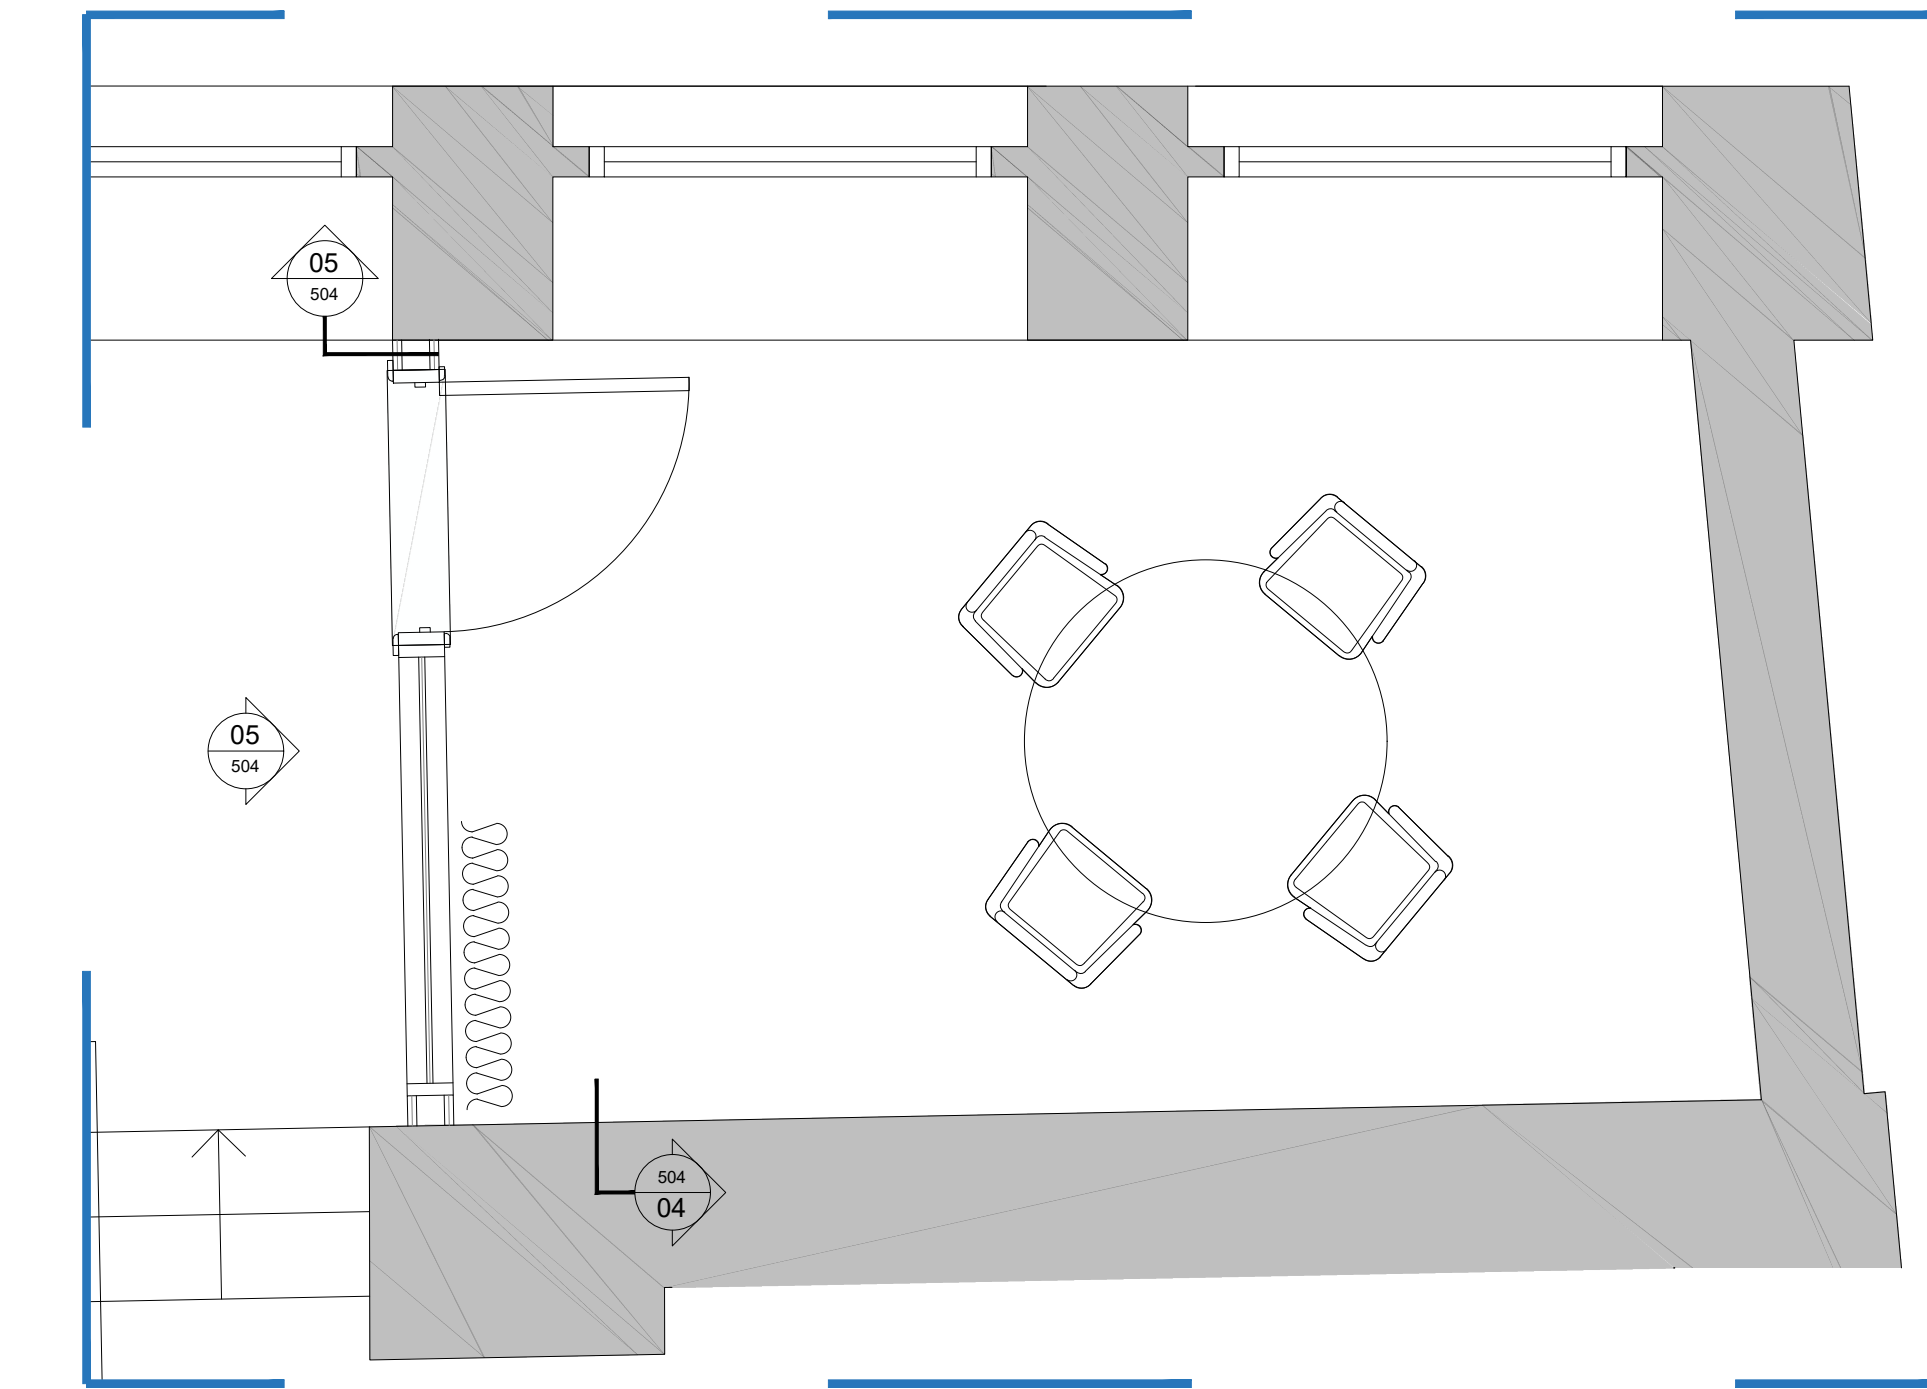


2 GF MEETING ROOM GENERAL ARRANGEMENT PLAN
SCALE: 1:25 @A1

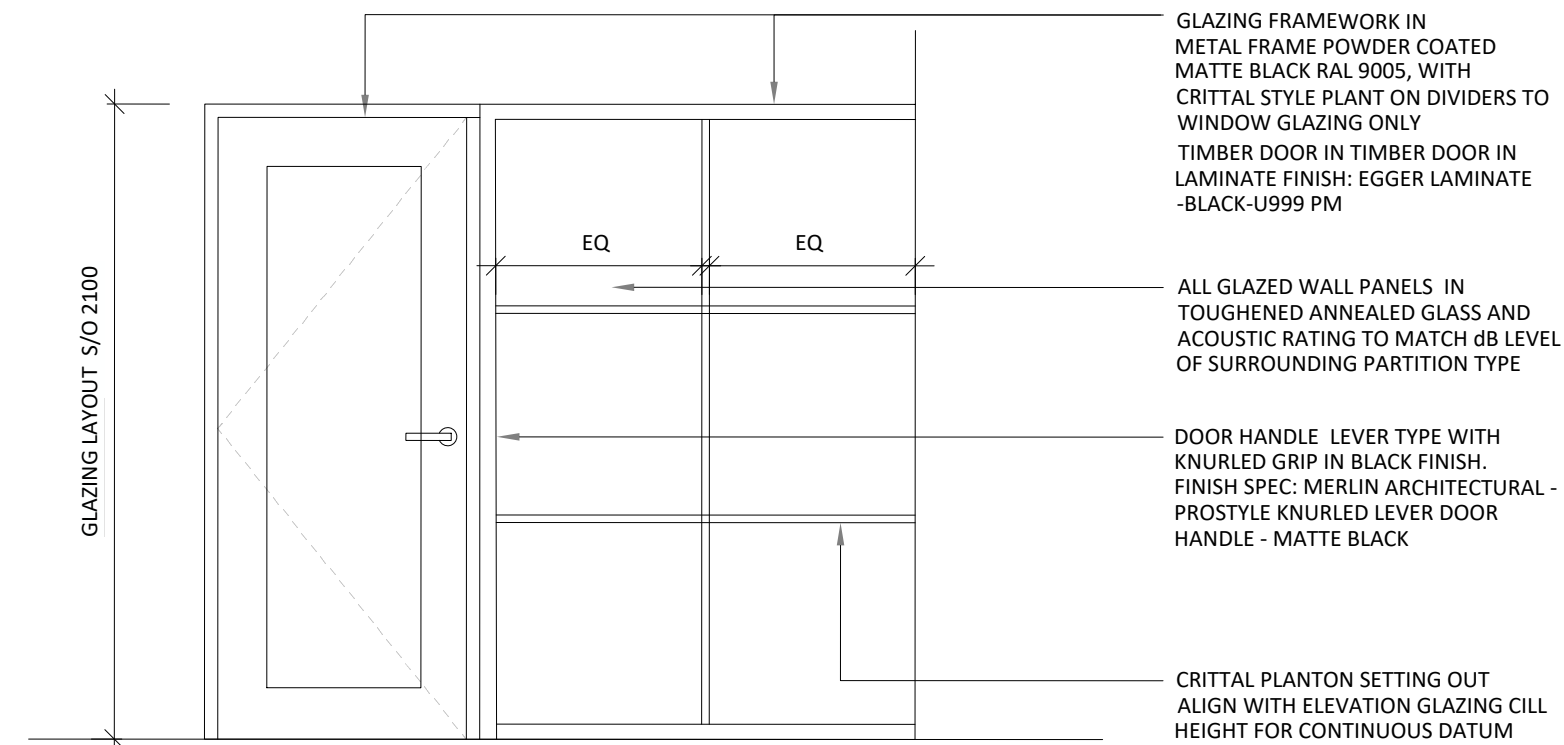

05 GF21-MEETING ROOM GLAZING SETTING OUT ELEVATION A
SCALE: 1:25 @ A1

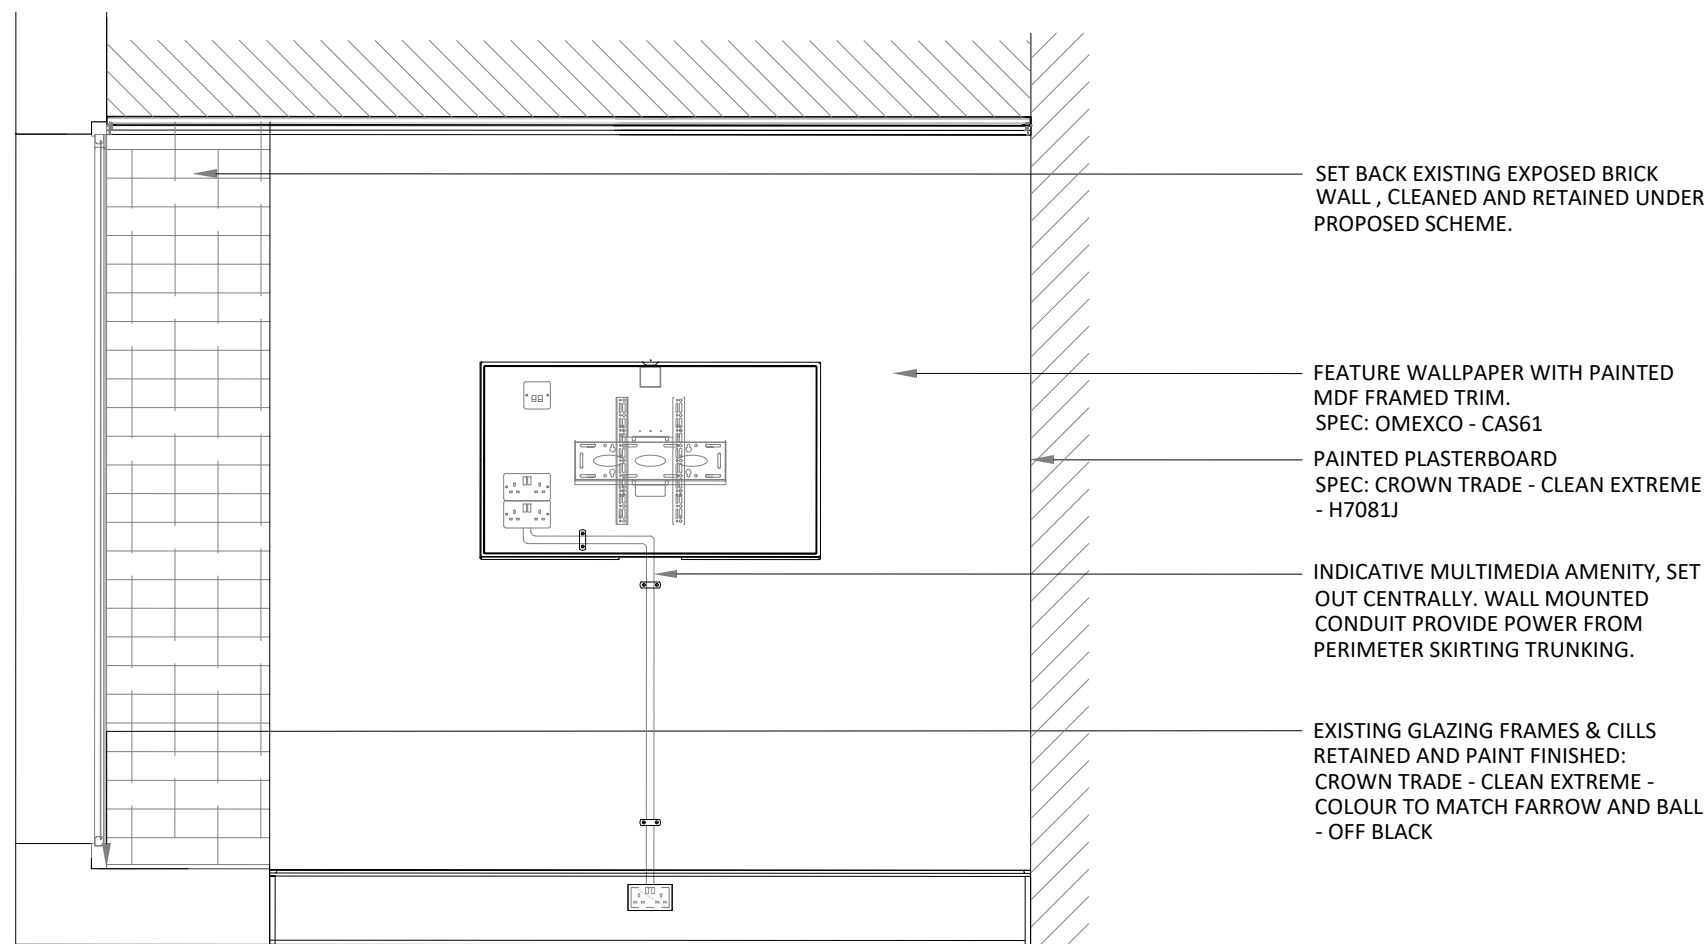


03 GF21-MEETING ROOM SECTION AA
SCALE: 1:25 @ A1

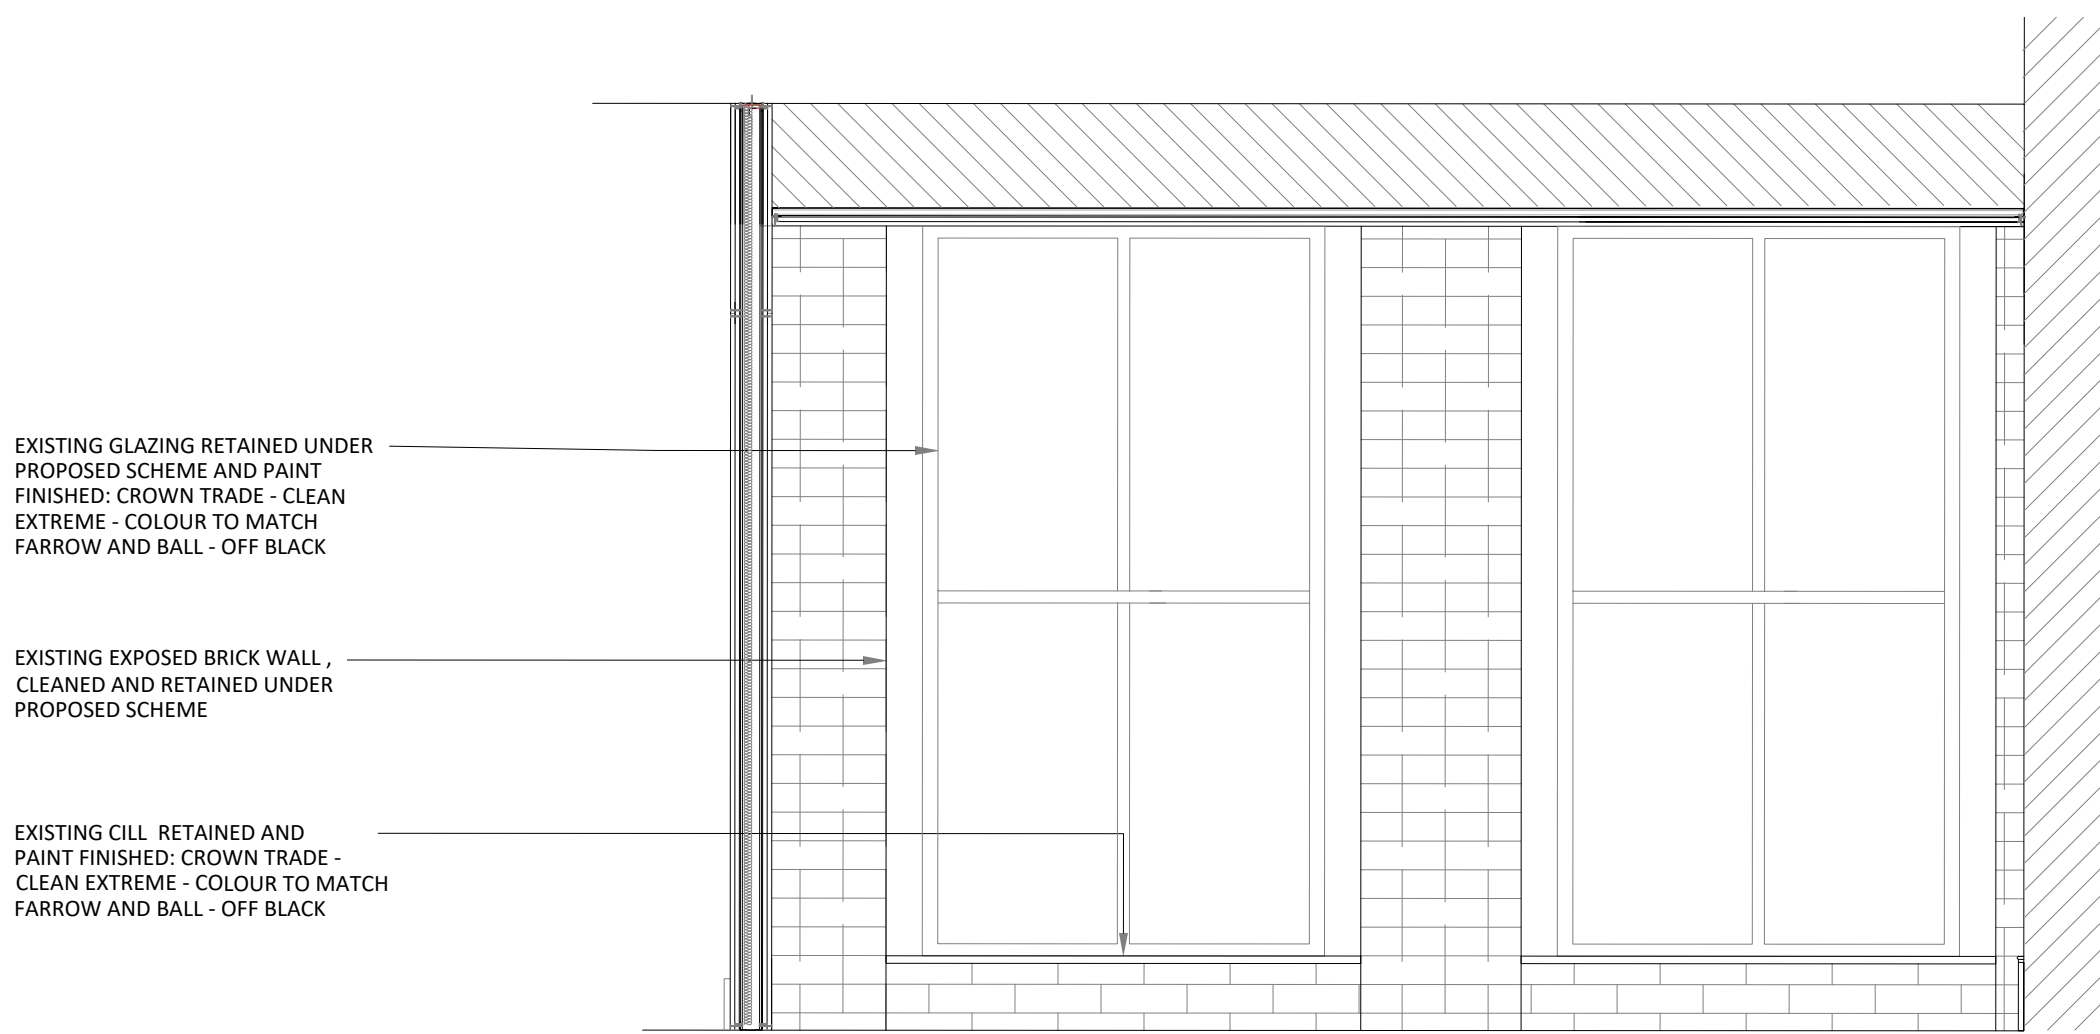

04 GF21-MEETING ROOM SECTION BB
SCALE: 1:25 @ A1

P01	FIRST ISSUE	25.09.26
REV	DESCRIPTION	DATE

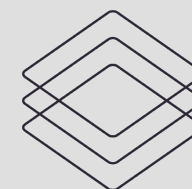

CubicWorks

CUBICWORKS LTD, A COMPANY REGISTERED IN ENGLAND & WALES,
REGISTRATION NUMBER 12154552

AS BUILT

PROJECT MANAGER:	DATE:
S.A.	02.10.26

DRAWING ADDRESS:
113-115 PORTLAND STREET
GROUND FLOOR

DRAWING TITLE:
BOARD ROOM DETAILS

DRAWING NO:
XXXX-CW-PS-GF-DR-I-5503

PROJ. NO:	ORIGINATOR	SCALE:	REV:
XXXX	A.T.	VARIOUS@A1	P01

SUITABILITY:
AS BUILT