
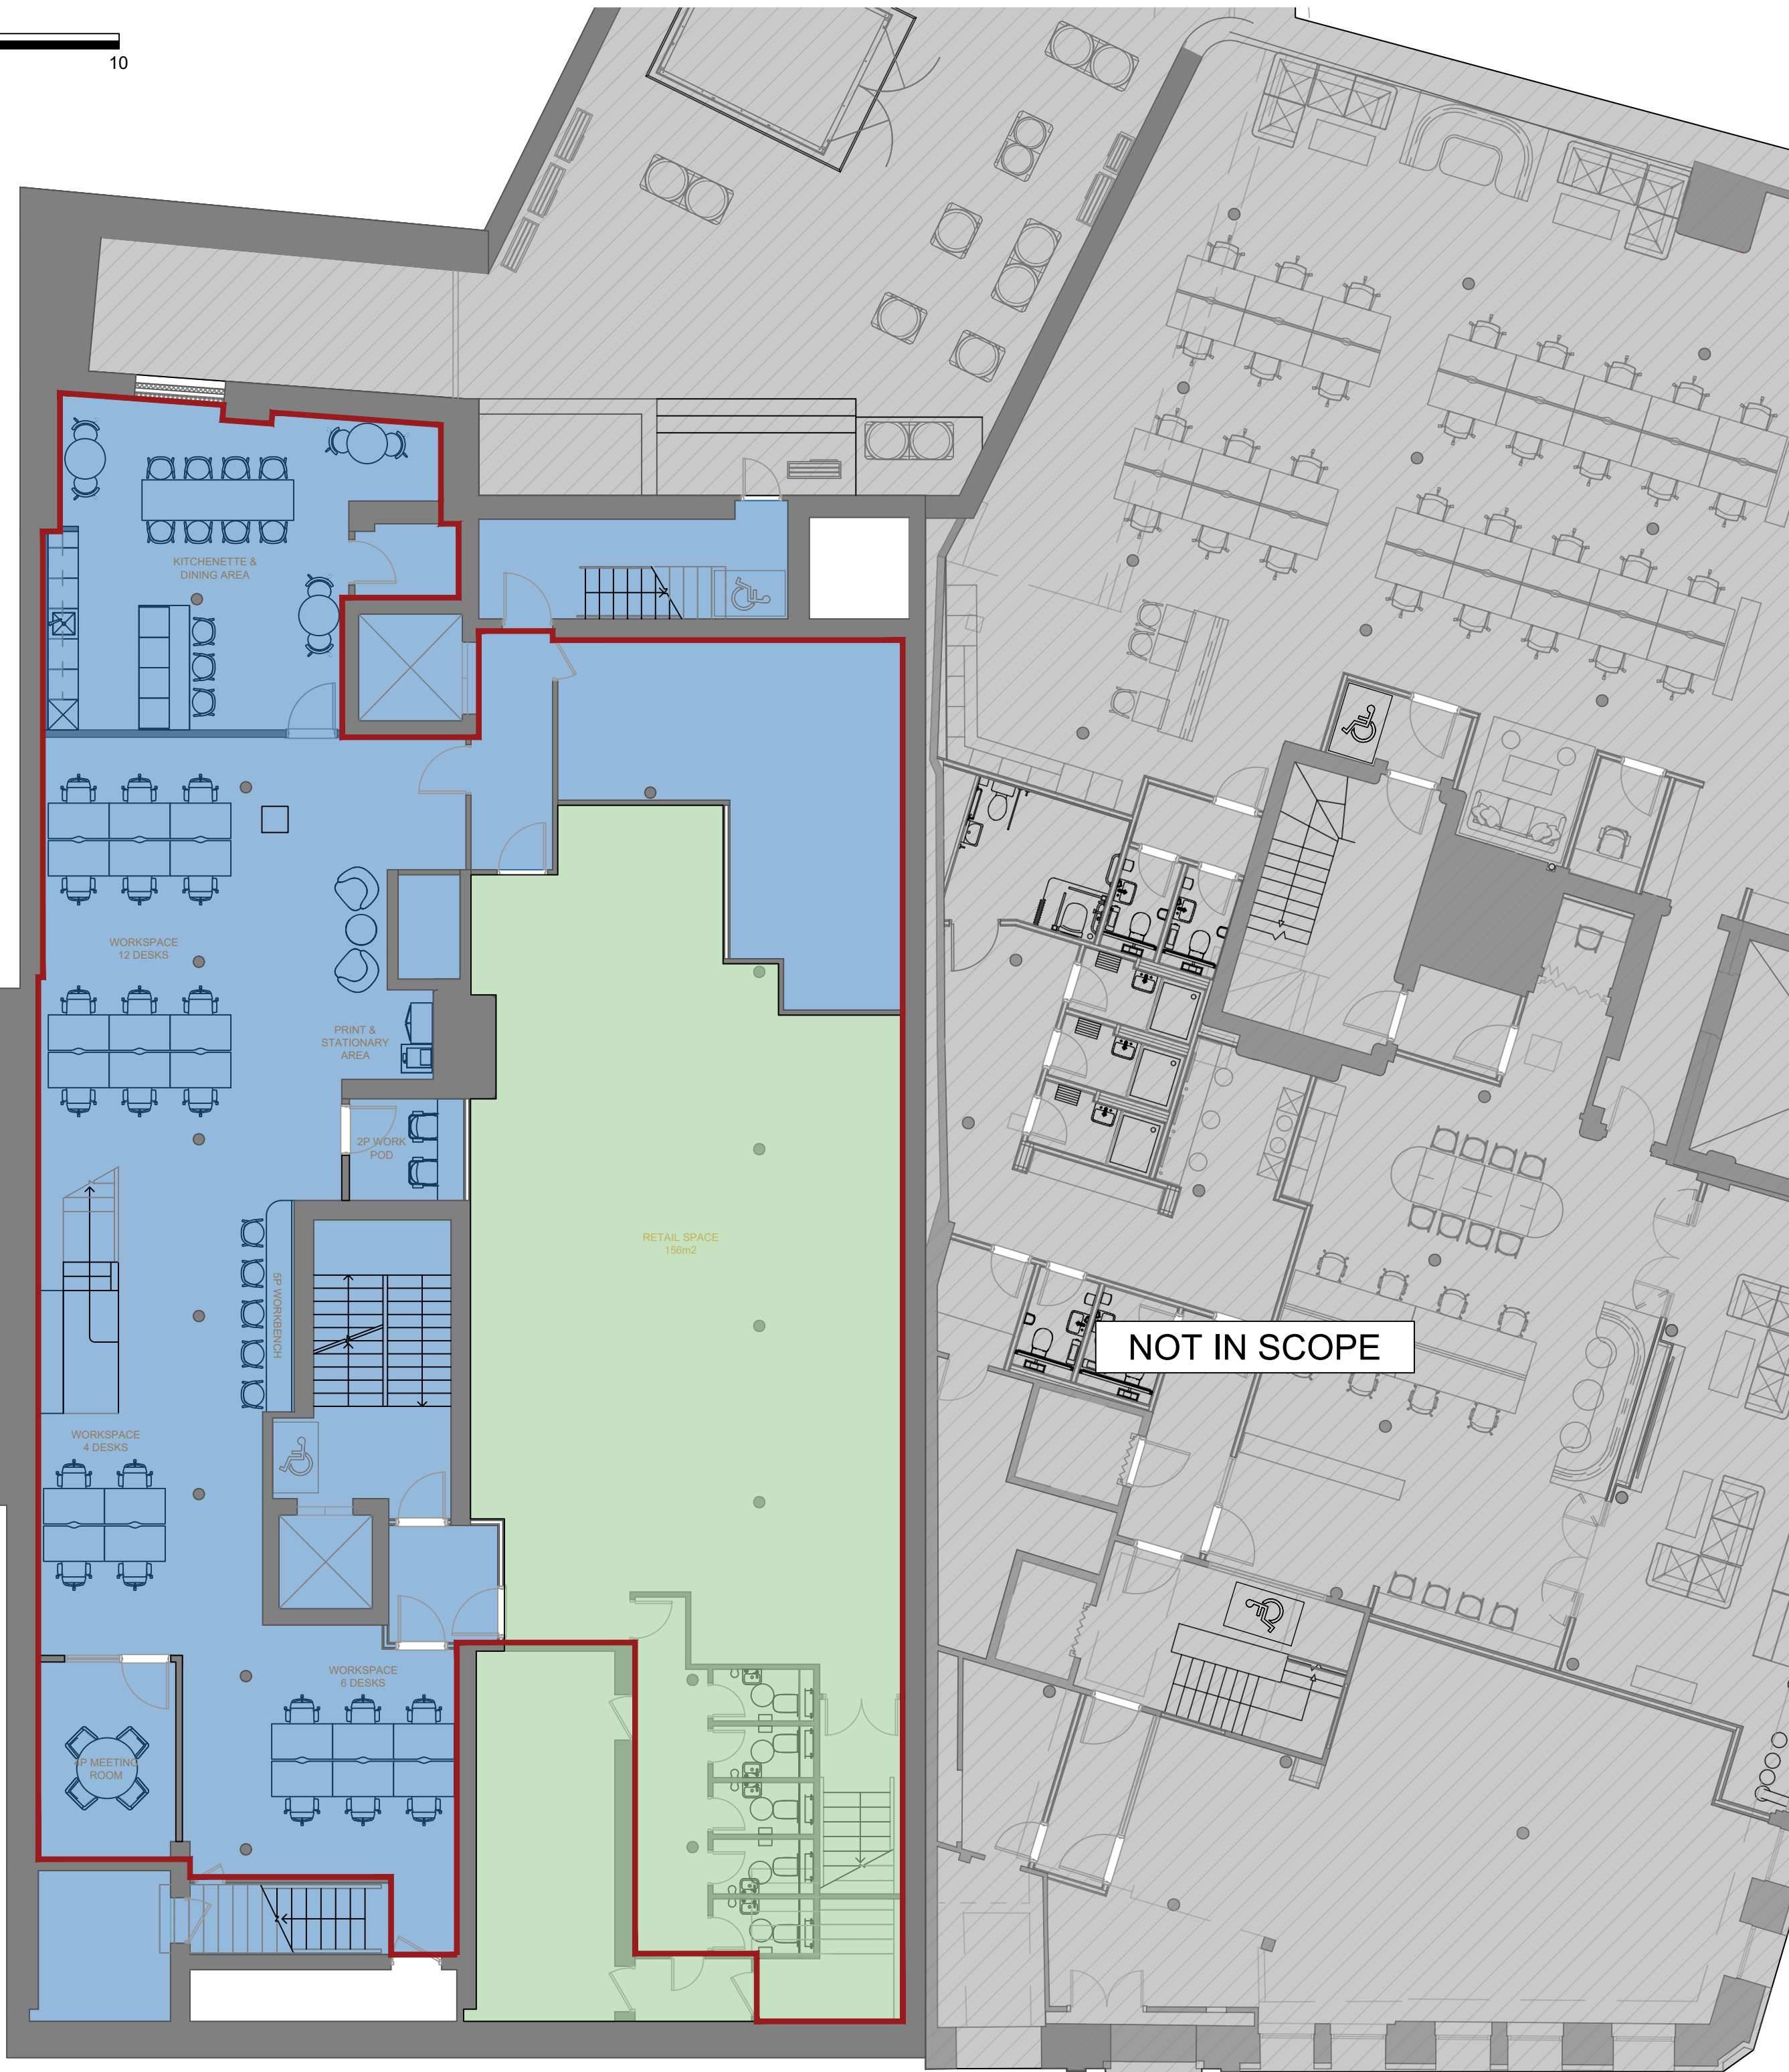


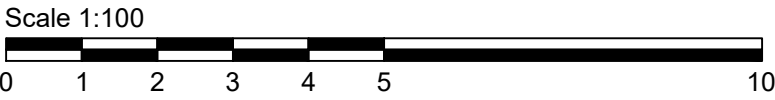


USE CLASS KEY:

USE CLASS E(c) - OFFICE

USE CLASS E(A & D) - RETAIL, AND INDOOR SPORT, RECREATION AND FITNESS

SOLID RED LINE DENOTES AREA WITHIN SCOPE OF WORKS

P01	FIRST ISSUE	21.09.26
REV	DESCRIPTION	DATE

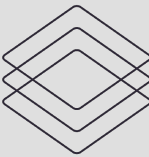

CubicWorks

CUBICWORKS LTD. A COMPANY REGISTERED IN ENGLAND & WALES, REGISTRATION NUMBER 12154582

AS BUILT

PROJECT MANAGER:	DATE:
S.A.	21.09.26

DRAWING ADDRESS:

PORTLAND STREET 113-115
MANCHESTER

DRAWING TITLE:

LOWER GROUND FLOOR USE CLASS PLAN

DRAWING NO:

XXXX-CW-PS-LG-DR-I-1002

PROJ. NO:	ORIGINATOR	SCALE:	REV:
XXXX	A.T.	1:100@A2	P01

SUITABILITY:

AS BUILT