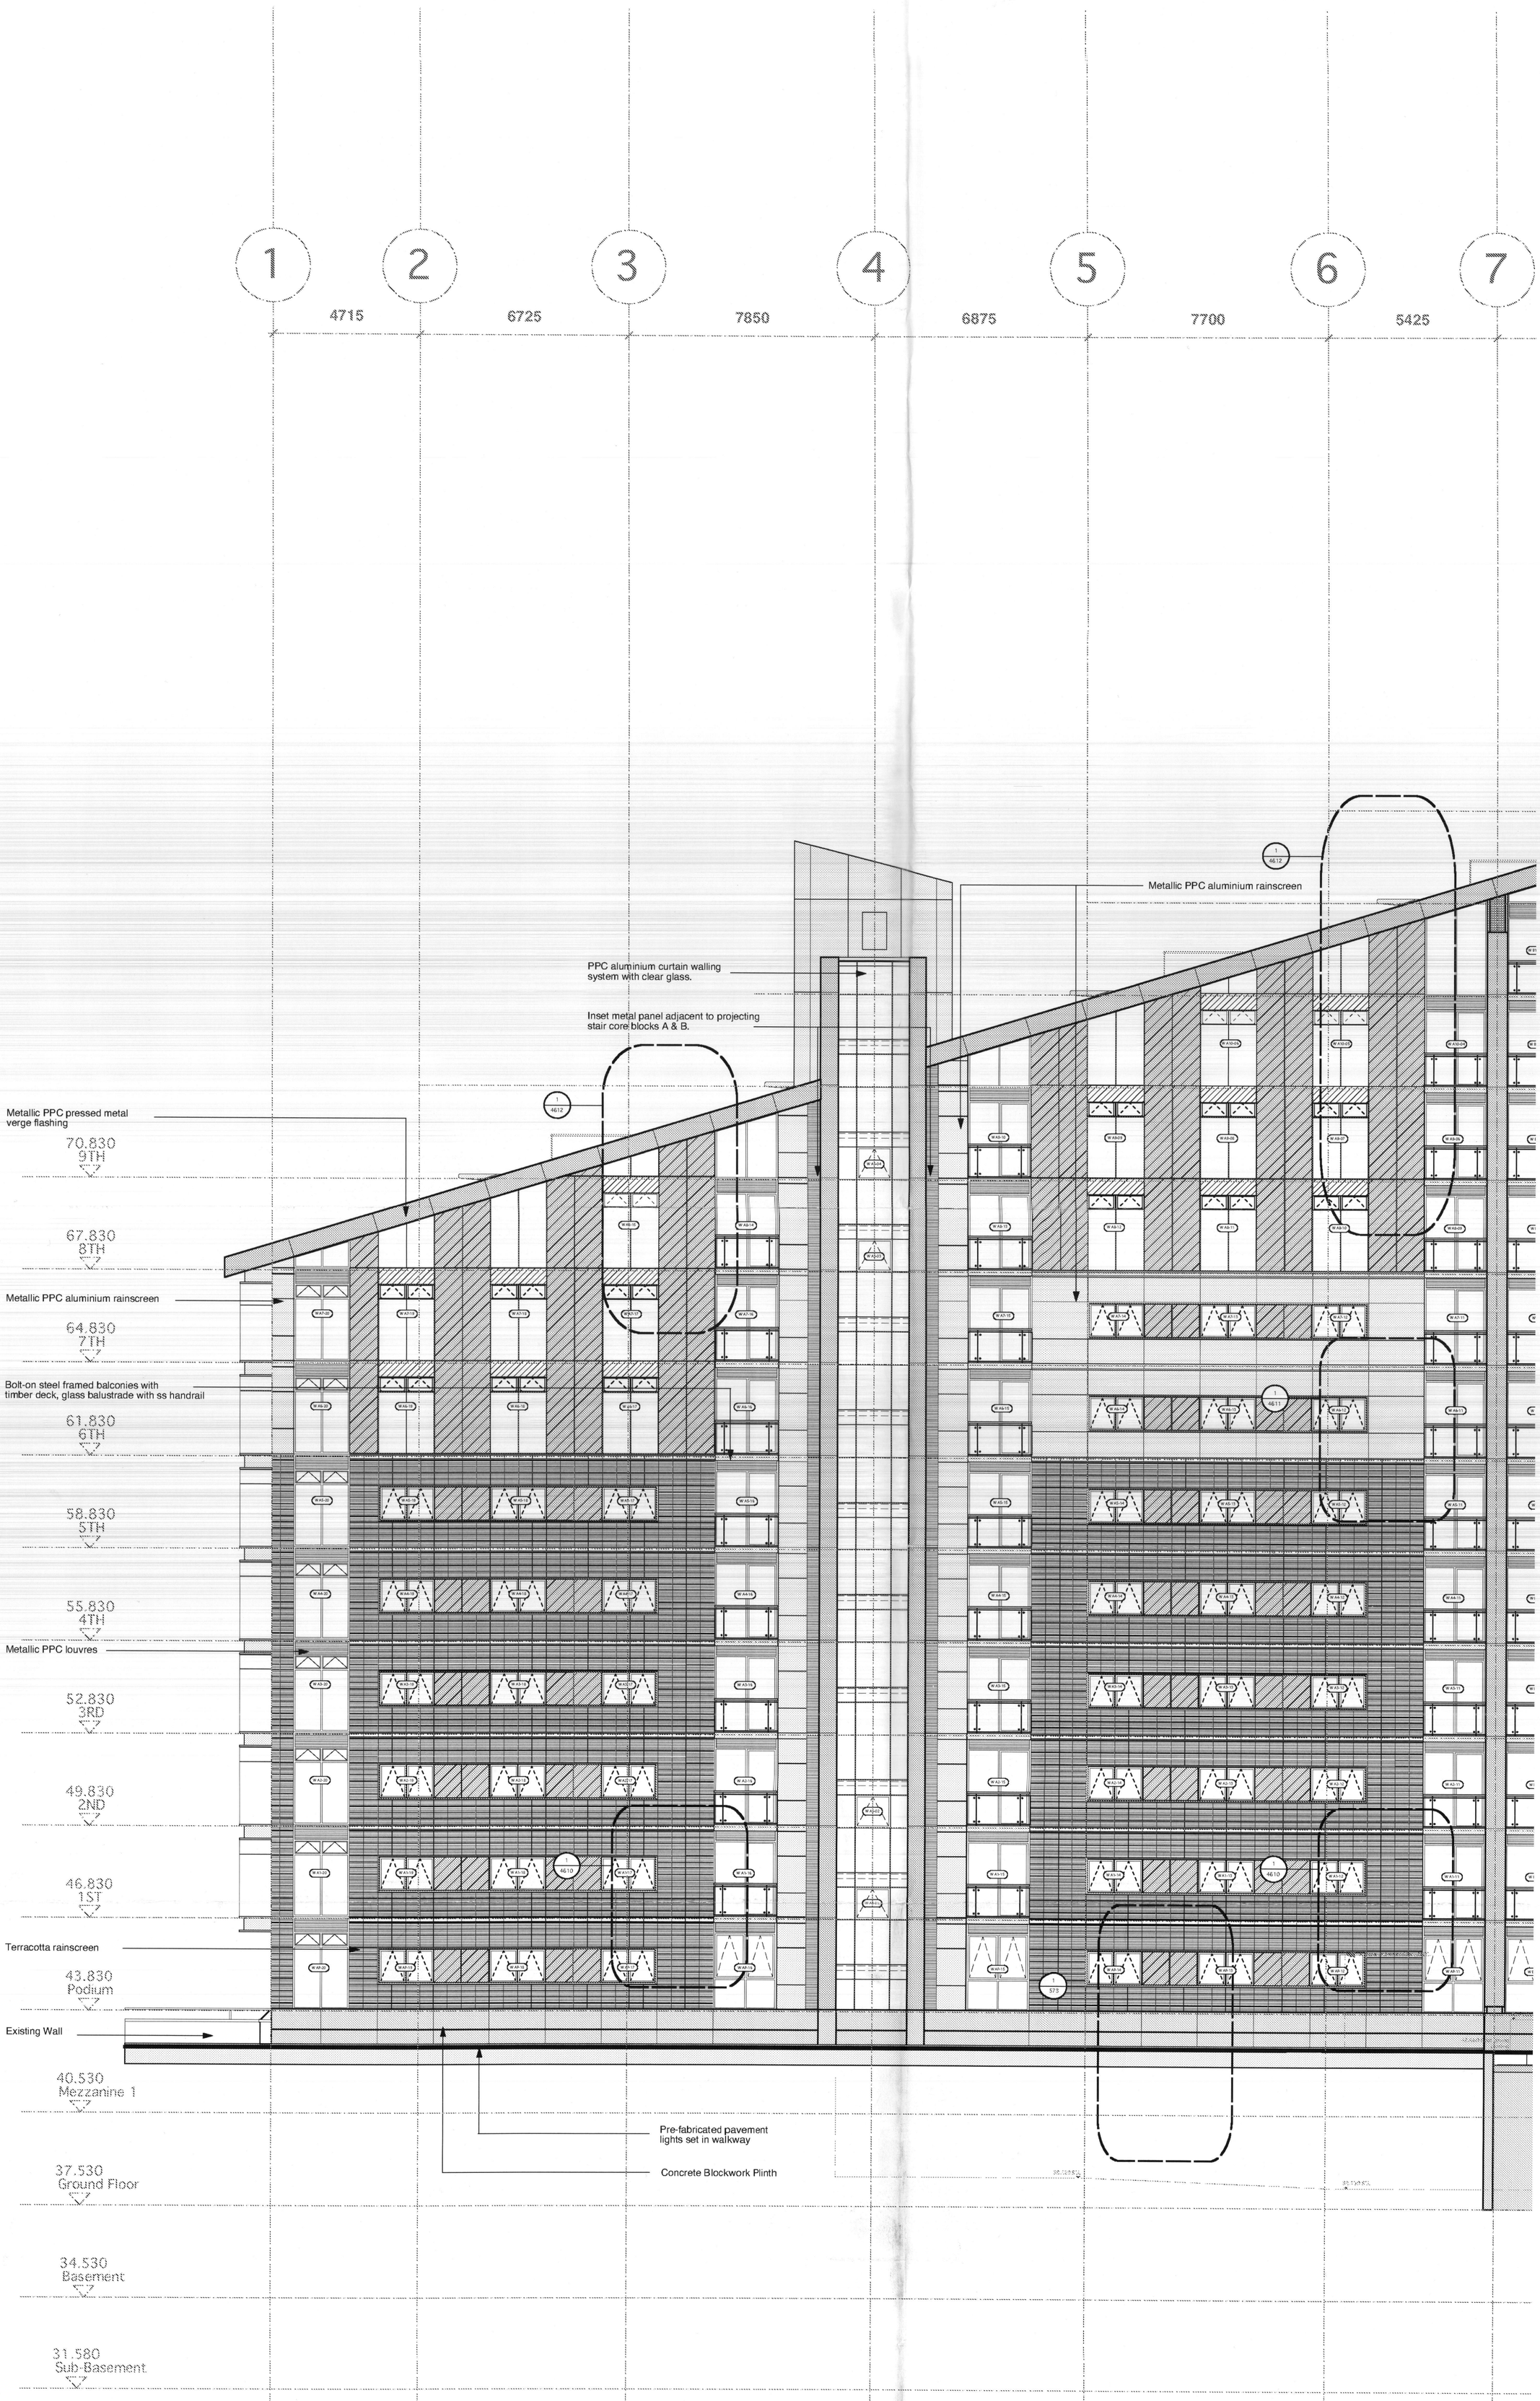

GENERAL NOTES 25.08.00

All setting out must be checked on site
All levels must be checked on site and refer to Ordnance Datum Newlyn unless alternative Datum given
All fixings and weatherings must be checked on site
All dimensions must be checked on site
This drawing must not be scaled
This drawing must be read in conjunction with the relevant specification clauses
This drawing must not be used for land transfer purposes
Calculated areas in accordance with Assael Architecture's Definition of Areas for Schedule of Areas
This drawing must not be used on site unless issued for construction
Revision Status:
P=Preliminary/Planning T=Tender C=Construction/Contract
© 2006 Assael Architecture Limited

DRAWING NOTES

ELECTRONIC FILE REF Nº A1621 4334-F1

STATUS	REVISION	DATE	DRN	CHECK	CDM
P1	PRELIMINARY ISSUE	24.02.06	DF		

NOTE
ALL THE DETAILS REFERRED TO ON THIS DRAWING ARE NOT FOR CONSTRUCTION UNTIL AND UNLESS THEY RECEIVE CONSTRUCTION STATUS

Key

- Single glazed shadow box unit. Clear glass.
- Single glazed unit and solid wall behind. Opaque glass.
- Double glazed unit. Clear glass.

carillion

- For information ☒
- For comment ☐
- For client sanction ☐
- For construction ☐

CLIENT
George Wimpey City Ltd

PROJECT TITLE
Slot Site
Manchester

DRAWING TITLE
Block A
East Elevation
AS BUILT

SCALE @ A1 SIZE 1:100
DATE Feb '06
DRAWING Nº A1621 4334
STATUS & REVISION P1

Assael

Assael Architecture Limited
Studio 13
50 Carnwath Road
London SW6 3EG

T +44 (0) 20 7736 7744
F +44 (0) 20 7736 6677
E surname@assael.co.uk
W www.assael.co.uk