
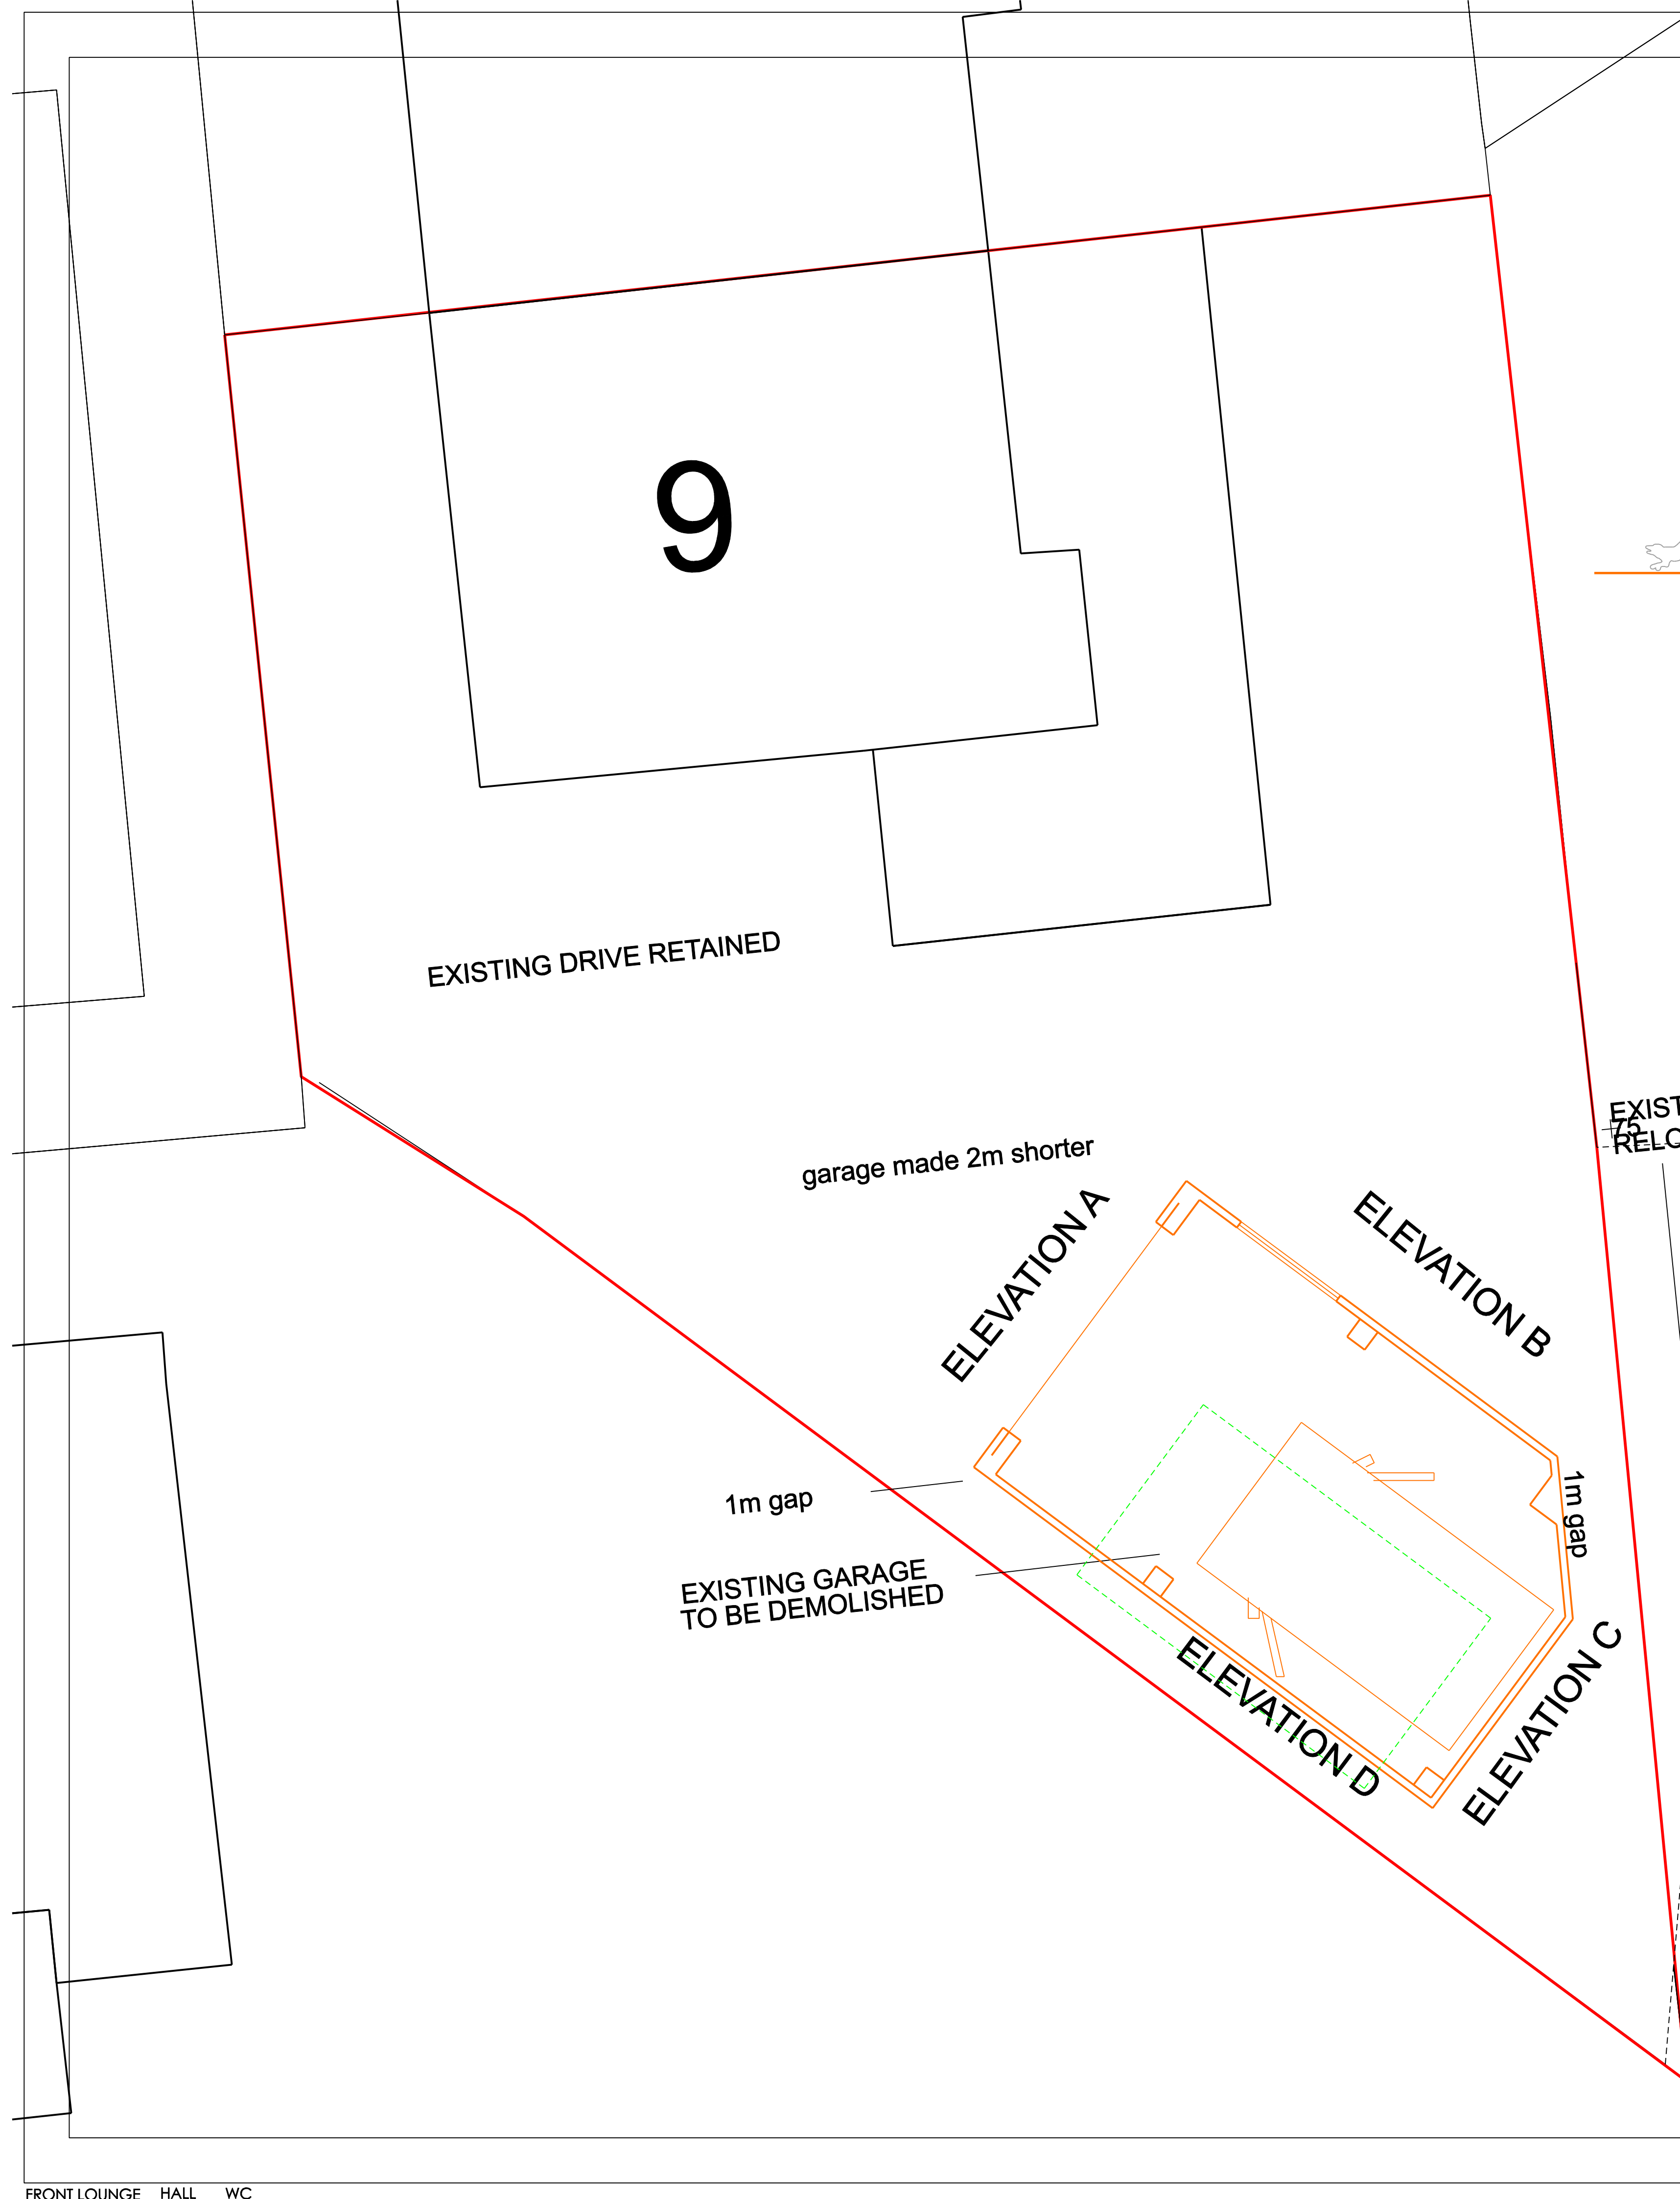


THESE DRAWINGS ARE FOR PLANNING AND BUILDING REGULATIONS PURPOSES ONLY. COPYRIGHT REMAINS WITH M T ARCHITECTURAL. DO NOT SCALE, IF IN DOUBT ASK.


STRUCTURAL DETAILS SHOWN ON THESE DRAWINGS ARE INDICATIVE. PLEASE REFER TO STRUCTURAL ENGINEERS DRAWINGS. ENGINEER APPOINTED DIRECT BY CLIENT

MT ARCHITECTURAL HAS BEEN APPOINTED TO PRODUCE CON / DESIGN STATEMENT / ADVICE ON PARTY WALL MATTERS. THE CLIENT HAS BEEN ADVISED OF THE LIMITS OF THE SERVICE. MT ARCHITECTURAL HAS BEEN APPOINTED IN A LIMITED CAPACITY TO PRODUCE CON / DESIGN STATEMENT / ADVICE ON PARTY WALL MATTERS. THE CLIENT HAS BEEN ADVISED OF THE LIMITS OF THE SERVICE. MT ARCHITECTURAL HAS BEEN APPOINTED IN A LIMITED CAPACITY TO PRODUCE CON / DESIGN STATEMENT / ADVICE ON PARTY WALL MATTERS. THE CLIENT HAS BEEN ADVISED OF THE LIMITS OF THE SERVICE.

PREVIOUS APPROVED SCHEME WAS PITCHED ROOF WITH 3.7M AT RIDGE BUT SET 1.5M AWAY FROM BOUNDARY. CLIENT NEEDS IT TIGHTER TO BOUNDARY (500mm) SO PROPOSES 3M FLAT ROOF

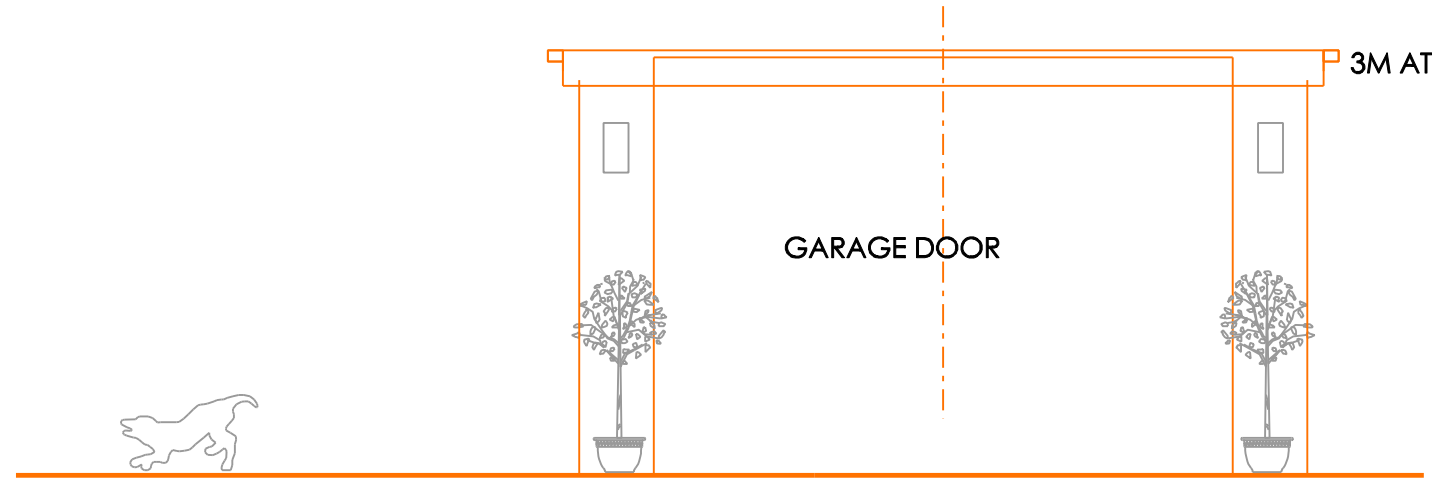


ELEVATION A

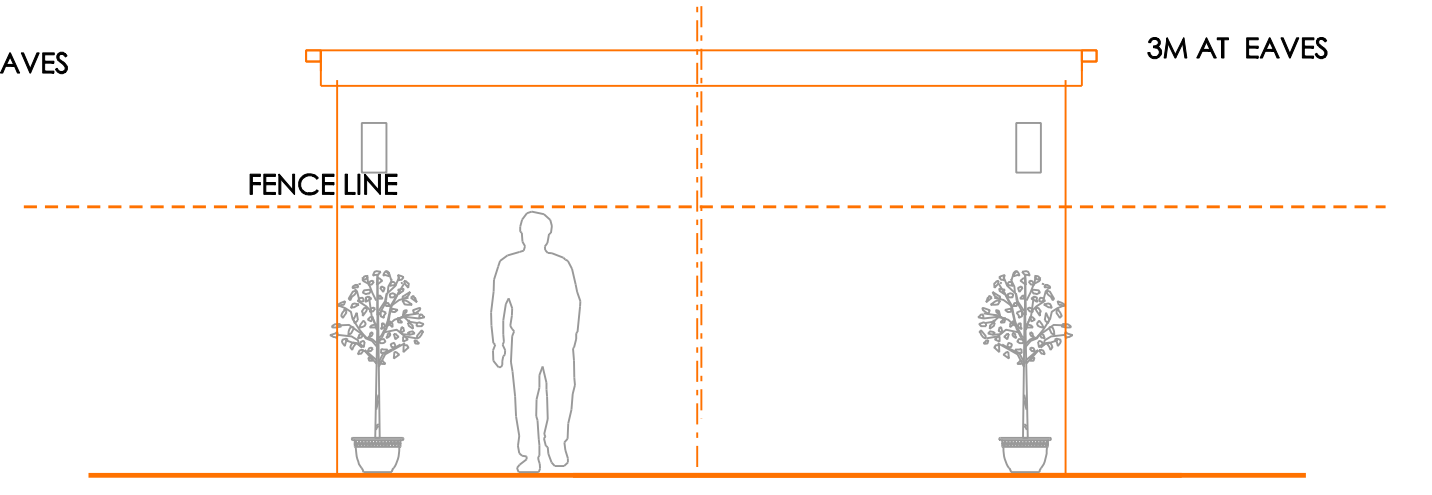

ELEVATION C



ELEVATION B

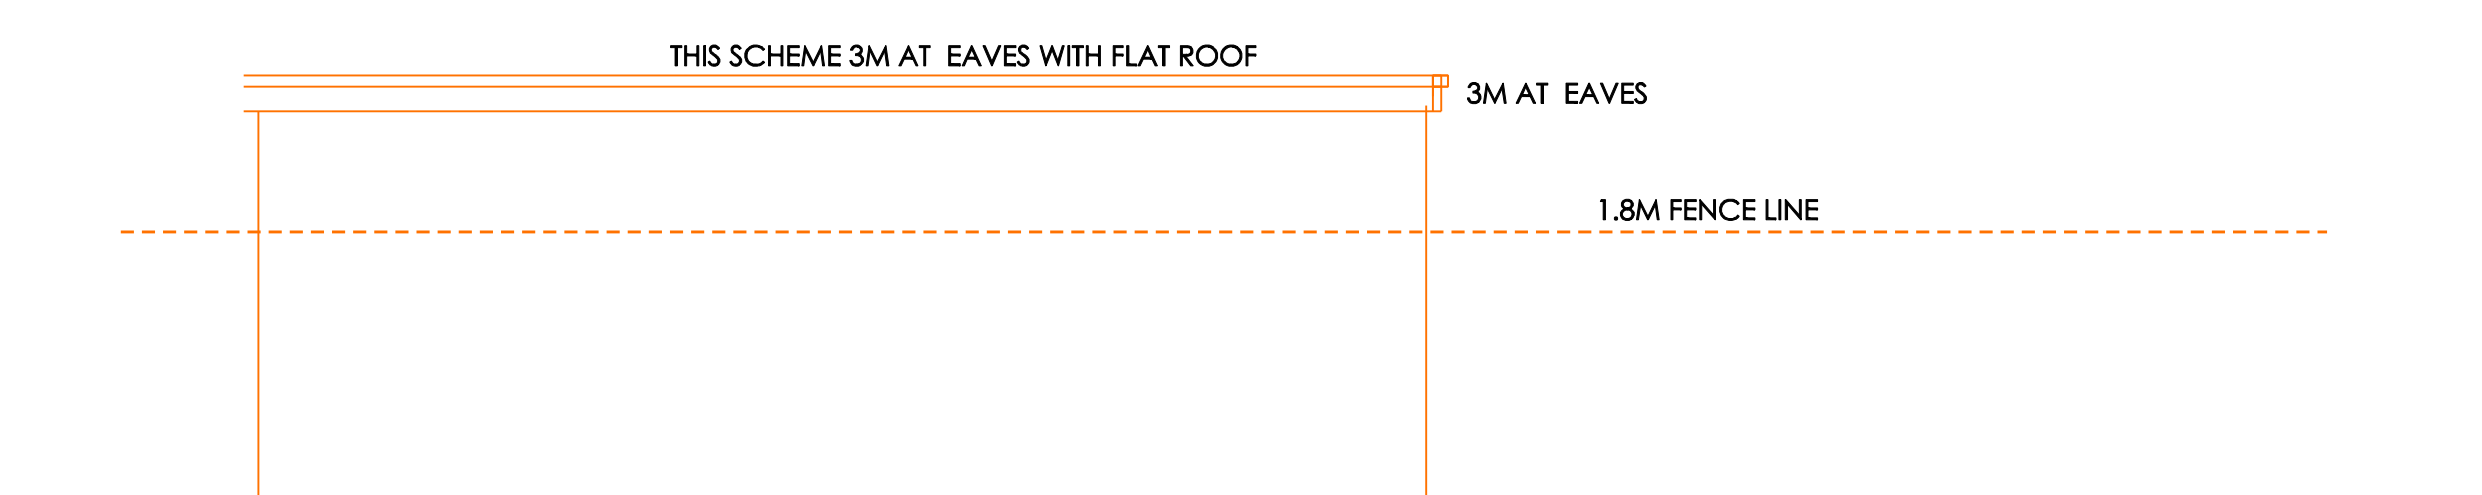

ELEVATION D

- DEMOLITION INDICATED IN GREEN DOTTED
- BLACK LINES ON PLAN INDICATE EXISTING TO BE RETAINED
- ORANGE LINES ON PLAN INDICATE PROPOSED WORKS

PROPOSED DETACHED GARAGE TO 9 GREENWICH CLOSE, NEWTON HEATH, M40 1NH

Drwg. No: 2022 / 05 / 01 Rev march 7th 2022
Date : march 7th 2022 Scale 1:50 @ A1

Mark Thorley design limited



Mark Thorley MCIAT, MSAI, MFPWS

Chartered Architectural Technologist, Party wall surveyor & Architectural Illustrator.

Mobile : 07986 453541
email : mark@mark-thorley.com
website www.markthorleydesign.com

649

REVISED 7th MARCH 2022