


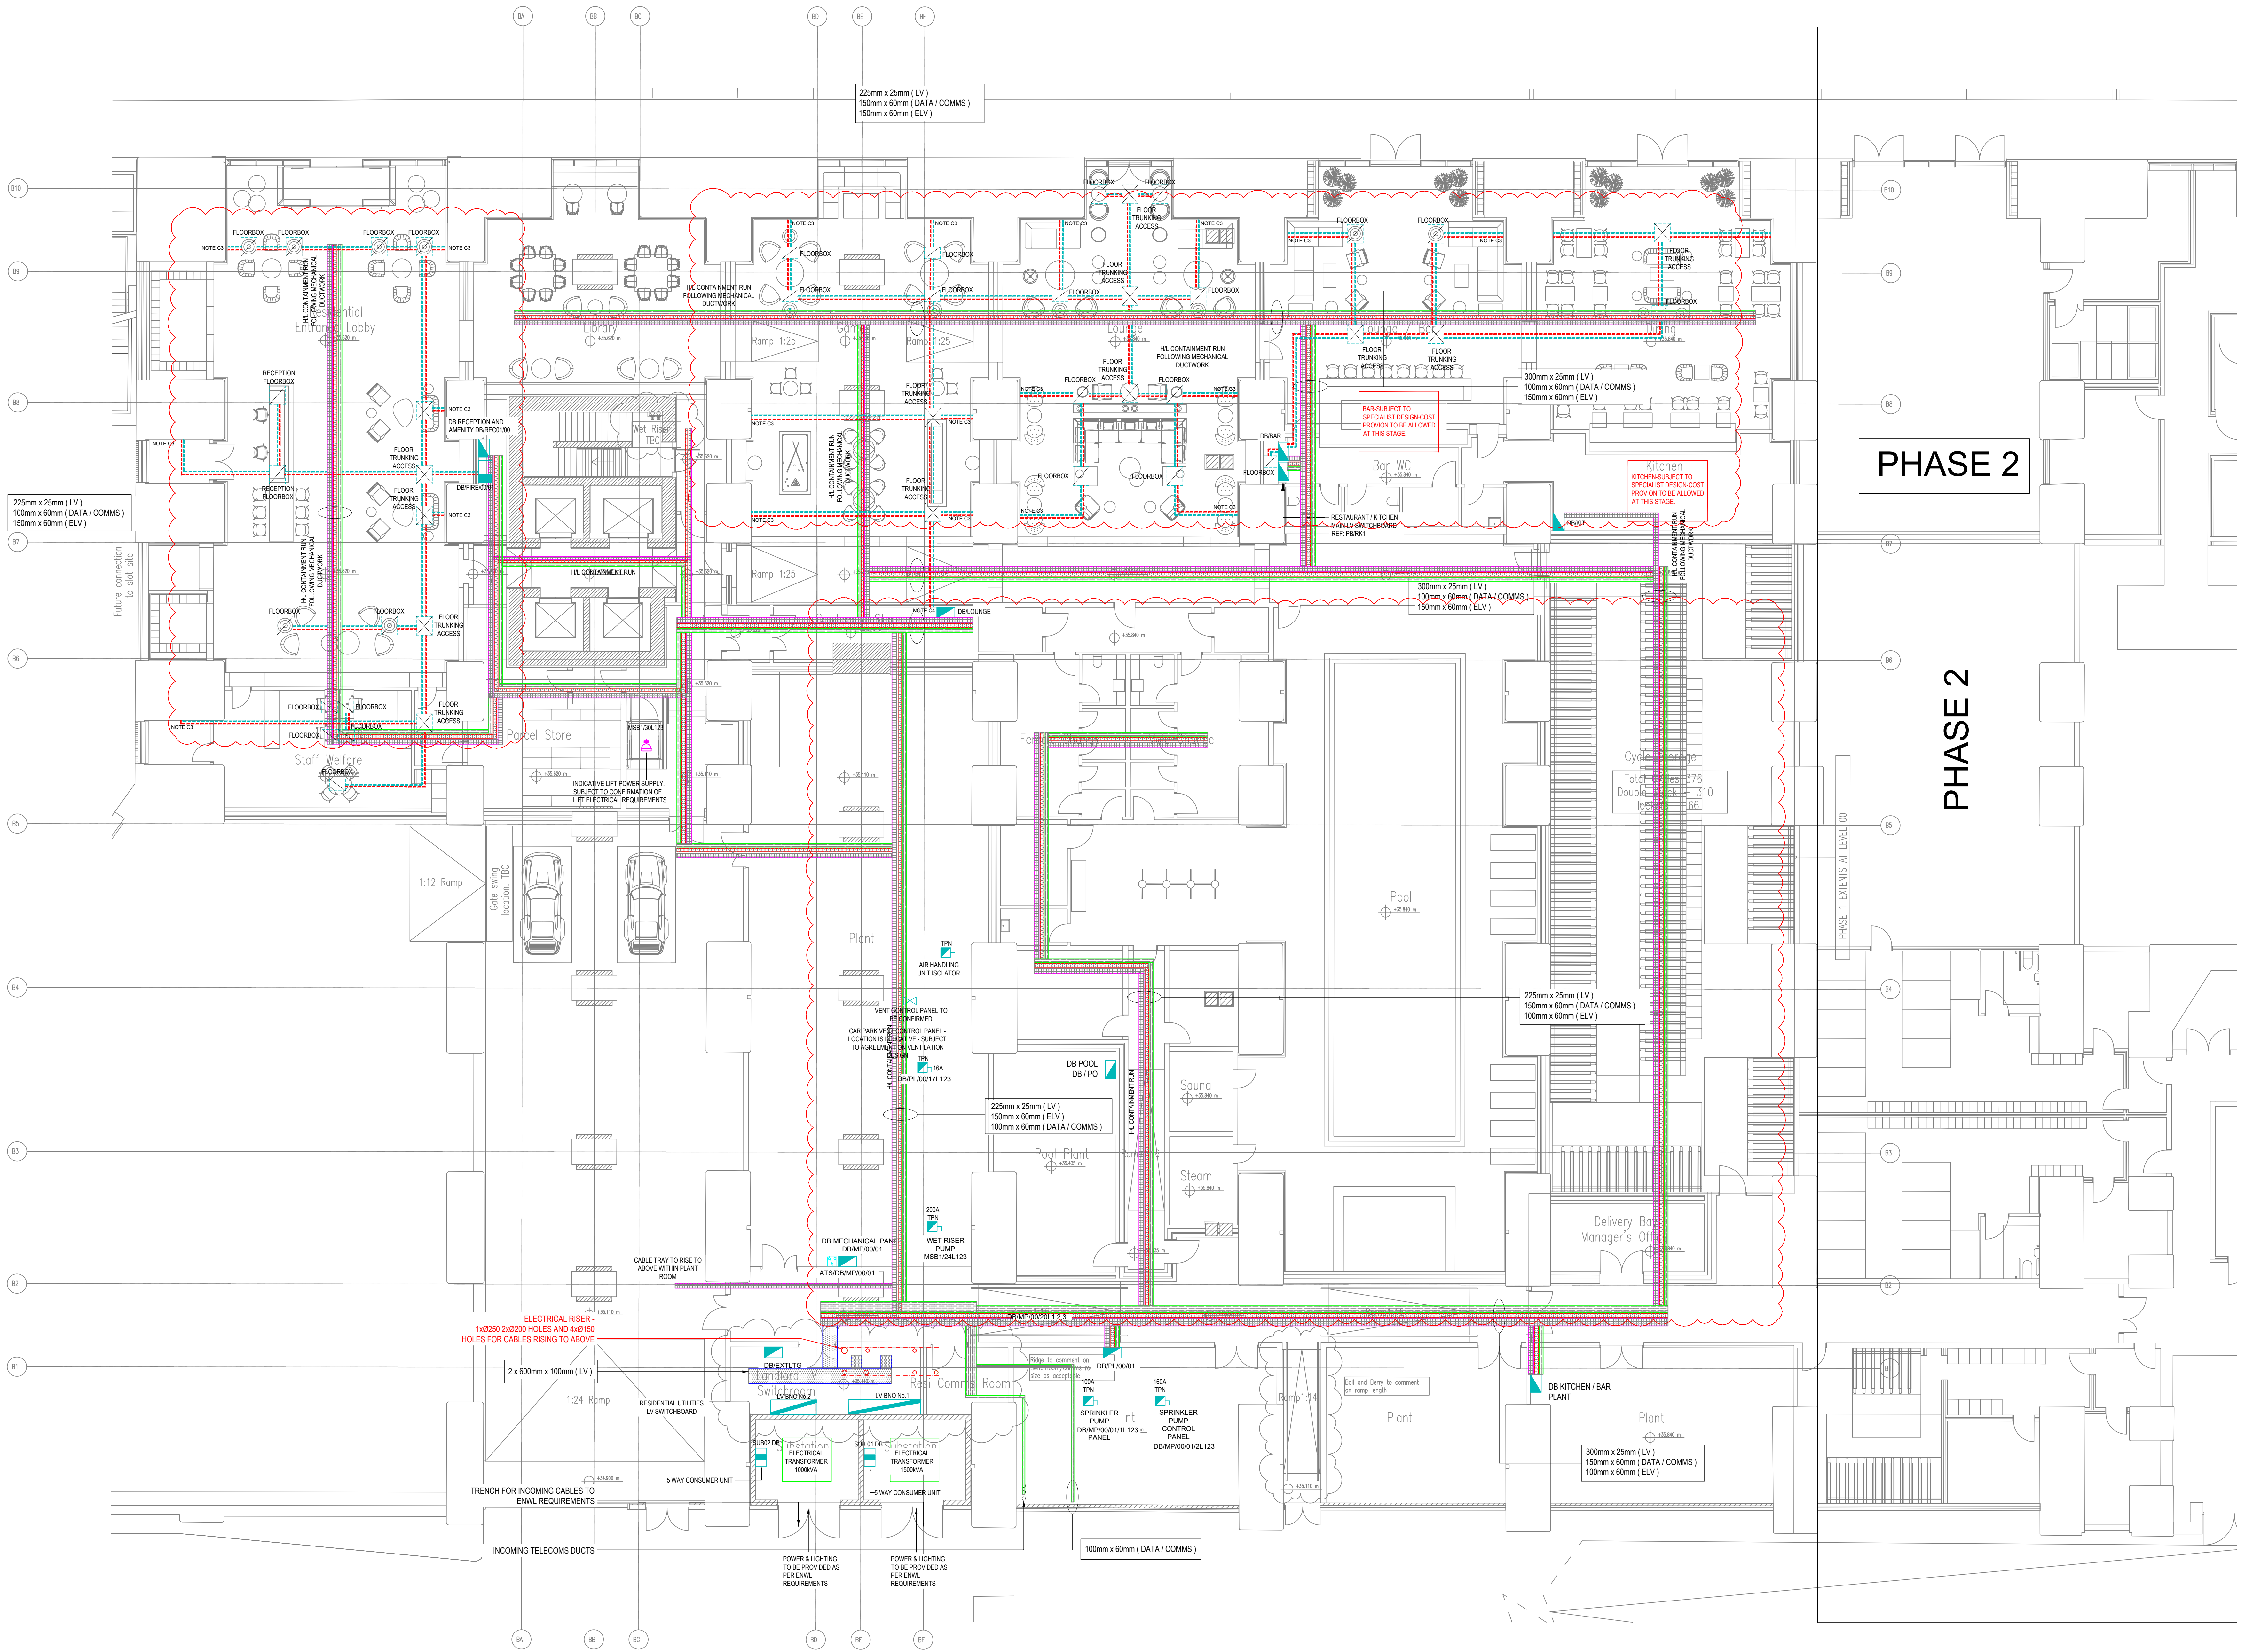

- CONTAINMENT LEGEND**
- LV DISTRIBUTION CABLE LADDER (SIZE AS INDICATED)
 - LV DISTRIBUTION (LV) FINAL CIRCUIT CABLE TRAY, (SIZE AS INDICATED)
 - ELV MULTISYSTEMS CABLE BASKET FOR FIRE ALARM, SECURITY, BMS
 - APARTMENT LV CABLE TRAY
 - DATA / COMMS / FIBRE / FT CABLE BASKET WITH METAL SEPARATOR FOR FT
 - IN SCREED GALVANISED STEEL TRUNKING
 - IN SCREED GALVANISED STEEL DATA / SPARE TRUNKING
- LV DISTRIBUTION LEGEND**
- MAIN LV SWITCHBOARD
 - TRM DISTRIBUTION BOARD
 - CONTROL PANEL / MCC
 - TRM AUTOMATIC TRANSFER SWITCH
 - SPIN SWITCH DISCONNECTOR
 - TRM SWITCH DISCONNECTOR
 - TRM MENNESIES 32A SOCKET SWITCHED INTERLOCKED RED P67
 - FLOOR BOX - FOR DETAILS REFER TO SMALL POWER DRAWINGS AND EQUIPMENT SCHEDULES
 - FLOOR TRUNKING ACCESS

DISCLAIMER NOTES:

- THIS DOCUMENT IS COPYRIGHT OF THE ORIGINATOR AND MUST BE TREATED AS CONFIDENTIAL.
- THIS DOCUMENT MUST NOT BE ALTERED, REPRODUCED OR DISTRIBUTED WITHOUT PRIOR WRITTEN CONSENT OF THE ORIGINATOR.
- THIS DOCUMENT MUST NOT BE ALTERED - THE ORIGINATOR ACCEPTS NO RESPONSIBILITY FOR ANY DISCREPANCIES ARISING AS A RESULT OF THE ORIGINATOR'S INFORMATION BEING ALTERED BY OTHERS.
- ANY DISCREPANCY MUST BE REPORTED TO THE ORIGINATOR.
- DO NOT SCALE THIS DOCUMENT - USE FIGURED DIMENSIONS ONLY.
- ALL DIMENSIONS MUST BE CHECKED ON SITE PRIOR TO COMMENCEMENT OF ANY RELATED WORKS.
- THIS DOCUMENT MUST BE READ IN CONJUNCTION WITH ALL SUPPORTING DOCUMENTS PRODUCED BY THE ORIGINATOR AND OTHER PROJECT DISCIPLINES.
- THE ORIGINATOR ACCEPTS NO RESPONSIBILITY FOR THE ACCURACY OF BACKGROUND INFORMATION PRODUCED BY THIRD PARTIES - THIS MUST BE TREATED AS INDICATIVE ONLY.
- USERS OF THIS DOCUMENT ARE RESPONSIBLE FOR CHECKING WHICH REVISION IS CURRENT.
- THE DOCUMENT STATUS 'INFORMATION' OR 'PRELIMINARY' INDICATES THAT THIS DRAWING IS FOR REFERENCE PURPOSES ONLY - THE ORIGINATOR WILL ACCEPT NO RESPONSIBILITY FOR THE COMPLETENESS OF INFORMATION UNDER THIS STATUS.
- THE DOCUMENT STATUS 'RECORD' OR 'AS BUILT' HAS BEEN PREPARED, IN PART, BASED UPON INFORMATION FURNISHED BY OTHERS. WHILE THIS INFORMATION IS BELIEVED TO BE RELIABLE, THE ORIGINATOR ASSUMES NO RESPONSIBILITY FOR THE ACCURACY OF THIS 'RECORD' OR 'AS BUILT' DOCUMENT OR FOR ANY ERRORS OR OMISSIONS THAT MAY HAVE BEEN INCORPORATED INTO IT AS A RESULT OF INCORRECT INFORMATION PROVIDED TO THE ORIGINATOR. THOSE RELYING ON THE 'RECORD' OR 'AS BUILT' DOCUMENT ARE ADVISED TO OBTAIN INDEPENDENT VERIFICATION OF ITS ACCURACY.

DRAWING NOTES:

CDM REGULATIONS 2015

SIGNIFICANT OR NON-CONSISTENT RISKS AND RISKS WHICH ARE DIFFICULT TO MANAGE ARE IDENTIFIED ON THIS DRAWING USING THE FOLLOWING SYMBOLS, IDENTIFIED TO THE RIGHT WITH BRIEF ACCOMPANYING TEXT. FOR FURTHER DETAILS OF THE RISKS IDENTIFIED BY DESIGNERS, REFERENCE SHOULD BE MADE TO CDM HAZARD REGISTER.

GENERAL NOTES:

- DO NOT SCALE FROM THIS DRAWING.
- ALL DIMENSIONS ARE IN MILLIMETRES UNLESS OTHERWISE INDICATED.
- THIS DRAWING SHALL BE READ IN CONJUNCTION WITH ALL ARCHITECTURAL, STRUCTURAL, AND MEP DRAWINGS, DOCUMENTS, SPECIFICATIONS AND CONTRACT DOCUMENTS.

CONTAINMENT NOTES:

C1 - THE 'LV' CABLE BASKET SHALL BE PROVIDED WITH A METAL CABLE COVER TO FULLY SEGREGATE THE DIFFERENT WIRING SYSTEMS THROUGHOUT THEIR ENTIRE LENGTH OF RUN.

C2 - THE 'IN SCREED' FLOOR TRUNKING ROUTES ARE INDICATIVE & SUBJECT TO THE DESIGN / LAYOUT OF THE FLOOR BOXES BEING APPROVED.

C3 - POWER AND DATA DUCTS SHALL TERMINATE AT A SUITABLE

C2	DATE/UM POINT RELOCATED	19.10.2021	KW	CN
C1	STAGE 4a - X REF UPDATED, ADDITIONAL CABLE DUCTS / IN SCREED TRUNKING ADDED	31.07.2021	MT	CN
B	STAGE 4a	04.08.2021	MT	CN
A	STAGE 4a	17.05.2021	MT	CN
REV	DESCRIPTION	DATE	BY	CHKD

ORIGINATOR:

RIDGE
PROPERTY & CONSTRUCTION CONSULTANTS

BELVEDERE HOUSE, 5TH FLOOR
12 BOOTH STREET
MANCHESTER
M2 4AW

TEL: 0161 833 9579
FAX: 0161 833 9501
WWW.RIDGE.CO.UK

CLIENT:
ASK / SALBOY

IN ASSOCIATION WITH:
ABERLA

PROJECT:
VIADUX

TITLE:
**LV DISTRIBUTION & CONTAINMENT LAYOUT
GROUND FLOOR**

DRAWN BY: MT SCALE: 1:100 @ A0
CHECKED BY: CN DATE: 28.02.2021

STATUS:
INFORMATION

DRAWING No:	PROJECT	ORG.	ZONE	LEVEL	TYPE	ROLE	NUMBER	REV
5013698	RDG	ZB	00	PL	E	0600	C2	

ARCHITECTS DRAWING

REF: 0945-10333-SP-2A-00-R-A-000-100 - GA PLAN
L060_00_S242_4 THE CONSTRUCTION_P07_L060
DATE: 1-REV CREATED: 23-07-2021

SCALE 1:100

1 2 3 4 5
m