

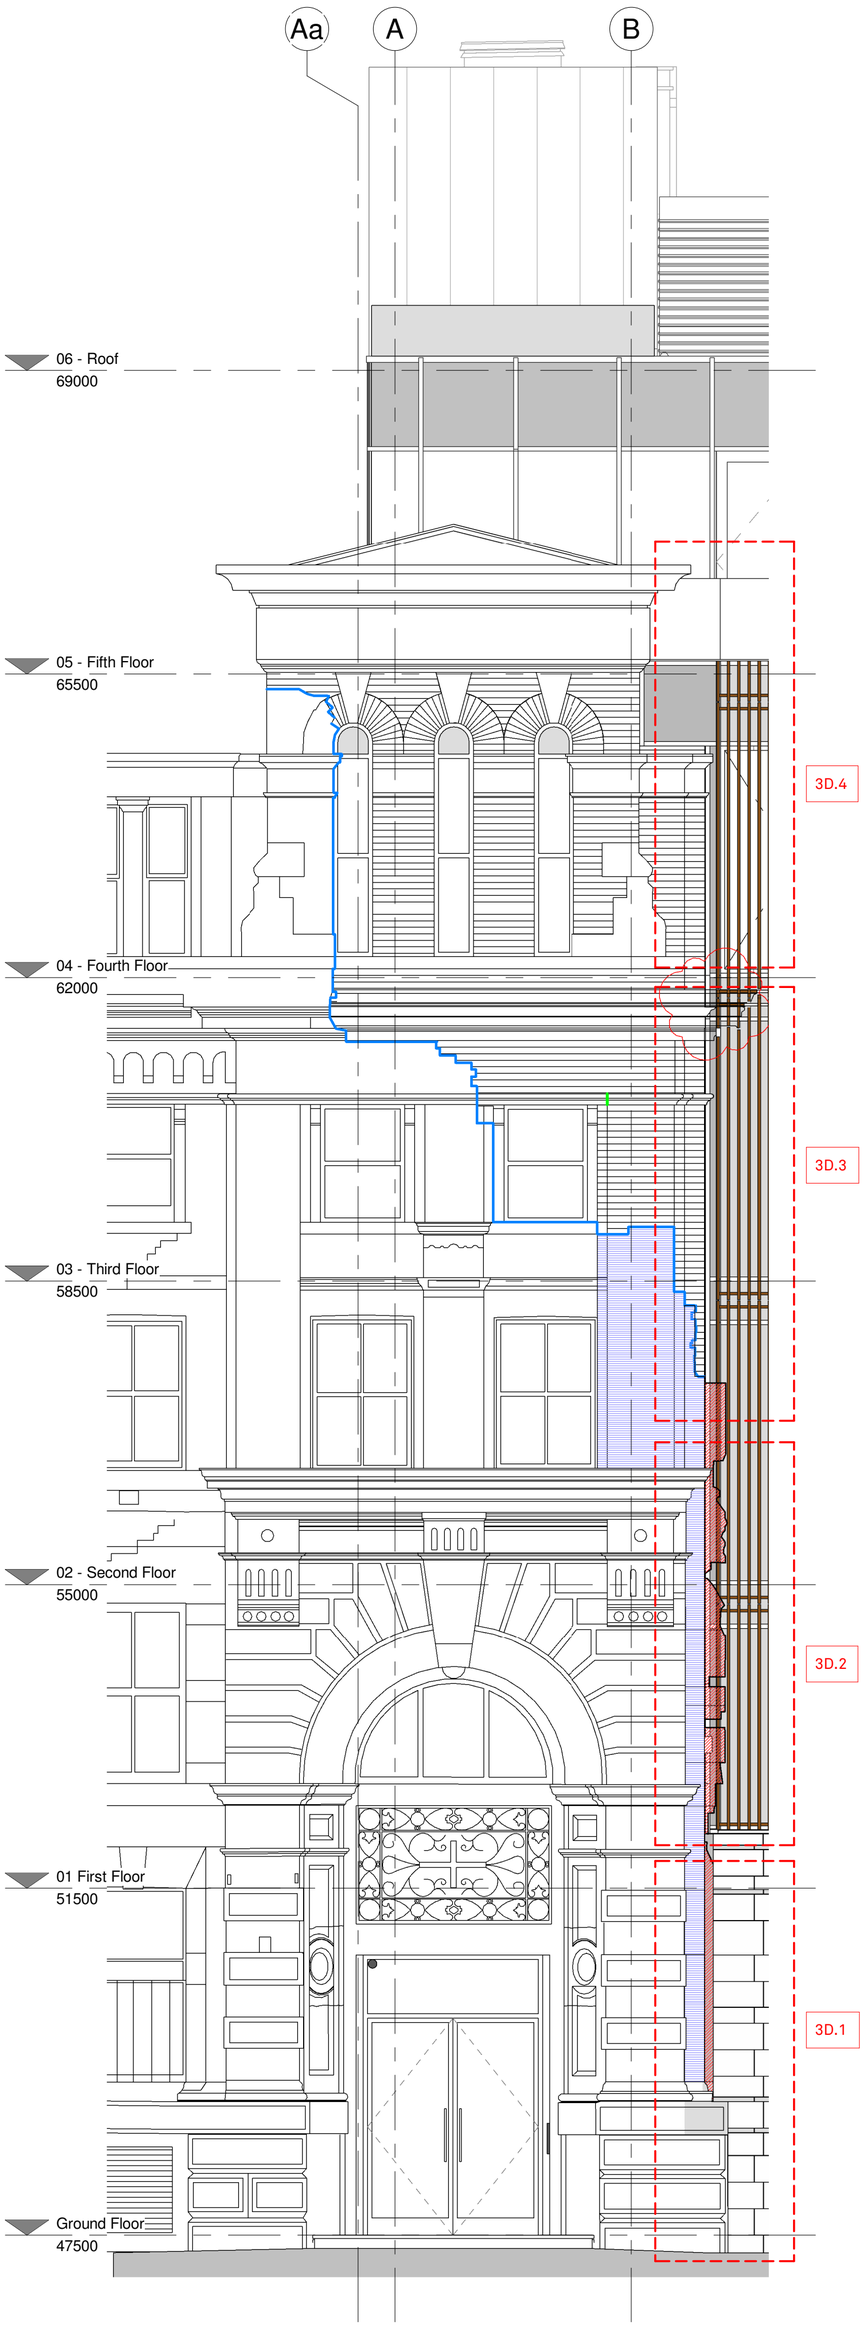



1 Dale Street - Existing Facade
1 : 50

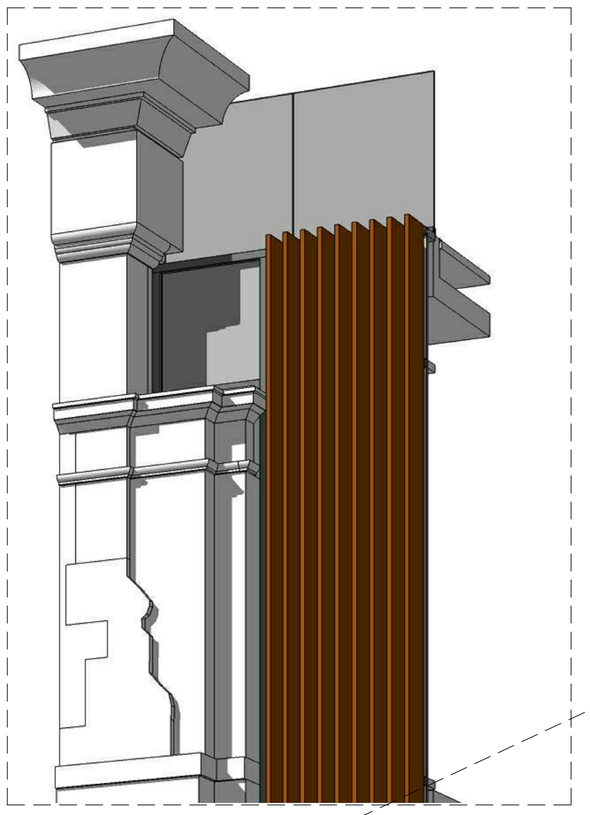


3D.4 - CURTAIN WALL AND MASONRY INTERFACE

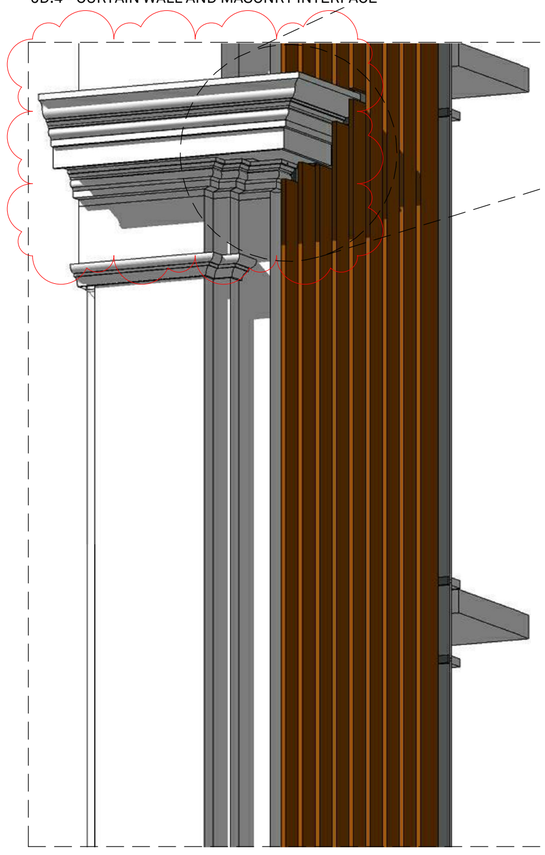

3D.3 - ABUTMENT - EXISTING CORNICE WITH FINS

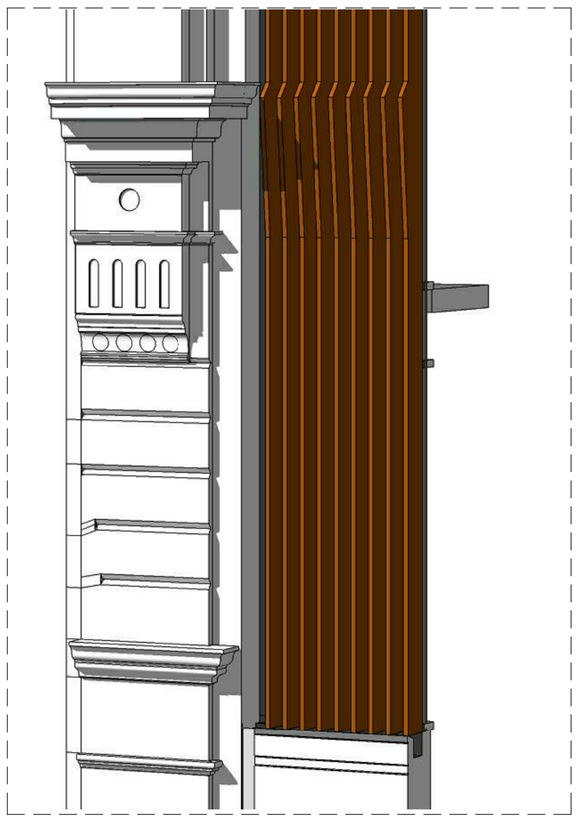

3D.2 - ABUTMENT - EXISTING CORNICE WITH FINS

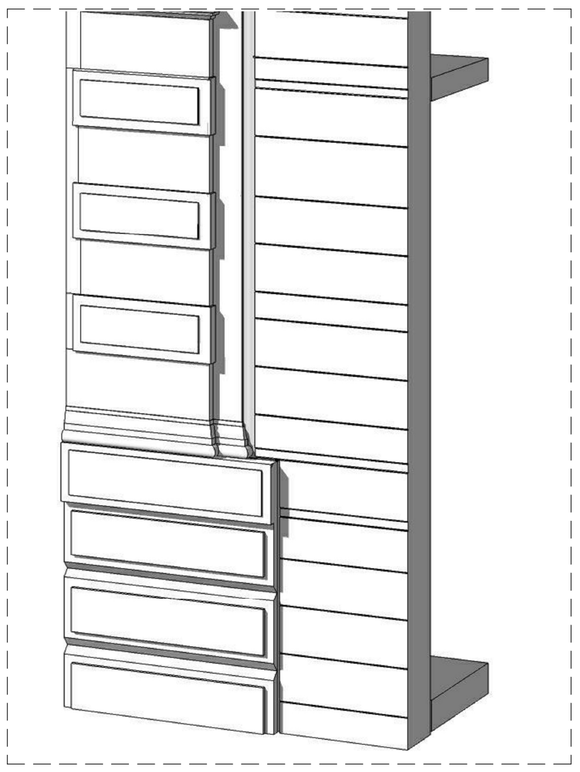

3D.1 - ABUTMENT - EXISTING FACADE WITH NEW



Installed flashing detail to top of cornice



PROPOSED EXISTING BRICK



PROPOSED EXISTING WINDOWS



PROPOSED EXISTING STONE

Notes

This document is © Falconer Chester Hall Limited
All drawing measurements shall not be obtained by scaling. Any discrepancies on this document to be immediately reported to the Architect. Verify all dimensions and levels prior to construction. This Document shall be read in conjunction with related documents, specifications and associated models.

This drawing contains the following model files:

P16019-FCH-XX-XX-M3-A-0001 [P0.1] [S2]

Revision	Date	Rev By	Chk By	Description
P4	15.11.21	RE		As built image of flashing to top of cornice included. Step to office entrance included. Entrance door revised.
P3	22.07.21	LR	RE	Ramp shown on existing facade
P2	12.07.21	RE	GJ	4th Floor cornice updated to reflect site installation.
P1	11.06.20	RE		Abutment at plinth level revised

FALCONER CHESTER HALL

FCH

London | Liverpool | Manchester | Kuala Lumpur

Drawing No. **P16019-FCH-XX-XX-DR-A-6022** Rev. **P4**

Project Title **27 Dale Street, Manchester**

Drawing Title **Dale Street Abutment to Existing Facade Sheet 2**

Client **Kamani Property Group**

Status	Purpose of Issue	Date	Drawn By
S2	**For Comments**	**June 2020**	**RE**
Job No.	Drawing Stage	Scale	Checked By
P16-019	**(4) Technical Design**	**1 : 50 @ A1**	**GJ**

Tel +44 (0) 0151 243 5800
© Falconer Chester Hall Limited
www.fcharchitects.com