


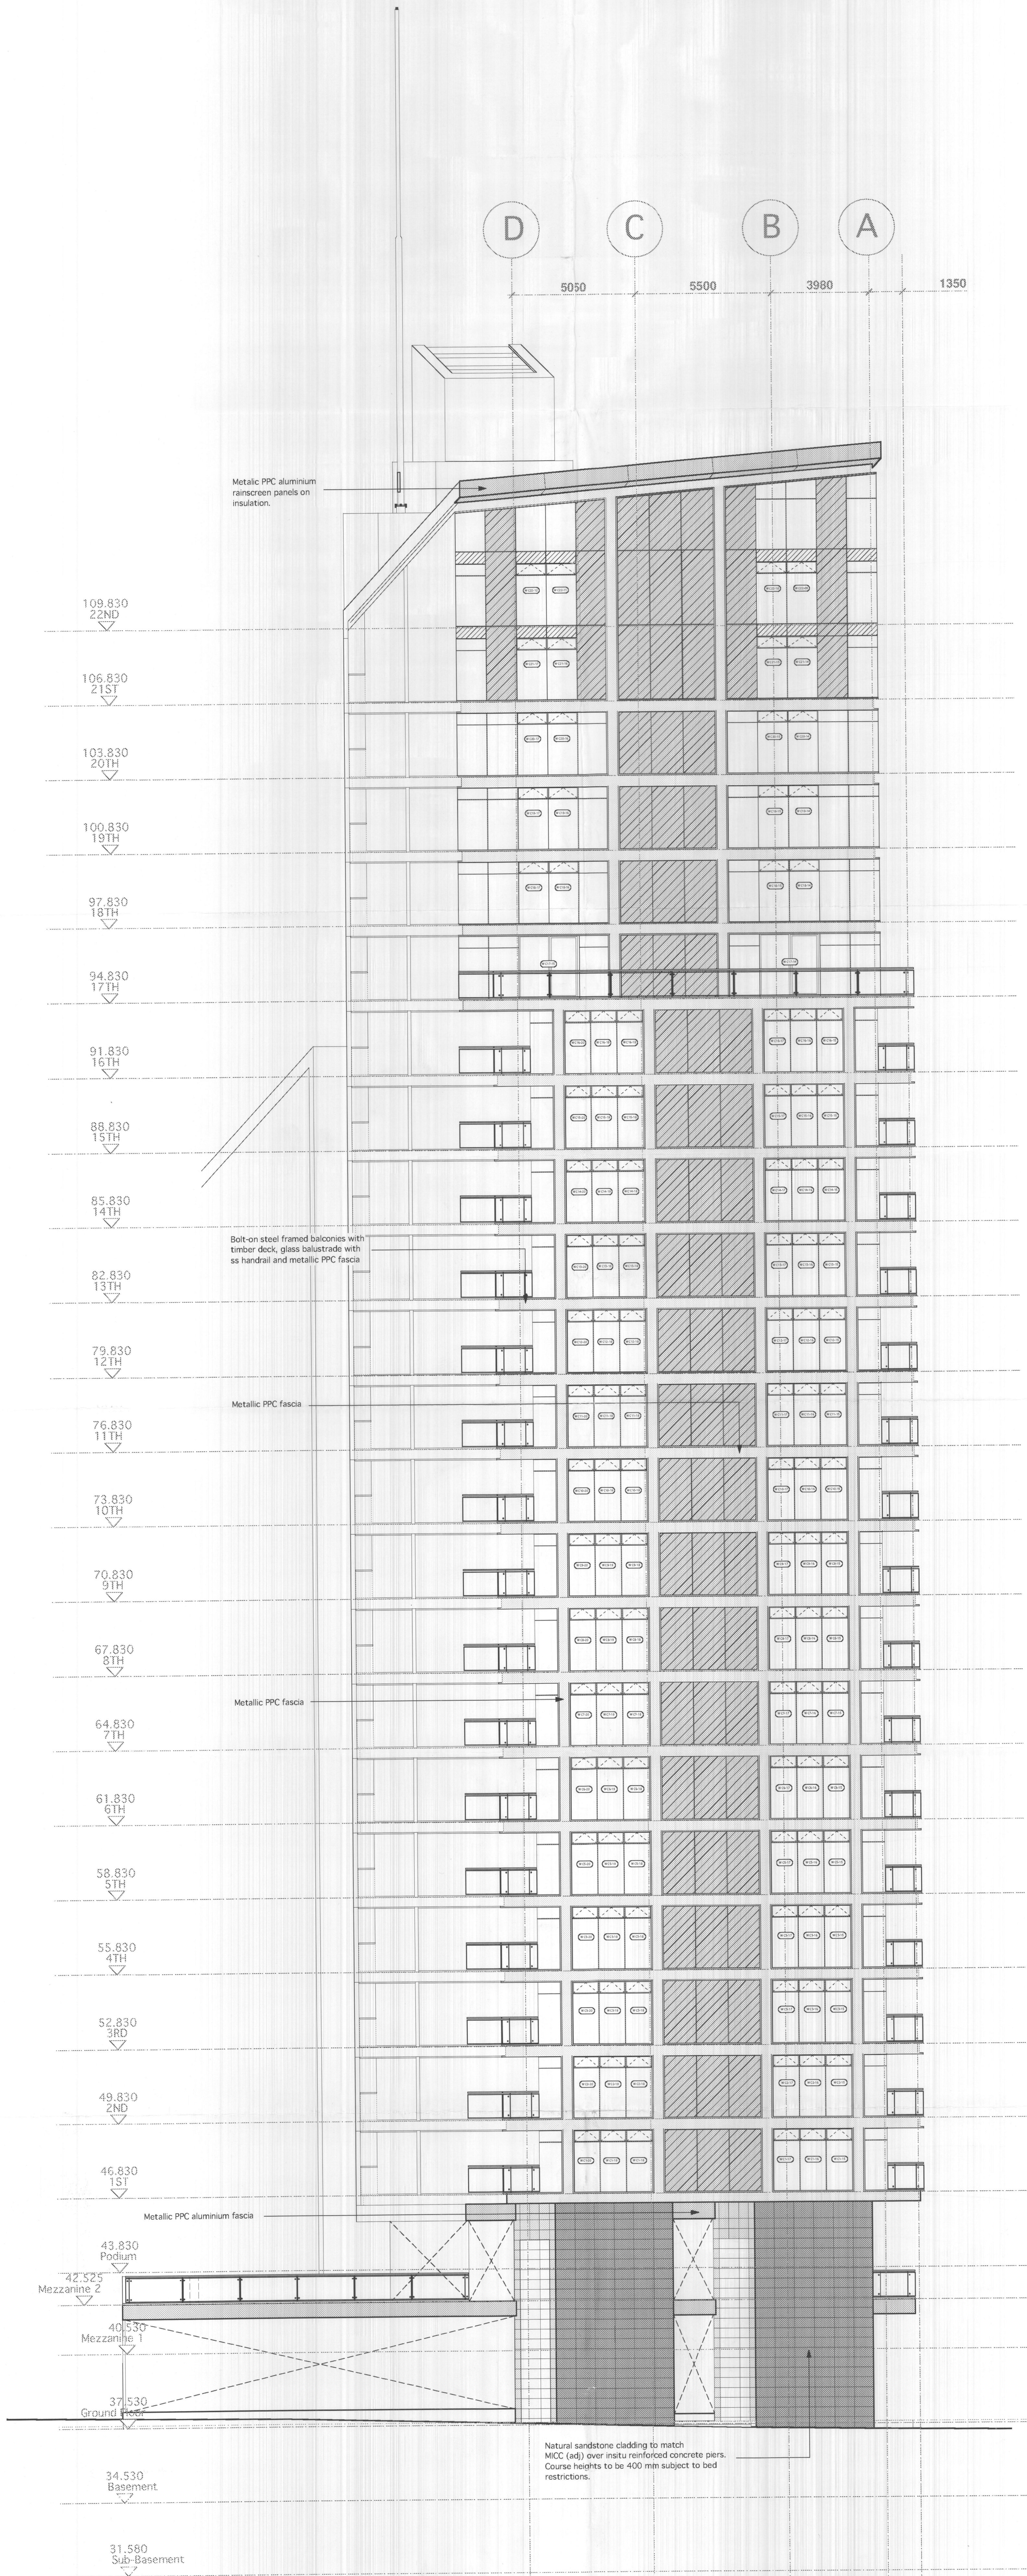

GENERAL NOTES 25.08.00

All setting out must be checked on site.
All levels must be checked on site and refer to
Contractor's Design/Drawings unless otherwise stated.
All fixings and weatherings must be checked on site.
All dimensions must be checked on site.
This drawing must not be scaled.
This drawing must be used in conjunction with the
relevant specification clauses.
This drawing must not be used for land transfer purposes.
Calculated areas in accordance with Assael Architecture's Definition of
Areas for Schedule of Areas.
This drawing must not be used on site unless issued for construction
Review Status:
P=Prepared/Planning T=Tender C=Construction/Contract
© 2005 Assael Architecture Limited

DRAWING NOTES

ELECTRONIC FILE REF: A1621 4333-F1
STATUS: REVISION DATE: 01/01/06 CHECK: CM
P1 PRELIMINARY ISSUE 24.02.06 DF

NOTE
ALL THE DETAILS REFERRED TO ON THIS
DRAWING ARE NOT FOR CONSTRUCTION
UNTIL AND UNLESS THEY RECEIVE
CONSTRUCTION STATUS

Key

- Single glazed shadow box unit. Clear glass.
- Single glazed unit with solid wall behind. Opaque glass.
- Double glazed unit. Clear glass.

carillion

For information ☒
For comment ☐
For client sanction ☐
For construction ☐

CLIENT
George Wimpey City Ltd

PROJECT TITLE
Slot Site
Manchester

DRAWING TITLE
Block C
North Elevation
AS BUILT

SCALE @ A1 SIZE DATE
1:100 Feb '06

DRAWING: N° STATUS & REVISION
A1621 4333 P1

Assael

Assael Architecture Limited
Studio 13
50 Carmath Road
London SW6 3EG
T +44 (0) 20 7736 7744
F +44 (0) 20 7736 6677
E suriname@assael.co.uk
W www.assael.co.uk