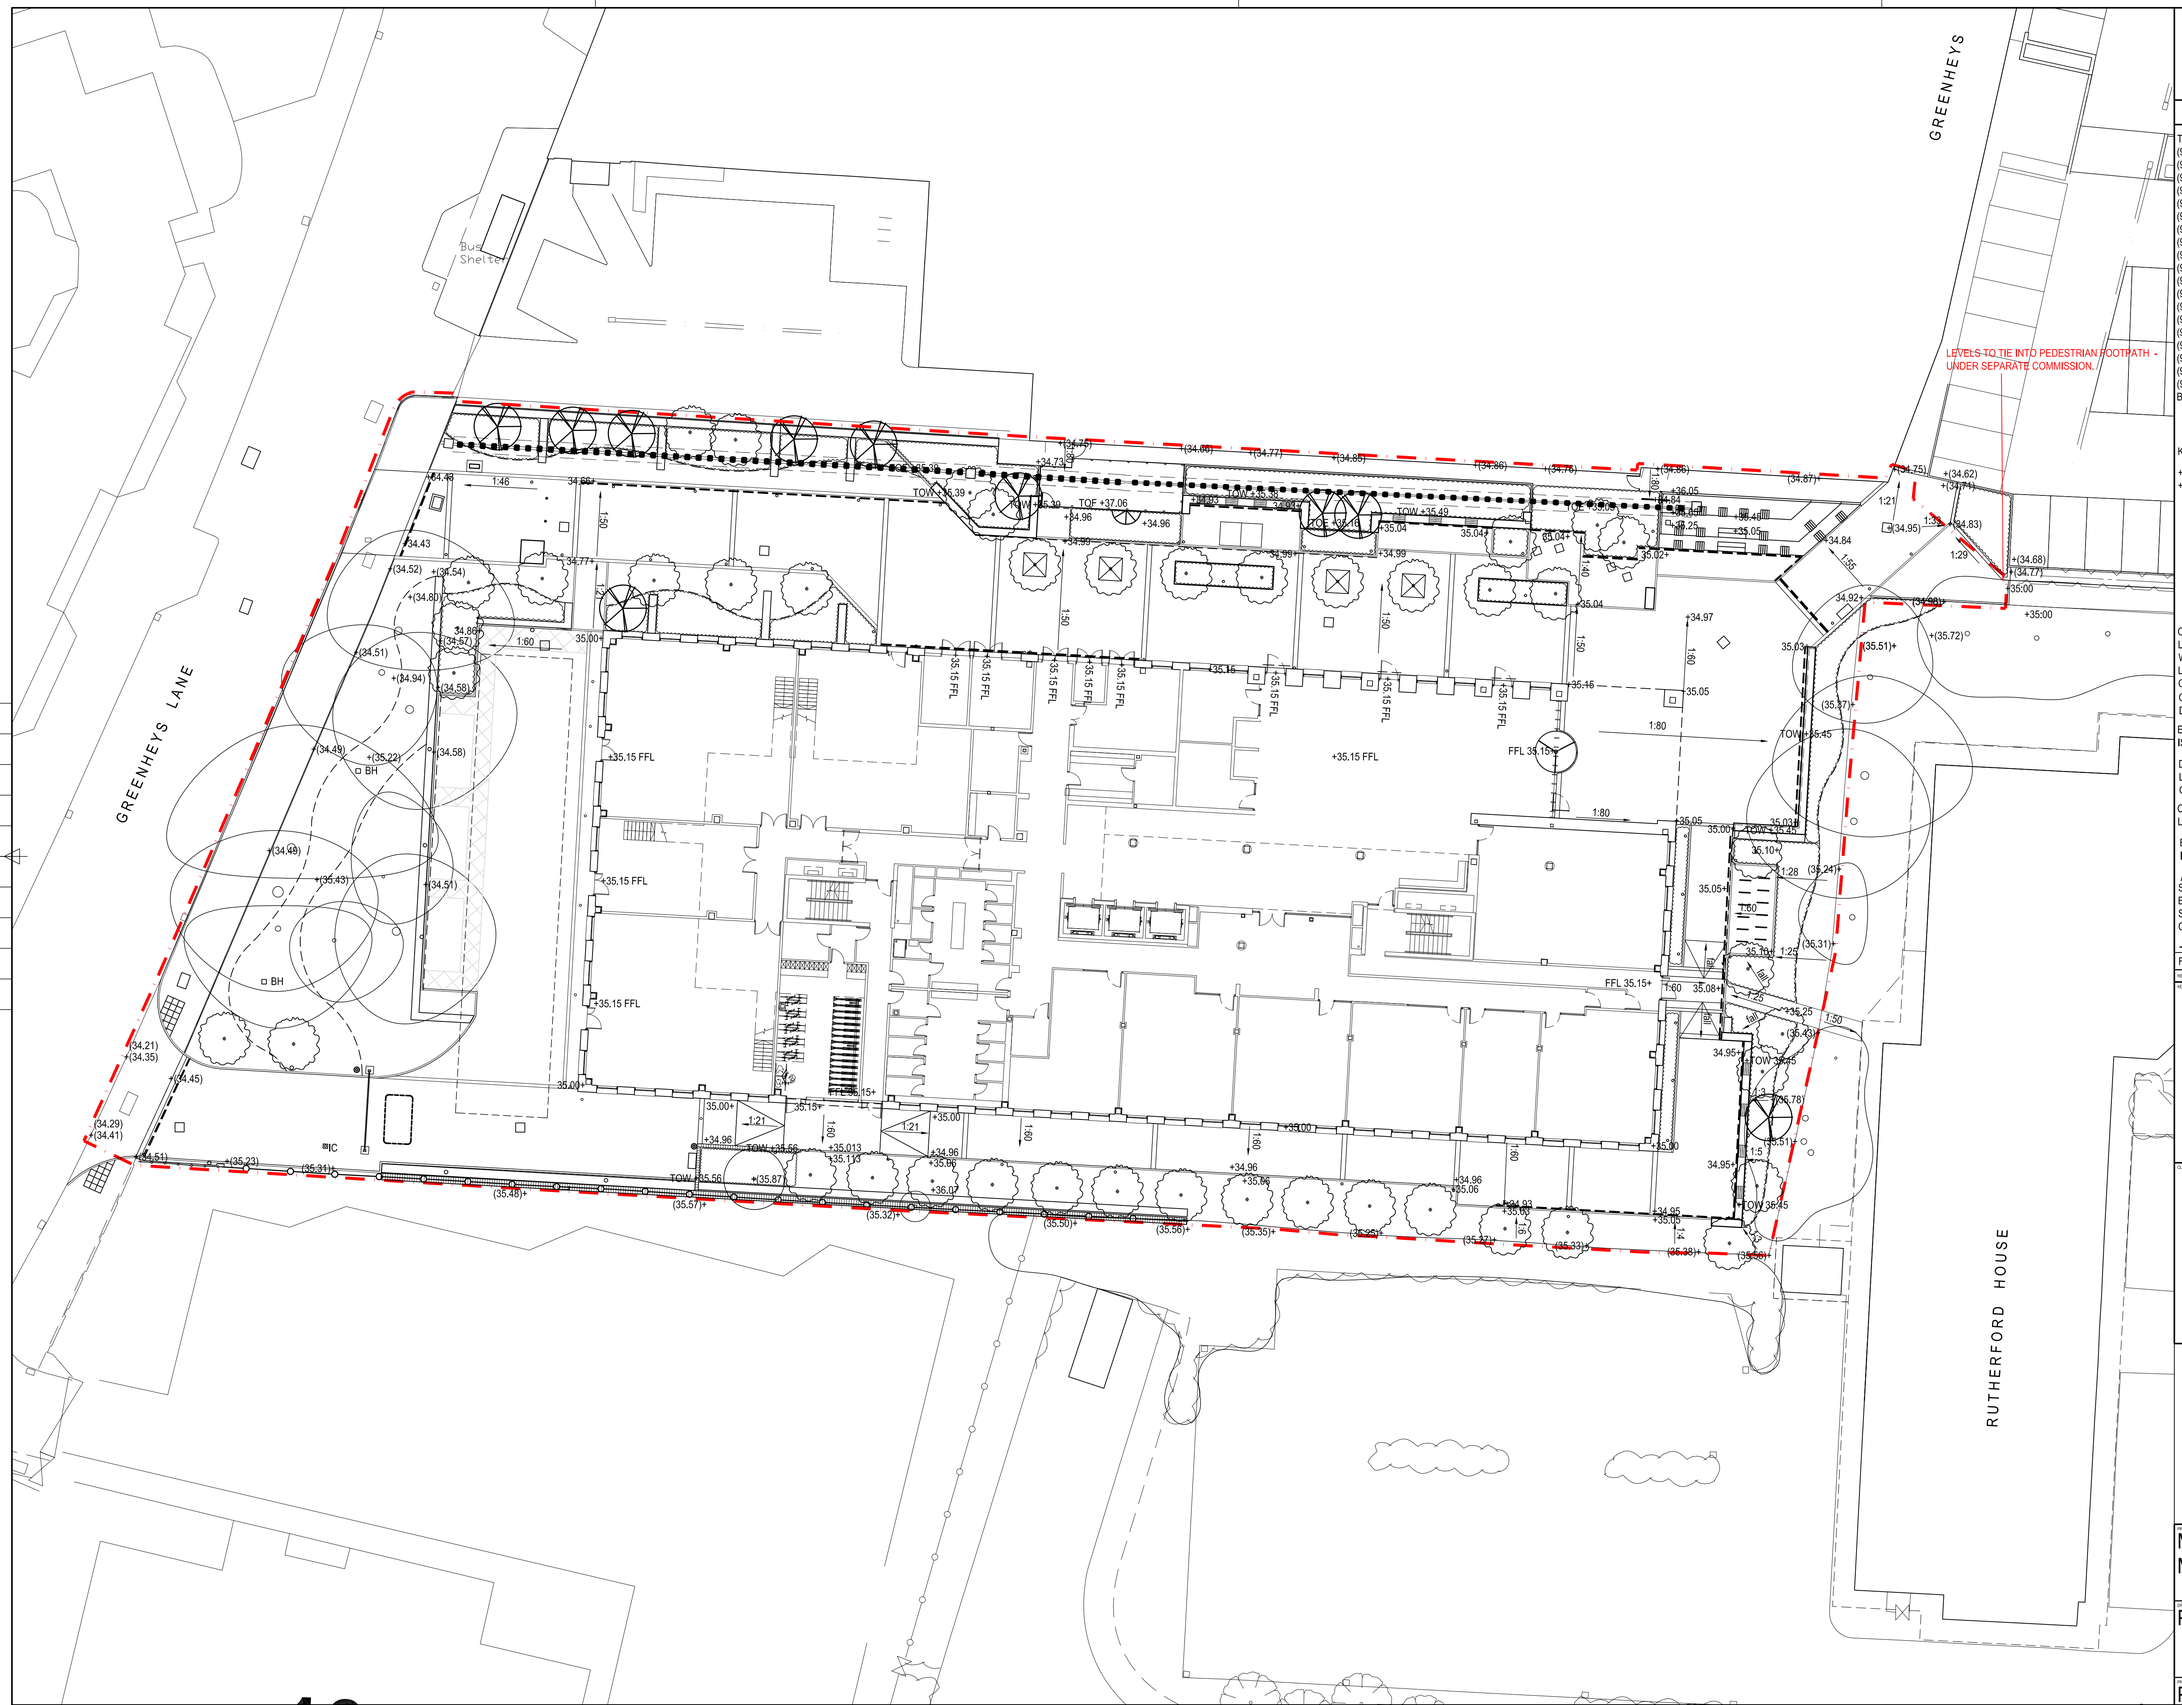


BUILDING DESIGN PARTNERSHIP SHALL HAVE NO RESPONSIBILITY FOR ANY USE MADE OF THIS DOCUMENT OTHER THAN FOR THAT WHICH IT WAS PREPARED AND ISSUED.

ALL DIMENSIONS SHOULD BE CHECKED ON SITE.

DO NOT SCALE FROM THIS DRAWING.

ANY DRAWING ERRORS OR DIVERGENCES SHOULD BE BROUGHT TO THE ATTENTION OF BUILDING DESIGN PARTNERSHIP AT THE ADDRESS SHOWN BELOW.

NOTES

TO BE READ IN CONJUNCTION WITH:
(9-)L003 - LANDSCAPE COLOUR MASTERPLAN
(9-)L006 - TREE CONSTRAINTS PLAN
(9-)L007 - LANDSCAPE PAVING MATERIALS
(9-)L101 - GENERAL ARRANGEMENT PLAN
(9-)L201 - TREE AND HEDGE PLAN
(9-)L202 - PLANTING PLAN
(9-)L301 - DETAIL AREAS SHEET 1 OF 3
(9-)L302 - DETAIL AREAS SHEET 2 OF 3
(9-)L303 - DETAIL AREAS SHEET 3 OF 3
(9-)L401 - TYPICAL CONSTRUCTION DETAILS
(9-)L402 - TYPICAL CONSTRUCTION DETAILS
(9-)L403 - TERRACE SEATING DETAILS
(9-)L404 - 'SW1' SEAT WALL DETAILS
(9-)L405 - 'SW2' SEAT WALL DETAILS
(9-)L406 - 'SW3' SEAT WALL DETAILS
(9-)L601 - LANDSCAPE SECTIONS SHEET 1 OF 2
(9-)L602 - LANDSCAPE SECTIONS SHEET 2 OF 2
(9-)L701 - TREE PIT DETAILS
(9-)L702 - TIMBER SCREEN DETAIL
BA-BDP-01-XX-SP-L-0001 - OUTLINE SPECIFICATION

KEY

+(30.00) EXISTING LEVEL RETAINED
+30.00 PROPOSED LEVEL

REVISION	DESCRIPTION	DRAWN	CHECKED	DATE
C02	LEVELS TO SOUTHERN BOUNDARY AMENDED, LOW CONCRETE WALL OMITTED, AND LOW BRICK WALL ADDED TO CORNER. LEVELS TO NORTH EAST CORNER AMENDED AS PART OF ONGOING WORK TO RESURFACE FOOTPATH.	LJ	JF	28.11.2021
C01	DRAWING REVISION AMENDED FOR CONSTRUCTION.	LJ	JF	18.11.2020
E	ISSUED FOR CONSTRUCTION.	LJ	JF	10.11.2020
D	LEVELS AMENDED TO NEW DESIGN ON SOUTH EAST CORNER OF BUILDING.	LJ	JF	31.01.2020
C	LEVELS UPDATED IN ACCORDANCE WITH DESIGN CHANGES	LJ	JF	31.01.2020
B	INTERIM STAGE 4 ISSUE	CZ	DAW	12.12.19
A	STAGE 3 COMMENTS AND CHANGES INCLUDING: BUILDING FOOTPRINT INCREASE, FFL RAISED BY 150mm, NEW SERVICE AREA ACCESS, RED LINE BOUNDARY, TESLA COMPOUND AREA, ADJUSTMENT TO ENTRANCE PLAZA	CZ	DAW	16.09.19
-	FIRST ISSUE	CZ	DAW	01.08.19

KEY PLAN

NORTH

CLIENT

MSP
MANCHESTER SCIENCE PARTNERSHIPS

BDP.

11 Ducie Street
P.O. Box 85, Piccadilly Basin
Manchester M60 3JA
United Kingdom
T +44 (0)161 828 2200
F +44 (0)161 828 2235
www.bdp.com

PROJECT TITLE
MSP BASE Building
MANCHESTER SCIENCE PARKS

DRAWING TITLE
PROPOSED LEVELS

SCALE @ A1
1:200

DATE
AUG '19

PROJECT NUMBER
P3000597

DRAWING No.
BA-BDP-01-XX-DR-L-(9-)L005

REVISION
C02