


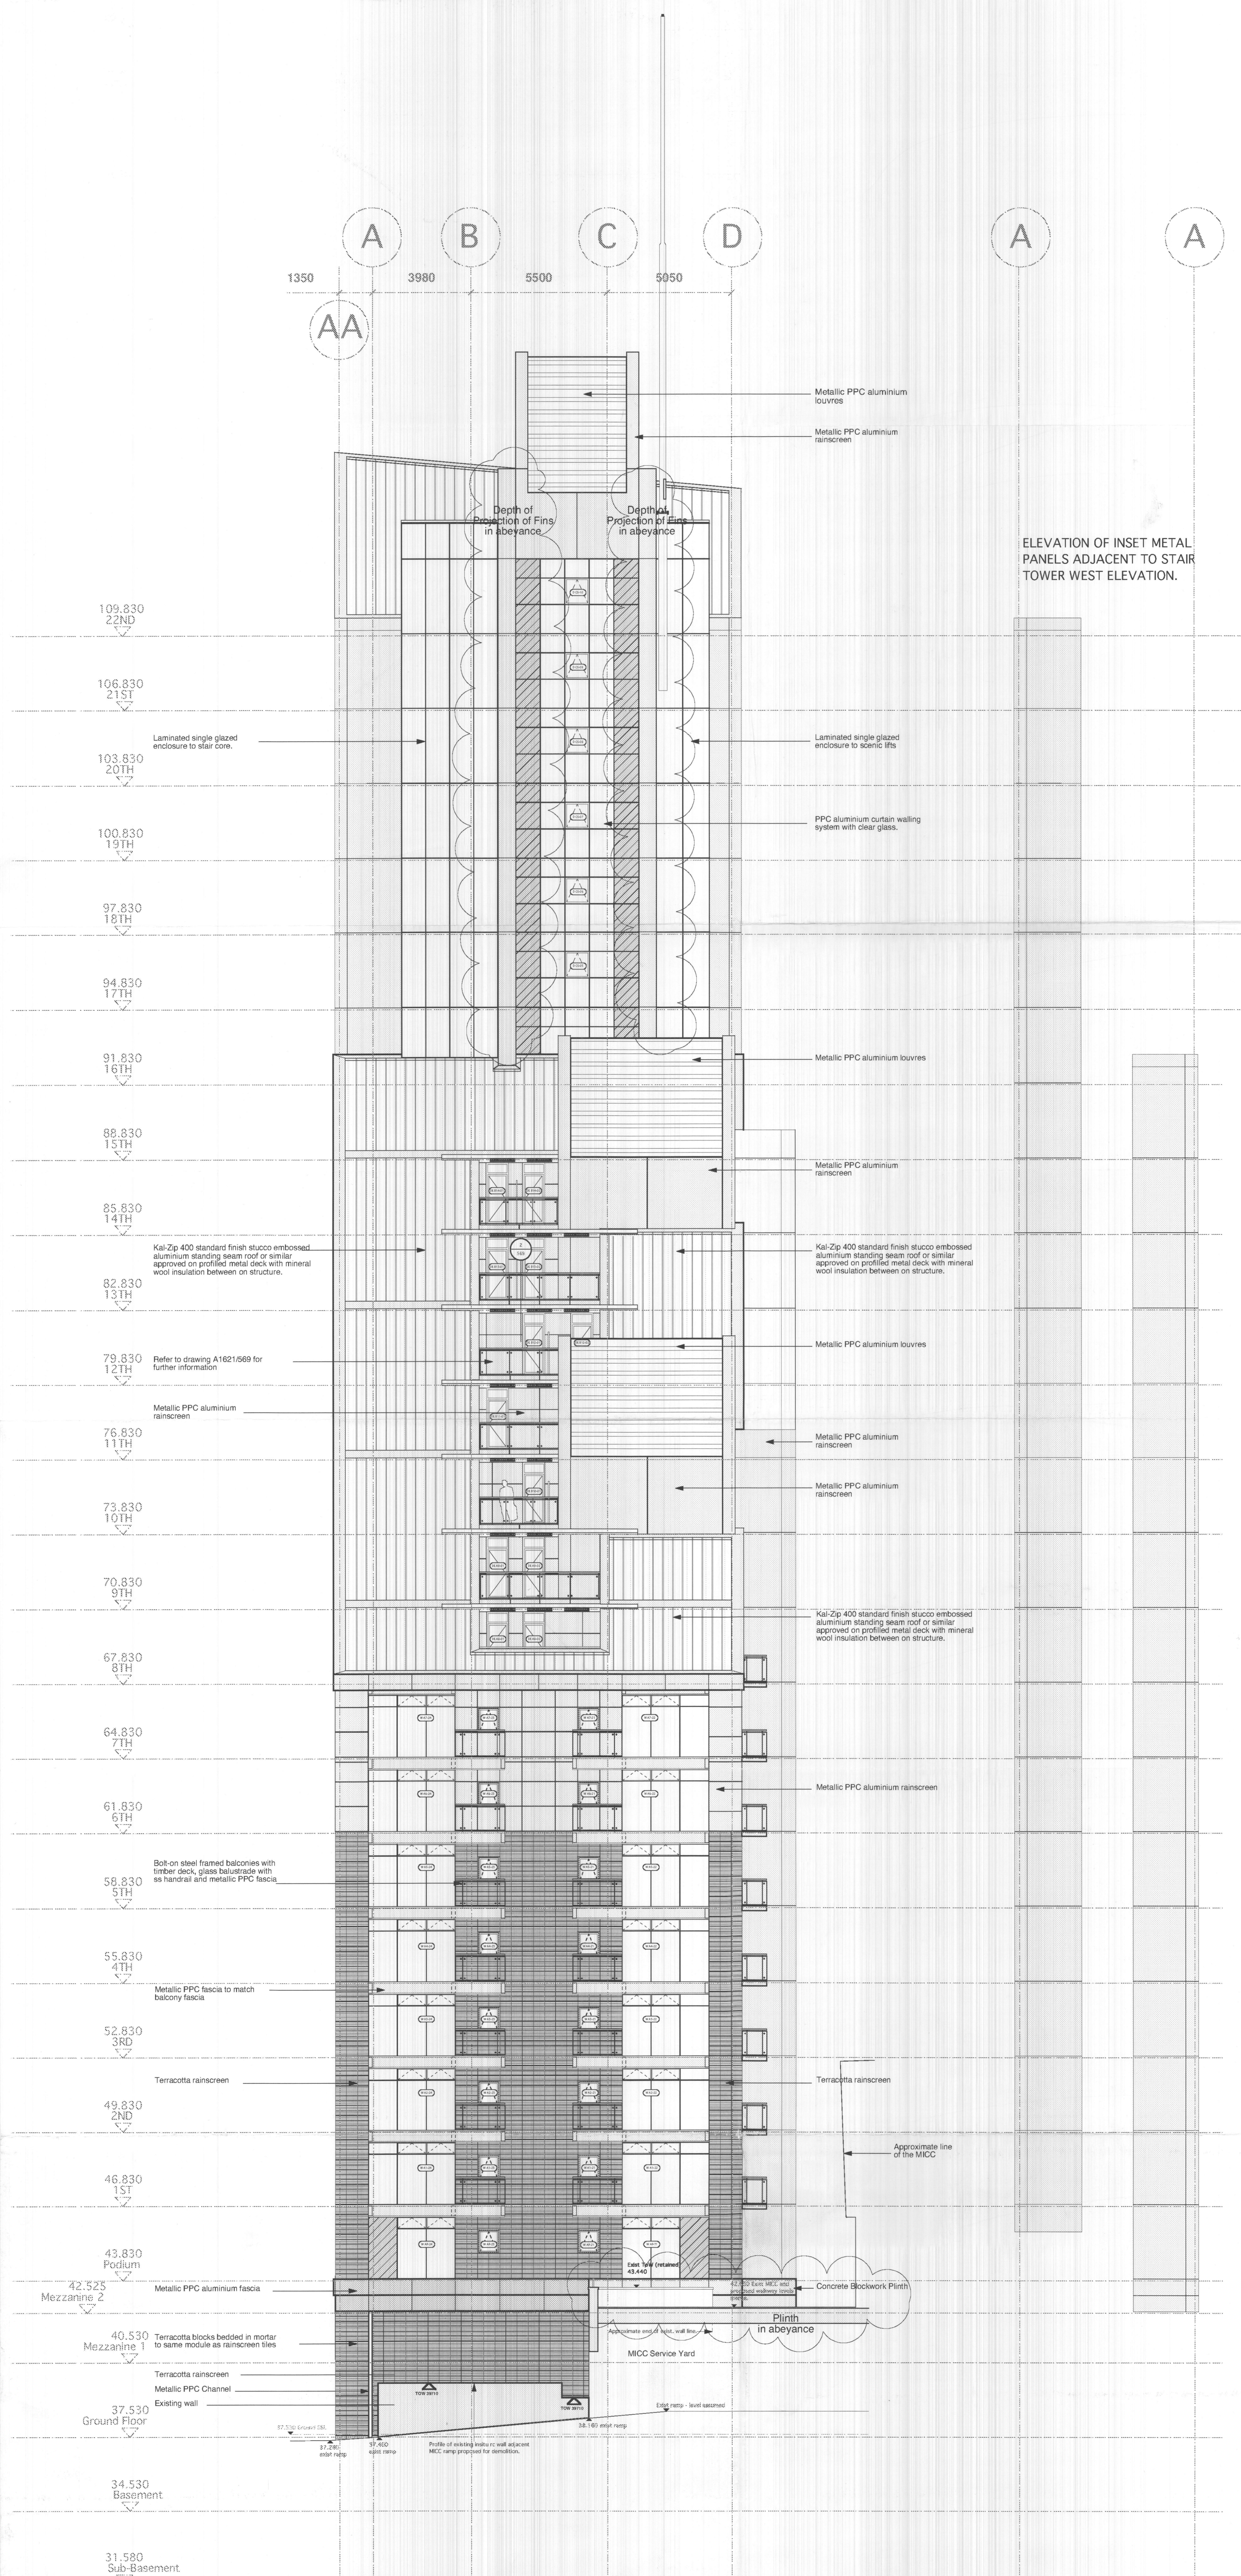

GENERAL NOTES	25.08.00
---------------	----------

All setting out must be checked on site
All levels must be checked on site and refer to
Ordinance Datum. Newlyn unless alternative Datum given
All fixings and weatherings must be checked on site
All dimensions must be checked on site
This drawing must not be scaled
This drawing must be read in conjunction with the
relevant specification clauses
This drawing must not be used for land transfer purposes
Calculated areas in accordance with Assael Architecture's Definition of
Areas for Schedule of Areas
This drawing must not be used on site unless issued for construction
Revision Status:
P=Preliminary/Planning T=Tender C=Construction/Contract
© 2006 Assael Architecture Limited

DRAWING NOTES

ELECTRONIC FILE REF N°	A1621 4337-F1		
STATUS REVISION	DATE	DRN	CHECK CD
D1 - PRELIMINARY ISSUE	24.02.06	DE	

NOTE
ALL THE DETAILS REFERRED TO ON THIS
DRAWING ARE NOT FOR CONSTRUCTION
UNTIL AND UNLESS THEY RECEIVE
CONSTRUCTION STATUS

Key	
	Single glazed shadow box unit. Clear glass.
	Single glazed unit with solid wall behind. Opaque glass.
	Double glazed unit. Clear glass.

CLIENT
George Wimpey City Ltd

PROJECT TITLE
**Slot Site
Manchester**

DRAWING TITLE

Block C
South Elevation
AS BUILT

SCALE @ A1 SIZE	DATE
1:100	Feb '06
DRAWING Nº	STATUS & REVISION
A1621/4337	P1

Assael

Assael Architecture Limited
Studio 13
50 Carnarvon Road
London SW6 3EG
T +44 (0) 20 7736 7744
F +44 (0) 20 7736 6677
E surname@assael.co.uk
W www.assael.co.uk