

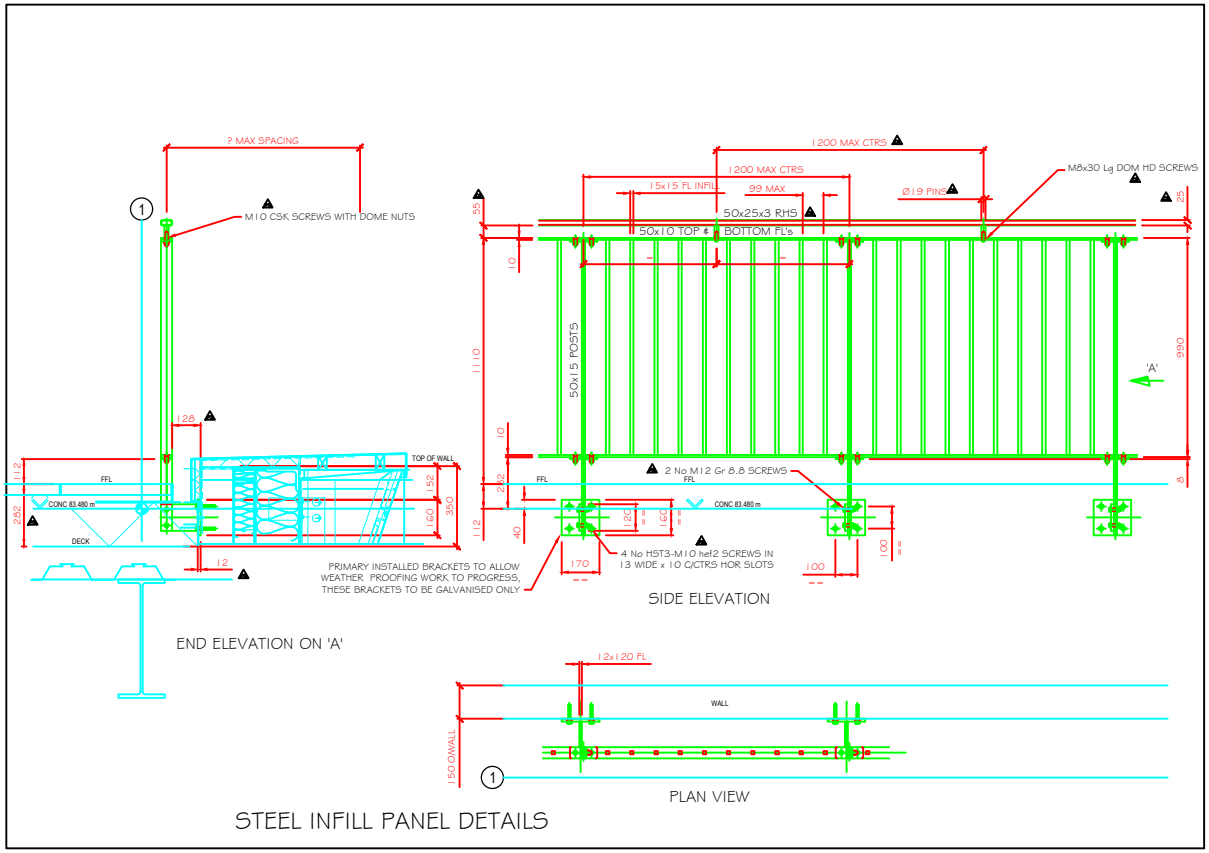


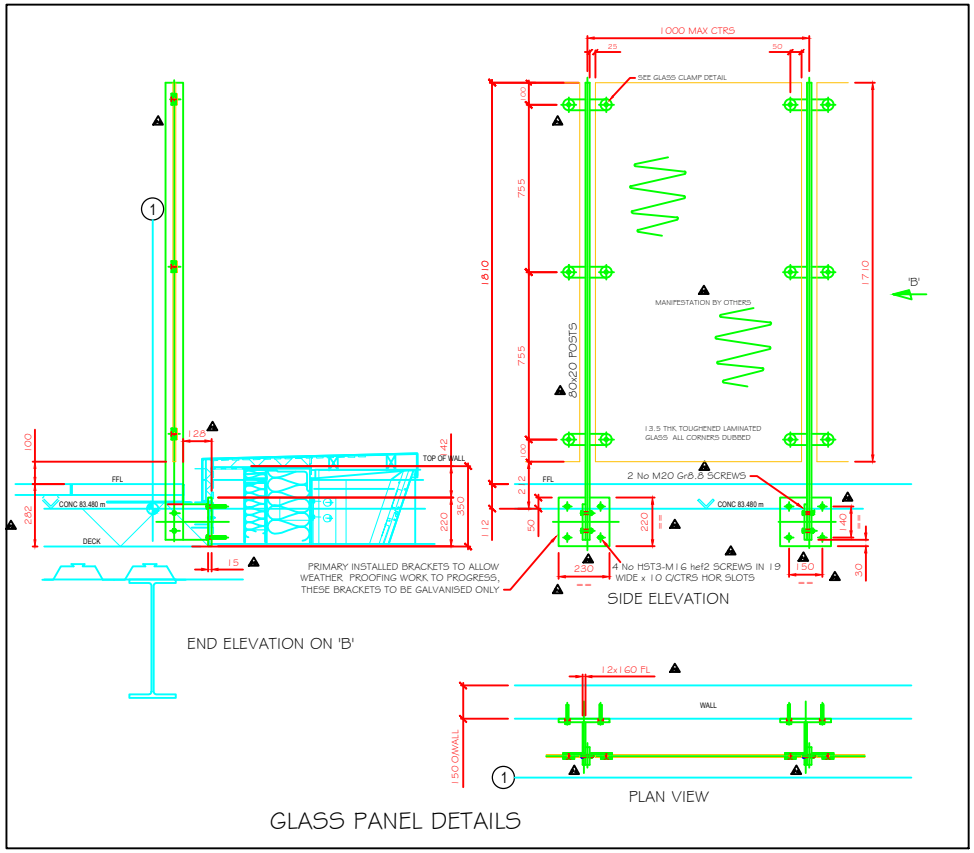

NOTES:
MATERIAL: MILD STEEL S275, GALV POWDER COATED COLOUR RAL 9011 MATT GLOSS LEVEL 30%. ALL SCREWS PAINTED TO MATCH FINAL COLOUR AT SITE.

UNLESS STATED OTHERWISE ALL WELDS ARE 6mm FILLET OR FULL STRENGTH BUTT WELDS (SUBJECT TO RWC / ENGINEERS REVIEW).
DESIGN LOAD - 0.74kN/m.

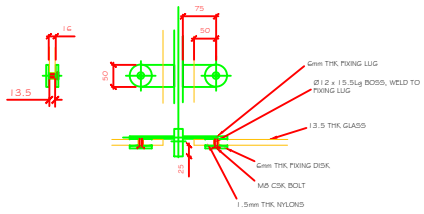

ENLARGED TYPICAL GLASS FIXING DETAIL
(10mm THK)

NOTES:
MATERIAL: MILD STEEL S275, GALV POWDER COATED COLOUR RAL 9011 MATT GLOSS LEVEL 30%. ALL SCREWS PAINTED TO MATCH FINAL COLOUR AT SITE.

UNLESS STATED OTHERWISE ALL WELDS ARE 6mm FILLET OR
FULL STRENGTH BUTT WELDS (SUBJECT TO RWC / ENGINEERS
REVIEW).
DESIGN LOAD - 1.5kN/m.

AS-BUILT

METFABS
making metal - work
METALLIC FABRICATIONS LTD, 212 THORP ARCH TRADING ESTATE, WETHERBY, LEEDS LS23 7FL
Telephone 01937 843485 Fax 01937 845517

REV.C03	AS-BUILT ISSUE 10/12/2020.
REV.P02	Mod'd to calcs 27/11/2019.
REV.P03	Mod'd to comments 28/11/2019.
REV.P04	Mod'd to comments 29/11/2019.
REV.C01	Mod'd to comments 16/12/2019.
REV.C02	Top rail added to steel infill panels 9/10/2020.

Mod'd to comments 29/11/2019.

CONTRACT	Circle Square : Plots 2, 3 + 4	TITLE	BUILDING 4 - PANEL DETAILS
		SCALE @ A1	VARIOUS
		DRAWN BY	RDS
		DRG. No.	CS-MET-B4-ZZ-DR-X-0012
JOB No: 882	CHECKED BY:	DATE	19/10/2019
		REV	C03