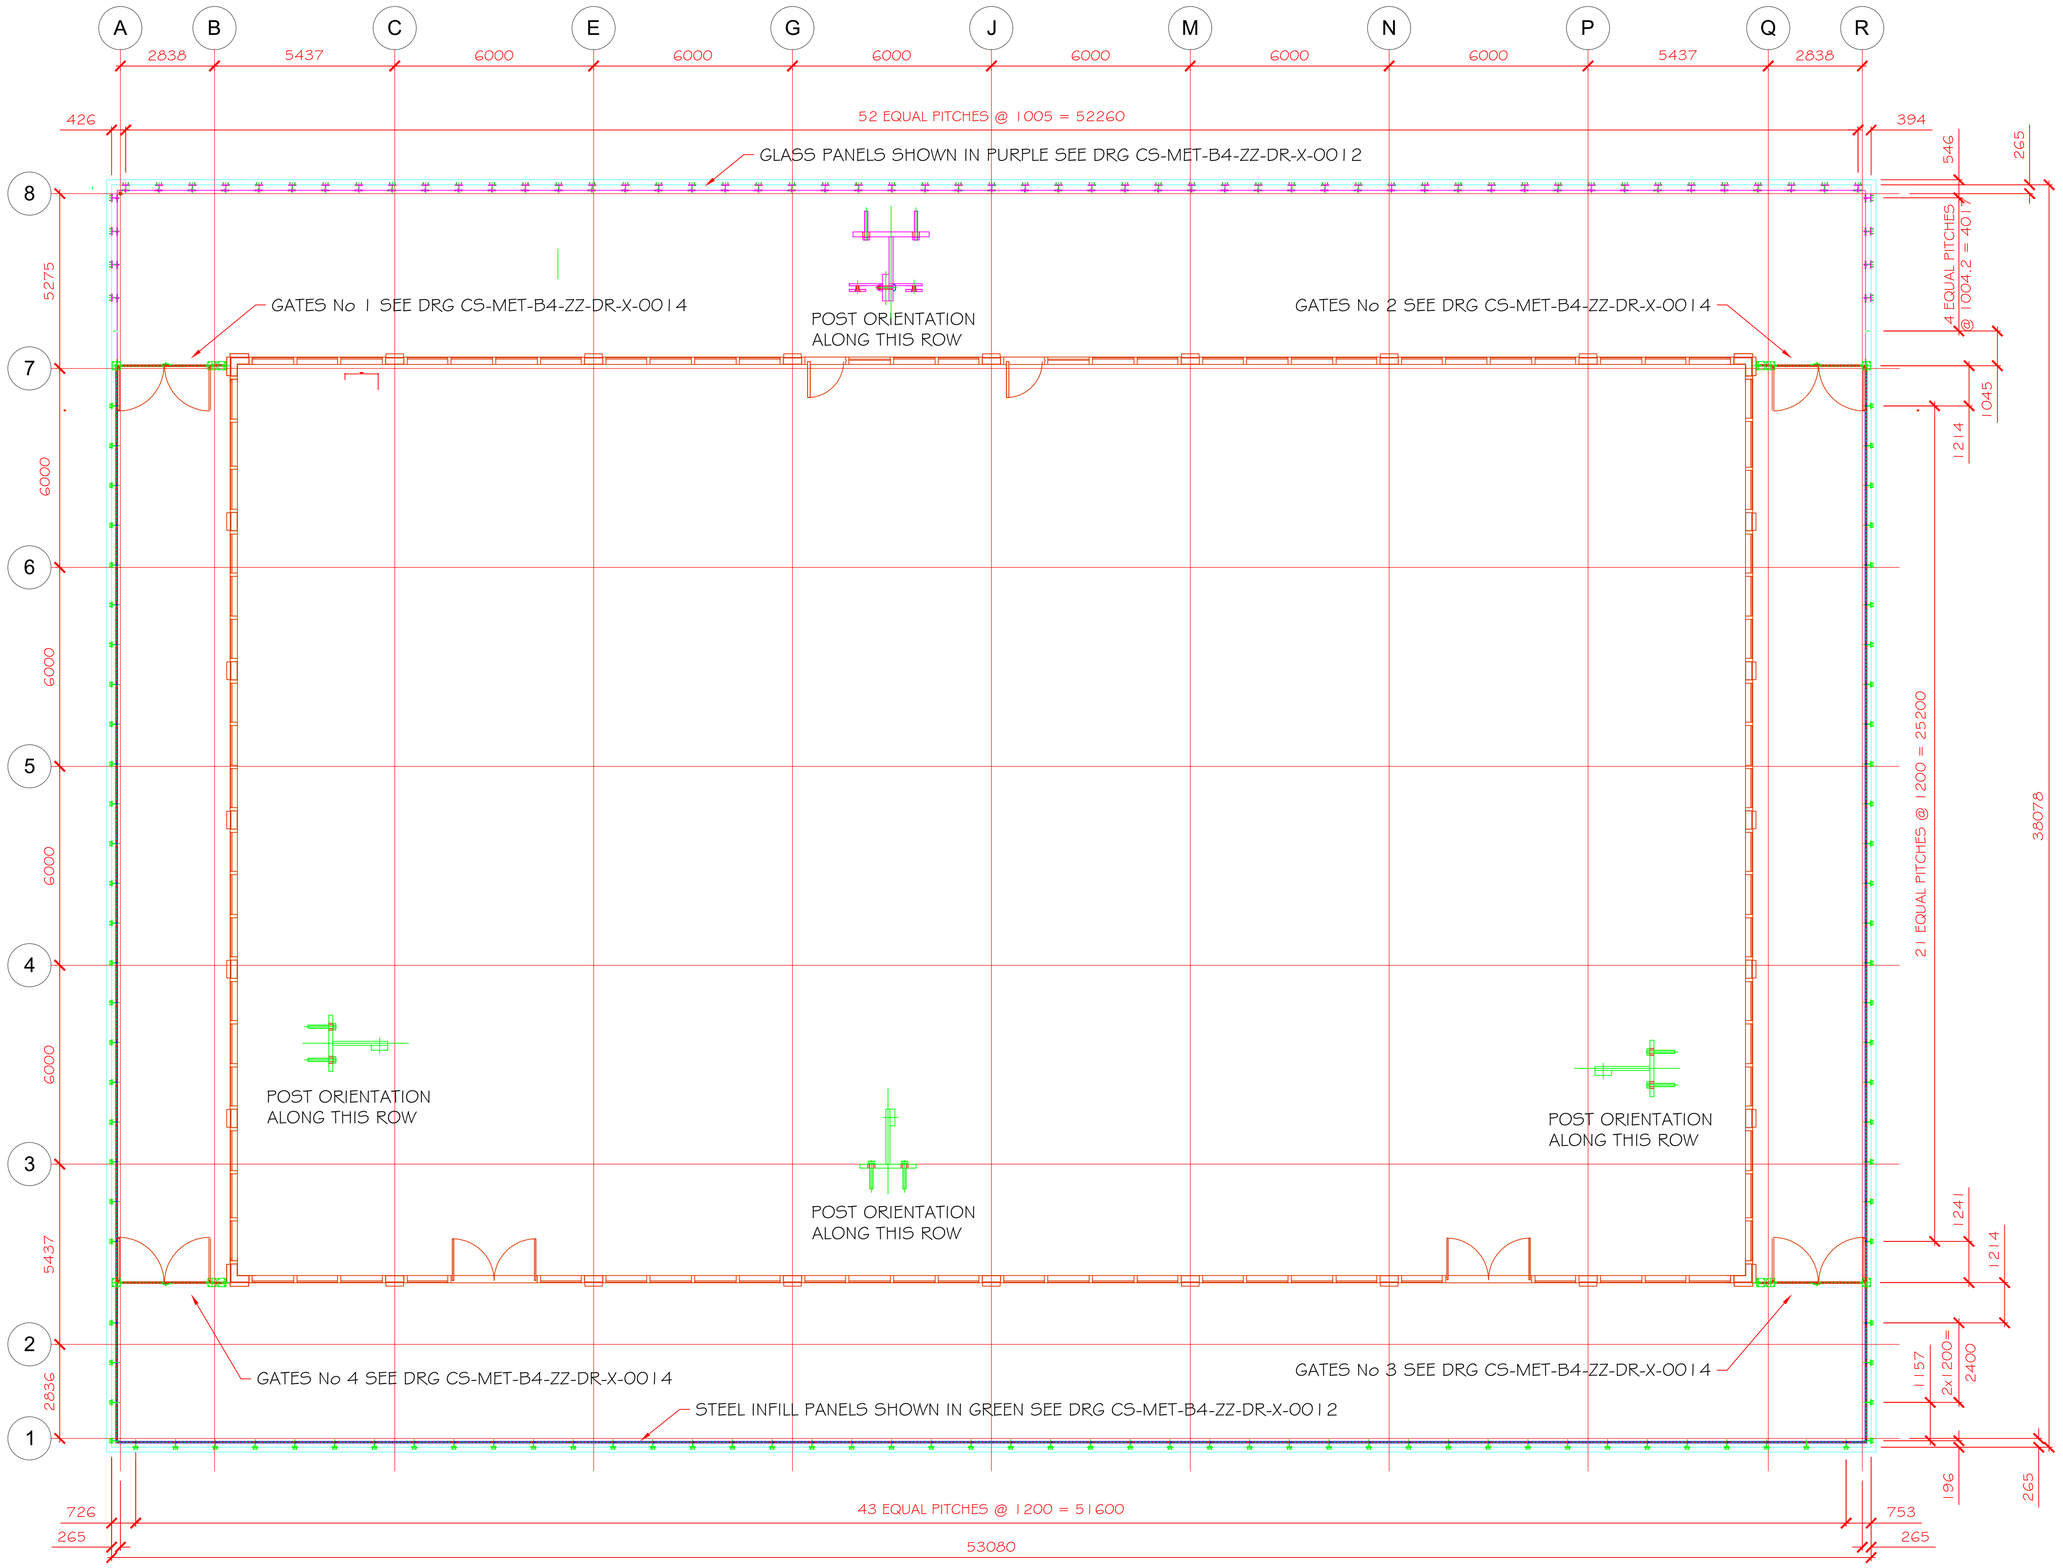


AS-BUILT

PLAN VIEW BUILDING 4

METFABS

making metal - work

METALLIC FABRICATIONS LTD, 212 THORP ARCH TRADING ESTATE, WETHERBY, LEEDS LS23 7FL

Telephone 01937 843485 Fax 01937 845517

REV.P01	First issue.
REV.C01	Mod'd to comments 29/11/2019.
REV.C02	Gates now numbered 16/12/2019.
REV.C03	
REV.P05	

NOTES:
MATERIAL: SEE DRG CS-MET-B4-ZZ-DR-X0012.

UNLESS STATED OTHERWISE ALL WELDS ARE 6mm FILLET OR FULL STRENGTH BUTT WELDS (SUBJECT TO RWC / ENGINEERS REVIEW).

CONTRACT: Circle Square : Plots 2, 3 + 4

JOB No: 882 | CHECKED BY:

TITLE: BUILDING 4 - GENERAL ARRANGEMENT OF PANELS

SCALE @ A1	VARIOUS	DRG. No.	CS-MET-B4-ZZ-DR-X-0013
DRAWN BY	RDS		
DATE	27/10/2019	REV	C04