


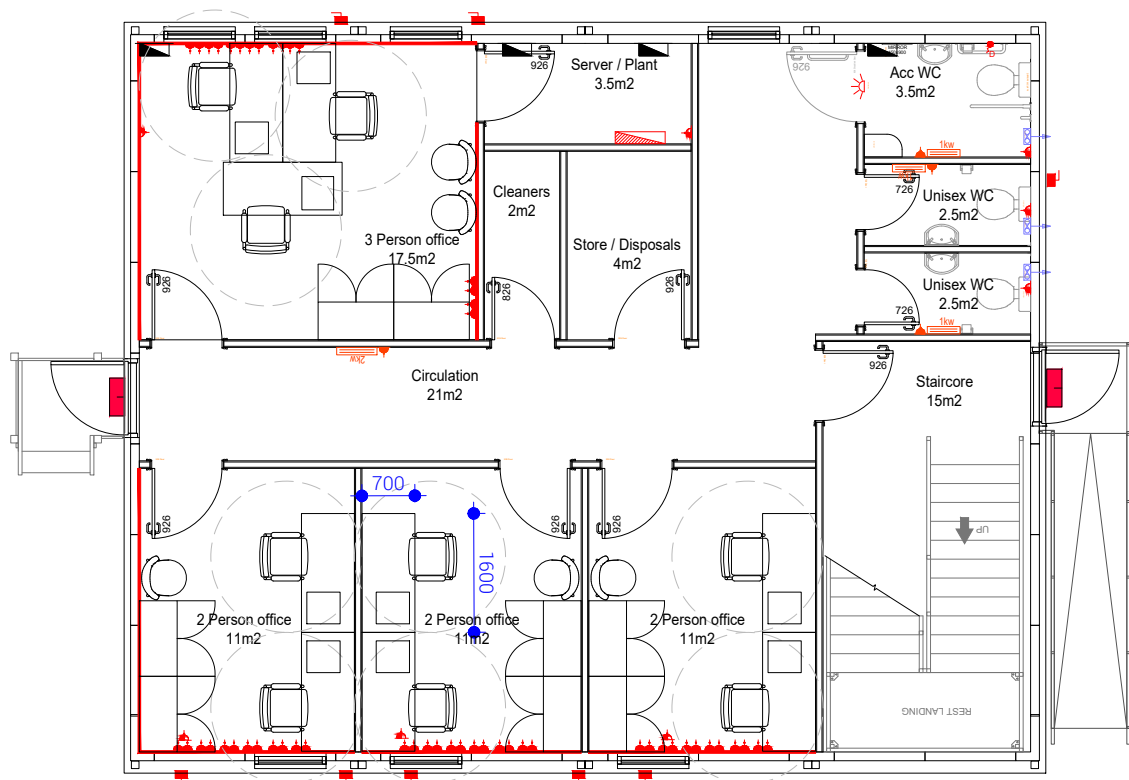

Level 0 GA - Loaded Office Layout
1 : 100

Key

Layout derived from 2m Social Distancing restrictions,


Layouts have been revised to suit the recommended 11m³ P/P as per HSE L24: Workplace Health, Safety and Welfare Regulations 1992: Approved Code of Practice. Resulting in a Max capacity of 21 alongside additional meeting space, as indicated.

Each 2 Person Office has a revised side-to-side desk arrangement to ensure social distancing and additional furniture. Note; additional below desk cable trays will be required in this location to direct power / data from the current locations (Indicated in Red)

Layouts derived from 1600 x 700 desk sizes to ensure greater social distancing.

Furniture Requirements indicated per office - Below desk Tambour unit (per desk) Min 1 additional, stackable chair (as indicated) and 1 no. high / 1 no. Low 1000 x 500 Storage cabinets.

Meeting Room indicated with 2 no. distanced capacity with 4 additional stacking chairs (if required).

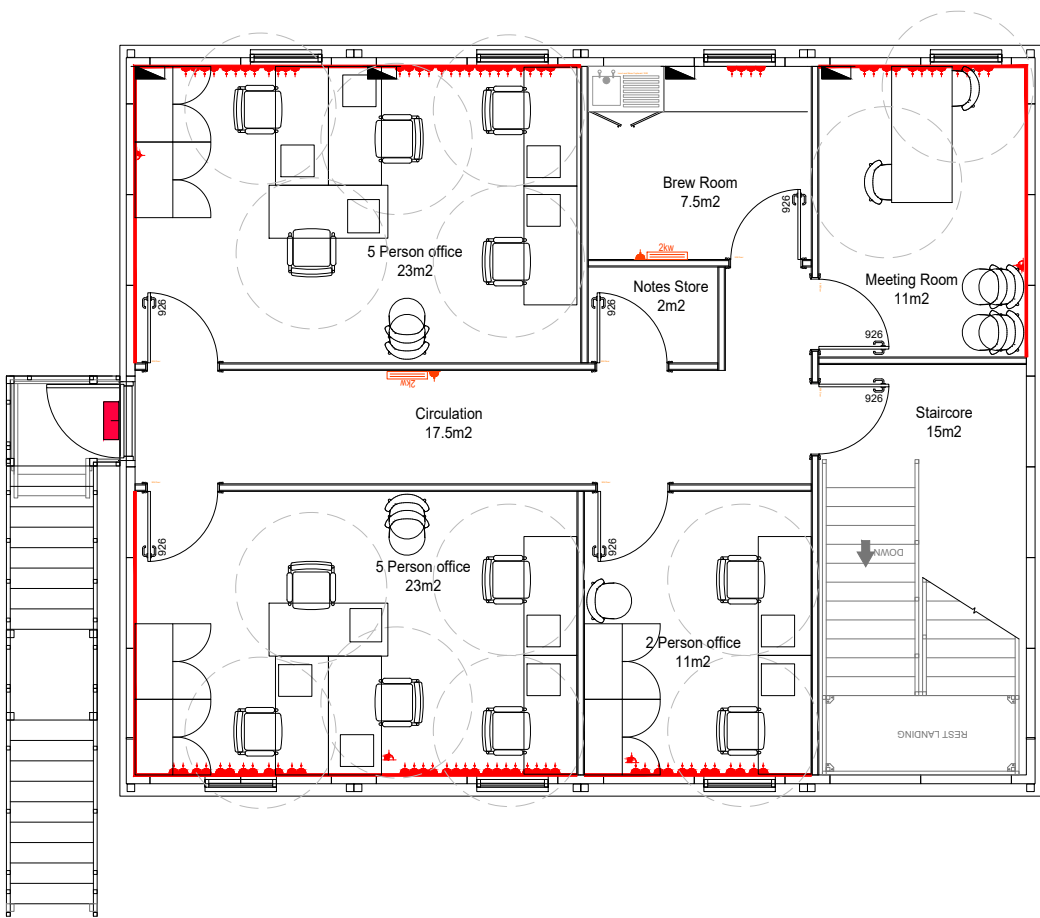

Level 1 GA - Loaded Office Layout
1 : 100

GENERAL NOTES:

DAY Architectural Ltd accepts no responsibility for any costs, losses or claims whatsoever arising from these drawings, specifications and related documents unless there is full compliance with the Client or any unauthorised user of the following:

1

All boundaries, dimensions and levels are to be checked on site before construction and any discrepancies reported to the Architect / Designer.

2

Partial Service: Any discrepancies with site or other information is to be advised to the Architect / Designer and direction and / or approval is to be sought before the implementation of the detail.

3

Block and site plans are reproduced under license from the Ordnance Survey.

4

Do not scale this drawing.

5

For the purpose of coordination, all relevant parties must check this information prior to implementation and report any discrepancies to the Architect / Designer.

CLIENT		DRAWING	
Manchester University Hospitals NHS FT		Alternative Office Layout Option	
PROJECT		SCALE	PAPER SIZE
Project RED - Fracture Relocation		1:100	A3
B A	PACKAGE REVISED TO SUIT FINAL MODULAR LAYOUT FIRST ISSUE - REVISED LAYOUT TO SUIT USER COMMENTS	DATE	DRAWN BY
		14/05/2021	GAB
		DAY DRAWING No.	REVISION
		DAY-XX-ZZ-DR-A-900111	B
		PROJECT No.	1052-20
		DRAWING STATUS	
		PLANNING	
REV	DESCRIPTION	DATE	Information contained on this drawing is the sole copyright of DAY Architectural Ltd. and is not to be reproduced without their permission.

DAY

DAY Architectural Ltd.
Studio 1, Lancaster Buildings
77 Deansgate, Manchester, M3 2BW
T: 0161 834 9703
W: www.day-architectural.com