
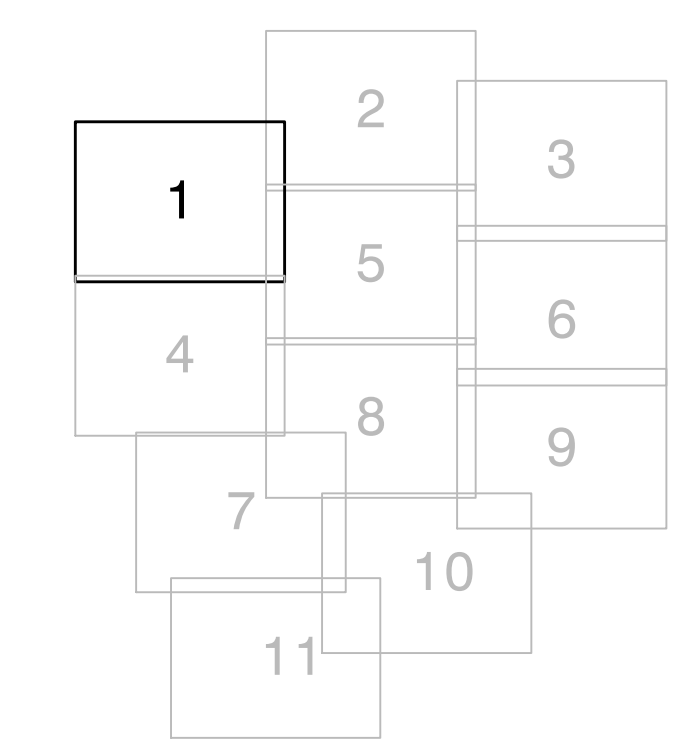
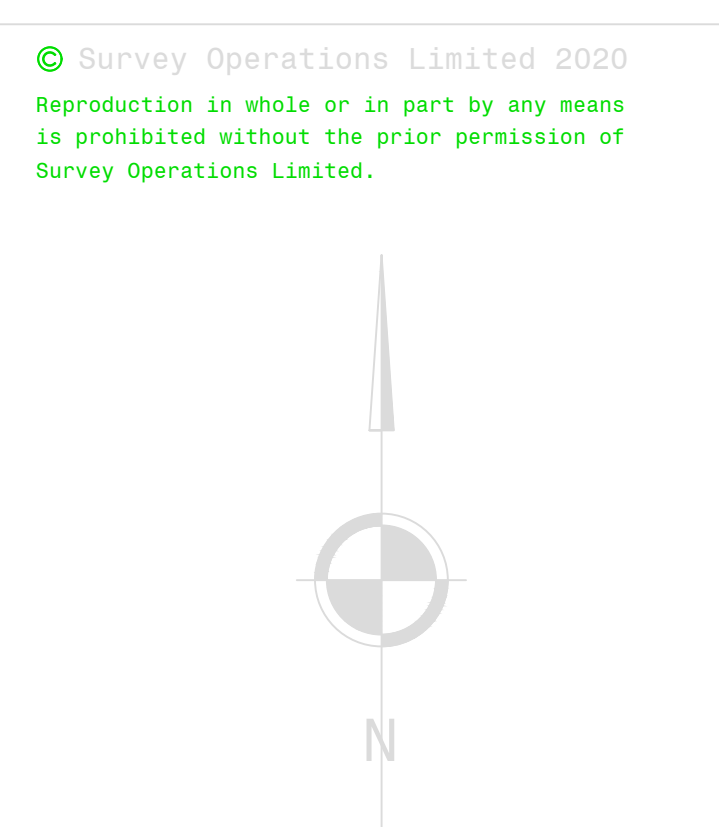


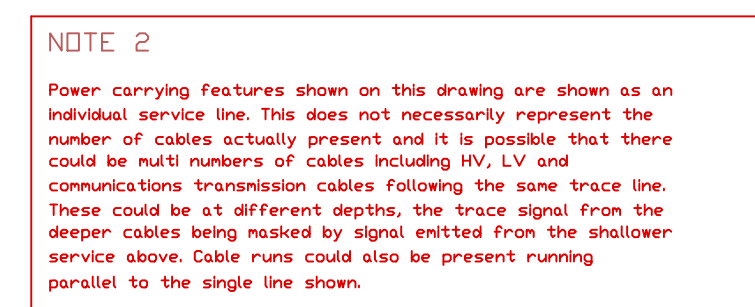

SHEET LAYOUT

Survey Observations


Smith Street, Skelmersdale, Lancs. WN8 8LN
Tel: 01695 725662 Fax: 01695 51816
Email: mail@survops.co.uk — www.survops.co.uk

Scale(s)	1:200	Surveyor	TW/SF/M
----------	-------	----------	---------

Date	MAY 20	Drawn	IT
Job Number		Checked	

Job Number	20B201	Checked	TW/SF/MB/IT
------------	--------	---------	-------------

Sheet Size & Drg Number & Revision
A0 20B201/001

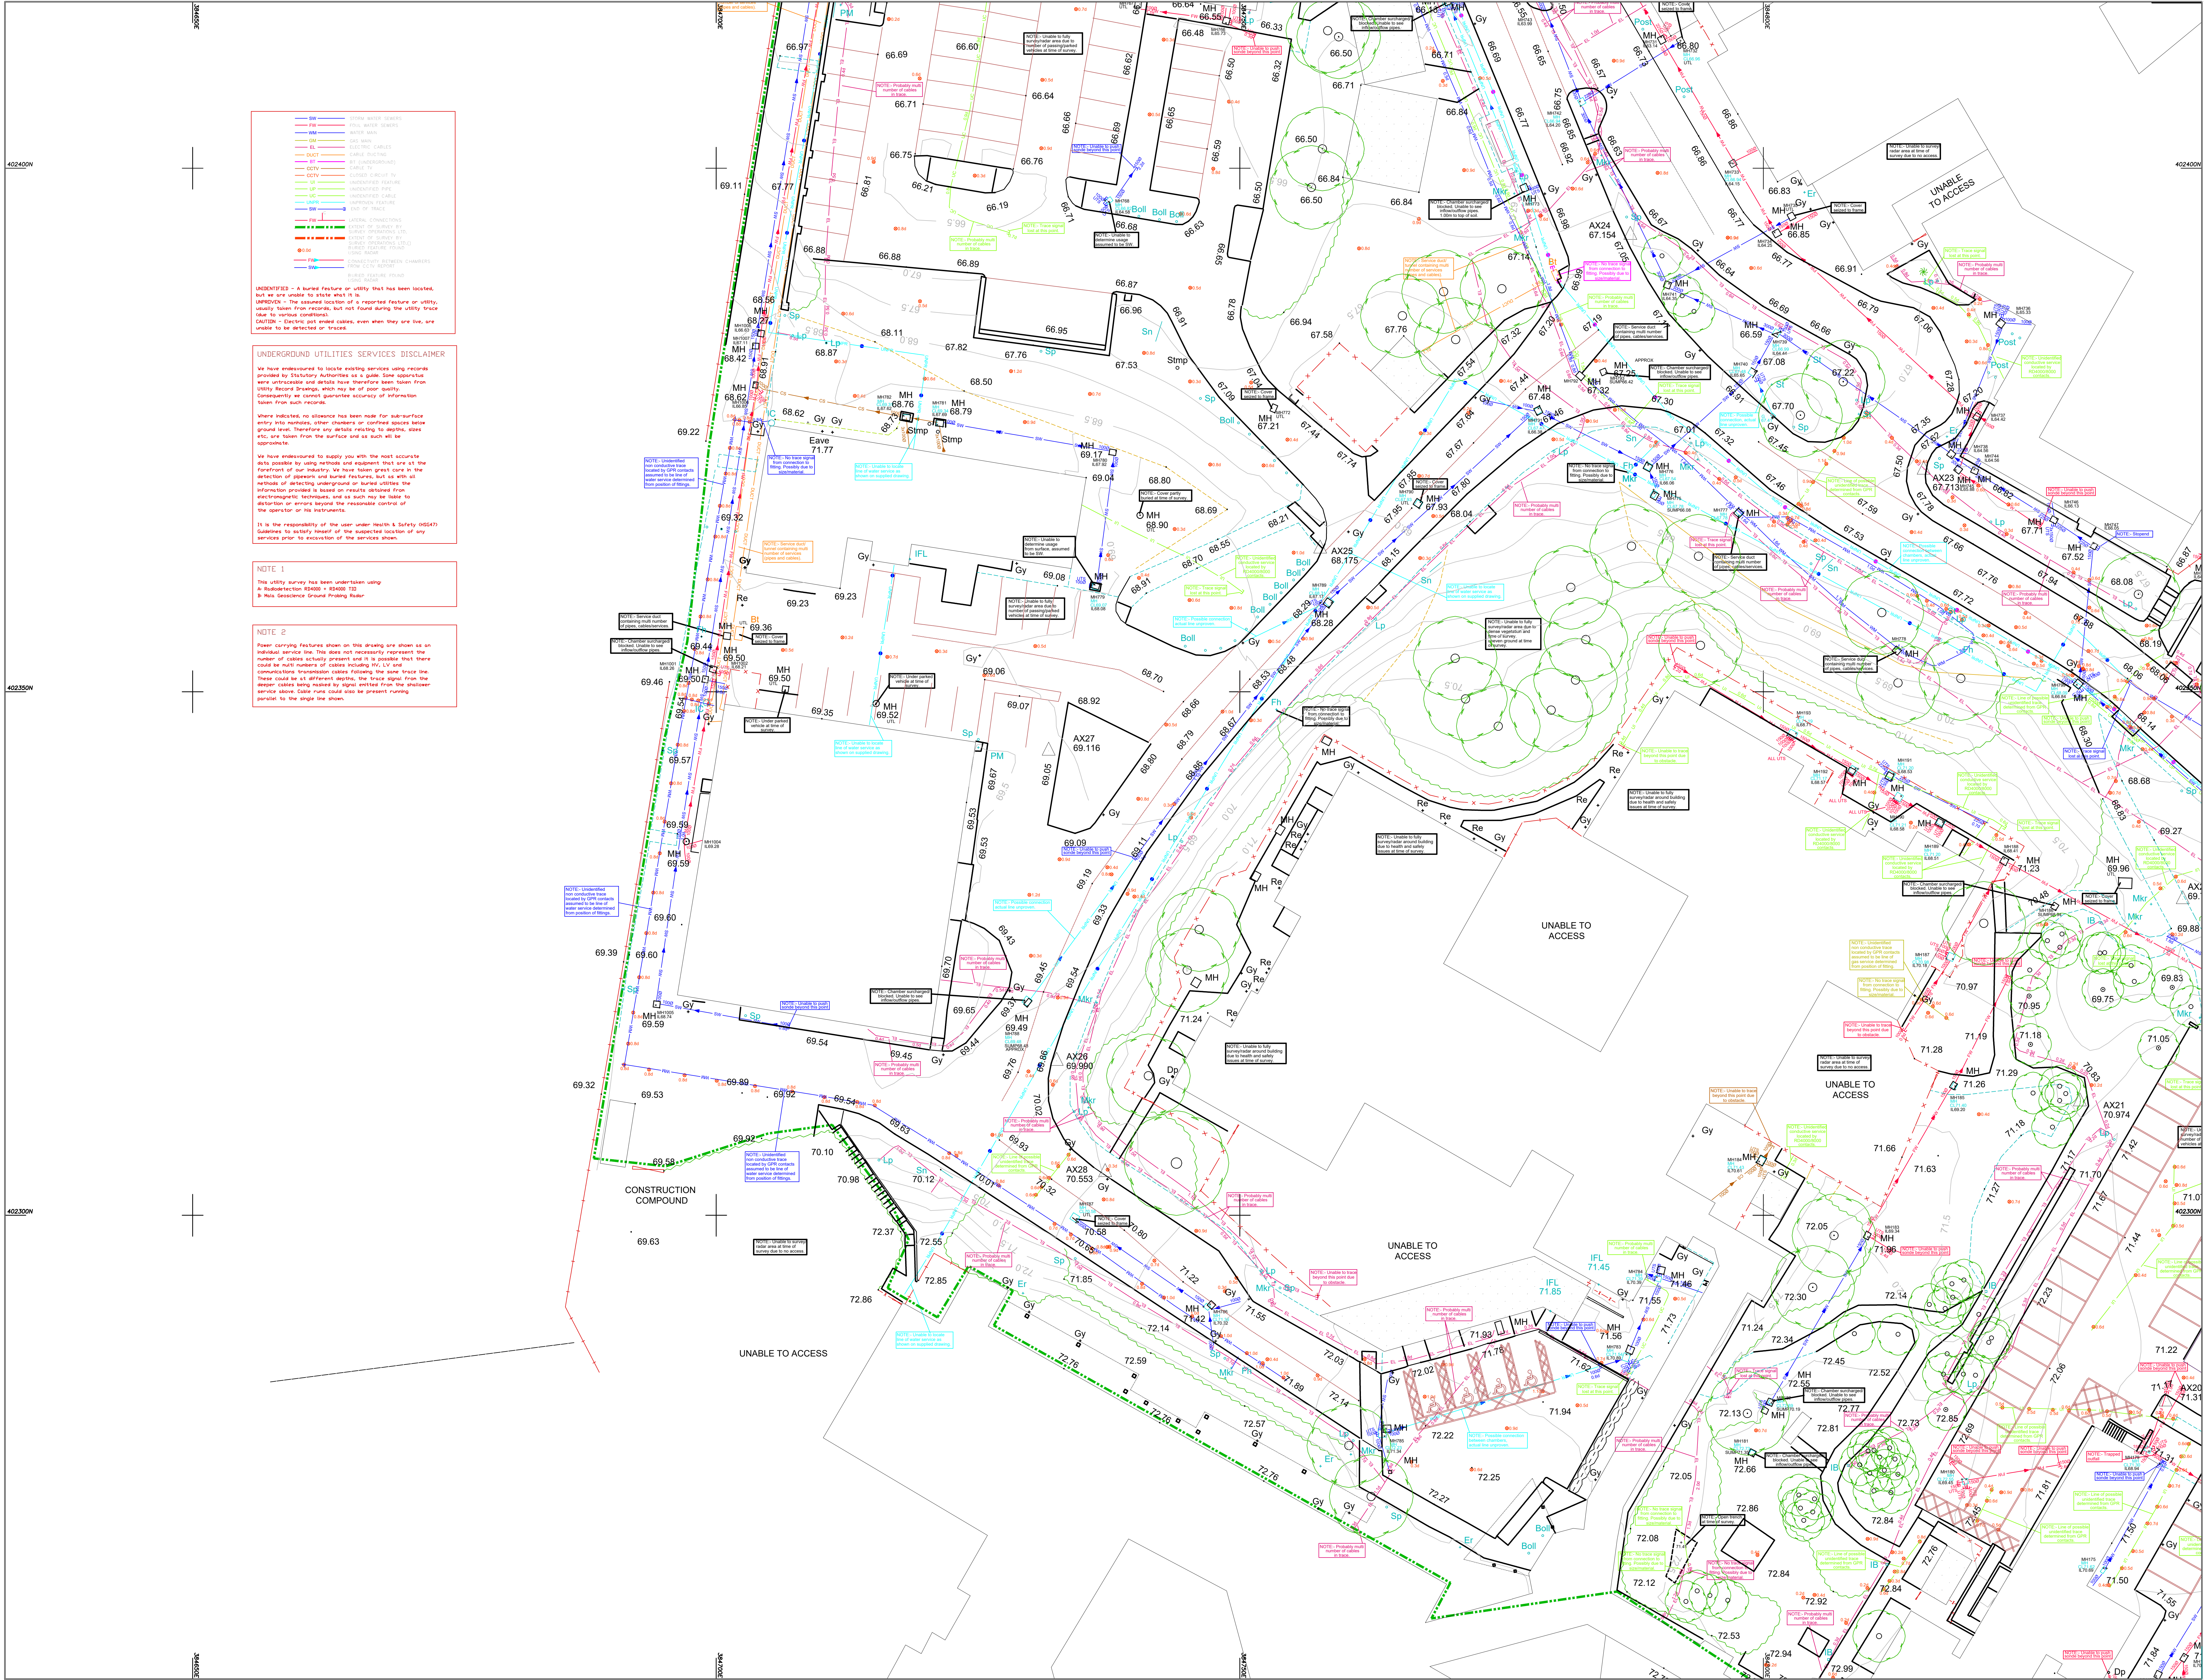

Survey Operations Limited 2020

Reproduction in whole or in part by any means is prohibited without the prior permission of Survey Operations Limited.

Notes:

All levels relate to Existing Site Datum. Orientation to Existing Site Grid.

Survey Control Markers established for Mapping purposes only and should not be used for Construction without the written approval of Survey Operations Ltd.

Drainage information must be verified with local authority records before use

Utility survey added to topographical survey (3654_30_2013) supplied by client.

Client

S.I. Sealy

Drawing Title

Utility Survey of Land at North Manchester General Hospital

Manchester

Sheet 4 of 11

Scale(s)

1:200

Surveyor

TW/SF/MB

Date

MAY 20

Drawn

IT

Job Number

20B201

Checked

TW/SF/MB/IT

Sheet Size & Org Number & Revision

A0 20B201/004


SHEET LAYOUT

Survey OPERATIONS


Tel: 01695 725662 Fax: 01695 51816

Email: mail@surveys.co.uk - www.surveys.co.uk

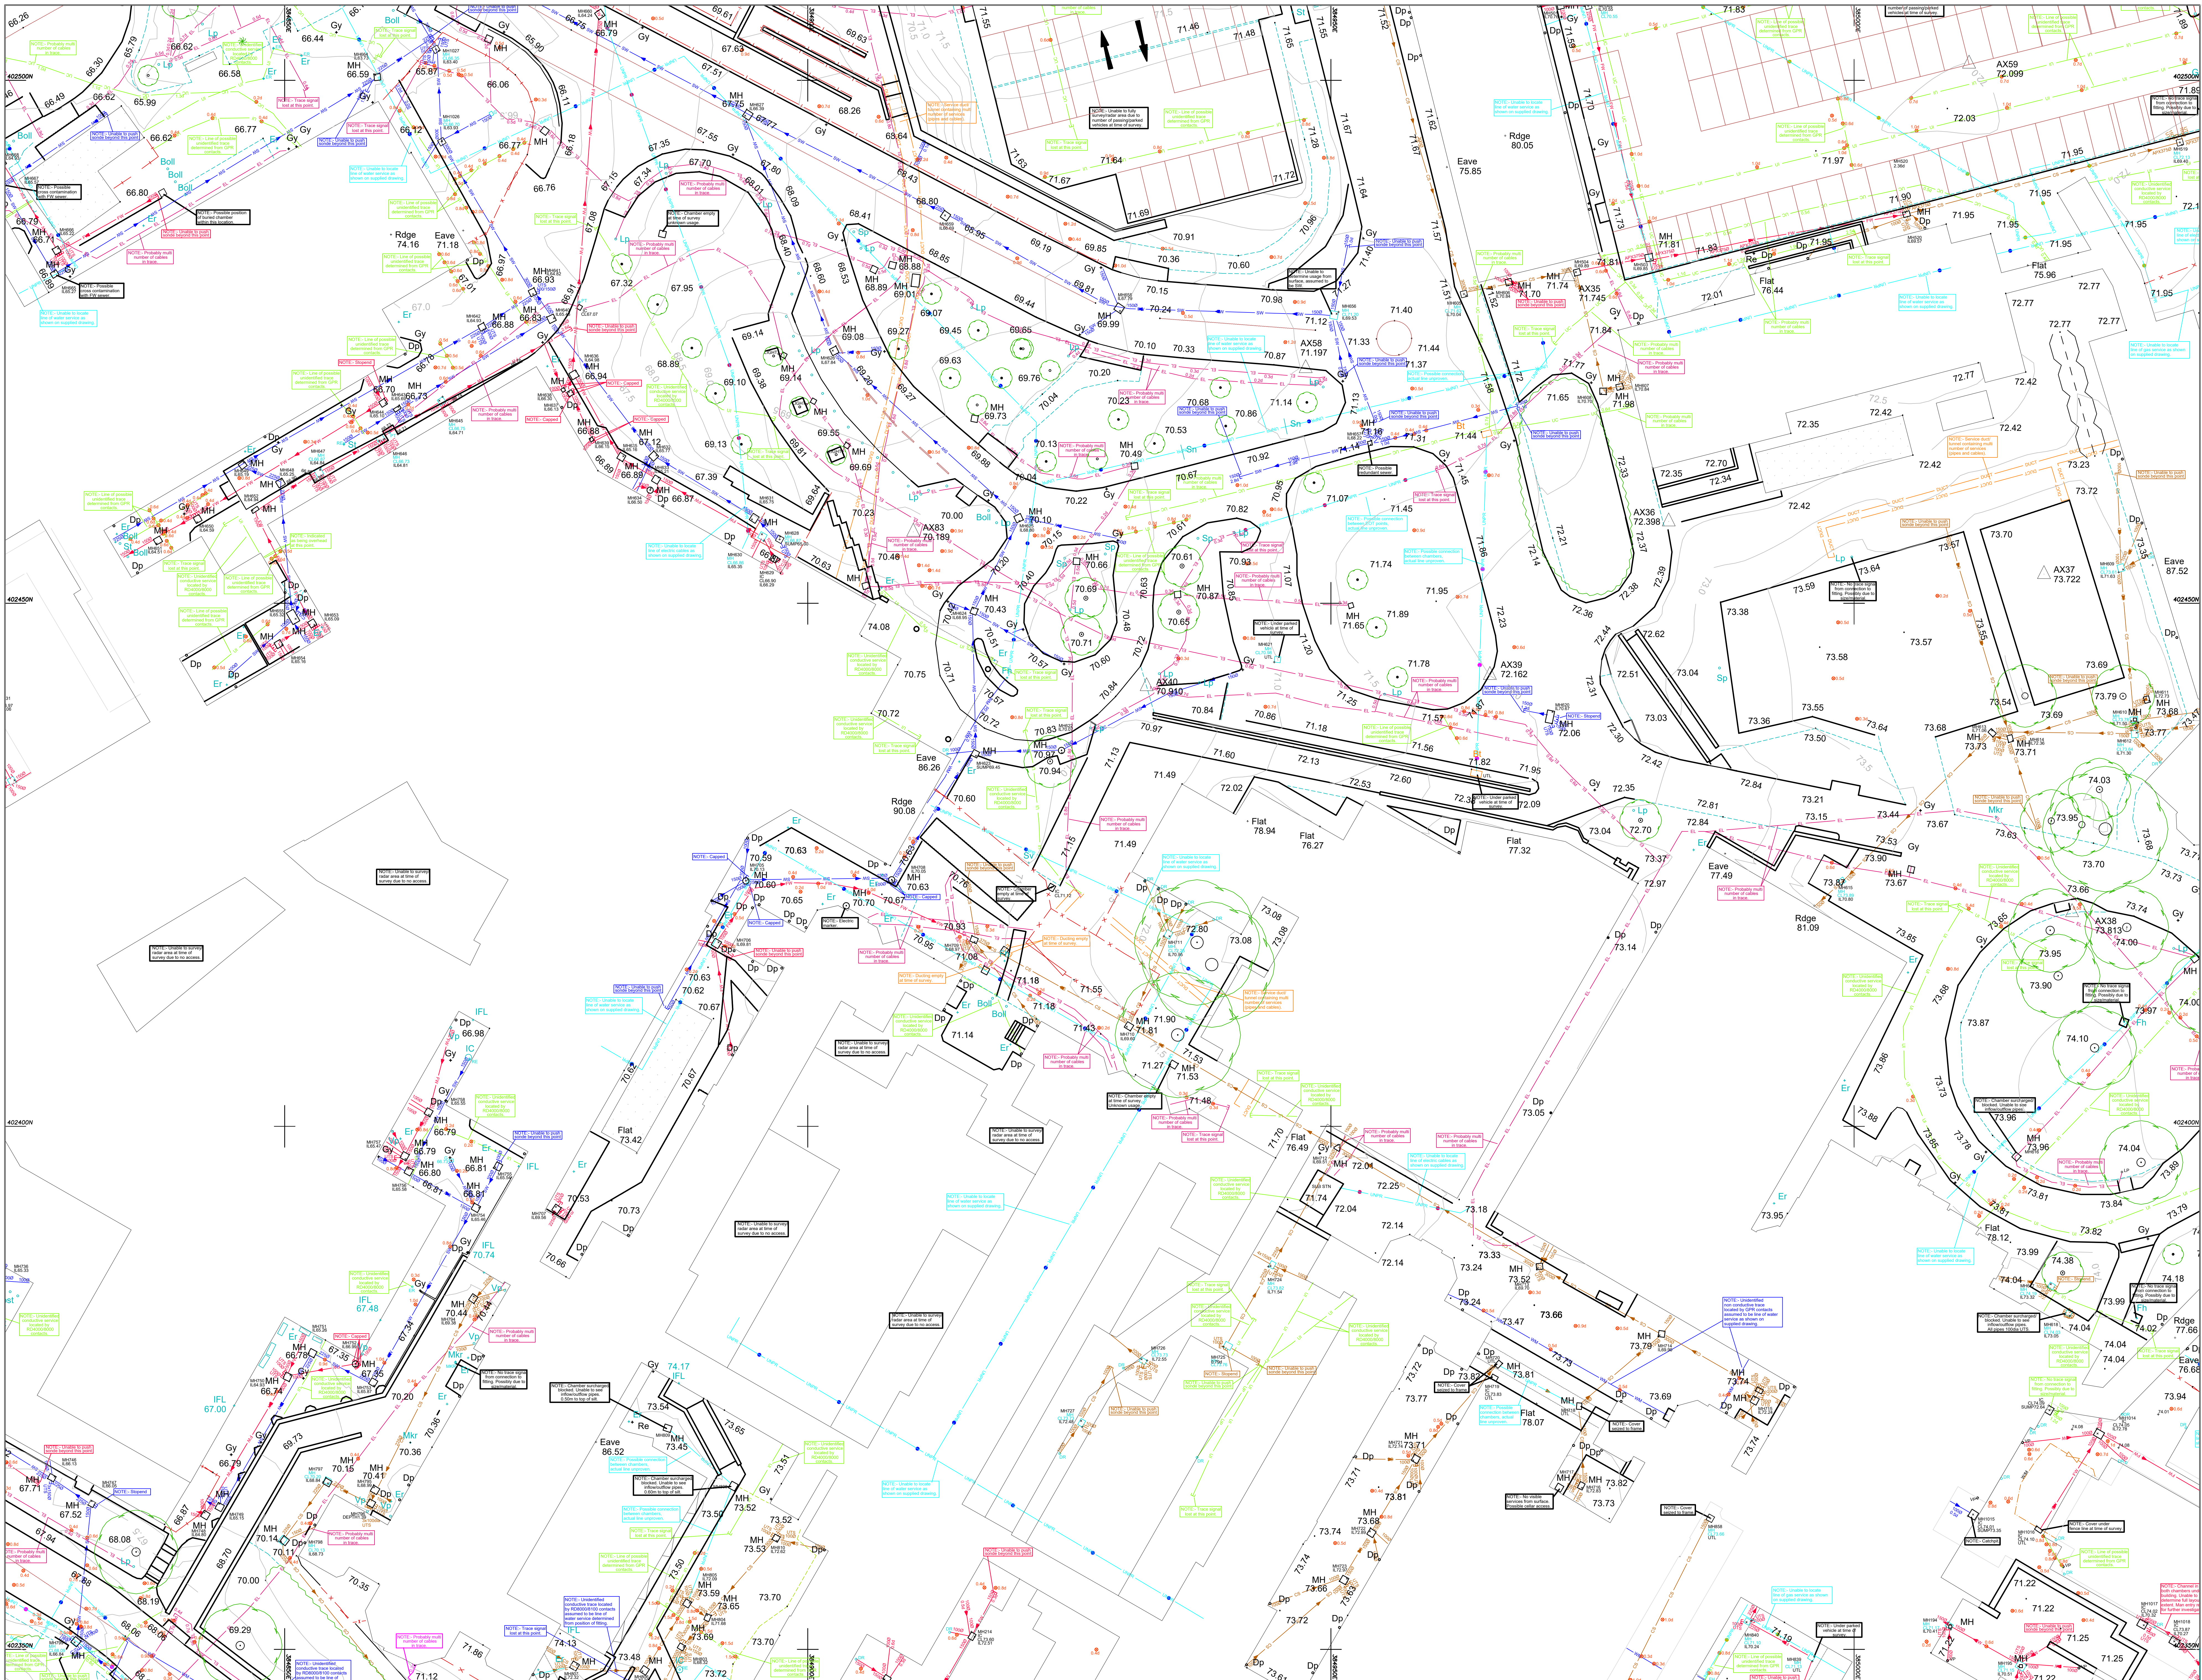


© Survey Operations Limited 2020
Reproduction in whole or in part by any means
is prohibited without the prior permission of
Survey Operations Limited.

Notes:
All levels relate to Existing Site Datum.
Orientation to Existing Site Grid.

Survey Control Markers established for
Mapping purposes only and should not be
used for Construction without the written
approval of Survey Operations Ltd.

Drainage information must be verified
with local authority records before use

Utility survey added to topographical survey
(3654_30_2013) supplied by client.

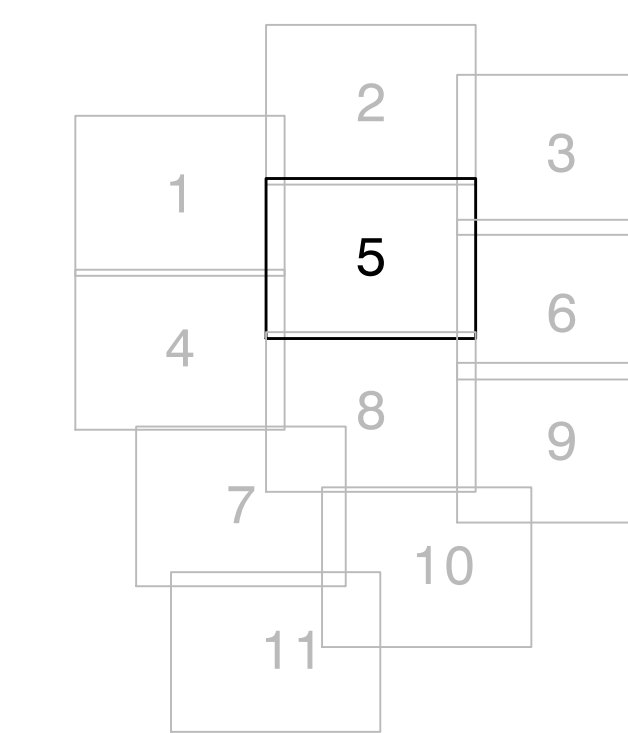

SHEET LAYOUT

Survey
OPERATIONS

Tel: 01695 725662 Fax: 01695 51816
Email: mail@surveys.co.uk - www.surveys.co.uk

Client S.I. Sealy

Drawing Title
Utility Survey of Land at:
North Manchester General Hospital
Manchester
Sheet 5 of 11

Scale(s) 1:200
Date MAY 20
Job Number 20B201

Surveyor TW/SF/MB
Drawn IT
Checked TW/SF/MB/IT
Sheet Size & Org Number & Revision
A0 20B201/005




Survey Operations Limited 2020
Reproduction in whole or in part by any means is prohibited without the prior permission of Survey Operations Limited.

Notes:
All levels relate to Existing Site Datum.
Orientation to Existing Site Grid.

Survey Control Markers established for Mapping purposes only and should not be used for Construction without the written approval of Survey Operations Ltd.

Drainage information must be verified with local authority records before use

Utility survey added to topographical survey (3654_30_2013) supplied by client.

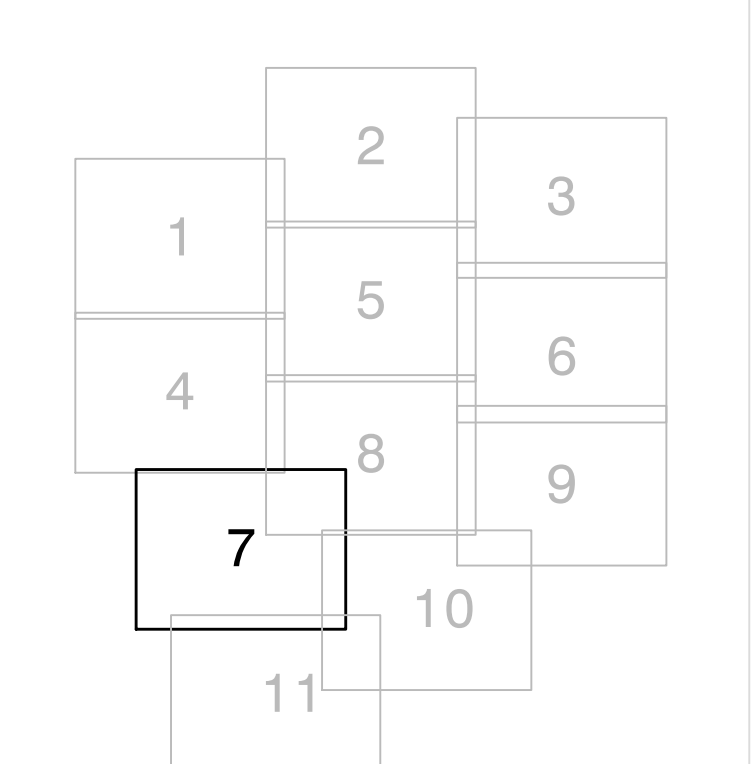

SHEET LAYOUT

Survey Operations

Tel: 01695 725662 Fax: 01695 51816
Email: mail@surveys.co.uk - www.surveys.co.uk

Client: S.I. Sealy

Drawing Title: Utility Survey of Land at North Manchester General Hospital, Manchester

Sheet 7 of 11

Scale(s): 1:200

Date: MAY 20


Job Number: 20B201

Sheet Size & Org Number & Revision: A0 20B201/007

Surveyor: TW/SF/MB

Drawn: IT

Checked: TW/SF/MB/IT

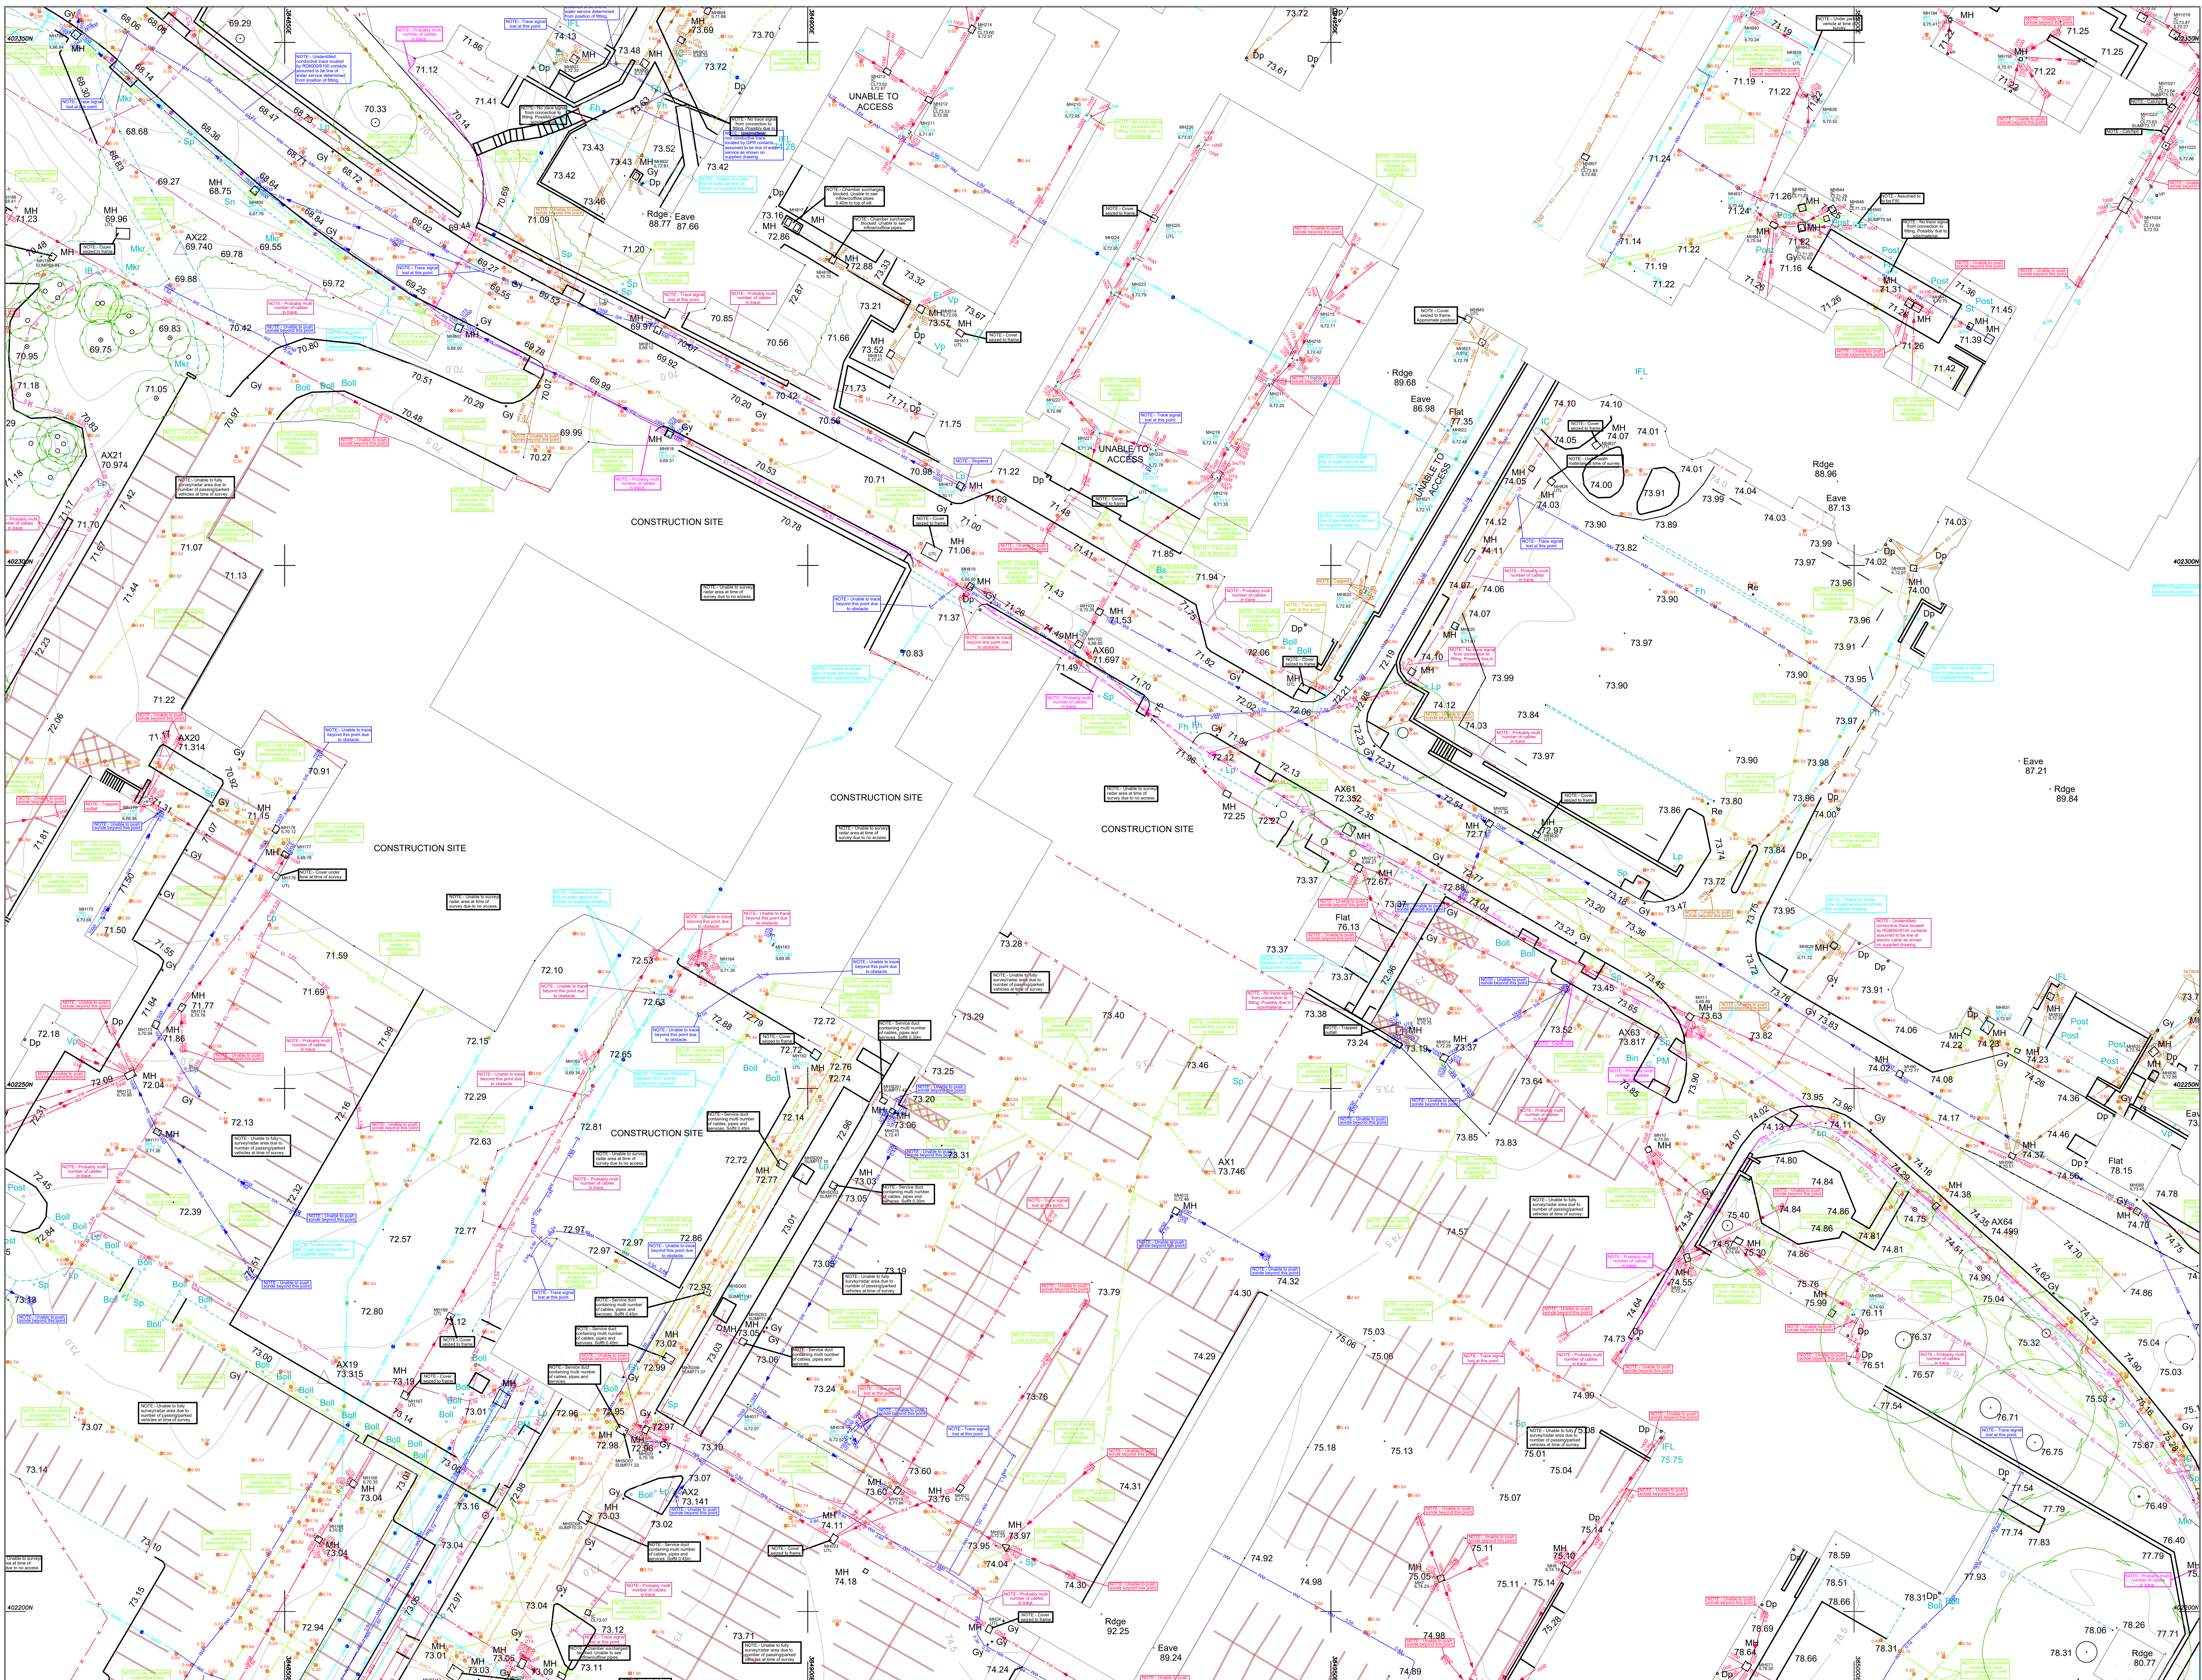


© Survey Operations Limited 2020
Reproduction in whole or in part by any means is prohibited without the prior permission of Survey Operations Limited.

Notes:
All levels relate to Existing Site Datum.
Orientation to Existing Site Grid.

Survey Control Markers established for Mapping purposes only and should not be used for Construction without the written approval of Survey Operations Ltd.

Drainage information must be verified with local authority records before use

Utility survey added to topographical survey (3654_30_2013) supplied by client.

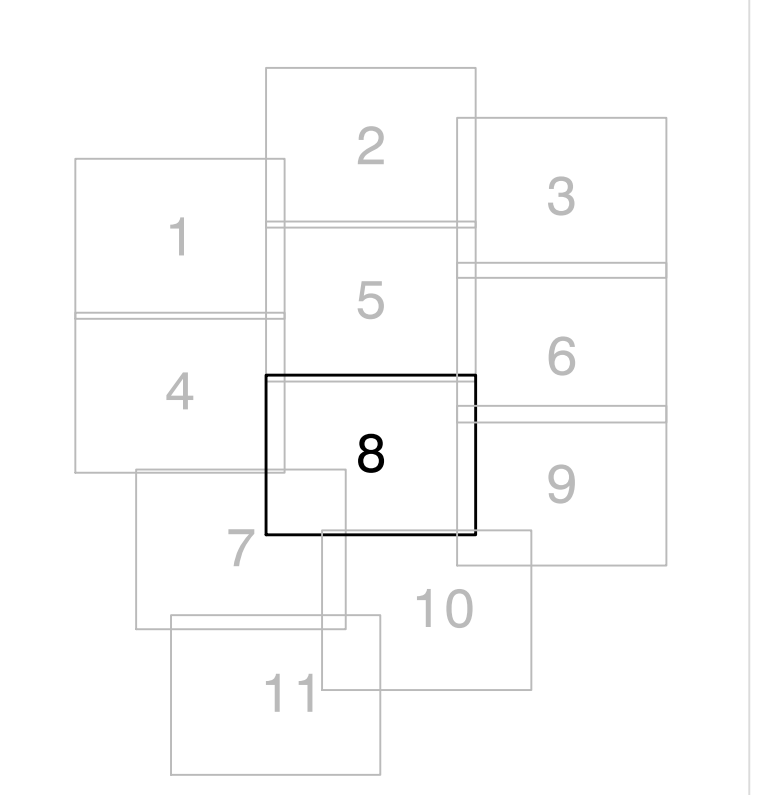

SHEET LAYOUT

Survey OPERATIONS

Tel: 01695 725662 Fax: 01695 51816
Email: mail@surveys.co.uk - www.surveys.co.uk

Client: S.I. Sealy

Drawing Title: Utility Survey of Land at North Manchester General Hospital, Manchester
Sheet 8 of 11

Scale(s): 1:200

Date: MAY 20

Job Number: 20B201

Sheet Size & Org Number & Revision: A0 20B201/008

Surveyor: TW/SF/MB
Drawn: IT
Checked: TW/SF/MB/IT



© Survey Operations Limited 2020
Reproduction in whole or in part by any means is prohibited without the prior permission of Survey Operations Limited.

Notes:
All levels relate to Existing Site Datum.
Orientation to Existing Site Grid.

Survey Control Markers established for Mapping purposes only and should not be used for Construction without the written approval of Survey Operations Ltd.

Drainage information must be verified with local authority records before use

Utility survey added to topographical survey (3654_30_2013) supplied by client.

UNDERGROUND UTILITIES SERVICES DISCLAIMER

We have endeavored to locate existing services using records provided by statutory authorities as a guide. Some apparent were untraceable and details have therefore been taken from utility record drawings, which may be of poor quality. Consequently we cannot guarantee accuracy of information taken from such records.


Where indicated, no clearance has been made for subsurface entry into manholes, other chambers or confined spaces below ground level. Therefore any details relating to depths, sizes etc, are taken from the surface and as such all be approximate.

We have endeavored to supply you with the most accurate data possible by using methods and equipment that are at the forefront of our industry. We have taken great care in the detection of pipework and buried features, but as with all methods of detecting underground or buried utilities the information provided is based on results obtained from electromagnetic techniques, and as such may be liable to distortion or errors beyond the reasonable control of the operator or his instruments.

It is the responsibility of the user under Health & Safety 1984/74 to satisfy itself of the suspected location of any services prior to excavation of the services shown.

NOTE 1
This utility survey has been undertaken using:
A: Radar Detection (Radar) - 100MHz T10
B: Non Geoscience Ground Penetrating Radar

NOTE 2
Power carrying features shown on this drawing are shown as an individual service line. This does not necessarily represent the number of cables actually present and it is possible that there could be multiple numbers of cables including HV, LV and communications transmission cables following the same trace line. These could be at different depths, the trace signal from the deeper cable being masked by signal emitted from the shallower service above. Cable runs could also be present running parallel to the single line shown.

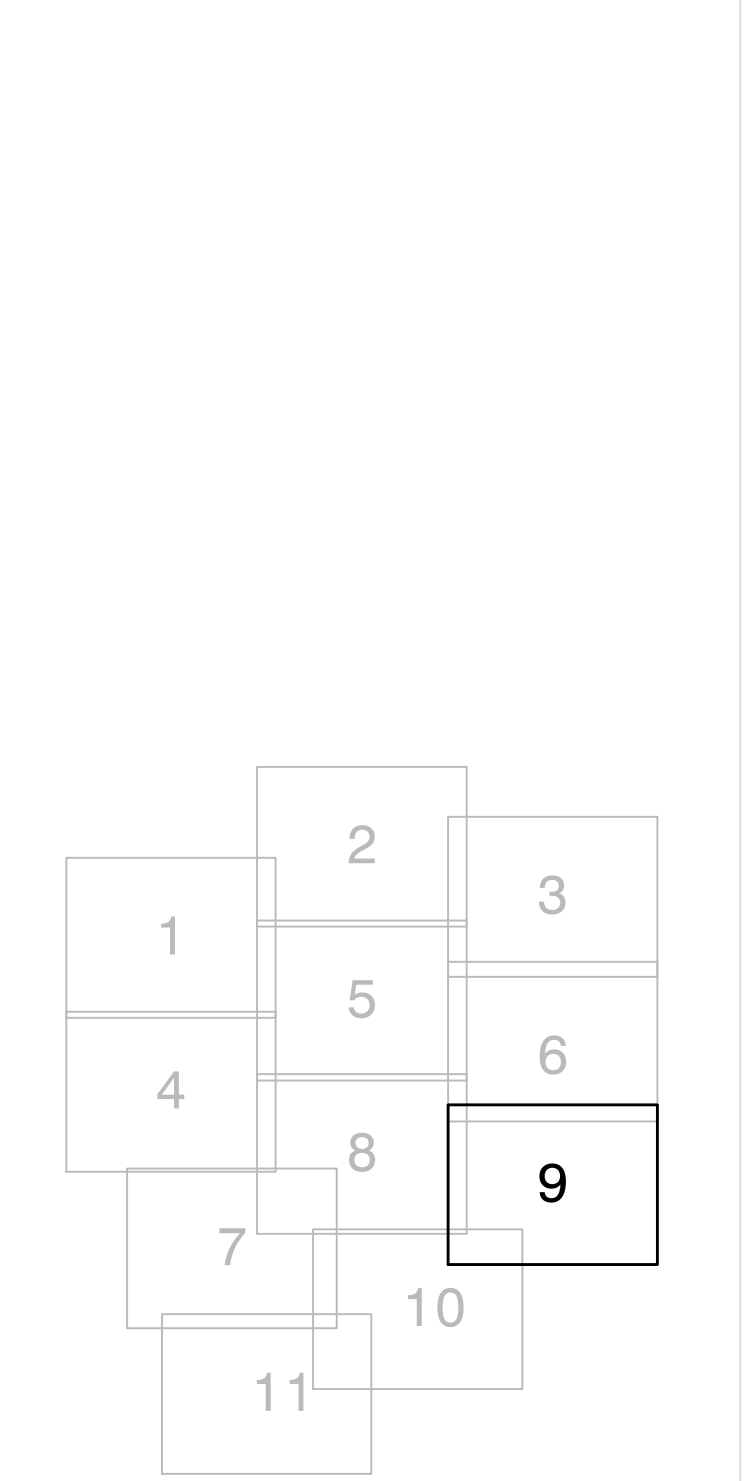

SHEET LAYOUT

Survey OPERATIONS

Smith Street, Skelmersdale, Lancs. WN8 8LN
Tel: 01695 725662 Fax: 01695 51816
Email: mail@surveys.co.uk - www.surveys.co.uk

Client: S.I. Sealy

Drawing Title: Utility Survey of Land at: North Manchester General Hospital, Manchester

Sheet 9 of 11

Scale(s): 1:200

Date: MAY 20

Job Number: 20B201

Surveyor: TW/SF/MB

Drawn: IT

Checked: TW/SF/MB/IT

Sheet Size & Org Number & Revision: A0 20B201/009