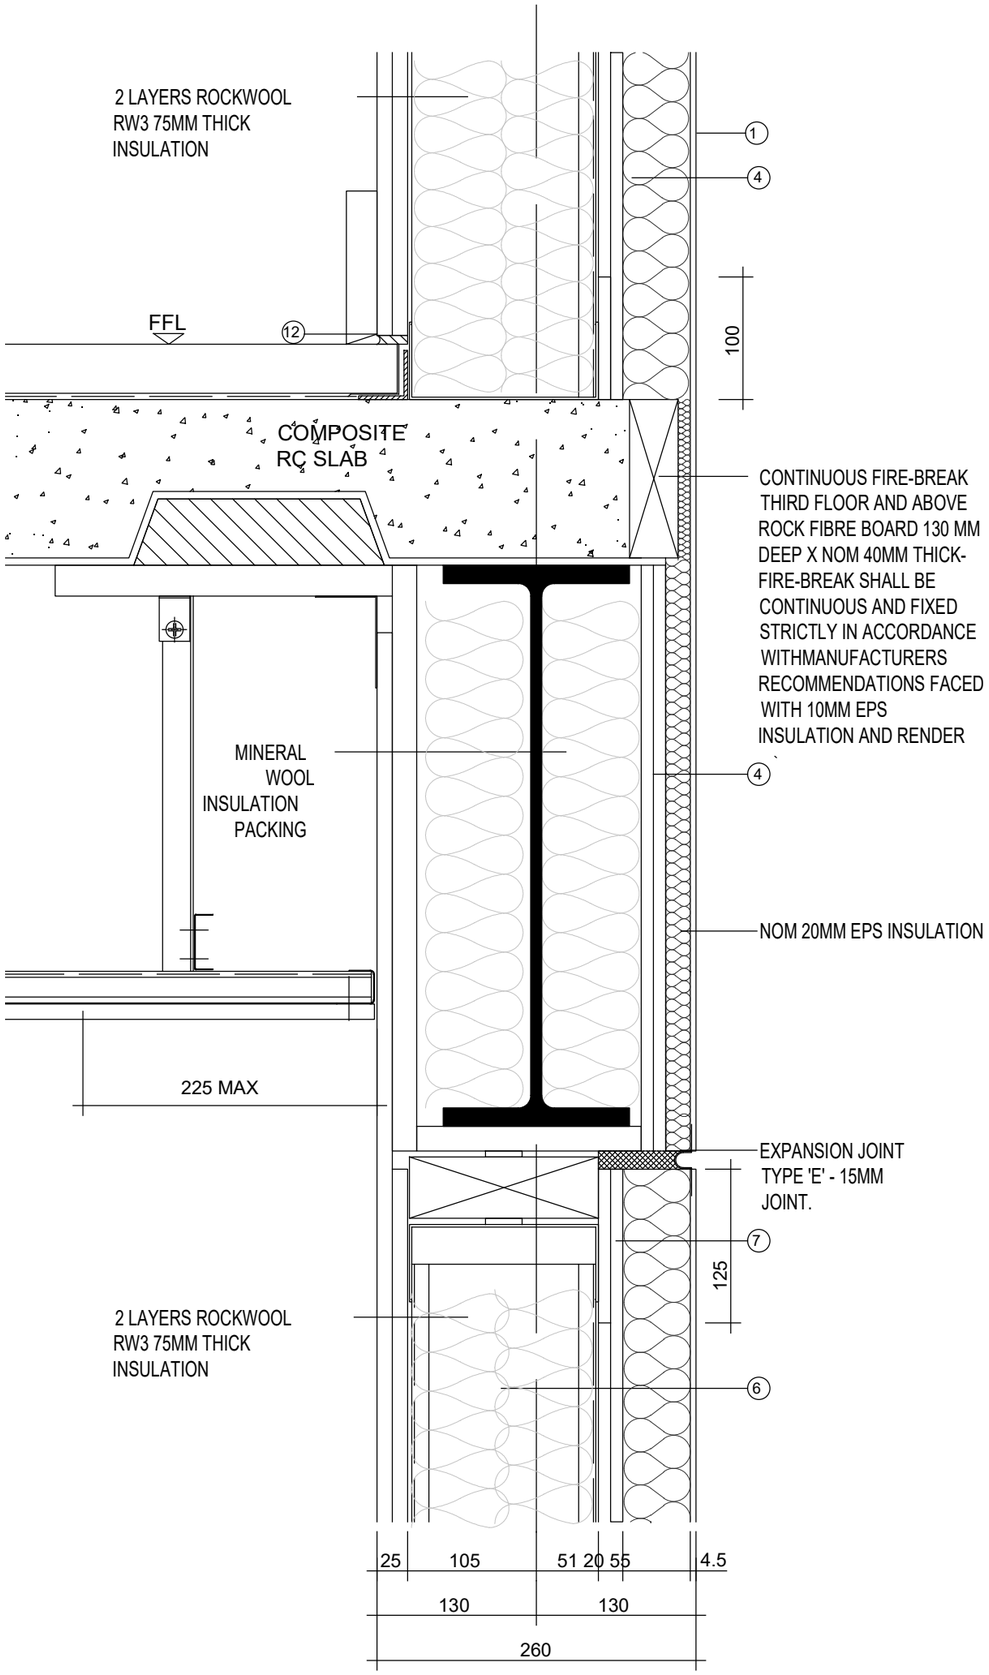


KEY

1. RENDER ON INSULATION NBS REF M21/210A AND 211A
2. RENDER ON BLUCLAD NBS REF M20/160A
3A. TIMBER CLADDING NBS REF H21/110
3B. TIMBER CLADDING NBS REF H21/115
4. BLUCLAD NBS REF H20/150
5. ALUMINIUM WINDOW NBS REF L10/335
6. INSULATION QUILT NBS REF P10/210A
7. METSEC CHANNELS NBS REF G10/150
8. BREATHER MEMBRANE NBS REF H21/130
9. DPM BY MONAFLEX OR OTHER SPECIALIST
10. TIMBER FRAMING NBS REF G20/270
11. MASTIC SEALANT EXTERNALLY NBS REF P10/460
12. INTUMESCENT SEALANT NBS REF P10/450
13. CAVITY BARRIERS / FIRE STOPS NBS REF P10/433
14. ALUMINIUM T SECTION NBS REF P20/150
15. ALUMINIUM CHANNEL NBS REF P20/160
16. ALUMINIUM ANGLE HEAD NBS REF P20/161
17. 12MM KORKPAK INSULATION NBS REF P10/141
18. COLOUR COATED WEATHERINGS & CILLS NBS REF H72/250
19. GLASROC NBS REF K11/890
20. 15MM PLYWOOD NBS REF K11/515A
21. SARNAFILL & KINGSPAN INSUL & METAL UPSTANDS & TRIMS NBS REF J42
22. LINING TO EXTERNAL WALLS NBS REF K10/156
23. LINING TO PARTY WALLS NBS REF K10/128
24. LINING TO INTERNAL WALLS NBS REF K10/126
25. INTERNAL LINING TO INTERNAL UNHEATED AREA NBS REF K10/158
26. INTERNAL LINING TO EXTERNAL WALL NBS REF K10/175
27. 1000 GUAGE DPM
28. 1 LAYER OF ROCKWOOL INSULATION LAID ON TOP FLANGE OF STEEL IN VOID

Use Dimensions - DO NOT SCALE
The Contractor is to check all dimensions at all times.
Contractor to check the dimensions & conditions on site before commencing. Subject to professional survey.
All errors and omissions to be reported prior to commencement.
This drawing must be read in conjunction with the relevant specification clauses. This drawing must not be used for purposes other than that for which it is provided. All drawings subject to statutory authority approval.

This Drawing Is Copyright of DMWR Architects LTD

Scale Bar — To be used as guidance only

KEYPLAN

NOTES

THIS DRAWING IS BASED ON AS BUILT INFORMATION. ACTUAL ARRANGEMENTS MAY VARY.

Rev	Date	Revision Description	Drn	Chk

Project Name: Design House Manchester	North
Client: Thomasons	
Drawing Title: Existing Slab Edge (Party Floor)	Client Job No: -
	DMWR Job No: 3685
Drawing Reference: 3685-DR-010	Revision: Rev
Drawn Date: 09.06.2021 / Scale: 1:5@A3	Drawn By
Drawning Status: FOR INFORMATION	Checked By

DMWR Architects

First Floor
16-18 Hatton Garden
London EC1 N 8AT

020 7870 3779
mail@dmwr.co.uk
www.dmwr.co.uk

Fourth Floor
41 Spring Gardens
Manchester M2 2BG

0161 413 4656
mail@dmwr.co.uk
www.dmwr.co.uk

Contact DMWR for more information