THIS DRAWING IS COPYRIGHT, AND REMAINS THE PROPERTY OF HTC ARCHITECTS. IT MUST NOT BE REPRODUCED, USED, DISCLOSED OR TRANSMITTED TO THIRD PARTIES IN ANY FORM, IN WHOLE OR IN PART, WITHOUT PRIOR WRITTEN PERMISSION.

DO NOT SCALE!
ALL DIMENSIONS SHOULD BE CHECKED ON SITE BEFORE WORK COMMENCES

DRAWN USING AS HTC AS BUILT DRAWINGS '2082 AB 100-GA GROUND FLOOR PLAN'

DRAWN USING 2.3.2 April 2022 ARCHITECTURAL LIDL DRS SPECIFICATION AND JAN 2022 SPECIFICATION

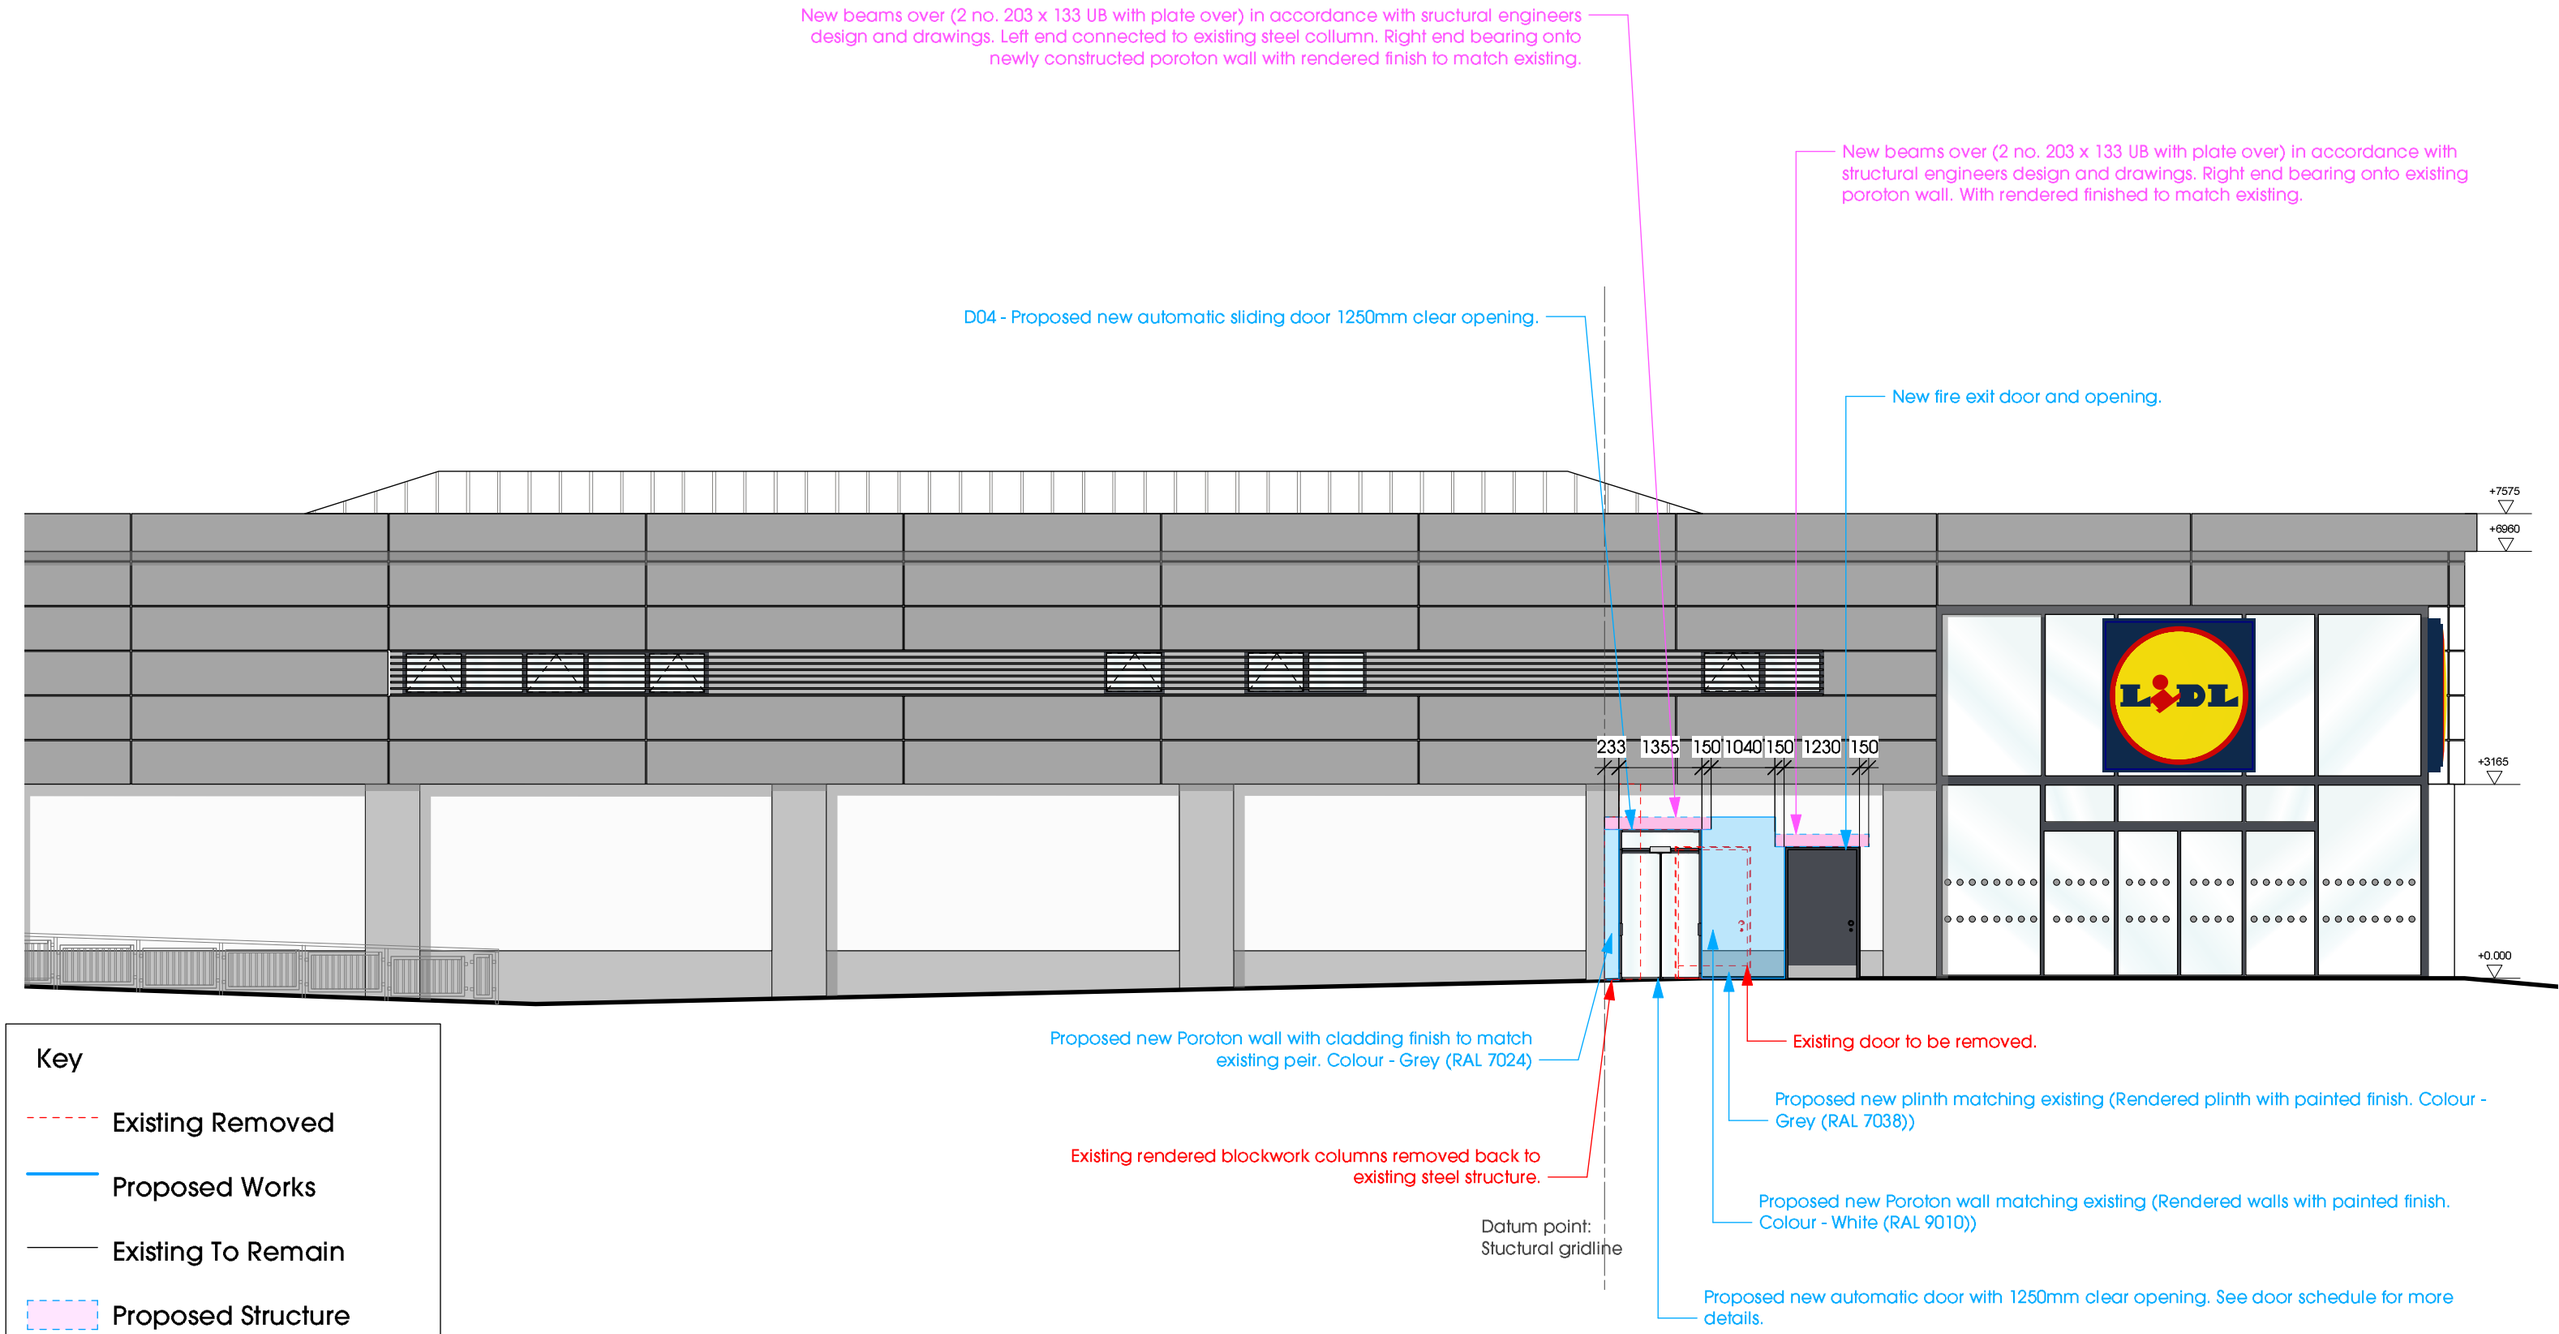

Key

- Existing Removed
- Proposed Works
- Existing To Remain
- Proposed Structure
- Proposed walls and cladding to match existing

See 'Demolition elevation' for extent of demolition.

Rev	Date	Description	Drawn

htcarchitects
York Place Studio
8 Britannia Street
Leeds
LS1 2DZ
T:(0113) 244 3457
W: www.htcarchitects.co.uk
E: info@htcarchitects.co.uk

client
Lidl GB Ltd.

project
LIDL DRS Extension-Harpurhey

drawing title
Proposed Elevation

date	April 2022
status	Tender
scale	1:100 @ A3
drawn	JC
checked	MH
job no.	2842
dwg no.	T201
rev.	