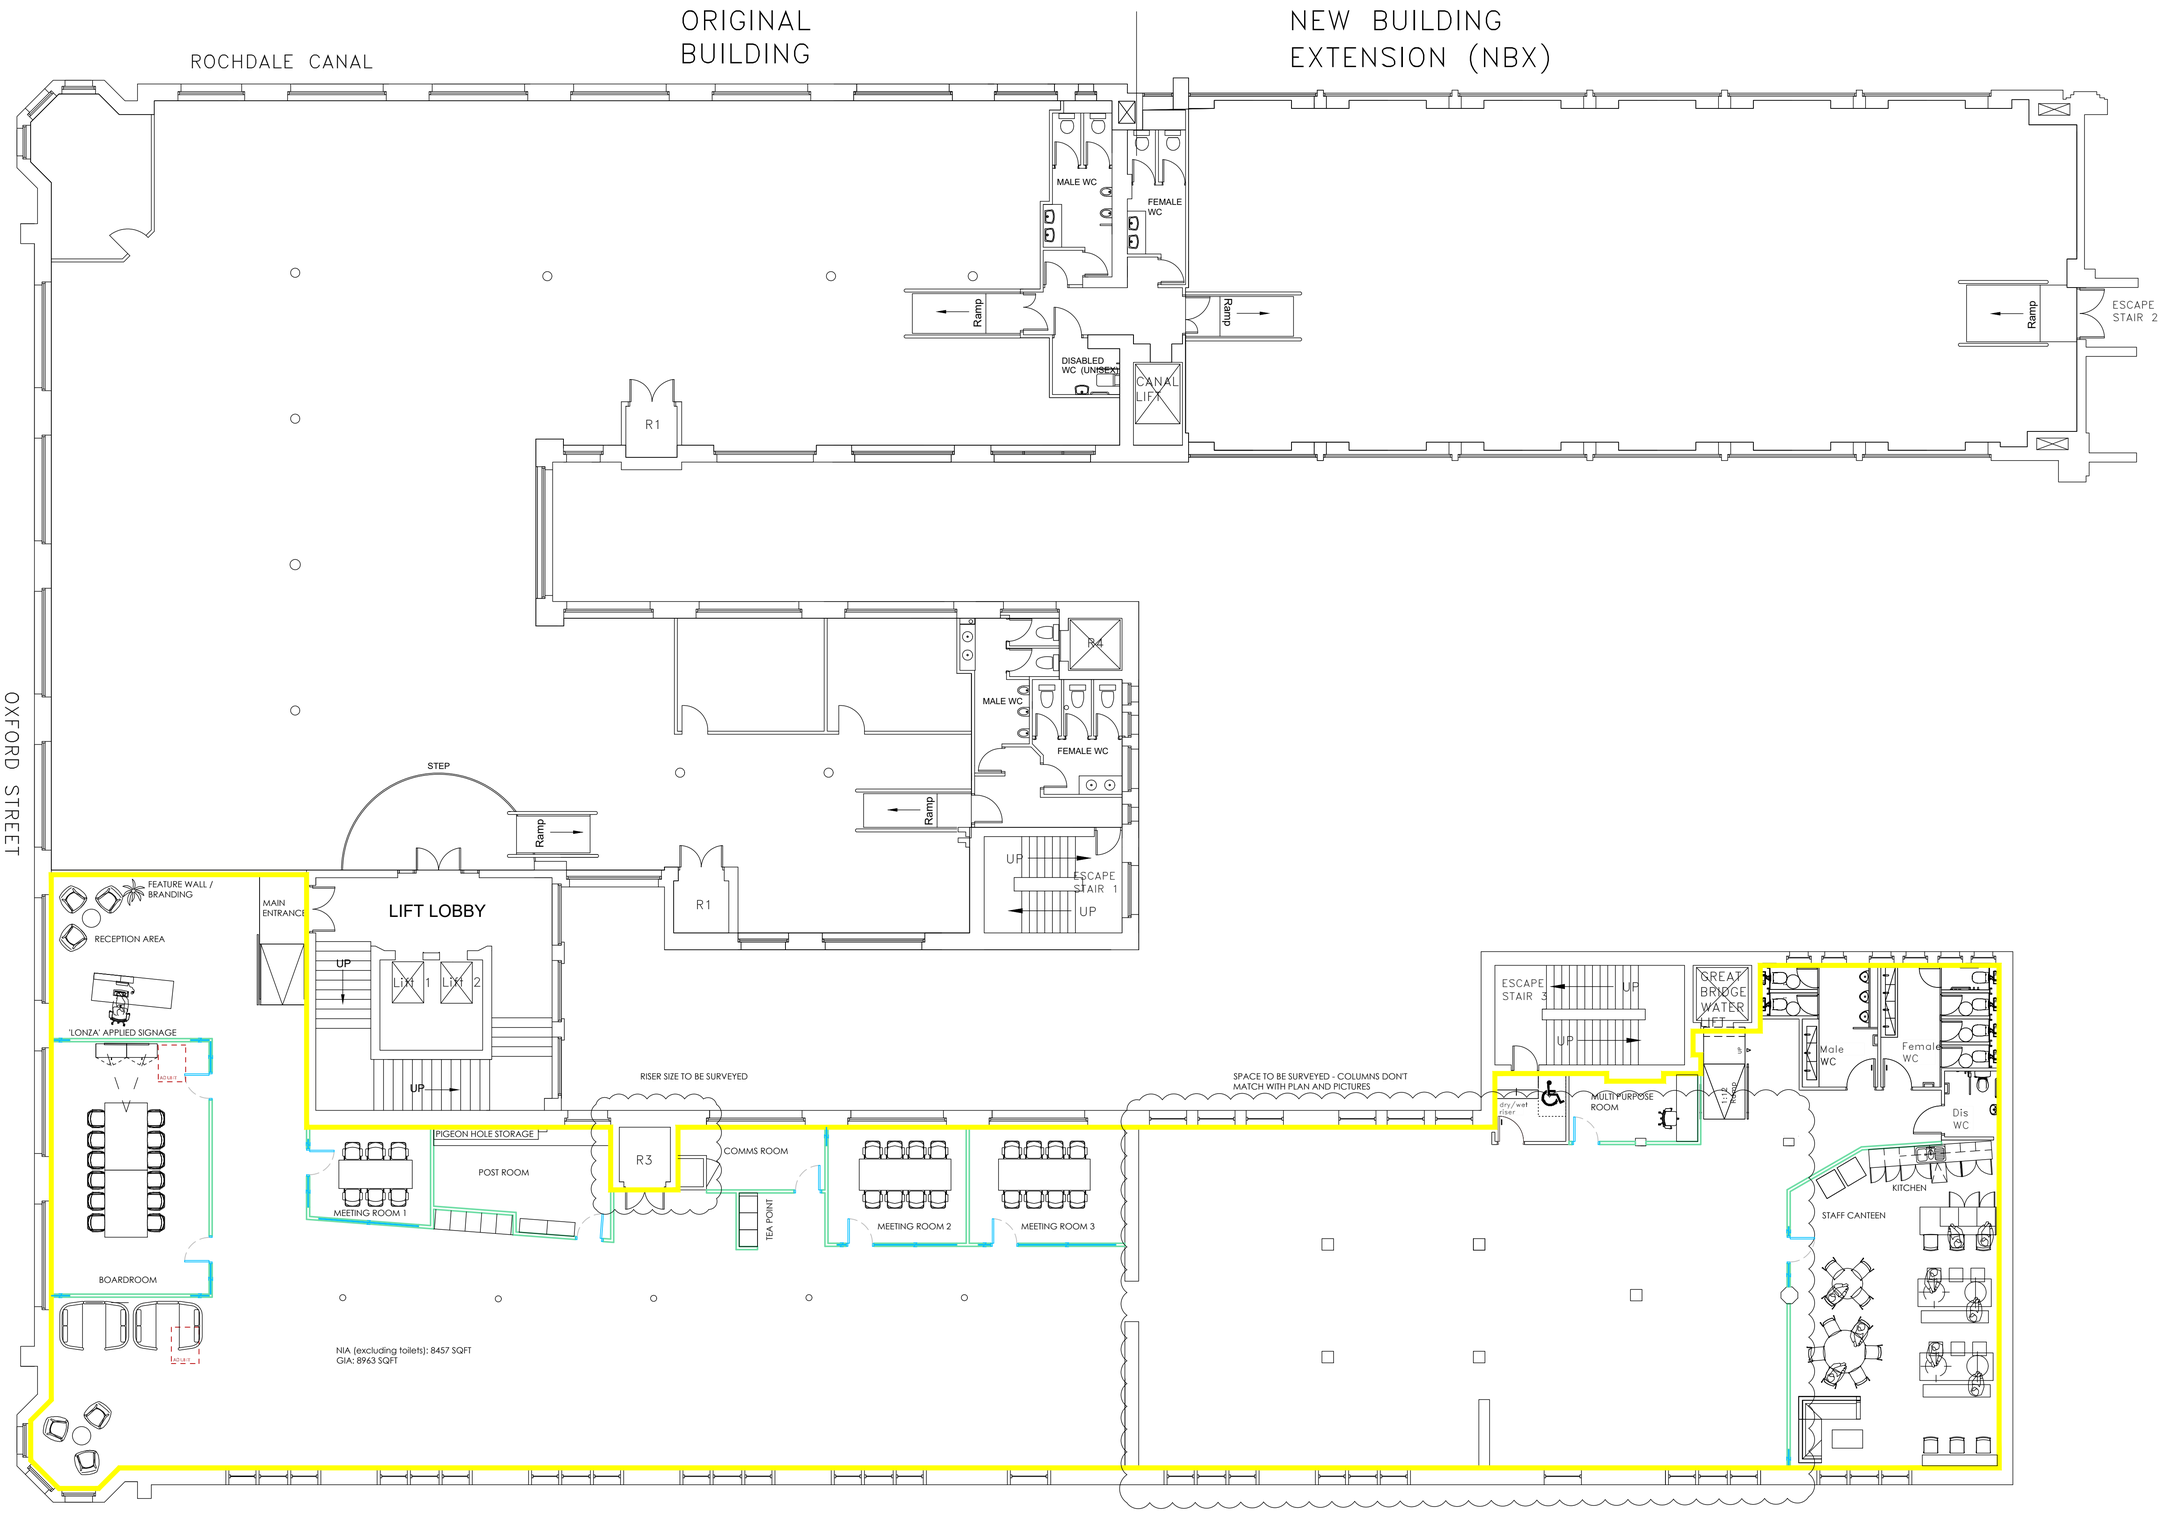



DRAWING TO BE READ IN CONJUNCTION WITH SCOPE OF WORKS

N

FLOOR PLATE AREA: XXXX SQFT

1:100 @ A1

1 2 3 4 5 6 7 8 9

| REV | DESCRIPTION | DRWN | CHKD | DATE |
|---|---|---|---|---|
| - | ------- | -- | -- | DD/MM/YY |

DRAWING STATUS

# PITCH DRAWING

CLIENT

-

PROJECT ADDRESS

Broadhurst Building, 56 Oxford Street, Menchester M1 6EU. Lee Building 90 Great Bridgewater Street Menchester M1 5JW

TITLE

Broadhurst Building - Second Floor - Lonza - as built

| SCALE | 1:100@A1 | DATE | |
|---|---|---|---|
| DRAWN | GP | CHECKED | |

| PROJECT NO | BLDG. | FLOOR | DETAIL | REV. |
|---|---|---|---|---|
| | - 01 - | 02 - | | - REV_ |

AIS +Enriching Environments

Ground Floor, St Paul's House, 10 Warwick Lane, London, EC4M 7BP

Tel: 020 7101 1177
enquiries@aisworkplace.com
www.ais-interiors.com

The copyright in this drawing is vested in Advanced Interior Solutions Group Companies Limited and its subsidiary companies ("AIS"), and no license or assignment of any kind has been, or is, granted to any third party whether by provision of copies, originals or otherwise, unless agreed expressly in writing by AIS. This drawing may not be copied, shown or given to a third party unless agreed expressly in writing by AIS.
© Copyright AIS

Layouts and all dimensions are subject to confirmation on site prior to commencement of any works. Do not scale from this drawing. AIS cannot accept responsibility for the accuracy of scaled plans supplied to us by third parties in either hard copy or PDF formats.