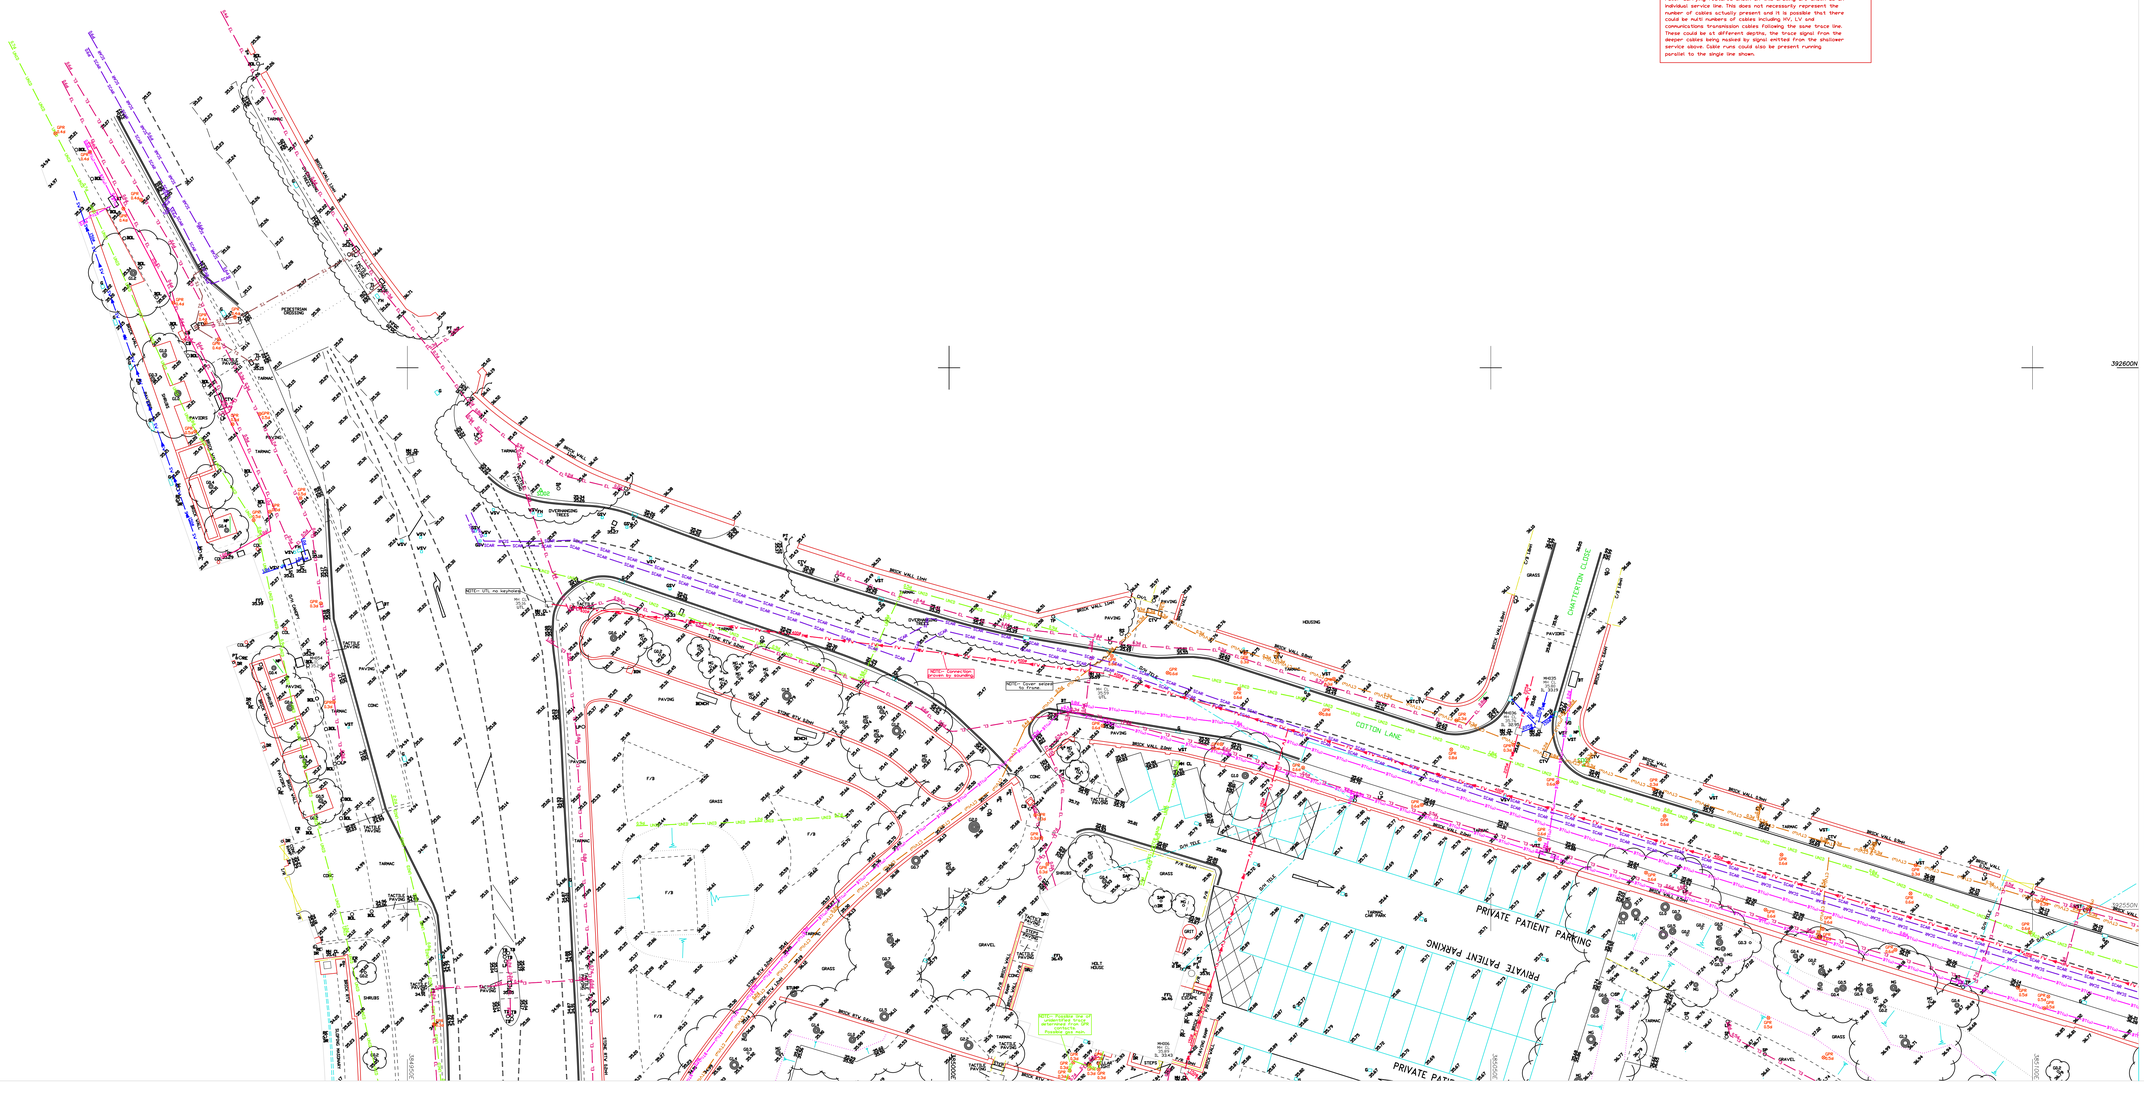
392650N
392600N
392550N
COTTON LANE
CHATTERTON CLOSE
PRIVATE PATIENT PARKING
PRIVATE PATIENT PARKING
PRIVATE PATIENT PARKING
HOUSING
HOUSE
BRICK WALL 1.8m
BRICK WALL 2.0m
BRICK WALL 2.5m
STONE RTN WALL 0.6m
STONE RTN WALL 1.0m
STONE RTN WALL 1.2m
PAVING
TARMAC
CONC
GRASS
GRAVEL
SHRUBS
HEDGE
TREE
NOTE: Possible line of underground drain detected from CCTV survey
NOTE: UTL no keyhole

SW — SW	STORM WATER SEWERS
FW — FW	FOUL WATER SEWERS
CS — CS	COMBINED WATER SEWERS
WM — WM	WATER MAIN
CW — CW	CULVERTED WATER
GM — GM	GAS MAIN
HV — HV	HV ELECTRIC CABLES
EL — EL	ELECTRIC CABLES
DUCT	CABLE DUCTING
HT — HT	U/G HEATING
PA — PA	PUBLIC ADDRESS SYSTEMS
FL — FL	FUEL LINE
BT(u)	BT (UNDERGROUND)
TM — TM	TELEMETRY SYSTEMS
COMS	COMMUNICATIONS CABLES
CTV(u)	CABLE TV
TS — TS	TRAFFIC CONTROL SIGNAL
CCTV	CLOSED CIRCUIT TV
UNID	UNIDENTIFIED FEATURE
UP — UP	UNIDENTIFIED PIPE
UC — UC	UNIDENTIFIED CABLE
UNPR	UNPROVEN FEATURE
SCAR	SERVICES SCAR
AB	ABANDONED SERVICE / UTILITY
SW — SW	END OF TRACE
FW — C — FW	
	EXTENT OF SURVEY BY SURVEY OPERATIONS LTD.
GPR	BURIED FEATURE FOUND USING RADAR

UNIDENTIFIED - A buried feature or utility that has been located, but we are unable to state what it is.

UNPROVEN - The assumed location of a reported feature or utility, usually taken from records, but not found during the utility trace (due to various conditions).

CAUTION - Electric pot ended cables, even when they are live, are unable to be detected or traced.

UNDERGROUND UTILITIES SERVICES DISCLAIMER

We have endeavoured to locate existing services using records provided by Statutory Authorities as a guide. Some apparatus were untraceable and details have therefore been taken from Utility Record Drawings, which may be of poor quality. Consequently we cannot guarantee accuracy of information

Where indicated, no allowance has been made for sub-surface entry into manholes, other chambers or confined spaces below ground level. Therefore any details relating to depths, sizes etc, are taken from the surface and as such will be approximate.

We have endeavoured to supply you with the most accurate data possible by using methods and equipment that are at the forefront of our industry. We have taken great care in the detection of pipework and buried features, but as with all methods of detecting underground or buried utilities the information provided is based on results obtained from electromagnetic techniques, and as such may be liable to distortion or errors beyond the reasonable control of the operator or his instruments.

It is the responsibility of the user under Health & Safety (HSG47) Guidelines to satisfy himself of the suspected location of any services prior to excavation of the services shown.

NOTE 1

This utility survey has been undertaken using:
A: Radiodetection RD4000 + RD4000 TIO
B: Mala Geoscience Ground Probing Radar

NOTE 2

Power carrying features shown on this drawing are shown as an individual service line. This does not necessarily represent the number of cables actually present and it is possible that there could be multi numbers of cables including HV, LV and communications transmission cables following the same trace line. These could be at different depths, the trace signal from the deeper cables being masked by signal emitted from the shallower service above. Cable runs could also be present running parallel to the single line shown.

© Survey Operations Limited 2011
Reproduction in whole or in part by any means is prohibited without the prior permission of Survey Operations Limited.

N

Note:
The survey is plotted on a plane local Grid. Orientation to National Grid. All levels relate to Ordnance Datum, achieved using the OS National GPS Network.

Survey Control Markers established for Mapping purposes only and should not be used for Construction without the written approval of Survey Operations Ltd.

Utility survey added to topographical survey job No. 10L010.

Drainage information must be verified with local authority records before use

SURVEY STATIONS

Name	Easting	Northing	Height
S001	384951.08	392498.82	34.70
S002	384962.31	392588.70	35.39
S003	385058.60	392563.29	35.84
S004	385137.08	392530.15	36.52
S005	385216.56	392505.52	37.05
S006	385280.35	392448.68	37.45
S007	385322.52	392415.69	37.55
S008	385139.38	392199.72	35.39
S009	385005.64	392306.16	34.75
S010	384920.04	392335.76	34.31
S011	384942.26	392404.49	34.48
S012	385085.59	392350.77	35.02
S013	385116.75	392448.06	35.93
S014	385023.51	392476.75	34.88

STANDARD REFERENCE & ABBREVIATIONS

(AR)........Assumed Route
AV..........Air Valve
B/W.........Barbed Wire
BB..........Belisha Beacon
BH..........Borehole
BL..........Bed Level
BS..........Bus Stop
BT Box......British Telecom Box
BT..........British Telecom IC
BW..........Brick Wall
Bar.........Barrier
Bol.........Bollard
C/B.........Close Boarded
C/I.........Corrugated Iron
C/P.........Chestnut Paling
CB..........Control Box
CCTV........Closed Circuit TV
CD..........Cable Duct
CH/L........Chain Link
CL..........Cover Level
CM..........Cable Marker
COL.........Column
CONC........Concrete
CP..........Catch Pit
CTV.........Cable Television
CW..........Concrete Block Wall
Chy.........Chimney
Cul.........Culvert
D.C.........Drainage Channel
DP..........Down Pipe
DR..........Drain
ECP.........Electricity Cable Pit
EIC.........Electricity Inspection Cover
EJ..........Expansion Joint
EJB.........Electricity Junction Box
EL SUB STN..Electricity Sub Station
EL..........Eaves Level
ELB.........Electricity Box
EP..........Electricity Pole
ER..........Earth Rod
ETL.........Electricity Transmission Line
F/B.........Flower Bed
FFL.........Finished Floor Level
FH..........Fire Hydrant
FL..........Floor Level
FP..........Flagpole
G*.*........Girth (of tree)
G...........Gulley
GP..........Guide Post
GSV.........Gas Stop Valve
HSE.........Housing
HV..........High Voltage
Ht..........Height
I/R.........Iron Railing
IC..........Inspection Cover
IL..........Invert Level
KO..........Kerb Outlet
LB..........Letter Box
LP..........Lamp Post
MG..........Multi-Girth
MH..........Manhole
MKR.........Marker
MP,MS.......Mile Post or Stone
NP..........Street Name Plate
O/H.........Overhead
O/P.........Open Paling
OSBM........Ordnance Survey Bench Mark
P/C.........Post & Chain
P/R.........Post & Rail
P/W.........Post & Wire
PAV.........Paving
PB..........Pillar Box
PC..........Pedestrian Crossing
PP..........Petrol Pump
PT..........Post or Pillar
RE..........Rodding Eye
RS..........Road Sign
RTW.........Retaining Wall
RWP.........Rain Water Pipe
SAP.........Sapling
SL..........Sump Level
SP..........Sign Post
SV..........Stop Valve (unspecified)
SVP.........Soil Vent Pipe
SW..........Stone Wall
SoL.........Soffit Level
TB..........Traffic Bollard
TBM.........Temporary Bench Mark
TCB.........Telephone Call Box
TFR.........Taken From Records
TIE.........Anchor Point (Masts/Poles)
TL..........Traffic Light
TLB.........Traffic Light Control Box
TM..........Ticket Machine
TMC.........Tarmac
TP..........Telecommunications Pole
TPIT........Trial Pit
U/C.........Under Construction
U/G.........Underground
UTL.........Unable to Lift (MH,IC etc)
VDP.........Vehicle Detector Pad
VP..........Vent Pipe
W/M.........Wire Mesh
WL..........Water Level
WM..........Water Meter
WO..........Wash Out
WST.........Water Stop Tap (domestic)
WSV.........Water Stop Valve (mains)

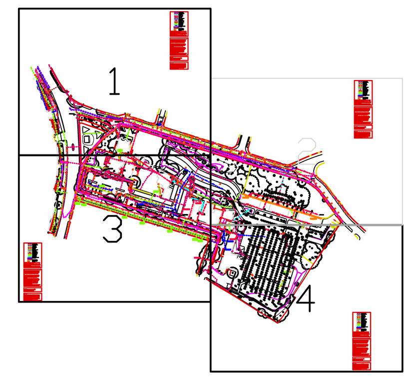

Survey OPERATIONS
Smith Street, Skelmersdale, Lancs. WN8 8LN
Tel: 01695 725662 Fax: 01695 51816
Email: mail@survops.co.uk — www.survops.co.uk

Client
Wilson Mason and Partners
Upland House, Spring Lane
Samlesbury
PR5 0UX

Drawing Title
Utility Survey of Land at:
Manchester University
MCRC Building
Sheet 2 of 4

Scale(s)	1:200	Surveyor	PG
Date	JAN 11	Drawn	IT
Job Number	11A152	Checked	PG/SG

Sheet Size & Drg Number & Revision
A0 11A152/002

- SW — STORM WATER SEWERS
- FW — FOUL WATER SEWERS
- CS — COMBINED WATER SEWERS
- WM — WATER MAIN
- CW — CULVERTED WATER
- GM — GAS MAIN
- HV — HV ELECTRIC CABLES
- EL — ELECTRIC CABLES
- DUCT — CABLE DUCTING
- HT — U/G HEATING
- PA — PUBLIC ADDRESS SYSTEMS
- FL — FUEL LINE
- BT(u) — BT (UNDERGROUND)
- TM — TELEMETRY SYSTEMS
- COMS — COMMUNICATIONS CABLES
- CTV(u) — CABLE TV
- TS — TRAFFIC CONTROL SIGNAL
- CCTV — CLOSED CIRCUIT TV
- UNID — UNIDENTIFIED FEATURE
- UP — UNIDENTIFIED PIPE
- UC — UNIDENTIFIED CABLE
- UNPR — UNPROVEN FEATURE
- SCAR — SERVICES SCAR
- AB — ABANDONED SERVICE / UTILITY
- SW — END OF TRACE
- FW C FW
- EXTENT OF SURVEY BY SURVEY OPERATIONS LTD.
- GPR — BURIED FEATURE FOUND USING RADAR

UNIDENTIFIED - A buried feature or utility that has been located, but we are unable to state what it is.

UNPROVEN - The assumed location of a reported feature or utility, usually taken from records, but not found during the utility trace (due to various conditions).

CAUTION - Electric pot ended cables, even when they are live, are unable to be detected or traced.

UNDERGROUND UTILITIES SERVICES DISCLAIMER

We have endeavoured to locate existing services using records provided by Statutory Authorities as a guide. Some apparatus were untraceable and details have therefore been taken from Utility Record Drawings, which may be of poor quality. Consequently we cannot guarantee accuracy of information

Where indicated, no allowance has been made for sub-surface entry into manholes, other chambers or confined spaces below ground level. Therefore any details relating to depths, sizes etc, are taken from the surface and as such will be approximate.

We have endeavoured to supply you with the most accurate data possible by using methods and equipment that are at the forefront of our industry. We have taken great care in the detection of pipework and buried features, but as with all methods of detecting underground or buried utilities the information provided is based on results obtained from electromagnetic techniques, and as such may be liable to distortion or errors beyond the reasonable control of the operator or his instruments.

It is the responsibility of the user under Health & Safety (HSG47) Guidelines to satisfy himself of the suspected location of any services prior to excavation of the services shown.

NOTE 1

This utility survey has been undertaken using:
A: Radiodetection RD4000 + RD4000 TIO
B: Mala Geoscience Ground Probing Radar

NOTE 2

Power carrying features shown on this drawing are shown as an individual service line. This does not necessarily represent the number of cables actually present and it is possible that there could be multi numbers of cables including HV, LV and communications transmission cables following the same trace line. These could be at different depths, the trace signal from the deeper cables being masked by signal emitted from the shallower service above. Cable runs could also be present running parallel to the single line shown.

© Survey Operations Limited 2011
Reproduction in whole or in part by any means is prohibited without the prior permission of Survey Operations Limited.

N

Note:

The survey is plotted on a plane local Grid. Orientation to National Grid. All levels relate to Ordnance Datum, achieved using the OS National GPS Network.

Survey Control Markers established for Mapping purposes only and should not be used for Construction without the written approval of Survey Operations Ltd.

Utility survey added to topographical survey job No. 10L010.

Drainage information must be verified with local authority records before use

SURVEY STATIONS

Name	Easting	Northing	Height
S001	384951.08	392498.82	34.70
S002	384962.31	392588.70	35.39
S003	385058.60	392563.29	35.84
S004	385137.08	392530.15	36.52
S005	385216.56	392505.52	37.05
S006	385280.35	392448.68	37.45
S007	385322.52	392415.69	37.55
S008	385139.38	392199.72	35.39
S009	385005.64	392306.16	34.75
S010	384920.04	392335.76	34.31
S011	384942.26	392404.49	34.48
S012	385085.59	392350.77	35.02
S013	385116.75	392448.06	35.93
S014	385023.51	392476.75	34.88

STANDARD REFERENCE & ABBREVIATIONS

(AR)........Assumed Route
AV..........Air Valve
B/W.........Barbed Wire
BB..........Belisha Beacon
BH..........Borehole
BL..........Bed Level
BS..........Bus Stop
BT Box......British Telecom Box
BT..........British Telecom IC
BW..........Brick Wall
Bar.........Barrier
Bol.........Bollard
C/B.........Close Boarded
C/I.........Corrugated Iron
C/P.........Chestnut Paling
CB..........Control Box
CCTV........Closed Circuit TV
CD..........Cable Duct
CH/L........Chain Link
CL..........Cover Level
CM..........Cable Marker
COL.........Column
CONC........Concrete
CP..........Catch Pit
CTV.........Cable Television
CW..........Concrete Block Wall
Chy.........Chimney
Cul.........Culvert
D.C.........Drainage Channel
DP..........Down Pipe
DR..........Drain
ECP.........Electricity Cable Pit
EIC.........Electricity Inspection Cover
EJ..........Expansion Joint
EJB.........Electricity Junction Box
EL SUB STN..Electricity Sub Station
EL..........Eaves Level
ELB.........Electricity Box
EP..........Electricity Pole
ER..........Earth Rod
ETL.........Electricity Transmission Line
F/B.........Flower Bed
FFL.........Finished Floor Level
FH..........Fire Hydrant
FL..........Floor Level
FP..........Flagpole
G*.*........Girth (of tree)
G...........Gulley
GP..........Guide Post
GSV.........Gas Stop Valve
HSE.........Housing
HV..........High Voltage
Ht..........Height
I/R.........Iron Railing
IC..........Inspection Cover
IL..........Invert Level
KO..........Kerb Outlet
LB..........Letter Box
LP..........Lamp Post
MG..........Multi-Girth
MH..........Manhole
MKR.........Marker
MP,MS.......Mile Post or Stone
NP..........Street Name Plate
O/H.........Overhead
O/P.........Open Paling
OSBM........Ordnance Survey Bench Mark
P/C.........Post & Chain
P/R.........Post & Rail
P/W.........Post & Wire
PAV.........Paving
PB..........Pillar Box
PC..........Pedestrian Crossing
PP..........Petrol Pump
PT..........Post or Pillar
RE..........Rodding Eye
RS..........Road Sign
RTW.........Retaining Wall
RWP.........Rain Water Pipe
SAP.........Sapling
SL..........Sump Level
SP..........Sign Post
SV..........Stop Valve (unspecified)
SVP.........Soil Vent Pipe
SW..........Stone Wall
SoL.........Soffit Level
TB..........Traffic Bollard
TBM.........Temporary Bench Mark
TCB.........Telephone Call Box
TFR.........Taken From Records
TIE.........Anchor Point (Masts/Poles)
TL..........Traffic Light
TLB.........Traffic Light Control Box
TM..........Ticket Machine
TMC.........Tarmac
TP..........Telecommunications Pole
TPIT........Trial Pit
U/C.........Under Construction
U/G.........Underground
UTL.........Unable to Lift (MH,IC etc)
VDP.........Vehicle Detector Pad
VP..........Vent Pipe
W/M.........Wire Mesh
WL..........Water Level
WM..........Water Meter
WO..........Wash Out
WST.........Water Stop Tap (domestic)
WSV.........Water Stop Valve (mains)

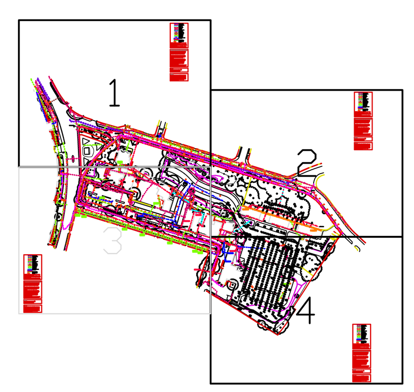

Survey Operations
Smith Street, Skelmersdale, Lancs. WN8 8LN
Tel: 01695 725662 Fax: 01695 51816
Email: mail@survops.co.uk — www.survops.co.uk

Client
Wilson Mason and Partners
Upland House, Spring Lane
Samlesbury
PR5 0UX

Drawing Title
Utility Survey of Land at:
Manchester University
MCRC Building
Sheet 3 of 4

Scale(s)	1:200	Surveyor	PG
Date	JAN 11	Drawn	IT
Job Number	11A152	Checked	PG/SG

Sheet Size & Drg Number & Revision
A0 11A152/003

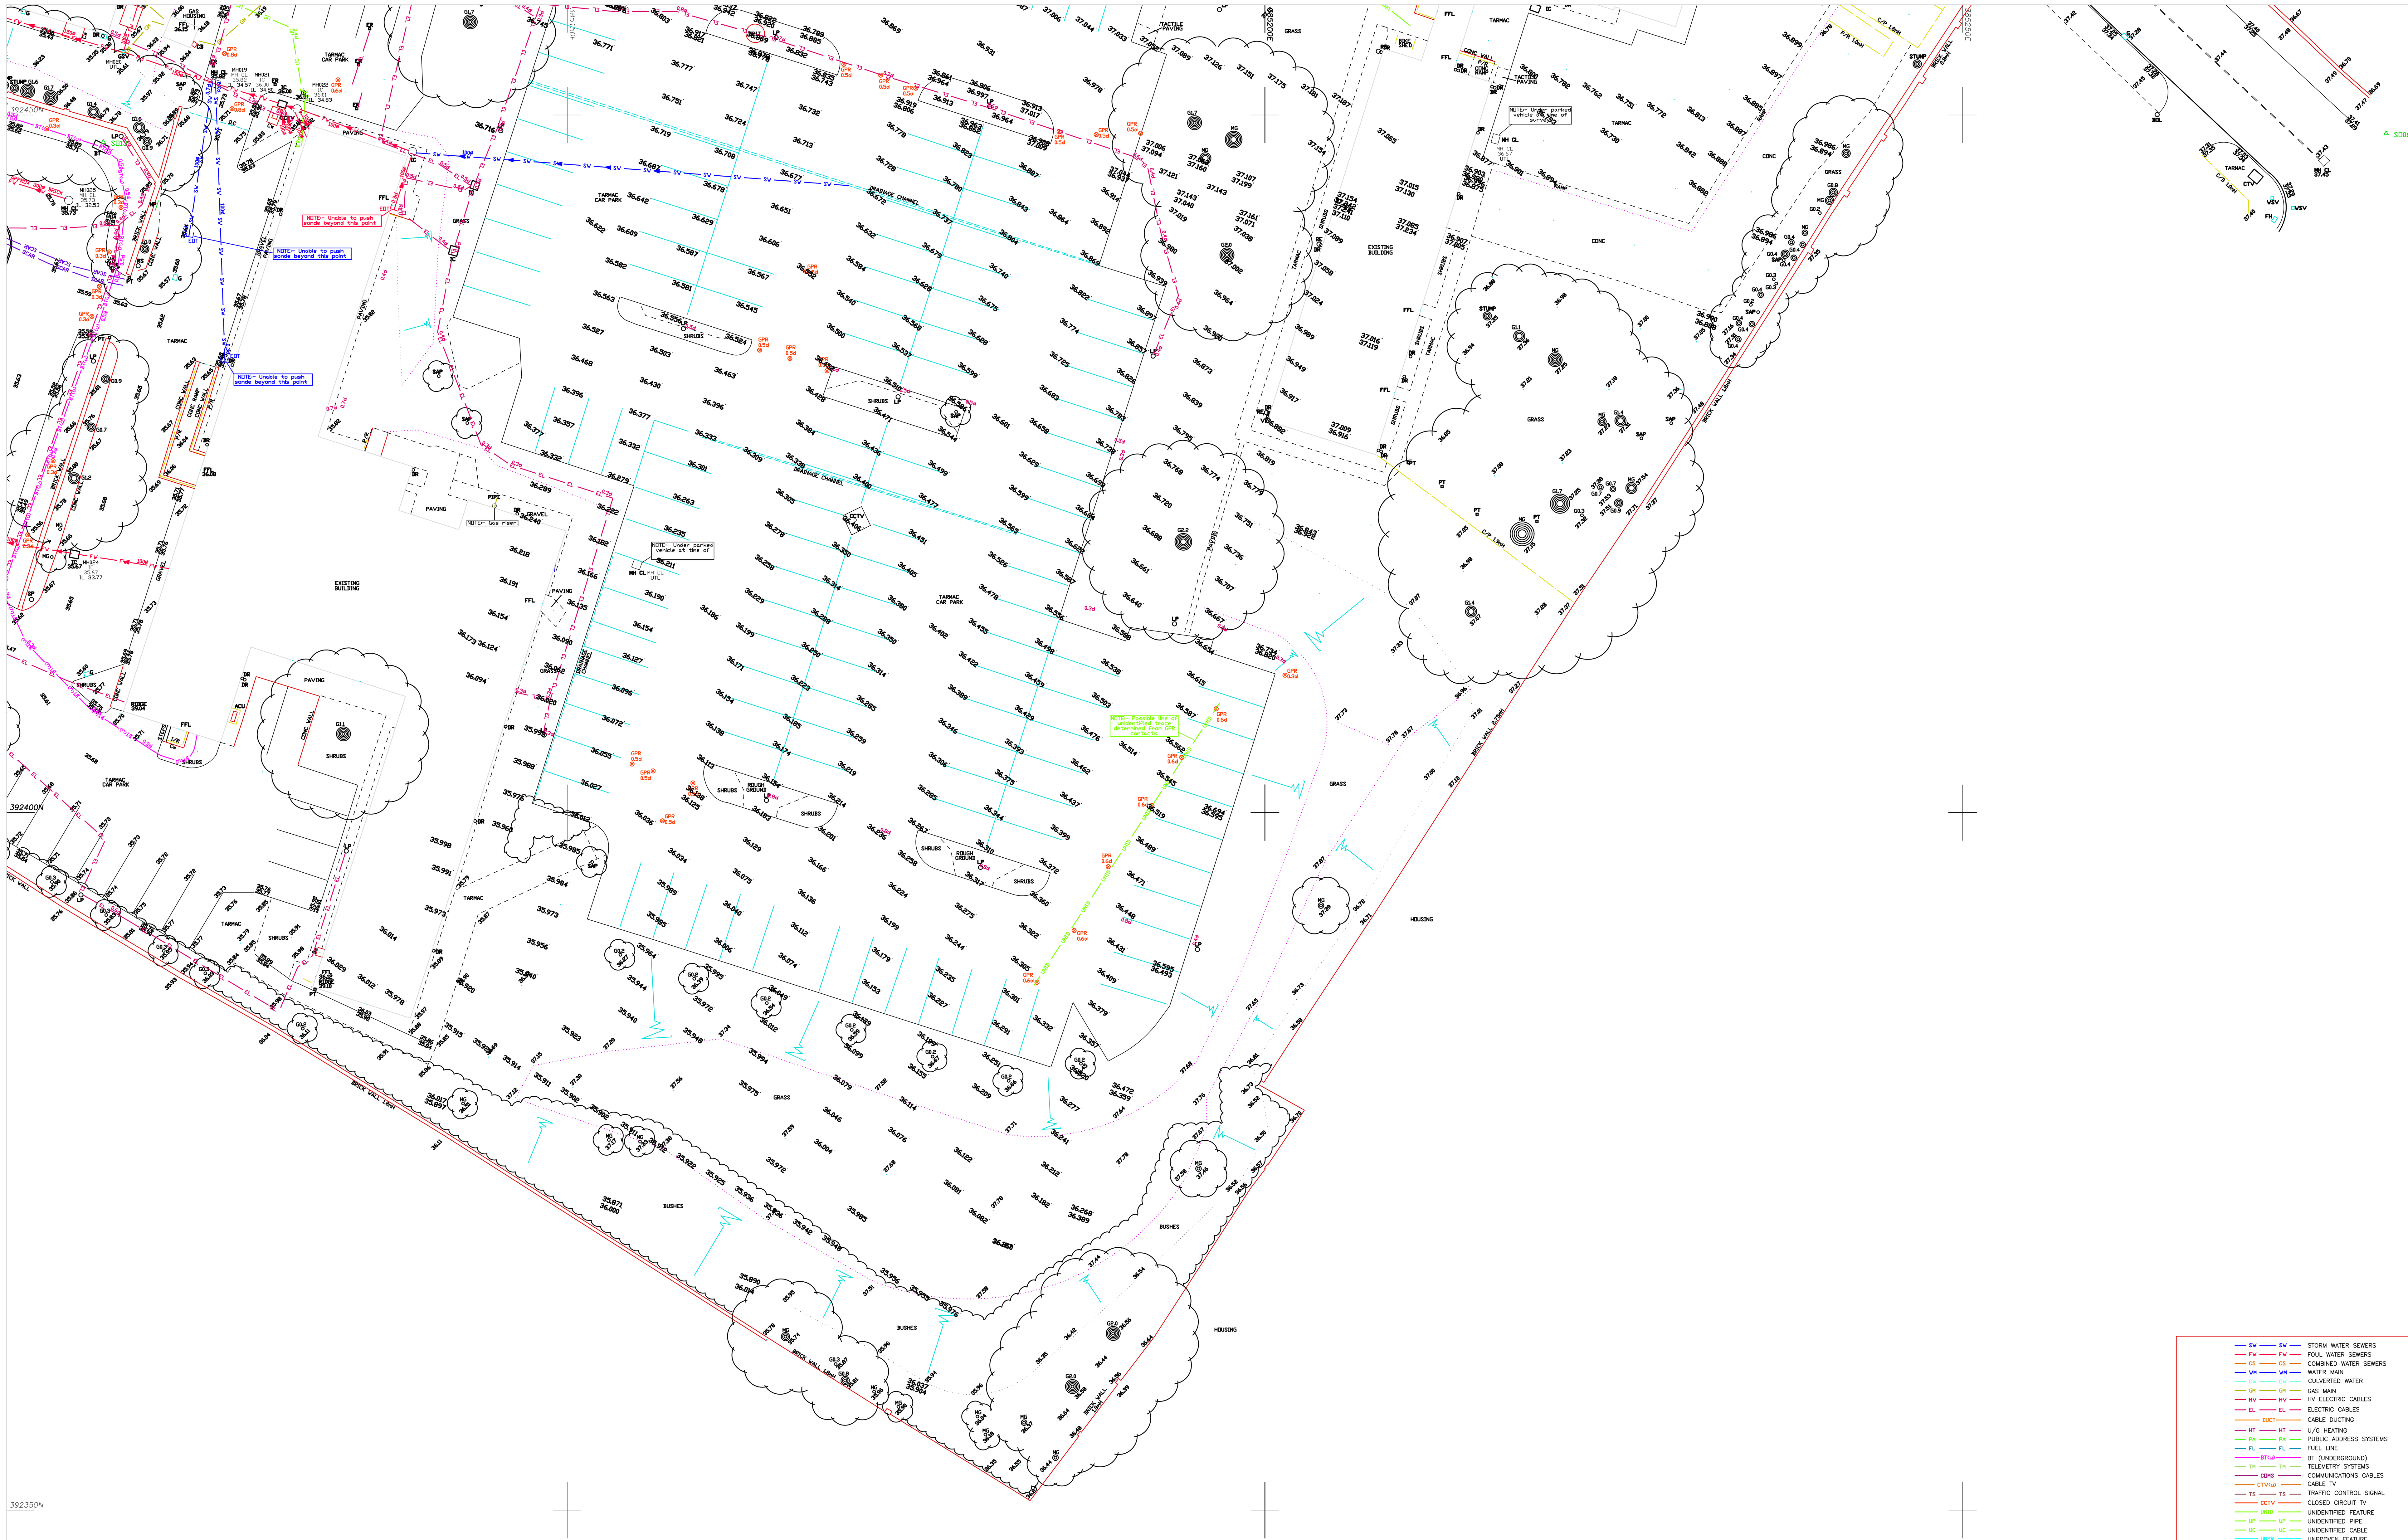

Code	Description
SW	STORM WATER SEWERS
FW	FOUL WATER SEWERS
CS	COMBINED WATER SEWERS
WM	WATER MAIN
CW	CULVERTED WATER
GM	GAS MAIN
HV	HV ELECTRIC CABLES
EL	ELECTRIC CABLES
DUCT	CABLE DUCTING
HT	U/G HEATING
PA	PUBLIC ADDRESS SYSTEMS
FL	FUEL LINE
BT(u)	BT (UNDERGROUND)
TM	TELEMETRY SYSTEMS
COMS	COMMUNICATIONS CABLES
CTV(u)	CABLE TV
TS	TRAFFIC CONTROL SIGNAL
CCTV	CLOSED CIRCUIT TV
UNID	UNIDENTIFIED FEATURE
UP	UNIDENTIFIED PIPE
UC	UNIDENTIFIED CABLE
UNPR	UNPROVEN FEATURE
SCAR	SERVICES SCAR
AB	ABANDONED SERVICE / UTILITY
SW	END OF TRACE
FW C FW	
	EXTENT OF SURVEY BY SURVEY OPERATIONS LTD.
GPR	BURIED FEATURE FOUND USING RADAR

UNIDENTIFIED - A buried feature or utility that has been located, but we are unable to state what it is.

UNPROVEN - The assumed location of a reported feature or utility, usually taken from records, but not found during the utility trace (due to various conditions).

CAUTION - Electric pot ended cables, even when they are live, are unable to be detected or traced.

UNDERGROUND UTILITIES SERVICES DISCLAIMER

We have endeavoured to locate existing services using records provided by Statutory Authorities as a guide. Some apparatus were untraceable and details have therefore been taken from Utility Record Drawings, which may be of poor quality. Consequently we cannot guarantee accuracy of information

Where indicated, no allowance has been made for sub-surface entry into manholes, other chambers or confined spaces below ground level. Therefore any details relating to depths, sizes etc, are taken from the surface and as such will be approximate.

We have endeavoured to supply you with the most accurate data possible by using methods and equipment that are at the forefront of our industry. We have taken great care in the detection of pipework and buried features, but as with all methods of detecting underground or buried utilities the information provided is based on results obtained from electromagnetic techniques, and as such may be liable to distortion or errors beyond the reasonable control of the operator or his instruments.

It is the responsibility of the user under Health & Safety (HSG47) Guidelines to satisfy himself of the suspected location of any services prior to excavation of the services shown.

NOTE 1

This utility survey has been undertaken using:
A: Radiodetection RD4000 + RD4000 TIO
B: Mala Geoscience Ground Probing Radar

NOTE 2

Power carrying features shown on this drawing are shown as an individual service line. This does not necessarily represent the number of cables actually present and it is possible that there could be multi numbers of cables including HV, LV and communications transmission cables following the same trace line. These could be at different depths, the trace signal from the deeper cables being masked by signal emitted from the shallower service above. Cable runs could also be present running parallel to the single line shown.

© Survey Operations Limited 2011
Reproduction in whole or in part by any means is prohibited without the prior permission of Survey Operations Limited.

Note:
The survey is plotted on a plane local Grid. Orientation to National Grid. All levels relate to Ordnance Datum, achieved using the OS National GPS Network.

Survey Control Markers established for Mapping purposes only and should not be used for Construction without the written approval of Survey Operations Ltd.

Utility survey added to topographical survey job No. 10L010.

Drainage information must be verified with local authority records before use

SURVEY STATIONS

Name	Easting	Northing	Height
S001	384951.08	392498.82	34.70
S002	384962.31	392588.70	35.39
S003	385058.60	392563.29	35.84
S004	385137.08	392530.15	36.52
S005	385216.56	392505.52	37.05
S006	385280.35	392448.68	37.45
S007	385322.52	392415.69	37.55
S008	385139.38	392199.72	35.39
S009	385005.64	392306.16	34.75
S010	384920.04	392335.76	34.31
S011	384942.26	392404.49	34.48
S012	385085.59	392350.77	35.02
S013	385116.75	392448.06	35.93
S014	385023.51	392476.75	34.88

STANDARD REFERENCE & ABBREVIATIONS

(AR)........Assumed Route
AV..........Air Valve
B/W.........Barbed Wire
BB..........Belisha Beacon
BH..........Borehole
BL..........Bed Level
BS..........Bus Stop
BT Box......British Telecom Box
BT..........British Telecom IC
BW..........Brick Wall
Bar.........Barrier
Bol.........Bollard
C/B.........Close Boarded
C/I.........Corrugated Iron
C/P.........Chestnut Paling
CB..........Control Box
CCTV........Closed Circuit TV
CD..........Cable Duct
CH/L........Chain Link
CL..........Cover Level
CM..........Cable Marker
COL.........Column
CONC........Concrete
CP..........Catch Pit
CTV.........Cable Television
CW..........Concrete Block Wall
Chy.........Chimney
Cul.........Culvert
D.C.........Drainage Channel
DP..........Down Pipe
DR..........Drain
ECP.........Electricity Cable Pit
EIC.........Electricity Inspection Cover
EJ..........Expansion Joint
EJB.........Electricity Junction Box
EL SUB STN..Electricity Sub Station
EL..........Eaves Level
ELB.........Electricity Box
EP..........Electricity Pole
ER..........Earth Rod
ETL.........Electricity Transmission Line
F/B.........Flower Bed
FFL.........Finished Floor Level
FH..........Fire Hydrant
FL..........Floor Level
FP..........Flagpole
G*.*........Girth (of tree)
G...........Gulley
GP..........Guide Post
GSV.........Gas Stop Valve
HSE.........Housing
HV..........High Voltage
Ht..........Height
I/R.........Iron Railing
IC..........Inspection Cover
IL..........Invert Level
KO..........Kerb Outlet
LB..........Letter Box
LP..........Lamp Post
MG..........Multi-Girth
MH..........Manhole
MKR.........Marker
MP,MS.......Mile Post or Stone
NP..........Street Name Plate
O/H.........Overhead
O/P.........Open Paling
OSBM........Ordnance Survey Bench Mark
P/C.........Post & Chain
P/R.........Post & Rail
P/W.........Post & Wire
PAV.........Paving
PB..........Pillar Box
PC..........Pedestrian Crossing
PP..........Petrol Pump
PT..........Post or Pillar
RE..........Rodding Eye
RS..........Road Sign
RTW.........Retaining Wall
RWP.........Rain Water Pipe
SAP.........Sapling
SL..........Sump Level
SP..........Sign Post
SV..........Stop Valve (unspecified)
SVP.........Soil Vent Pipe
SW..........Stone Wall
SoL.........Soffit Level
TB..........Traffic Bollard
TBM.........Temporary Bench Mark
TCB.........Telephone Call Box
TFR.........Taken From Records
TIE.........Anchor Point (Masts/Poles)
TL..........Traffic Light
TLB.........Traffic Light Control Box
TM..........Ticket Machine
TMC.........Tarmac
TP..........Telecommunications Pole
TPIT........Trial Pit
U/C.........Under Construction
U/G.........Underground
UTL.........Unable to Lift (MH,IC etc)
VDP.........Vehicle Detector Pad
VP..........Vent Pipe
W/M.........Wire Mesh
WL..........Water Level
WM..........Water Meter
WO..........Wash Out
WST.........Water Stop Tap (domestic)
WSV.........Water Stop Valve (mains)

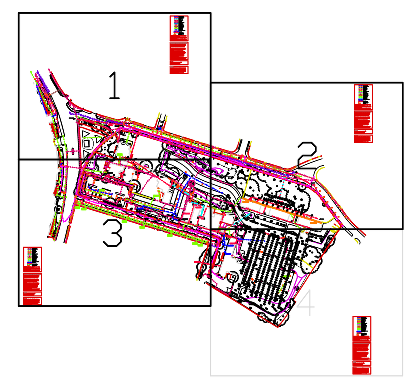

Survey Operations
Smith Street, Skelmersdale, Lancs. WN8 8LN
Tel: 01695 725662 Fax: 01695 51816
Email: mail@survops.co.uk – www.survops.co.uk

Client
Wilson Mason and Partners
Upland House, Spring Lane
Samlesbury
PR5 0UX

Drawing Title
Utility Survey of Land at:
Manchester University
MCRC Building
Sheet 4 of 4

Scale(s)	1:200	Surveyor	PG
Date	JAN 11	Drawn	IT
Job Number	11A152	Checked	PG/SG

Sheet Size & Drg Number & Revision
A0 11A152/004