

Rev	Date	Description
-	-	-

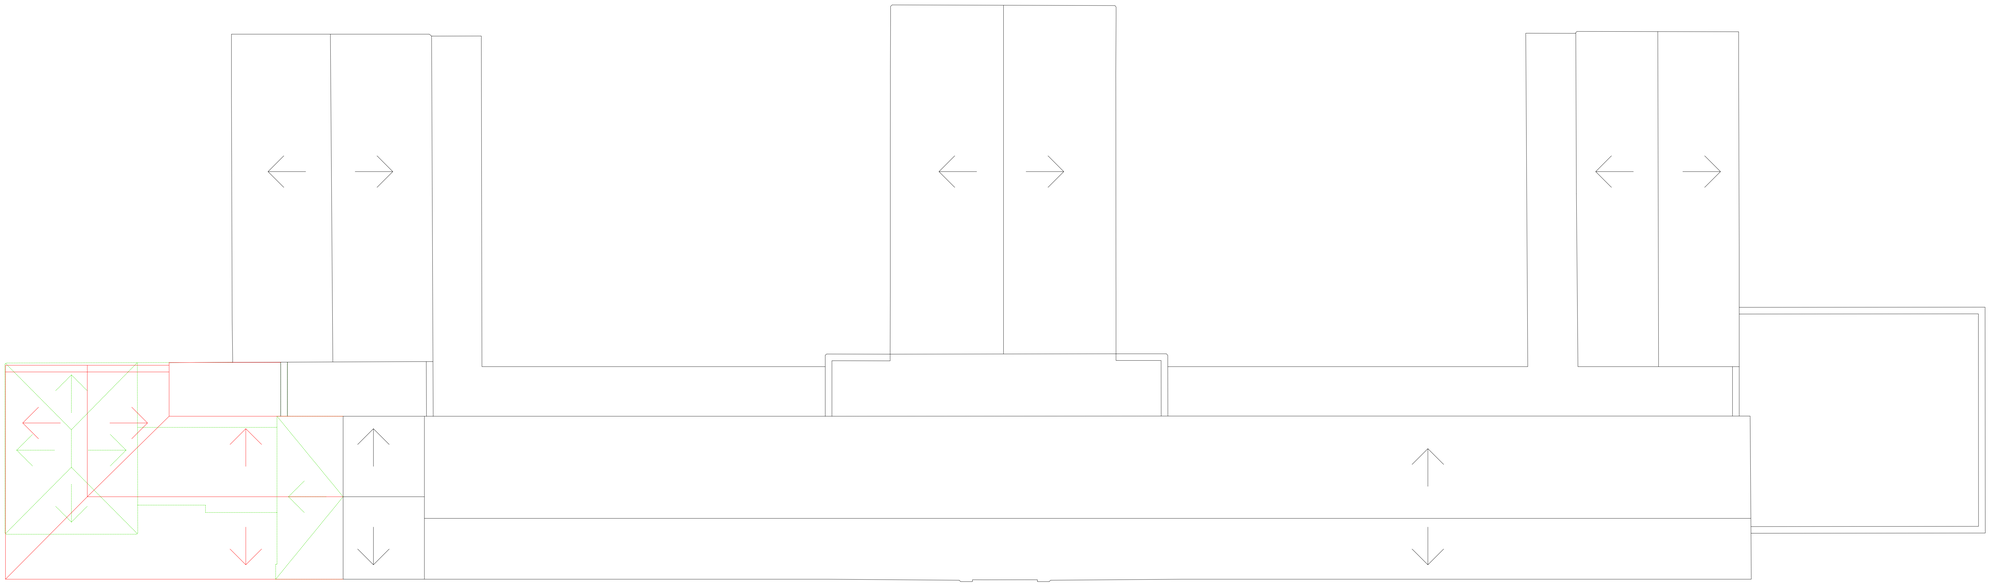

ROOF LAYOUT

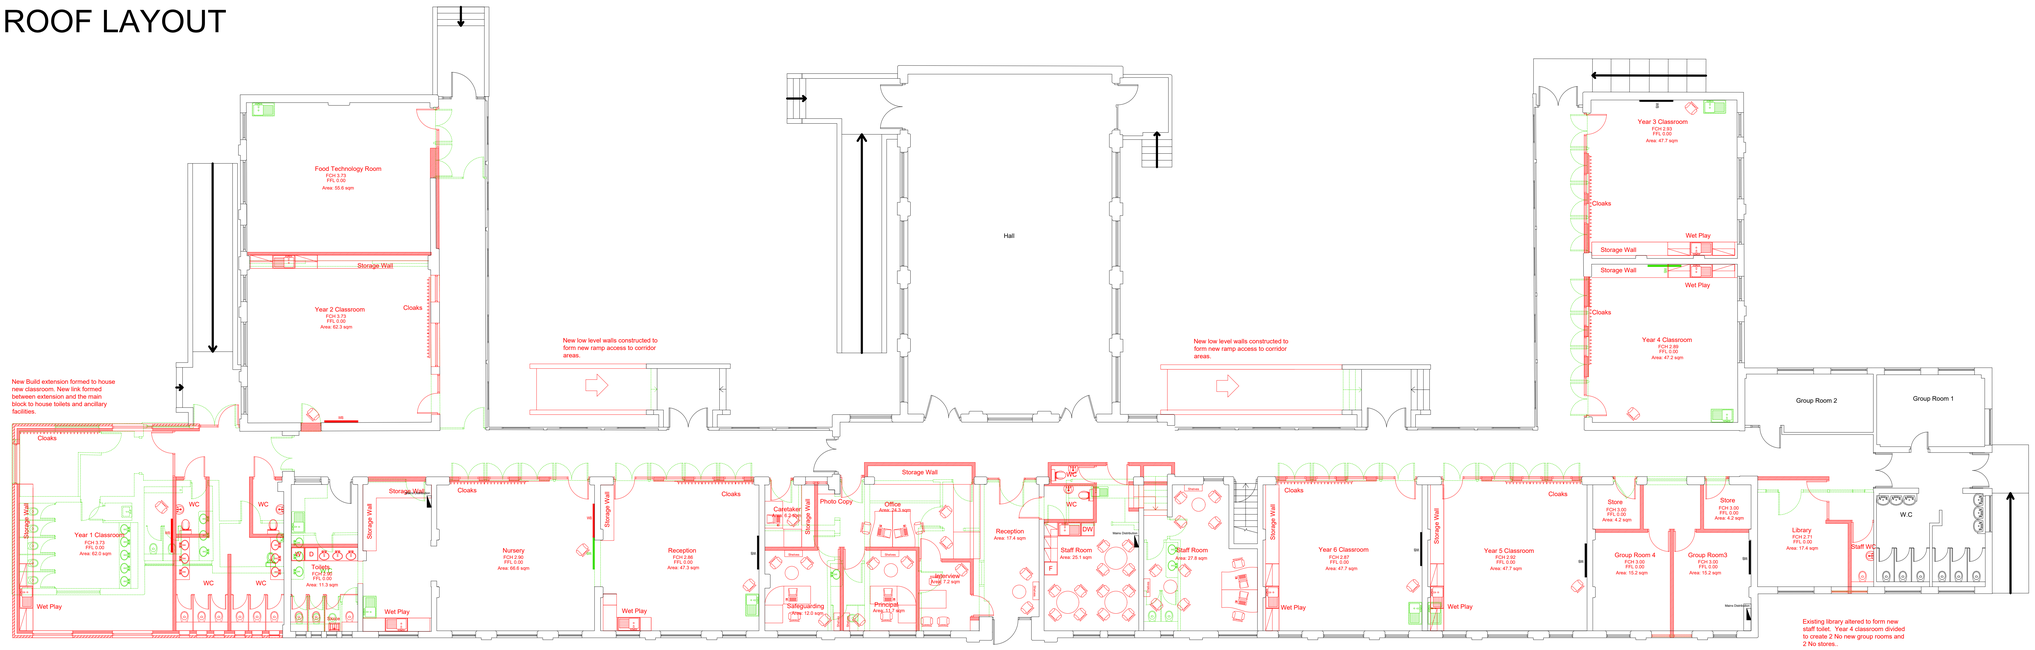

GROUND FLOOR LAYOUT

EXISTING INDICATED IN BLACK / WHITE
PROPOSED WORK INDICATED IN RED
DEMOLITION INDICATED IN GREEN

1000 3000
0 2000 4000
LINEAR SCALE IN MILLIMETRES FOR 1:100 SCALE

Arcus Consulting LLP
Wakefield 0192 466 9000 Manchester 0161 905 3222 London 0208 8742 2512
Liverpool 0151 708 1080 Newcastle 0191 280 4000
info@arcus.uk.com www.arcus.uk.com

Client
OASIS COMMUNITY LEARNING
KEY STAGE 1 AND ADMIN BLOCK

Project
OASIS ACADEMY ASPINAL
BROADACRE ROAD, MANCHESTER M18 7NY

Title
PROPOSED LAYOUT
-

Scale	Date	Stage
1:100@A1	SEP 19	PLANNING
Job No	Drawing No	Rev
5926	103	-
Drawn	Approved	
NW	AW	

This drawing is the copyright of Arcus. Contractors must check all dimensions on site. Do not scale the drawings.Only figured dimensions are to be worked to.