


Photograph of new drip detail:

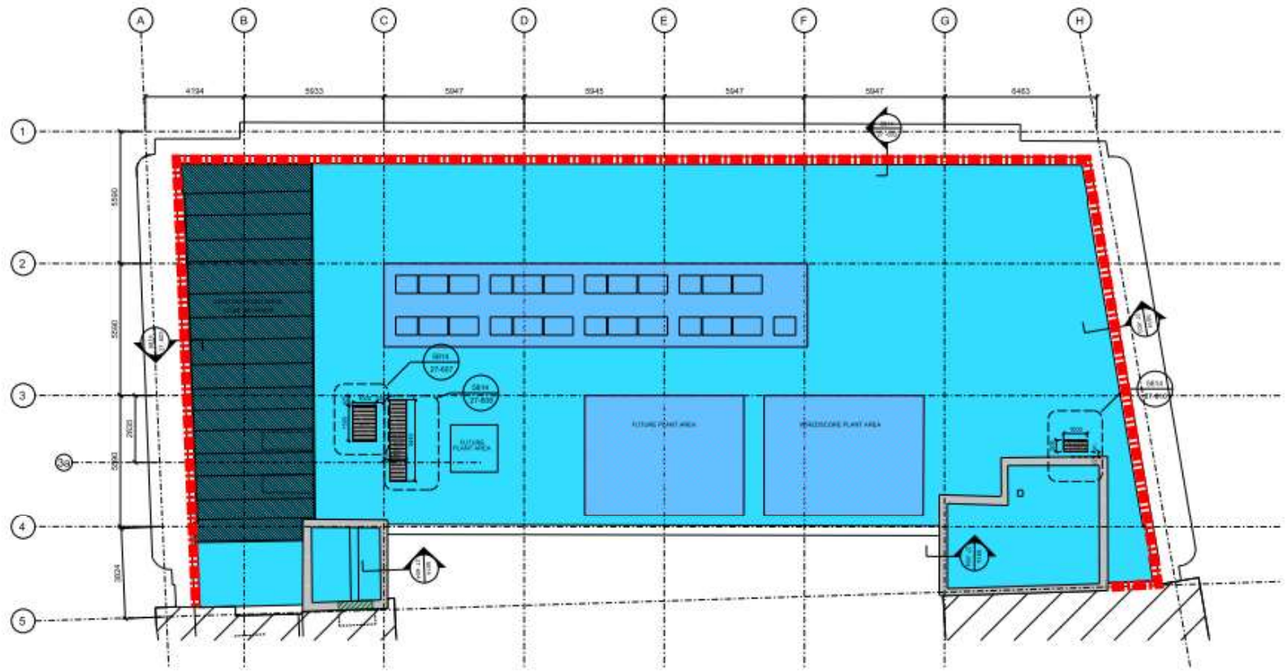

Red line of new drip detail:

Method:

The existing plastisol drip detail that has been installed to try to prevent the deterioration of the level 9 window lintels on the Hanover Street elevation will be carefully removed with hand tools. The new powder coated aluminium drip detail will be installed in the same location but will also incorporate the Dantzic & Federation elevations (atrium coping has drip detail incorporated). Bespoke corner pieces will be included to eliminate any mitred corners. The drip will be painted RAL9001 off site during the powder coating process. This will be fixed at the top, with the Kemperol (also painted RAL 9001) lapped on to the drip to provide sufficient weatherproofing.

Dantzic - Methodology for installation of new drip detail on main roof

Russells Construction