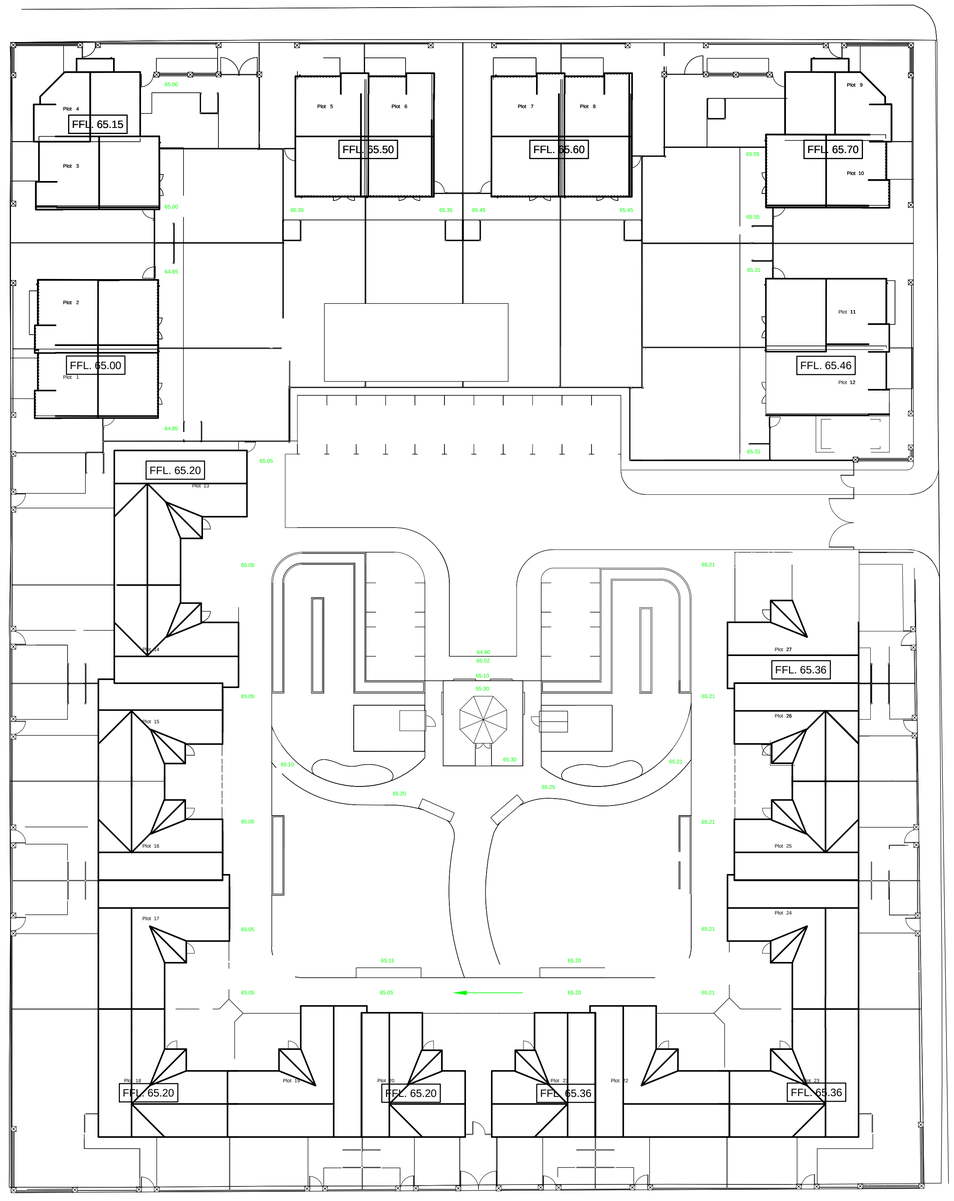


AS BUILT

REV	DATE	DESCRIPTION
A	01.07.19	AS BUILT

CLIENT

THE CASEY GROUP
RYDINGS ROAD
ROCHDALE

Carley Daines & Partners
Consulting Civil and Structural Engineers

11 Bridgewater Road Walkden
Worsley Manchester M28 3JE
Tel 0161 799 2720 Fax 0161 790 3474
E-mail mail@carleydaines.co.uk

TITLE

NEW DEVELOPMENT
SOUTH STREET
OPENSHAW

LEVELS (GARDEN)

Drawn	M.HOLE	Checked	DM
Date	APRIL 2019	Date	APRIL 2019
Scale	1:250		
Drawing No.	17.B.12001/13		A