
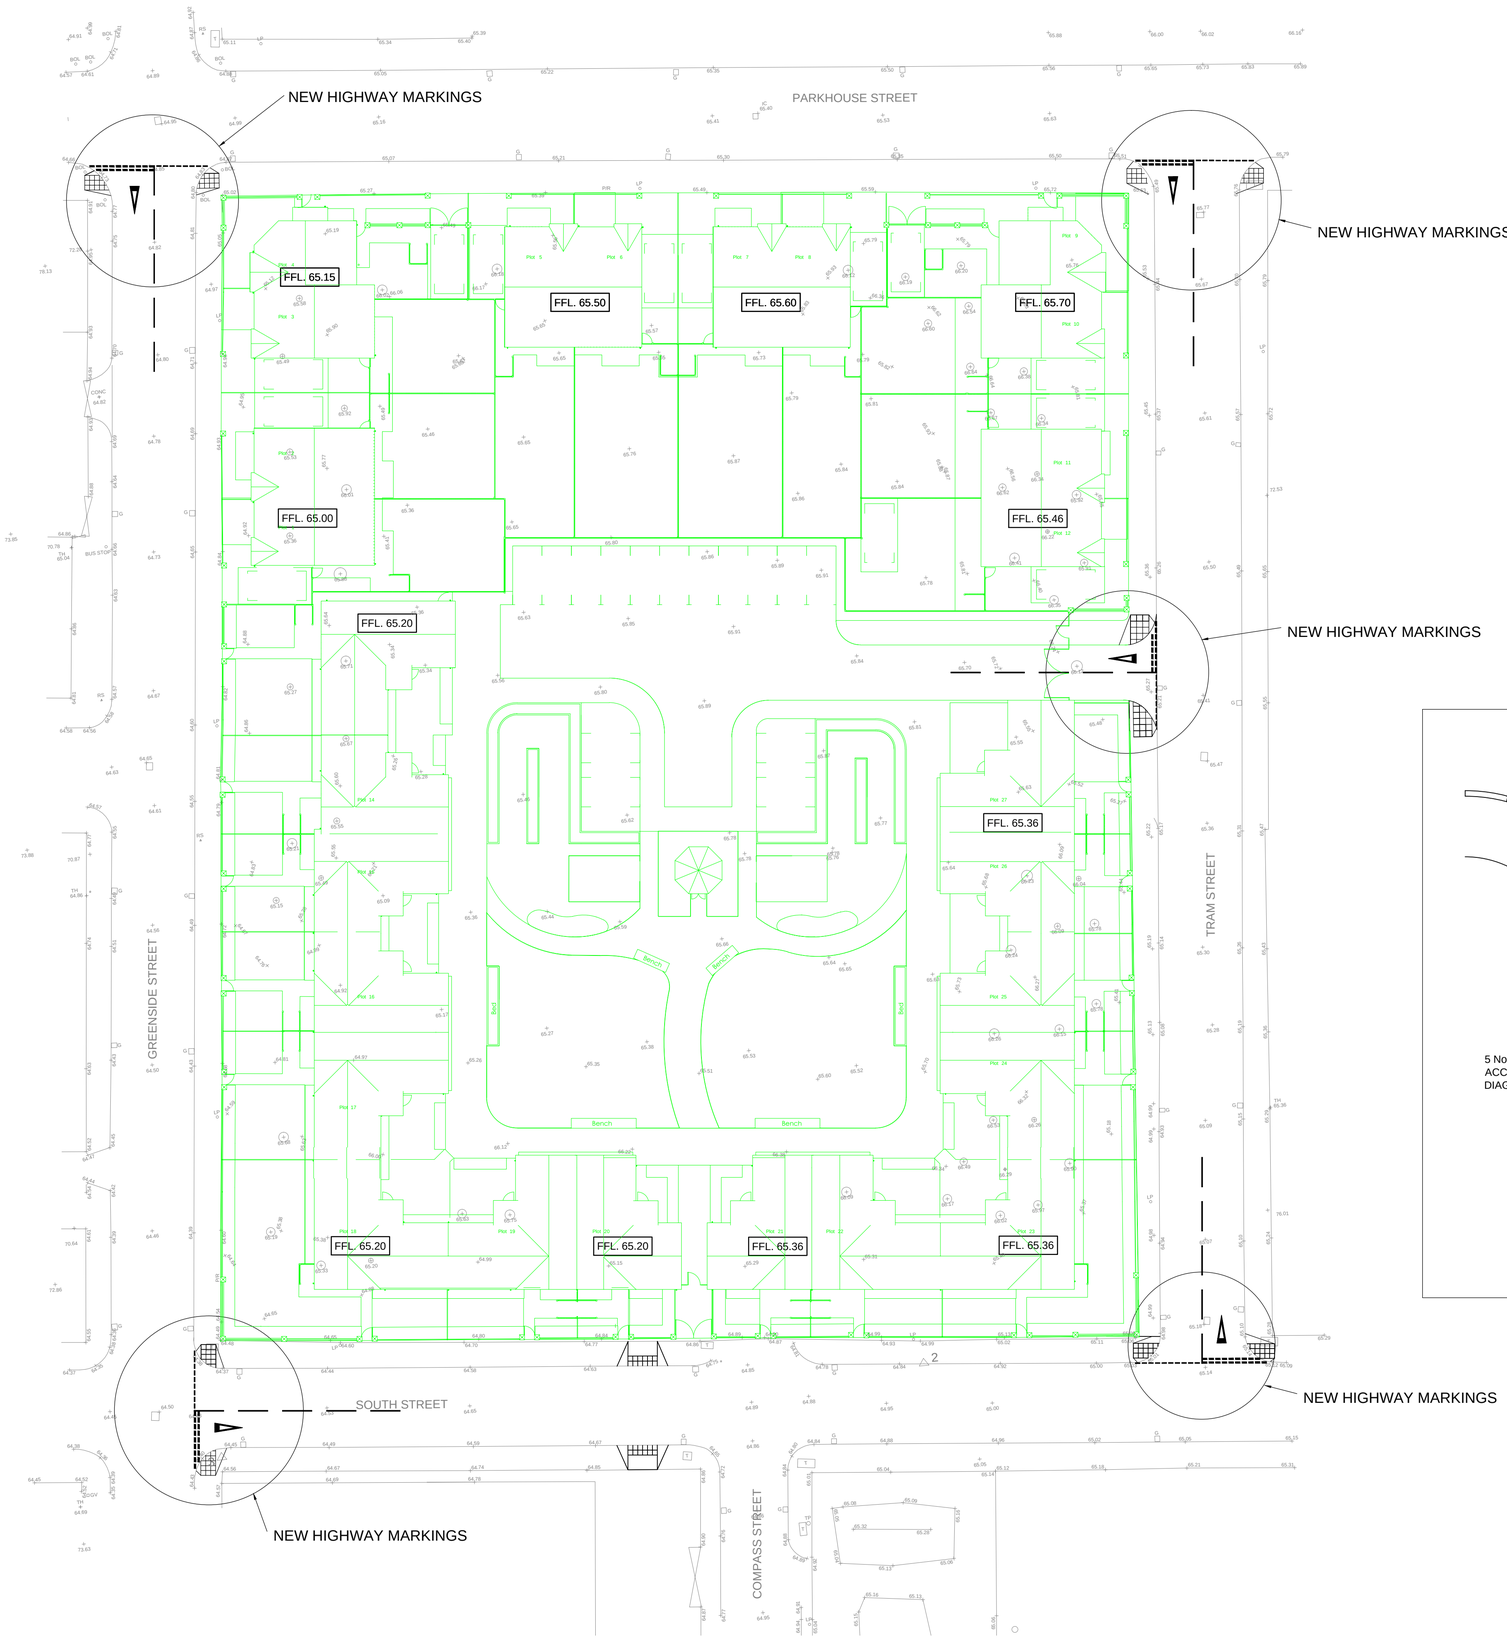


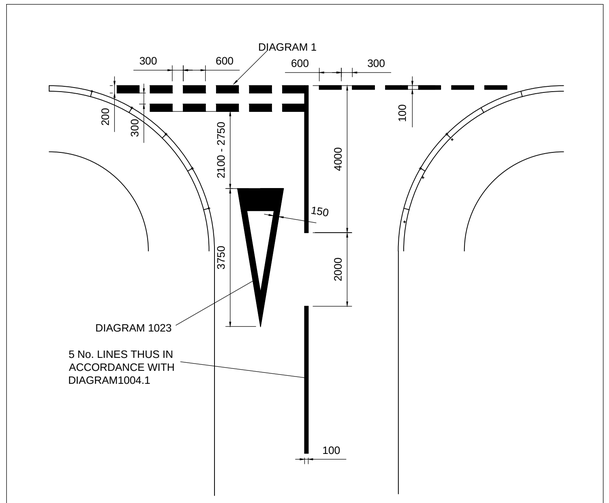

HIGHWAY MARKINGS

AS BUILT

NOTES

DO NOT SCALE OFF THIS DRAWING
IF IN DOUBT - ASK

REV	DATE	DESCRIPTION
C	01.07.19	AS BUILT
B	26.02.19	SITE ENTRANCE UPDATED
A	20.01.19	DRAWING UPDATED - CROSSING ADDED

CLIENT

THE CASEY GROUP
RYDINGS ROAD
ROCHDALE

Carley Daines & Partners
Consulting Civil and Structural Engineers

11 Bridgewater Road Walkden
Worsley Manchester M28 3JE
Tel 0161 799 2720 Fax 0161 790 3474
E-mail mail@carleydaines.co.uk

TITLE

NEW DEVELOPMENT
SOUTH STREET
OPENSHAW

HIGHWAY MARKINGS

Drawn	M.HOLE	Checked	CRC
	JUNE 2018	Date	JUNE 2018
Scale	1:250		
Drawing No.	17.B.12001/11		C