All dimensions are to be checked on site, any discrepancies are to be reported to the Architect before work commences. Do not scale from this drawing.

This drawing is to be read in conjunction with all relevant consultants and specialists drawings / documents, any discrepancies are to be reported to the Architect before the affected work commences.

All structural components shown are indicative only. Details / calculations of structural members are to be provided by the Structural Engineer.

This drawing is copyright.

A	Submission of Planning Application	16/12/2016
B	Amended as per the request of the client and LPA.	21/04/2017
C	Submission of Planning Application	19/06/2017
D	General amendments following comments received LPA on 04/12/2017	05/12/2017



Approved Kingston Road Elevation as built 1:100




Approved South-East Elevation as built 1:100



Original Kingston Road Elevation 1:100



Original South-East Elevation 1:100

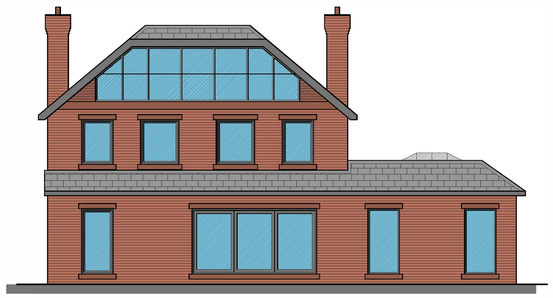

Approved Rear Elevation as built 1:100



Approved North-West Elevation as built 1:100



Original Rear Elevation 1:100



Original North-West Elevation 1:100

Note - Weathered Pre War Common Brick supplied by Imperial Handmade Brickwork on reconstructed elevations to be tinted to match the front elevations of neighbouring "Shirley Houses".

Tang & Associates Ltd
Chartered Architects

Tel : 0161 877 9587
e-mail: barrytang@tangassociates.co.uk

Entrance W1, 1/F, Westwood House,
Greenwood Business Centre,
Manchester, M5 4QH, UK

Client:

Mrs Shaheean Khan

Project:

53 Kingston Road, Didsbury, Manchester M20 2SB

Drawing Title:

Original and Approved Elevations
(Permission ref: 117633/FH/2017)

Scale:	Date:
1:100 @ A1	June 2019

Drawing No:	Revision:
9321/120	E