




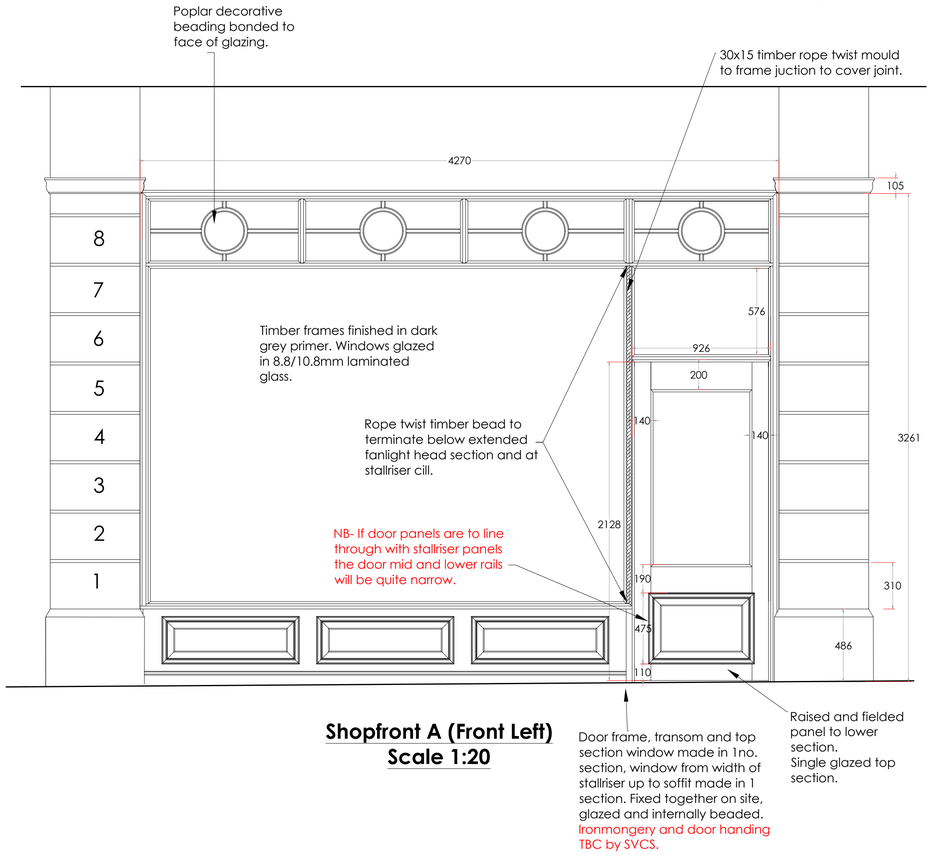


Shopfront A (Front Left) Scale 1:20

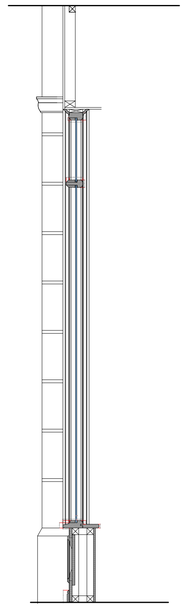

Typical Section Scale 1:20

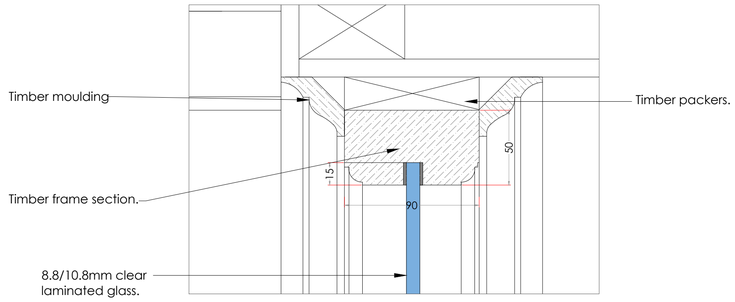


Head Section Scale 1:2

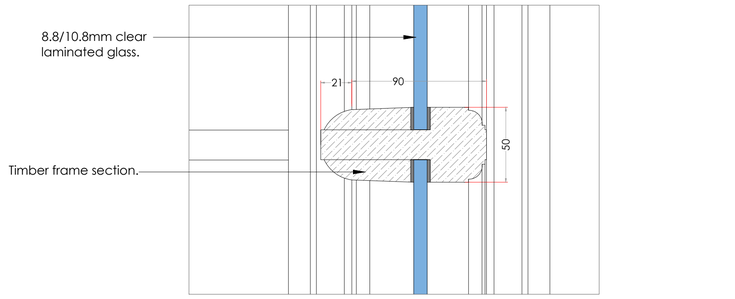


Mid Rail Scale 1:2




Plan Section Scale 1:20

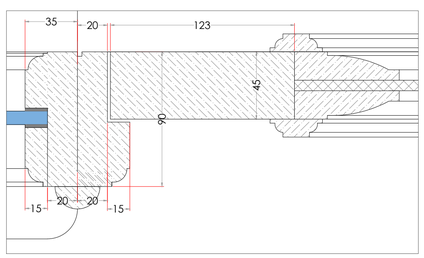


LH Lower Door/Frame Section Scale 1:2

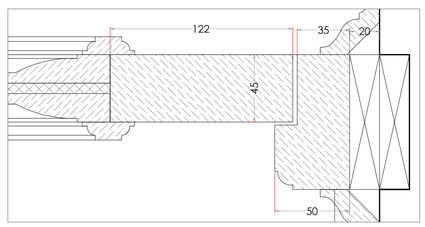


RH Lower Door/Frame Section Scale 1:2

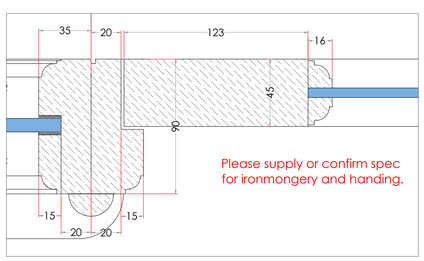


LH Upper Door/Frame Section Scale 1:2

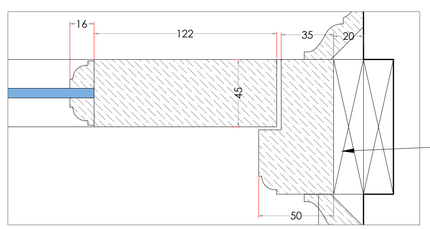

RH Upper Door/Frame Section Scale 1:2

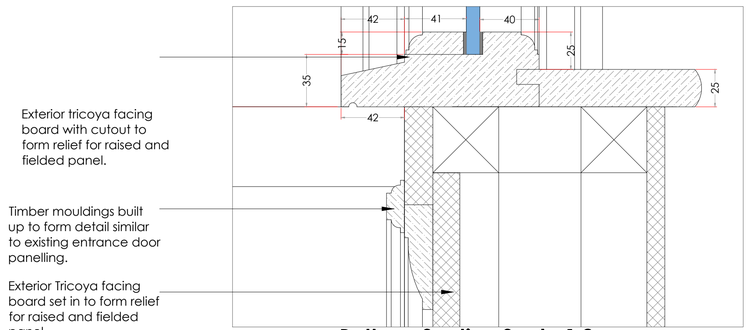

Bottom Section Scale 1:2

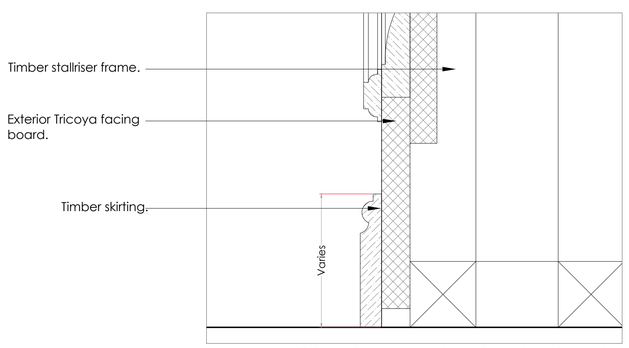

Stallriser bottom Section Scale 1:2

DRAWINGS NOT TO BE SCALED

All contractors are responsible for taking & checking all dimensions relative to this work.
The designer must be advised of any discrepancies.
This drawing must be read in conjunction with the specification/ bill of quantities & any related drawings.
Copyright on this drawing is reserved by MENTHA & HALSALL SHOPFITTERS LTD. & is issued on the condition that it is not copied, reproduced, retained or disclosed to any unauthorised person either wholly or in part without the consent in writing of MENTHA & HALSALL SHOPFITTERS LTD.

Revisions

16/10/18	A	Drawing revised as per main contractor/architects comments and markups.
3/12/18	B	Dims added to sections as requested.
5/2/19	C	Details revised following site meeting and Conservation Officer comments: Decorative moulding added to vertical frame/wall junctions and frame head/ soffit junctions. Stallriser front facing revised to resemble existing site doors' raised and fielded panels. New door revised to single glazed upper panel and raised and fielded panel to lower panel.
7/2/19	D	Door lower panel and mid rail increased in height.
8/3/19	E	Rope twist timber bead reduced in height. Now runs from stallriser cill to underside of fanlight extended upper section.

Project
Kenworthys Building

Drawing title
Shopfront A

Drawing no.	Rev.
1001.006	E
Date: 3/10/2018	Scale: 1:20 & 1:2@A1
Drawn by: CR	Job no.: ****

mentha & halsall
specialist interior fitout contractors
www.mentha-halsall.com
01704 530800