

Loading Bay: Ground Floor Plan

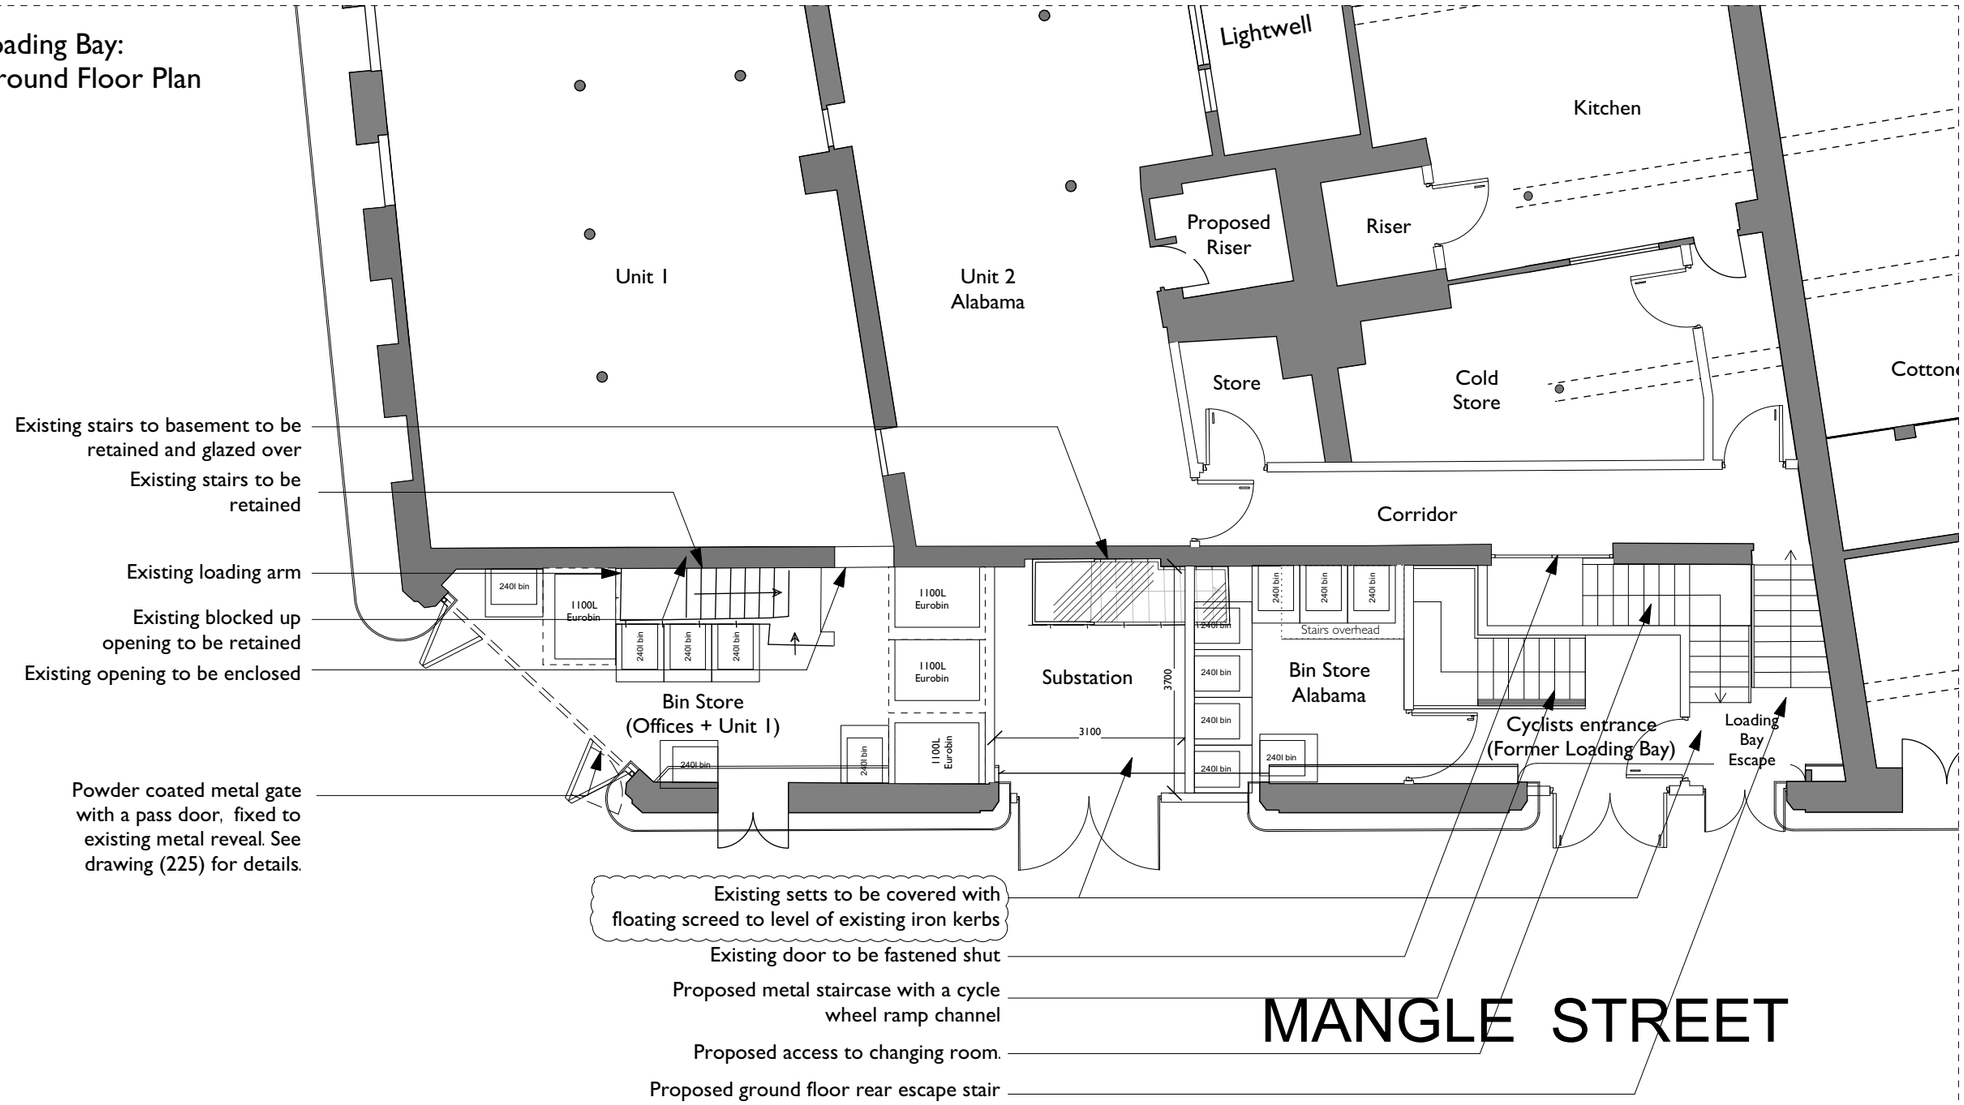

Loading Bay: Mezzanine Floor Plan

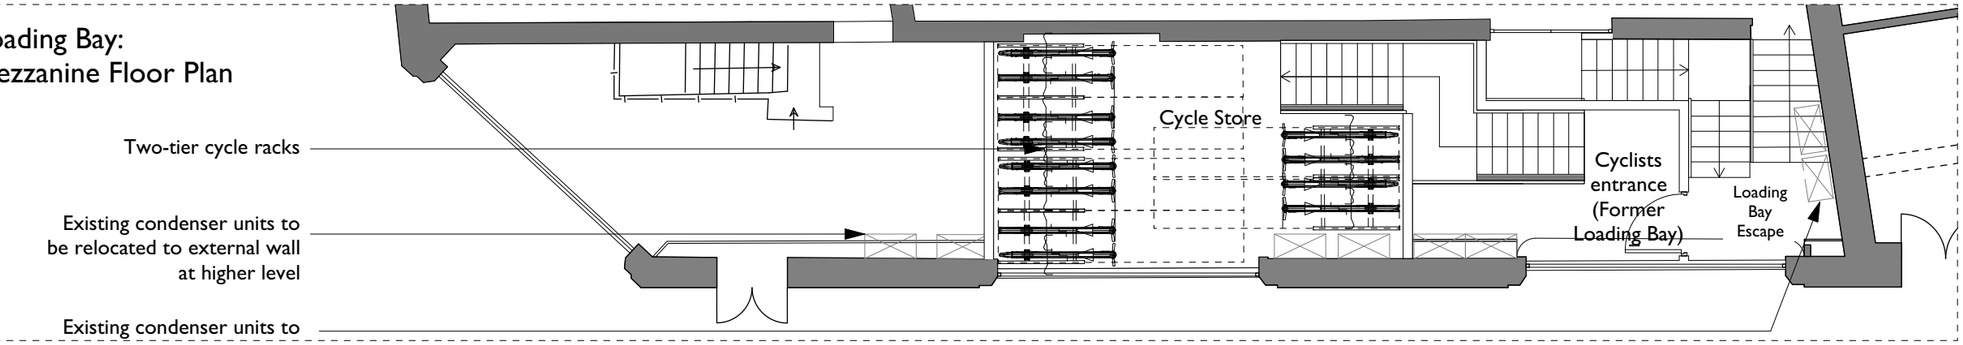

COPYRIGHT OF ATELIER MB LTD
DO NOT SCALE FROM THIS DRAWING
DIMENSIONS TO BE CHECKED ON SITE

All dimensions to be checked on site prior to any commencing work.

N

KEY

- Existing
- Downstand beams
- Extent of works
- Proposed

Rev	Note	DRN	CHK
H 10.10.18	Back of house for Alabama and Jimmy's revised. Loading bay escape staircase revised. Condenser units shown relocated.	ZS	AB
G 30.07.18	Back of house for Alabama and Jimmy's revised. Loading bay escape staircase revised. Condenser units shown relocated.	ZS	AB
F 11.05.18	Extent of floating screed in loading bay revised.	ZS	AB
E 23.11.17	Bin store and annotations revised.	ZS	AB
D 30.10.17	Drawing title revised. Substation shown and layout revised accordingly.	ZS	AB
C 27.09.17	Bin Store for Offices added; Annotations revised.	ZS	AB
B 25.09.17	Cycle store added; existing staircase to basement reinstated.	ZS	AB
A 14.09.17	Drawing amendments	RD	AB

8-16 Newton Street

Loading Bay Plan
Proposed

scheme 1665
drwg no. **P(125)**
rev H

scale **1:100@A3**
date first drawn Sep 17
drawn RD

***SK** sketch **P** proposed **T** tender **C** construction **AB** asbuilt*

www.ateliermb.co.uk
t 0161 236 0051
e architect@ateliermb.co.uk

Atelier MB
Urban Architects