

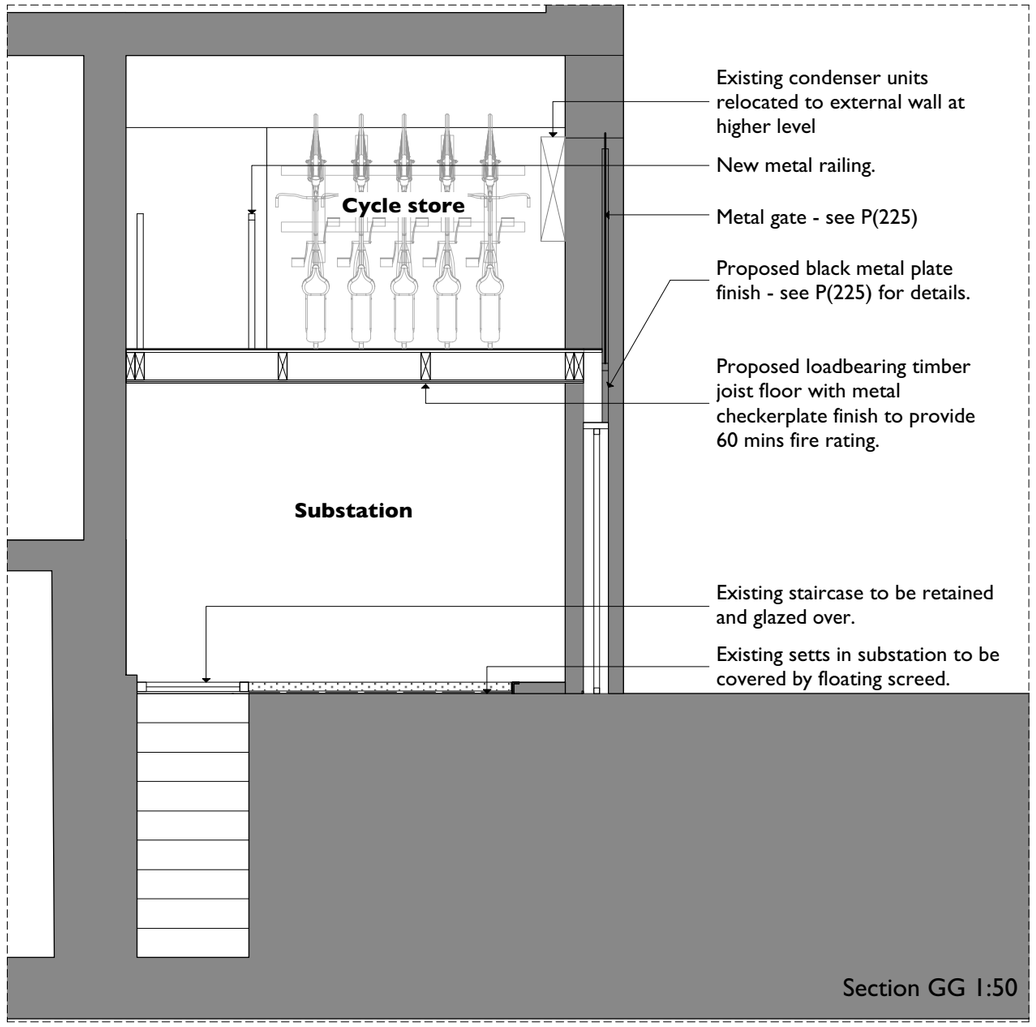


Section GG 1:50

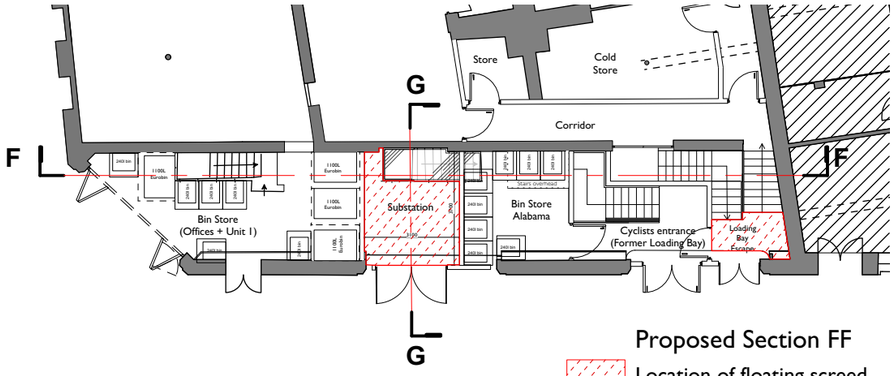


Proposed Section FF

Location of floating screed

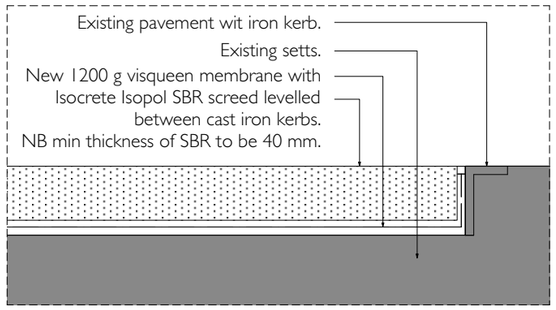

Typical floating screed detail 1:8

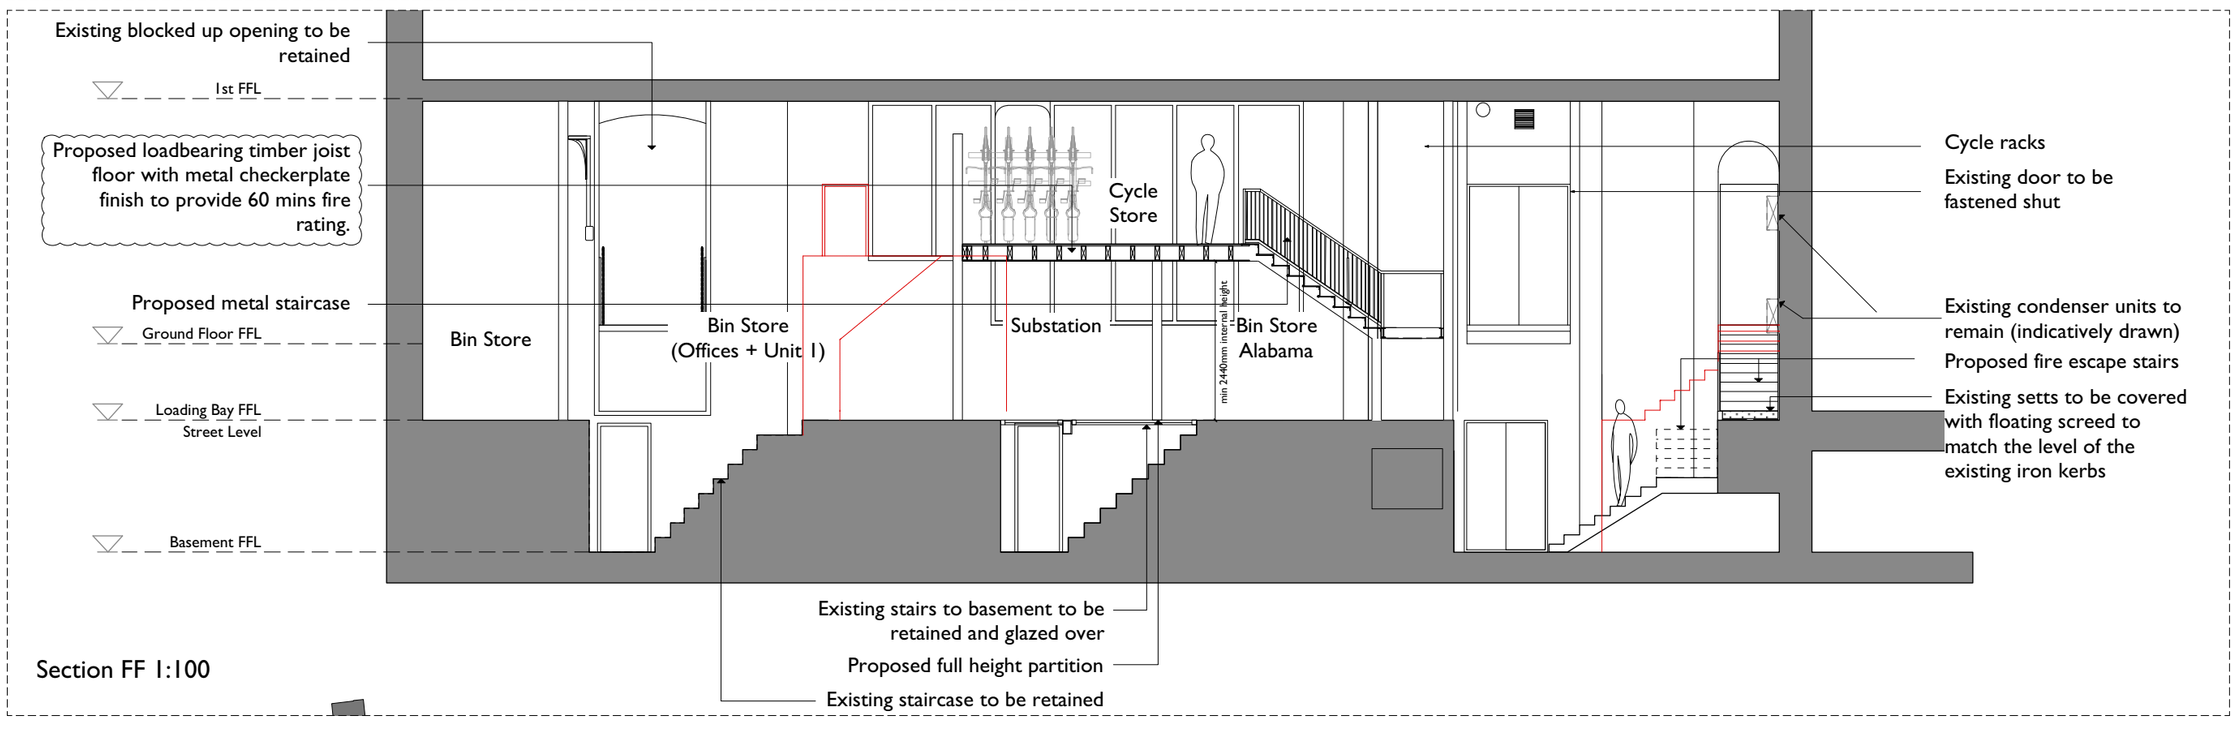

Section FF 1:100

COPYRIGHT OF ATELIER MB LTD
DO NOT SCALE FROM THIS DRAWING
DIMENSIONS TO BE CHECKED ON SITE

All dimensions to be checked on site prior to any commencing work.

Rev	Note	DRN	CHK
I 22.11.18	Ramp removed following Planner's comments.	ZS	AB
H 06.11.18	Screed ramp detail added.	ZS	ZS
G 10.10.18	Section revised to suit updated plan.	RD	ZS
F 30.07.18	Layout in loading bay revised. Floor details added.	ZS	AB
E 15.05.18	Extent of floating screed over cobbles in loading bay revised.	ZS	AB
D 23.11.17	Levels added. Layout revised as a substation added.	ZS	AB
C 27.09.17	Bin store modified.	ZS	AB
B 25.09.17	Cycle store added; existing staircase reinstated	ZS	AB
A 14.09.17	Revised drawing	RD	AB

8-16
Newton Street

Loading Bay Section
Proposed

scheme 1665
drwg no. **P(310)**
rev I

scale 1:100@A3
date first drawn Sep 17
drawn RD

SK sketch P proposed T tender C construction AB asbuilt

www.ateliermb.co.uk
t 0161 236 0051
e architect@ateliermb.co.uk

Atelier MB
Urban Architects