

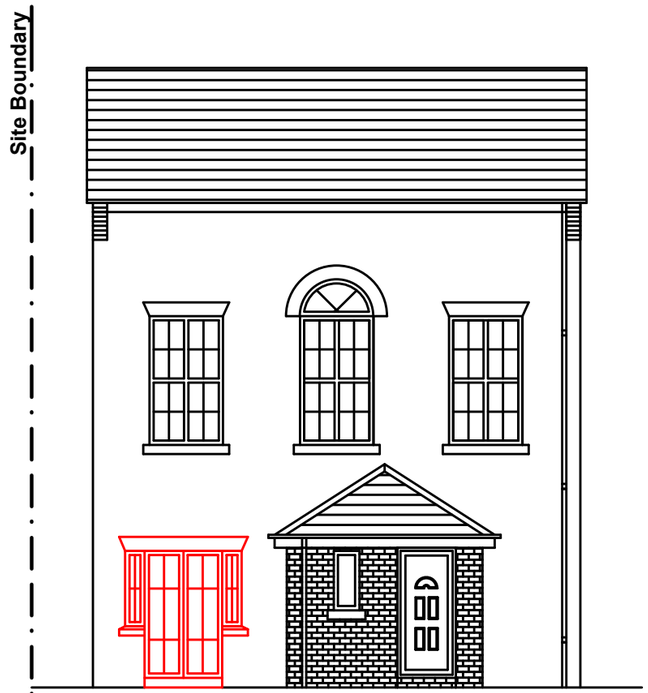



As-built Front Elevation

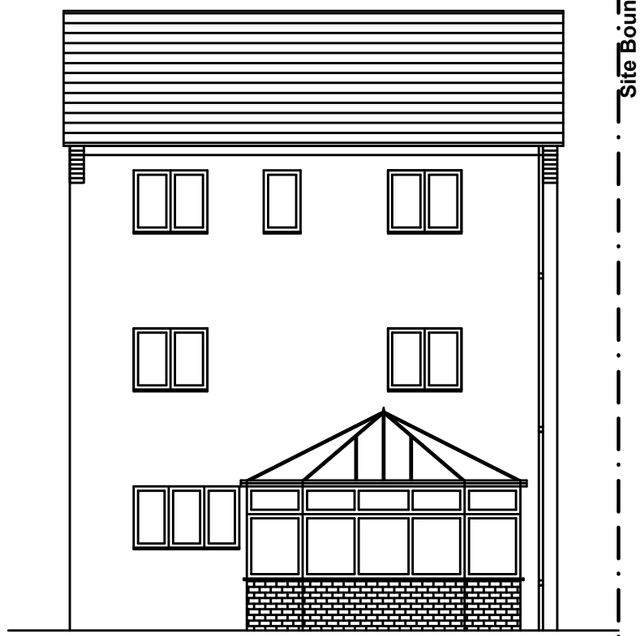

As-built Rear Elevation

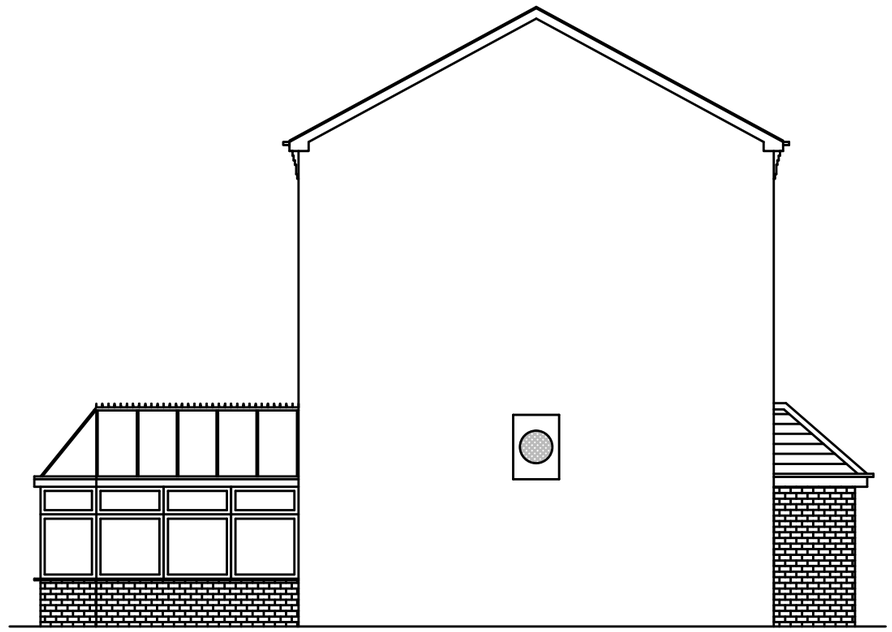

As-built Side Elevation

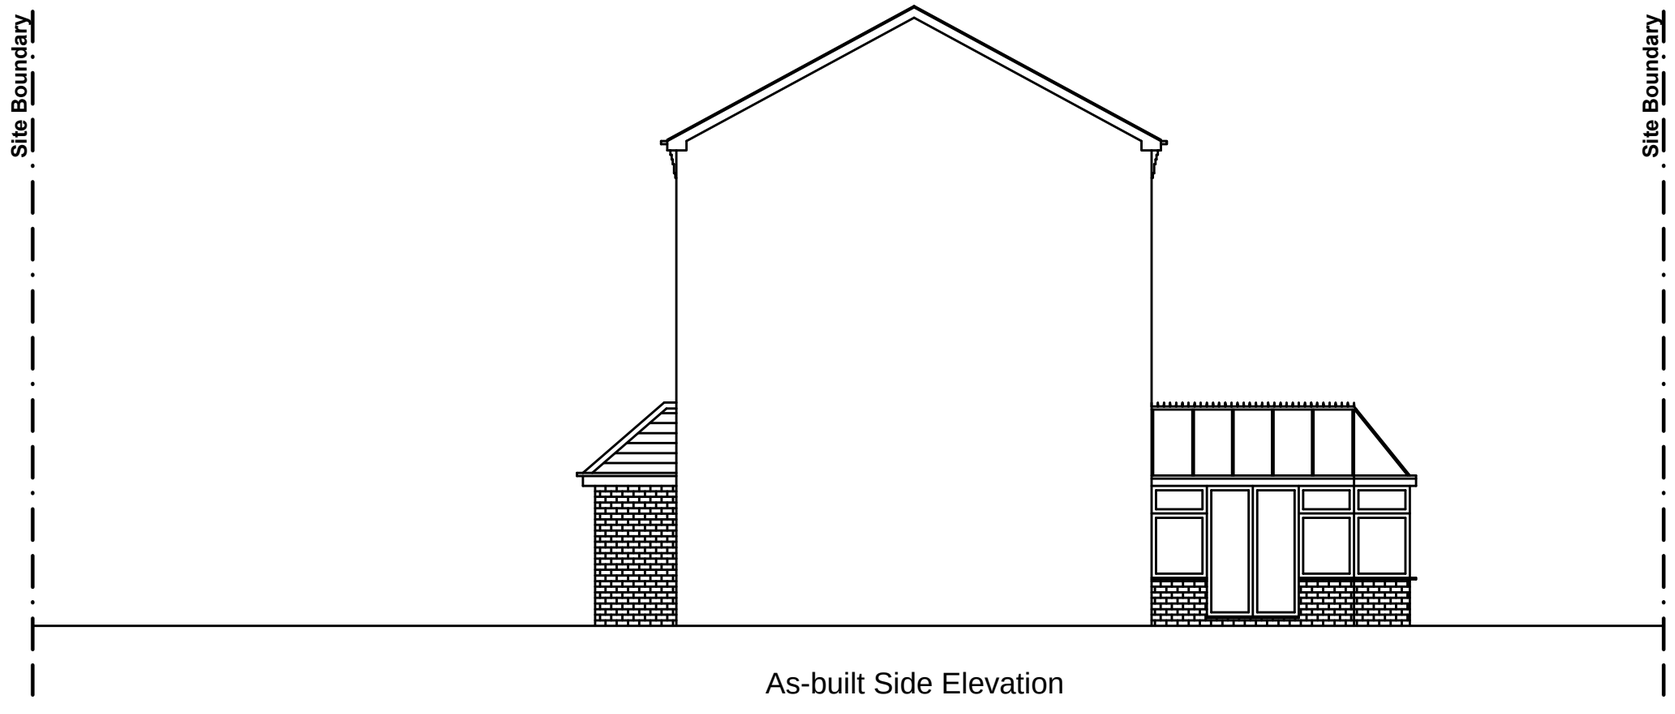

As-built Side Elevation

Mohammed Khan
BSc (Hons) MNAEA
Building Surveyor & Property Consultant
Ash 4 Homes, 5300 Lakeside, Cheadle Royal Business Park, Cheadle, SK8 3GP,
Tel: 0161 428 8652 Mobile: 07890 269580

Project Name:
Garage Conversion

Drawing Name:
As-Built Elevations

Project Address:
68 Chelsfield Grove,
Chorlton, Manchester,
M21 7BD

Project Ref: MK/071801

Date: 24.08.18

Scale: 1:100

Paper Size: A3

Sheet: 02

Rev: 0