

AS-INSTALLED FRONT ELEVATION

Scale 1:50

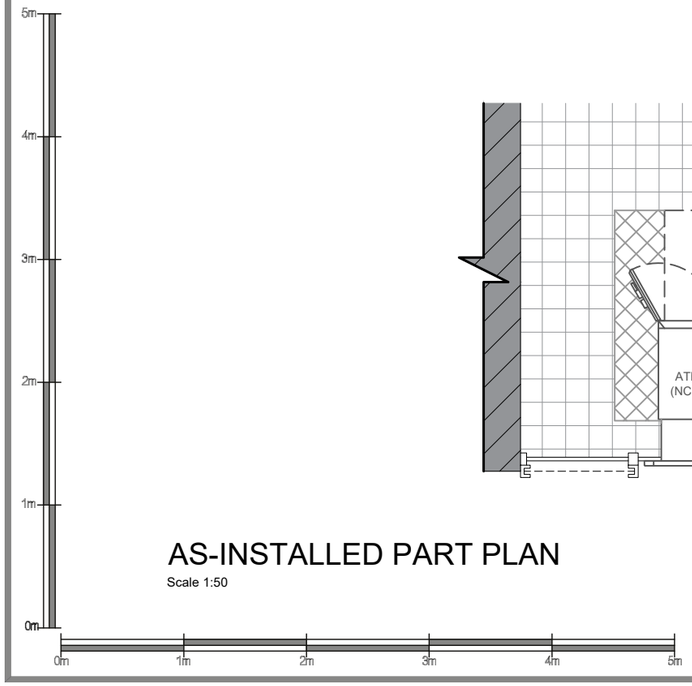

AS-INSTALLED PART PLAN

Scale 1:50

NM GROUP

Date:	Comments:	By:

GENERAL NOTES:

1) All dimensions in millimeters unless otherwise stated.

Site:
Abi Retail Ltd,
191-193 Hollyhedge Road,
Manchester

Drawing Title:

As-Installed Plan and Elevation

Ref:	Date: 29/10/2018	Rev:
Scale: 1:50	Paper: A3	Date Rev: