

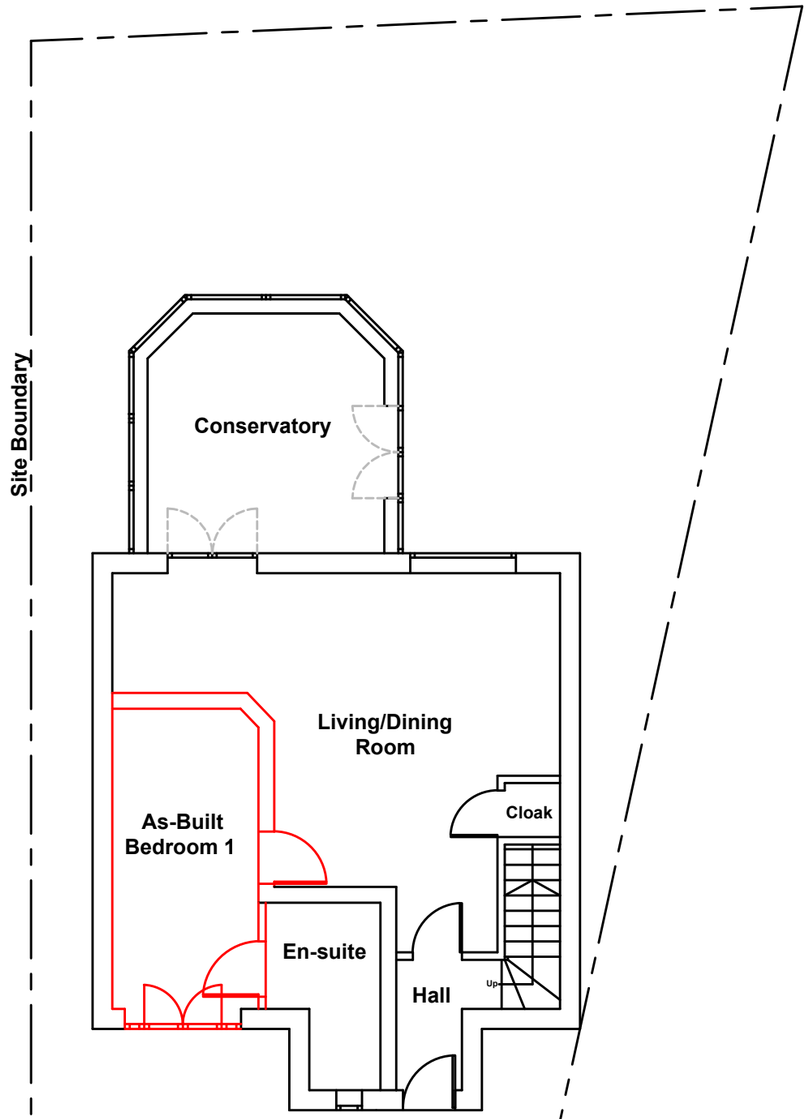


As-built Ground Floor Plan

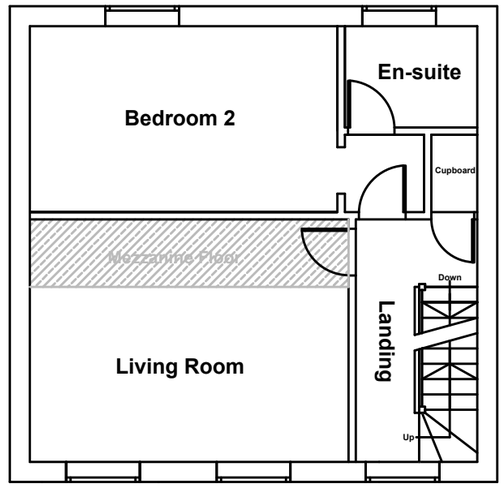

As-built First Floor Plan

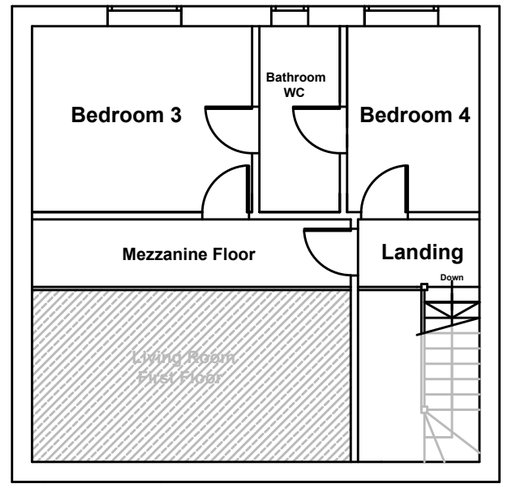

As-built Second Floor Plan

Mohammed Khan
BSc (Hons) MNAEA
Building Surveyor & Property Consultant
Ash 4 Homes, 5300 Lakeside, Cheadle Royal Business Park, Cheadle, SK8 3GP,
Tel: 0161 428 8652 Mobile: 07890 269580

Project Name:
Garage Conversion

Drawing Name:
As-Built Plans

Project Address:
68 Chelsfield Grove,
Chorlton, Manchester,
M21 7BD

Project Ref: MK/071801
Date: 24.08.18
Scale: 1:100
Paper Size: A3

Sheet: 01
Rev: 0