
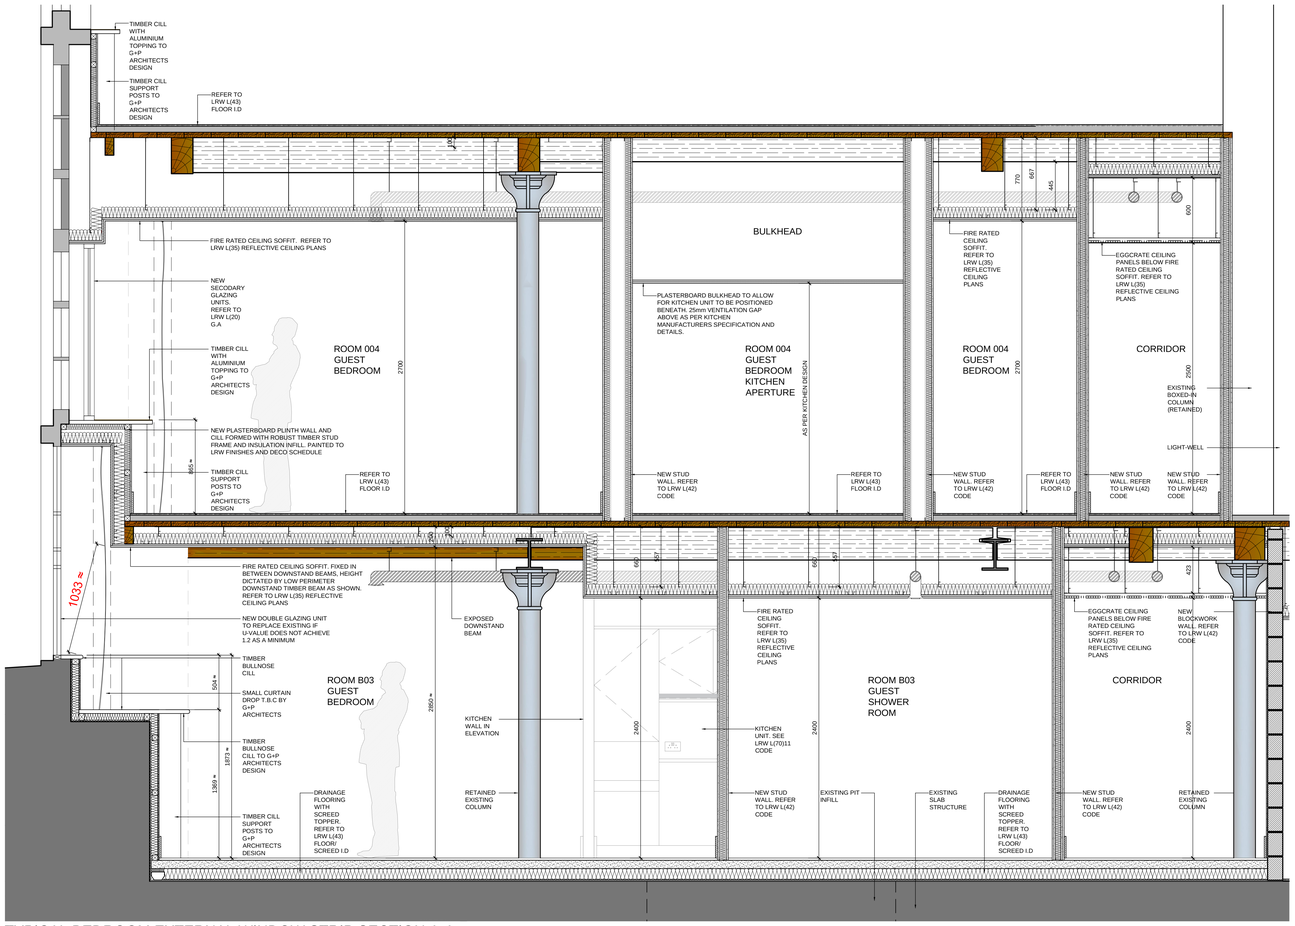



TYPICAL BEDROOM EXTERNAL WINDOW STRIP SECTION A-A

SCALE 1:20

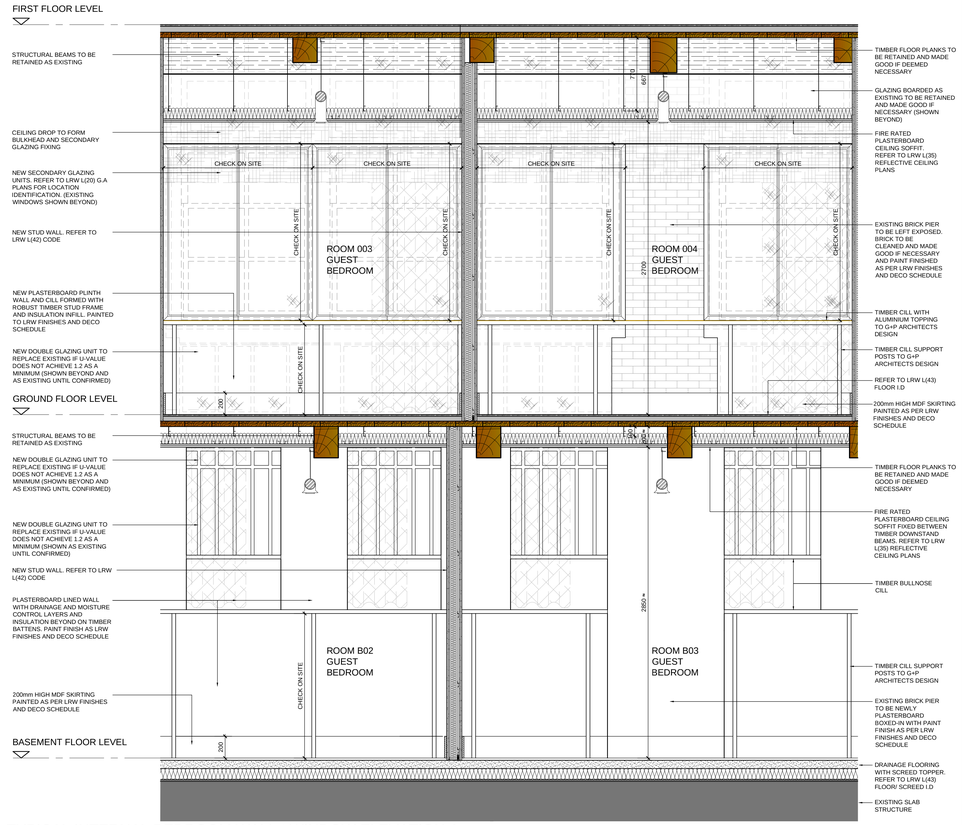


TYPICAL INTERNAL BEDROOM WALL / WINDOW ELEVATION A

SCALE 1:20

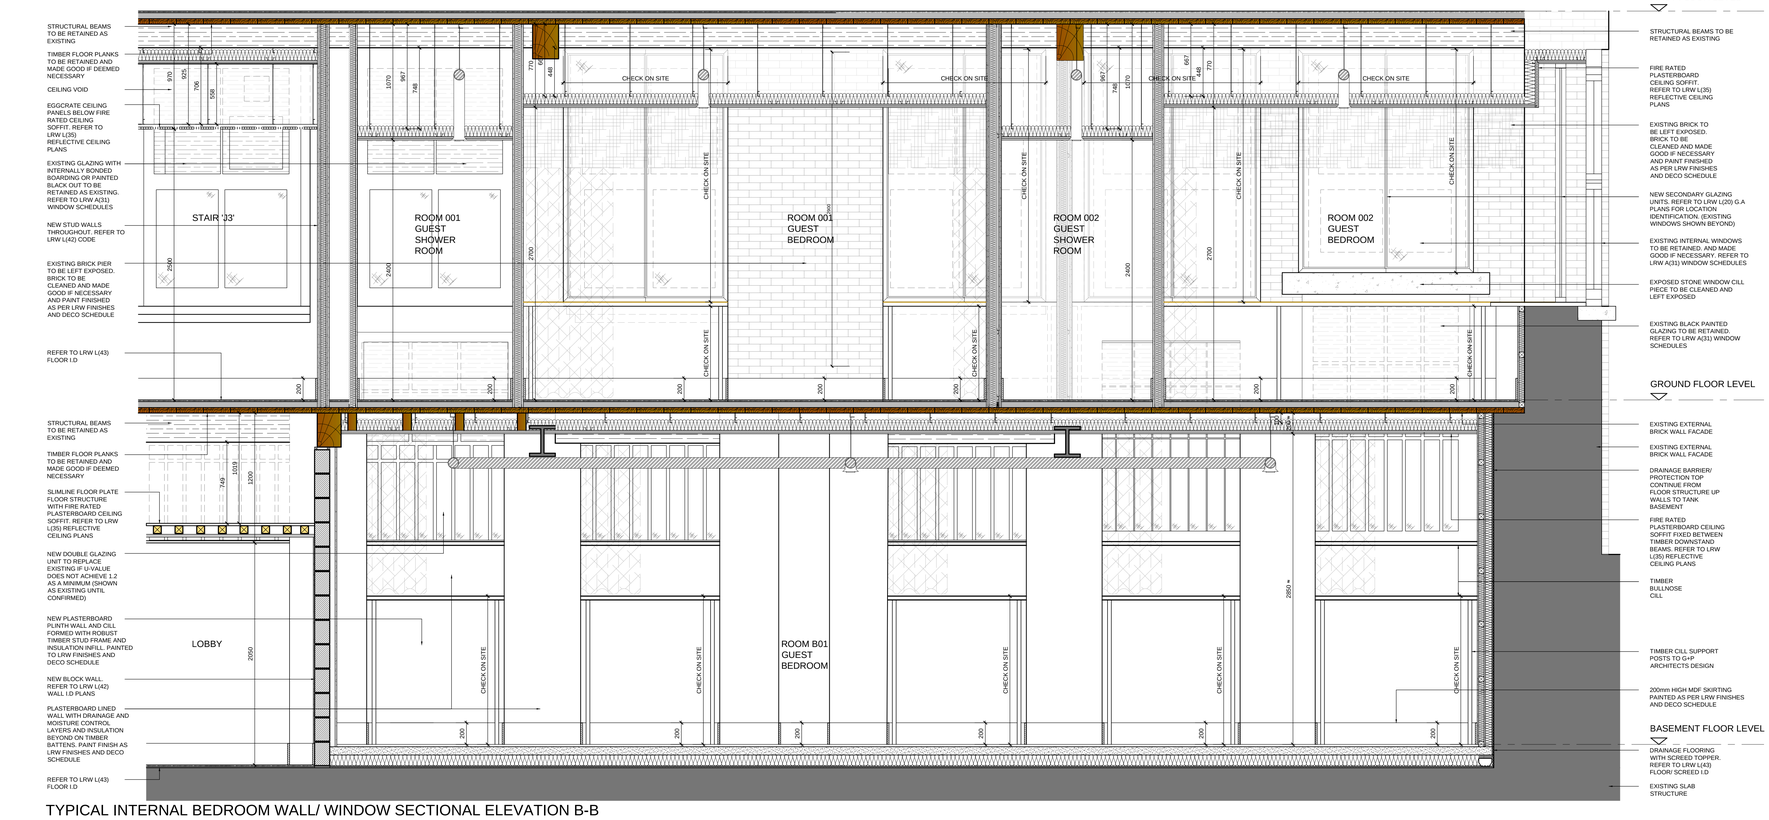

TYPICAL INTERNAL BEDROOM WALL/ WINDOW SECTIONAL ELEVATION B-B

SCALE 1:20

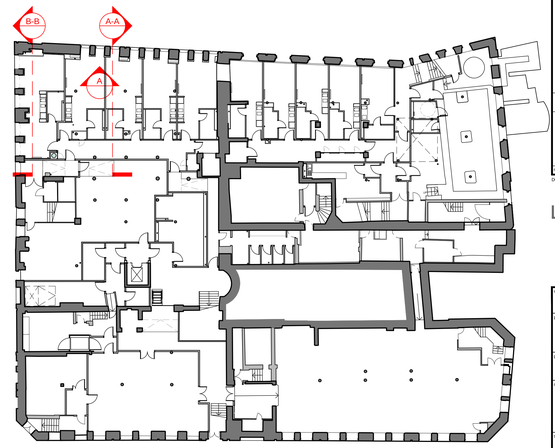

BASEMENT KEY PLAN N.T.S.

GENERAL NOTES:

ALL DIMENSIONS ARE TO BE CHECKED ON SITE WITH ANY DISCREPANCIES REPORTED TO THE ARCHITECT PRIOR TO THE WORKS BEING CARRIED OUT.

ALL WORKS ARE TO BE IN ACCORDANCE WITH THE PLANNING APPROVAL AND ANY SUBSEQUENT APPROVED LOCAL AUTHORITY PLANNING CORRESPONDENCE INCLUDING DRAWINGS, DOCUMENTS AND REPORTS.

ALL WORKS ARE TO COMPLY WITH THE BUILDING REGULATIONS, BRITISH STANDARDS, CODE OF PRACTICE, AND ANY LOCAL STATUTORY REQUIREMENTS.

ALL WORKS ARE TO COMPLY WITH CURRENT HEALTH AND SAFETY LEGISLATION, H.S.E. RECOMMENDATIONS/GUIDANCE AND THE CURRENT C.D.M. REGULATIONS.

THIS DRAWING IS TO BE READ IN CONJUNCTION WITH LEACH RHODES WALKER ARCHITECTS GENERAL ARRANGEMENT (L CODE) DRAWINGS, TOGETHER WITH RELEVANT DETAILED (A CODE) DRAWINGS AND SPECIFICATIONS.

FOR ALL STRUCTURAL WORKS REFER TO THE STRUCTURAL ENGINEERS INFORMATION.

FOR ALL MECHANICAL AND ELECTRICAL WORKS REFER TO THE MECHANICAL AND ELECTRICAL ENGINEERS INFORMATION.

FOR ALL ABOVE GROUND DRAINAGE WORKS REFER TO THE PUBLIC HEALTH ENGINEERS INFORMATION.

ALL PRODUCTS SPECIFIED ARE TO BE INSTALLED STRICTLY IN ACCORDANCE WITH THE MANUFACTURERS RECOMMENDATIONS, SPECIFICATION AND DETAILS.

THIS DRAWING IS TO BE READ IN CONJUNCTION WITH THE FOLLOWING:

- L(20) CODE GA PLANS
- L(20) CODE DEMOLITION PLANS
- L(35) CODE CEILING PLANS
- L(42) CODE WALL ID PLANS
- L(43) CODE FLOOR FINISHES
- L(43) CODE SCREED I.D PLAN
- S(40)01 CODE FINISHES AND DECO SCHEDULE
- A(31) CODE WINDOW SCHEDULE
- B.V FIRE CONSULTANT REPORT
- STRUCTURAL ENGINEER (MHA) DRAWINGS AND SPECIFICATIONS

rev	description	drwn	auth	date
B	ISSUED FOR PLANNING. UPDATED TO SUIT LATEST DESIGN INTENT	DG	RW	18.02.18
A	AMENDED TO INCLUDE CORRECT COLUMN CAPITALS, CURTAIN & PELMET FABRIC AND INDICATIVELY DEMONSTRATE POSSIBLE RAISED CEILING DESIGN FOR GROUND FLOOR AS BASEMENT CONCEPT (SHOWN IN RED)	DG	RW	18.01.18

DO NOT SCALE OFF THIS DRAWING

© LEACH RHODES WALKER 2001

LeachRhodesWalker Architects

info@lrw.co.uk | www.lrw.co.uk
50 Dearmans Place Manchester M3 5LH

Manchester +44 (0)161 833 0211 | London +44 (0)207 201 2160 | Bucharest +40 (21)650 4026

client: SACO

project: THE ATRIUM MANCHESTER

project no	drawing no	rev
7664	A(80)05	B

description: JOHNSON BASEMENT & GROUND BEDROOMS TYP SECTION PROPOSALS

scale	date drawn	drawn by	authorised by
VARIES@ A0	15.01.18	DG	RMW

file: I:\lr\Archive\projects\7664\A\80\Elements\architect\section*.pln/dwg

purpose of issue: planning ● | building regs ○ | tender ○ | comment ○ | approval ○ | construction ○