
notes

1. DO NOT SCALE FROM THIS DRAWING - USE FIGURED DIMENSIONS ONLY.
2. TO BE READ IN CONJUNCTION WITH ALL OTHER CONSULTANTS / SPECIALISTS DRAWINGS. REPORT ANY DISCREPANCIES BEFORE AFFECTED WORK COMMENCES.
3. ALL SETTING OUT DIMENSIONS TO BE CHECKED ON SITE BY CONTRACTOR BEFORE WORK COMMENCES.


TENDER



Little John Street Existing Elevation1
1 : 100

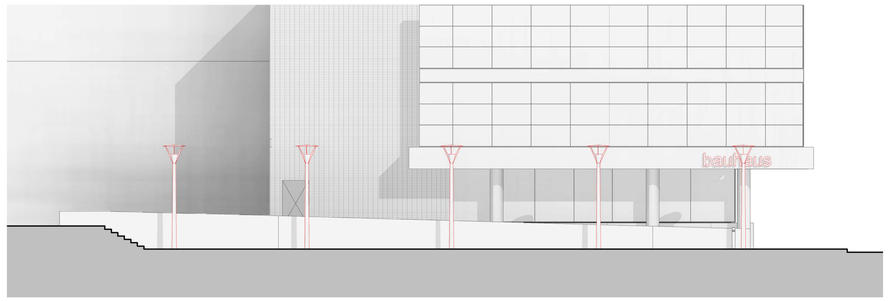

Little John Street Proposed Elevation1

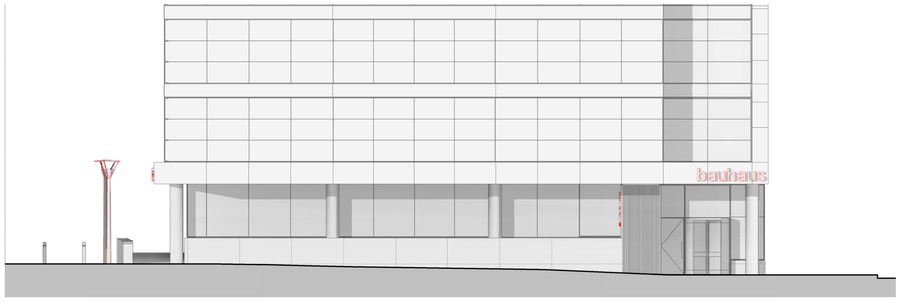

Quay Street Existing Elevation




Quay Street Proposed Elevation
1 : 100


Enhancement to low level retaining wall - Green Wall, Timber metal cladding

Additional Screening through use of box planting sitting across stone plinth between columns

New Timber Screen to provide privacy and screening to Proposed social space

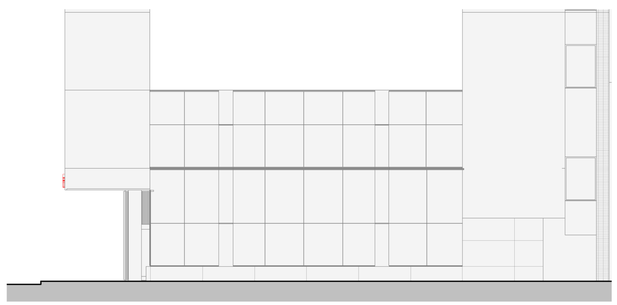

Atherton Street Existing Elevation
1 : 100

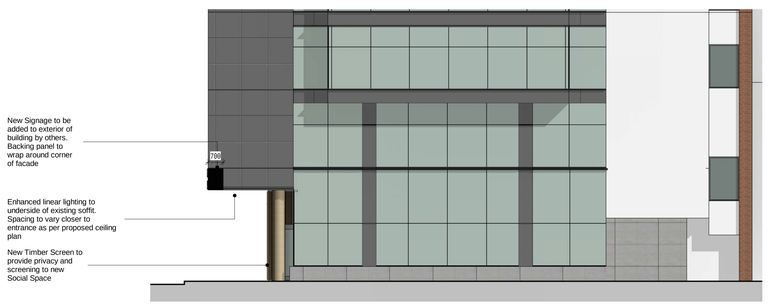

Atherton Street Proposed Elevation
1 : 100

Areas outlined in blue boundary to be refurbished as new

Areas with red line boundary indicate elements to be demolished / removed and replaced with new feature

Demolitions Key

0 2m 5m
1:50

revisions | date: | issue by: | check

A Updates made to existing facade elevations to reflect existing Autocad Drawings 21.02.218 OT SK

client: Orchard Street investment Management LLP

project: Bauhaus

drawing title: Existing and Proposed Elevations

drawing number: **017109_T - 103**

revision: A

drawing status: Tender

scale: 1 : 100 @ A0

date: 10/07/2017

drawn by: OT

checked by: LM

seven architecture

seven architecture offices at:
61 Oxford Street, **MANCHESTER,** M1 6EQ
t: 0161 236 5655
Clarendon House, Victoria Avenue, **HARROGATE,** North Yorks, HG1 1DY
t: 01423 709 807
24 Greville Street, **LONDON**, EC1N 8SS
t: 0203 036 0693
Galeri 6, Doc Victoria, **CAERNARFON,** Gwynedd, LL55 1SQ
t: 01286 685 253

www.sevenarchitecture.co.uk