
notes

1. DO NOT SCALE FROM THIS DRAWING - USE FIGURED DIMENSIONS ONLY.
2. TO BE READ IN CONJUNCTION WITH ALL OTHER CONSULTANTS / SPECIALISTS DRAWINGS. REPORT ANY DISCREPANCIES BEFORE AFFECTED WORK COMMENCES.
3. ALL SETTING OUT DIMENSIONS TO BE CHECKED ON SITE BY CONTRACTOR BEFORE WORK COMMENCES.

TENDER



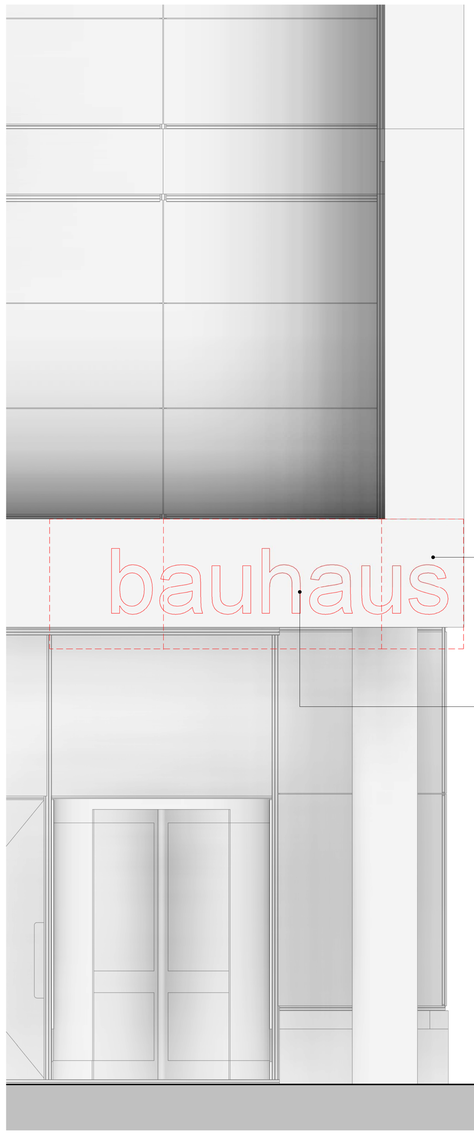

Existing signage to removed from all frontage and replaced with proposed signage by others

Signage panel to repaced once signage has been removed



Black powder coated aluminium frame attached to underside of existing soffit

Additional screening through use of box planting sitting across stone plinth between columns

Black powder coated aluminium frame to provide rigid bracing To timber louvres

Oak treated timber lovre at varying depths and centres to match existing timber surround, providing screen and privacy to new social space

Black powder coated aluminium frame attached to existing stone plinth



Enhanced lighting to underside of existing soffit. Lighting to be agreed by others

Areas outlined in blue boundary to be refurbished as new

Areas with red line boundary indicate elements to be demolished / removed and replaced with new feature

Demolitions Key 1 - 20

Quay Street Detail Elevation Copy 1
1 : 20

Quay Street Detail Elevation

0 0.5m 1m
1:20

revisions		date; issue by; check
A	Updates made to existing facade elevations to reflect existing Autocad Drawings	21.02.218 OT SK

client: Orchard Street investment Management LLP

project: Bauhaus

drawing title: Detailed Elevations Quay Street

drawing number: **017109_T - 105**

revision: A

drawing status: Tender

scale: 1 : 20 @ A0

date: 06/21/17

drawn by: OT

checked by: LM

seven architecture

seven architecture offices at:
61 Oxford Street, **MANCHESTER,** M1 6EQ
t.: 0161 236 5605
Clarendon House, Victoria Avenue, **HARROGATE,** North Yorks, HG1 1DY
t.: 01423 709 807
24 Greville Street, **LONDON**, EC1N 8SS
t.: 0203 096 0691
Galeri 6, Doc Victoria, **CAERNARFON,** Gwynedd, LL55 1SQ
t: 01286 685 253
www.sevenarchitecture.co.uk