



FRONT ELEVATION

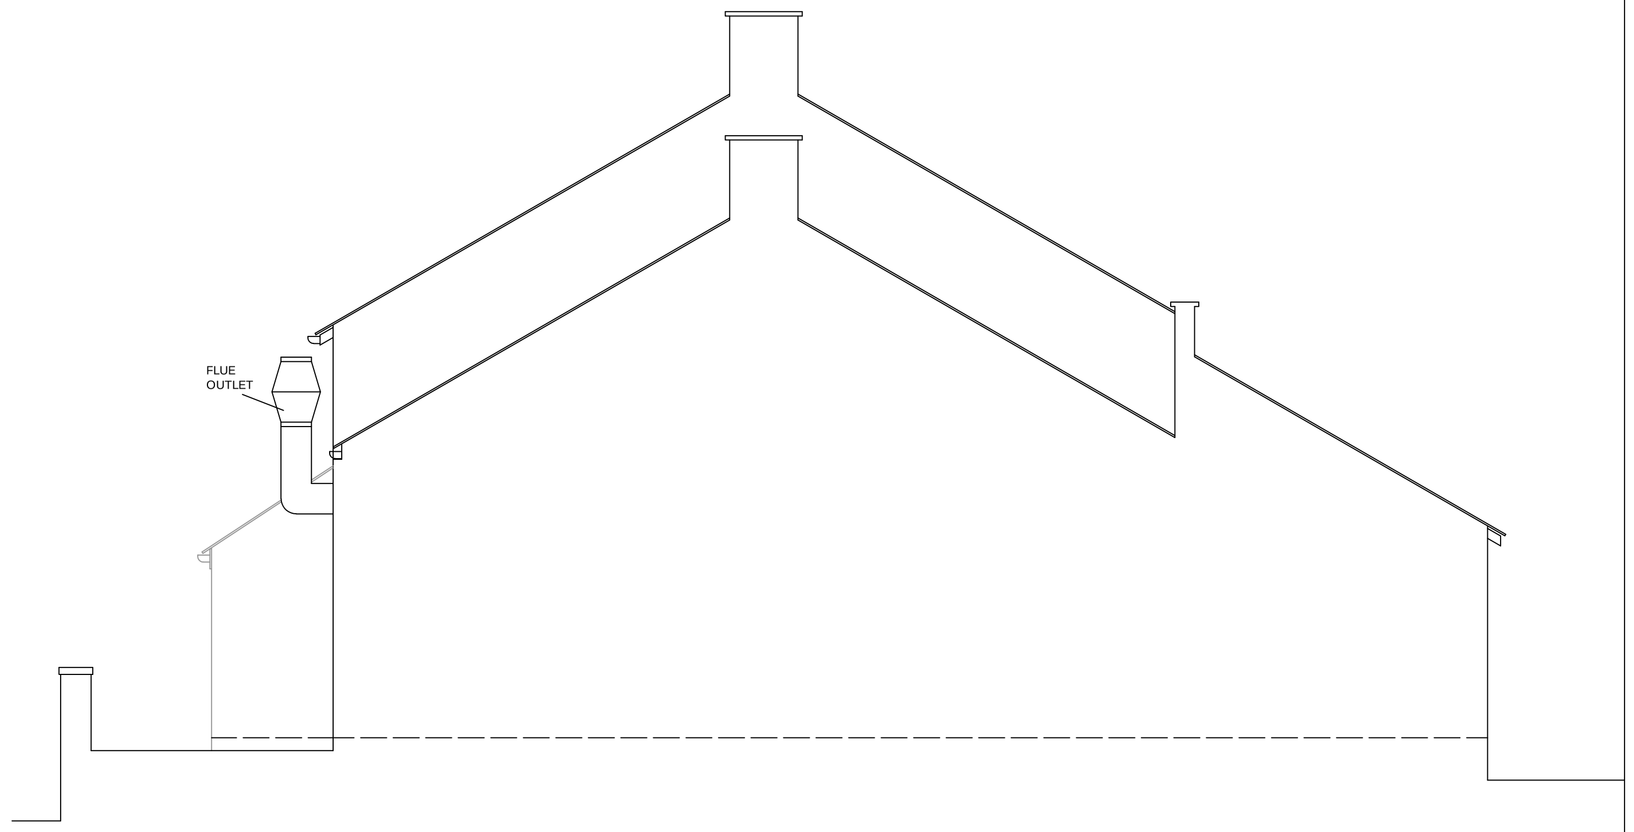

REAR ELEVATION

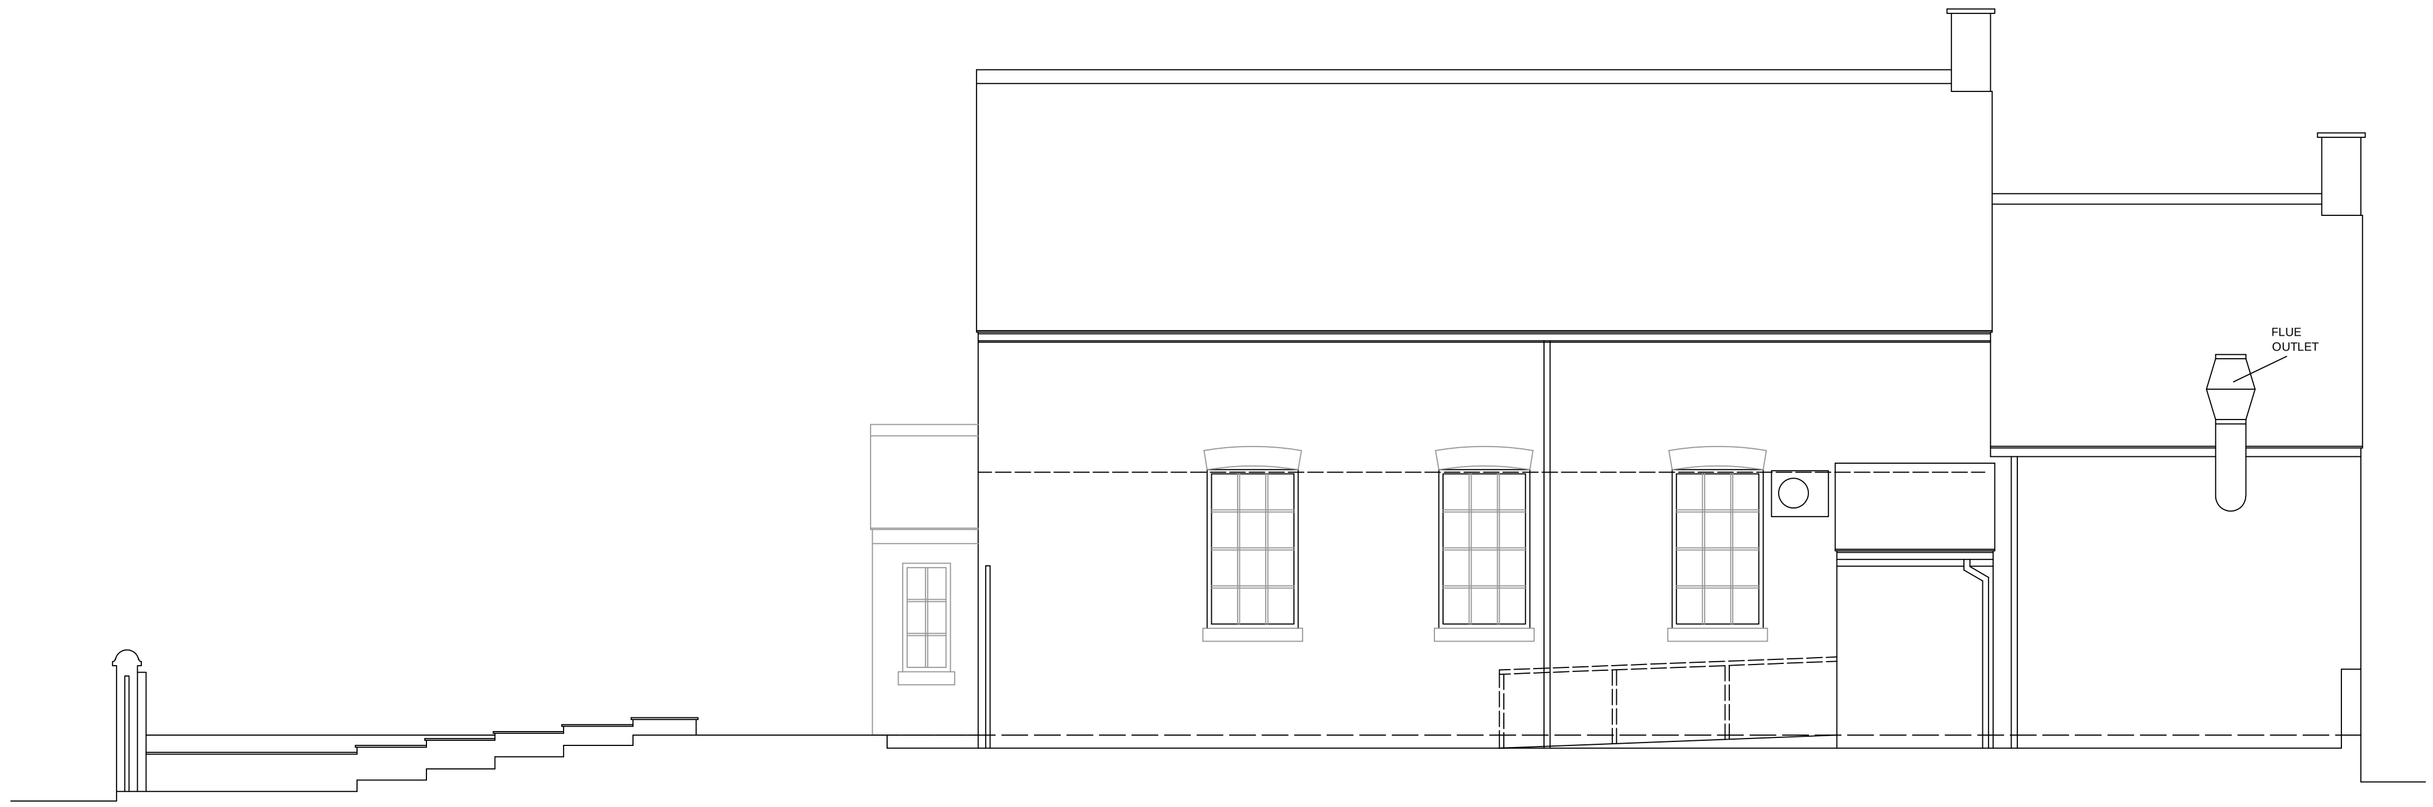

SIDE ELEVATION

Rev.B. Revised flue outet. 25.08.17
Rev.A. General revision. 27.06.17

CLIENT	MR J. PERRY
PROJECT	REGULARISATION OF FLUE OUTLET & BIN STORE
ADDRESS	ZITANO 133 BEECH ROAD CHORLTON, MANCHESTER
TITLE	AS BUILT ELEVATIONS
DRAWING NO.	1357/ 6
REVISION SUFFIX:	B
SCALE	1 : 50
DATE	26.06.17

knightpyatt
architectural services
chartered surveyors

Tel: 01625 614447
Email: andy@knightpyatt.co.uk
Website: www.knightpyatt.co.uk

24 Landseer Drive,
Macclesfield, Cheshire.
SK10 3RU

A1