
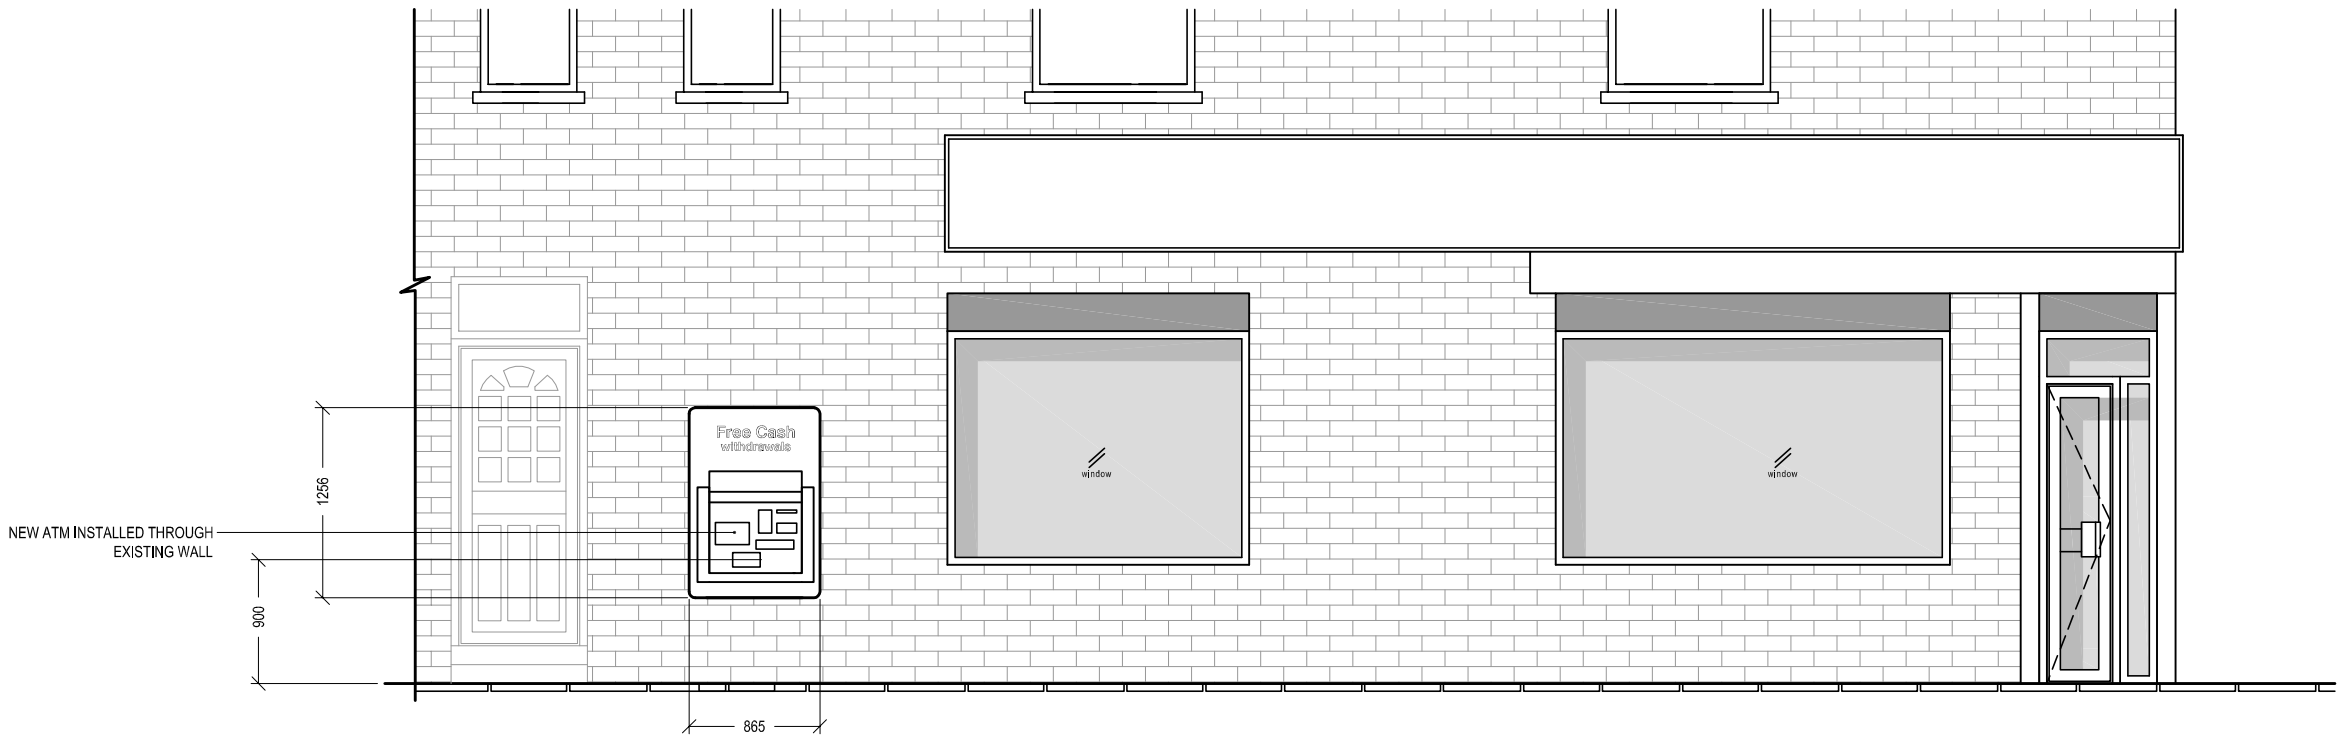


AS INSTALLED FRONT ELEVATION
Scale 1:50

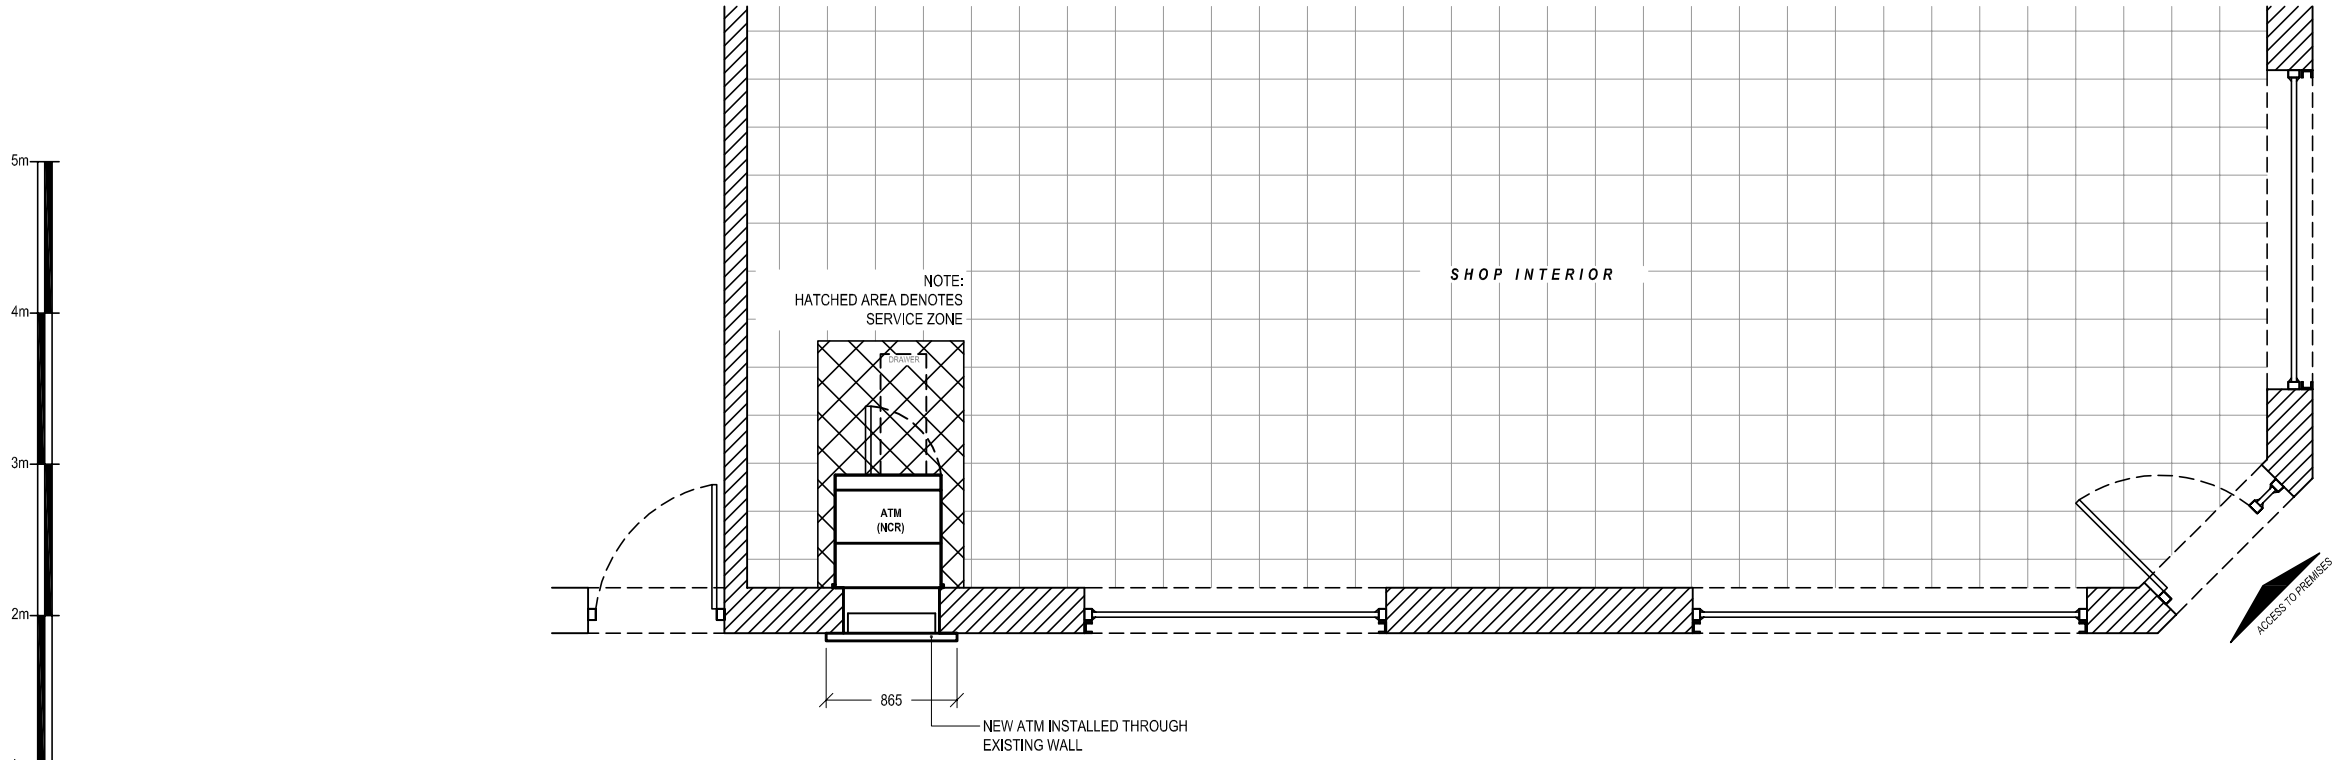

AS INSTALLED PART PLAN
Scale 1:50

NOTE MACHINE

Date:	Comments:	By:

GENERAL NOTES:

1) All dimensions in millimeters unless otherwise stated.

Site:
SHA SUPERSTORE
357-359
[redacted] Claremont Road,
Manchester,
M14 7NB

Drawing Title:
As Installed Elevation and Plan

Ref:	Date:	Rev:
NM-03-2016-69-2	19-03-2016	
Scale: 1:50	Paper: A3	Date Rev: