
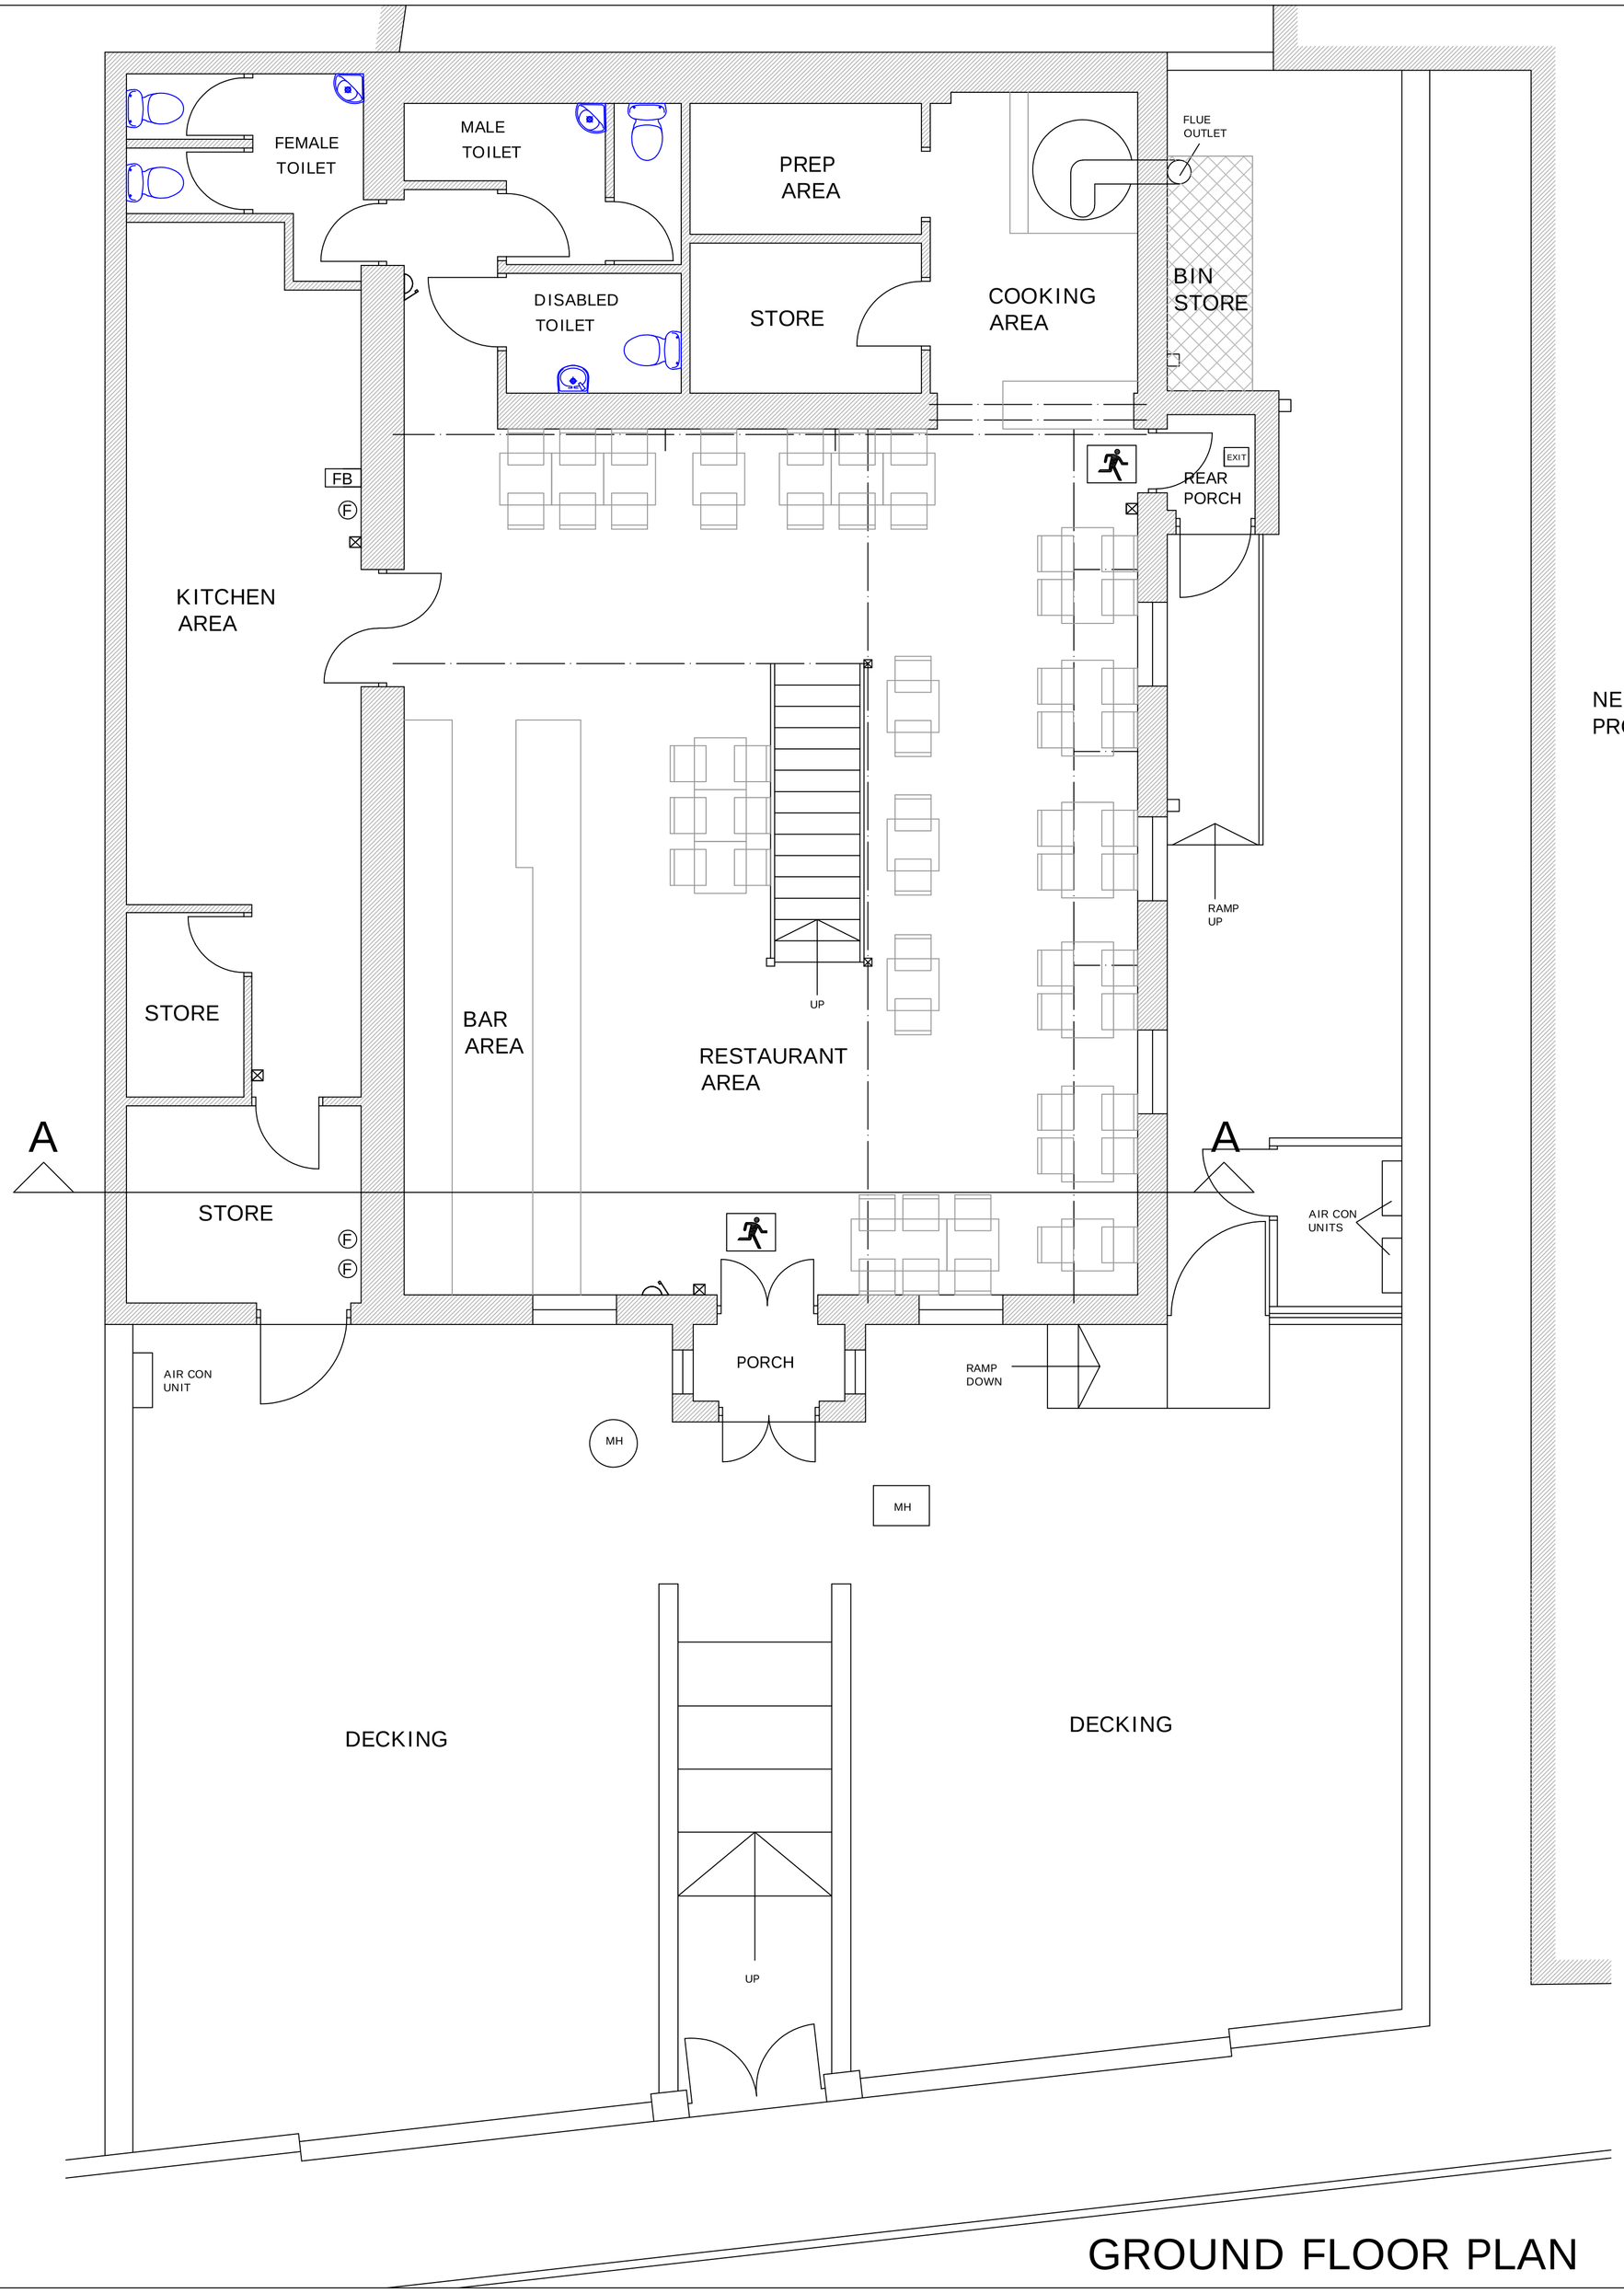


GROUND FLOOR PLAN

NEIGHBOURING PROPERTY

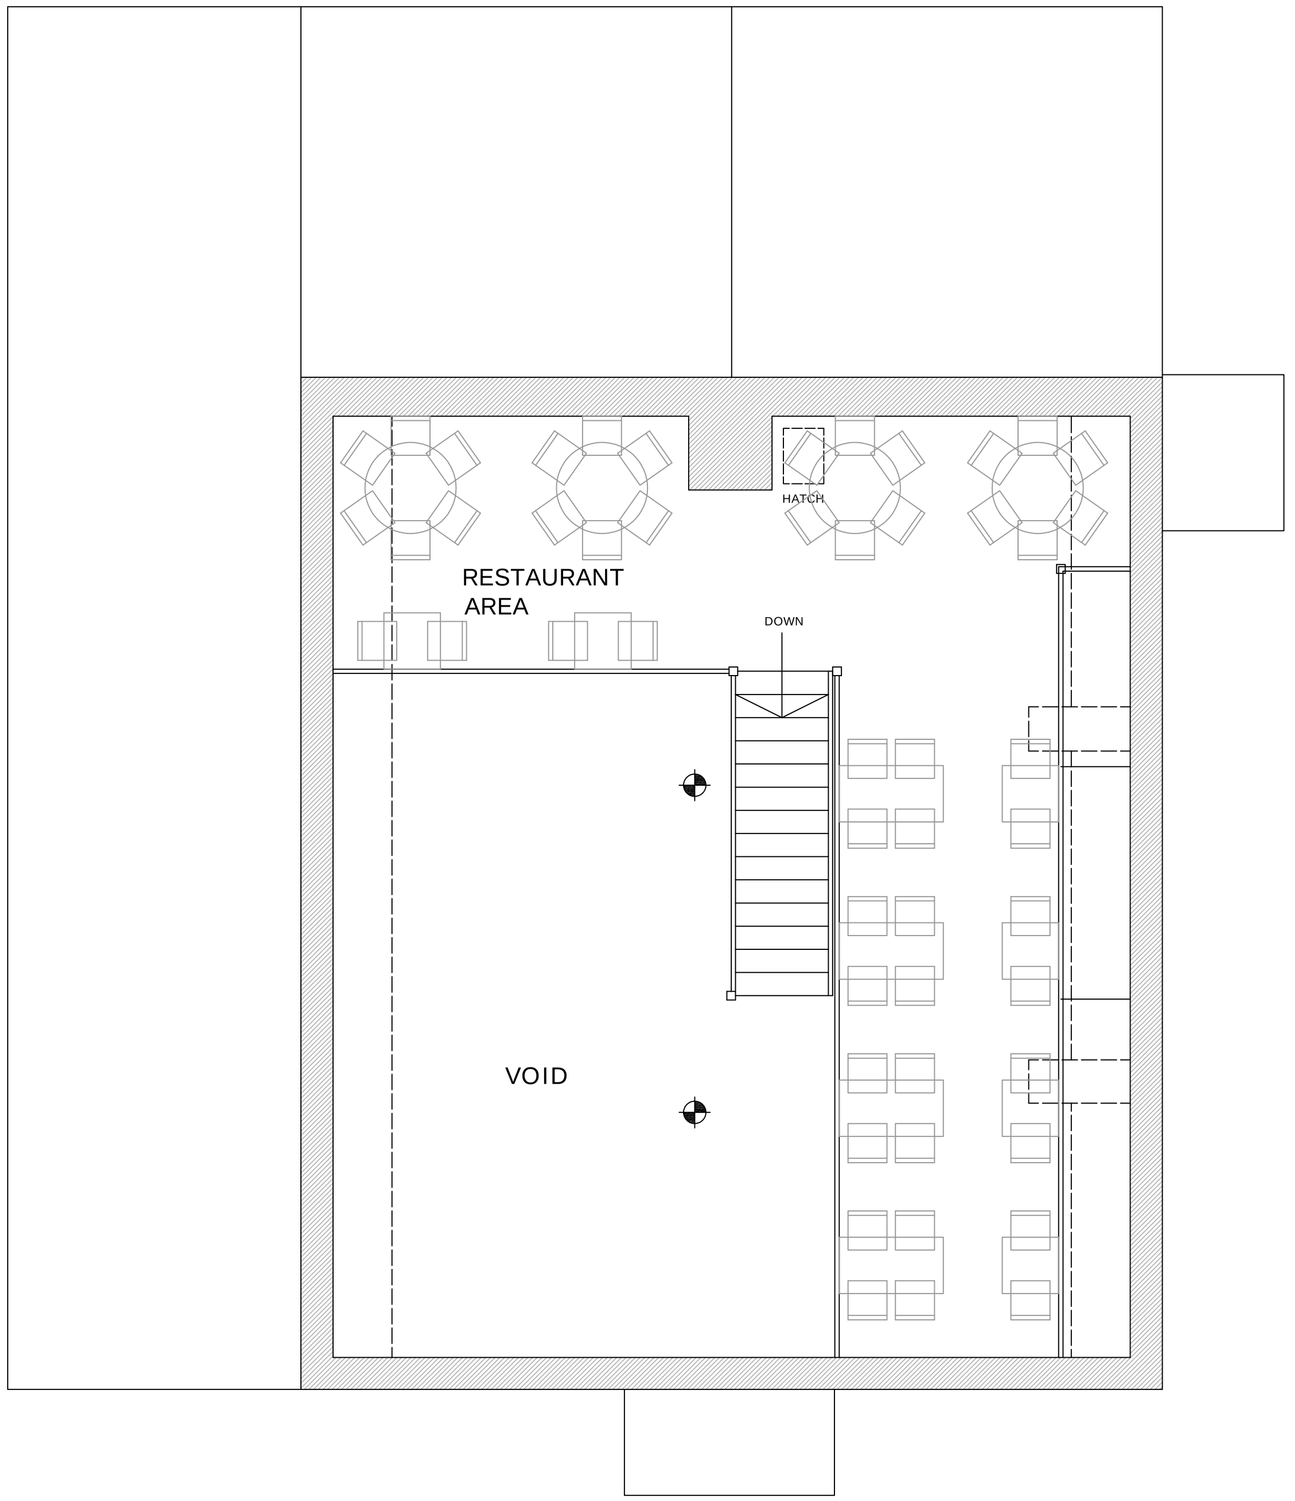

MEZANINE FLOOR PLAN

KEY

- BREAK GLASS POINT
- FIRE ALARM SOUNDER
- FIRE EXTINGUISHER
- SMOKE / HEAT DETECTOR
- FB — FIRE BLANKET
- ILLUMINATED EMERGENCY EXIT SIGN
- EXIT — EMERGENCY EXIT SIGN

Rev.A. General revision. 27.06.17

CLIENT	MR J. PERRY		
PROJECT	REGULARISATION OF FLUE OUTLET & BIN STORE		
ADDRESS	ZITANO 133 BEECH ROAD CHORLTON, MANCHESTER		
TITLE	AS BUILT FLOOR PLANS		
DRAWING NO.	1357/ 5	REVISION SUFFIX:	A
SCALE	1 : 50	DATE	26.06.17

knightpyatt
architectural services
chartered surveyors

Tel: 01625 614447
Email: andy@knightpyatt.co.uk
Website: www.knightpyatt.co.uk

24 Landseer Drive,
Macclesfield, Cheshire.
SK10 3RU

A1