
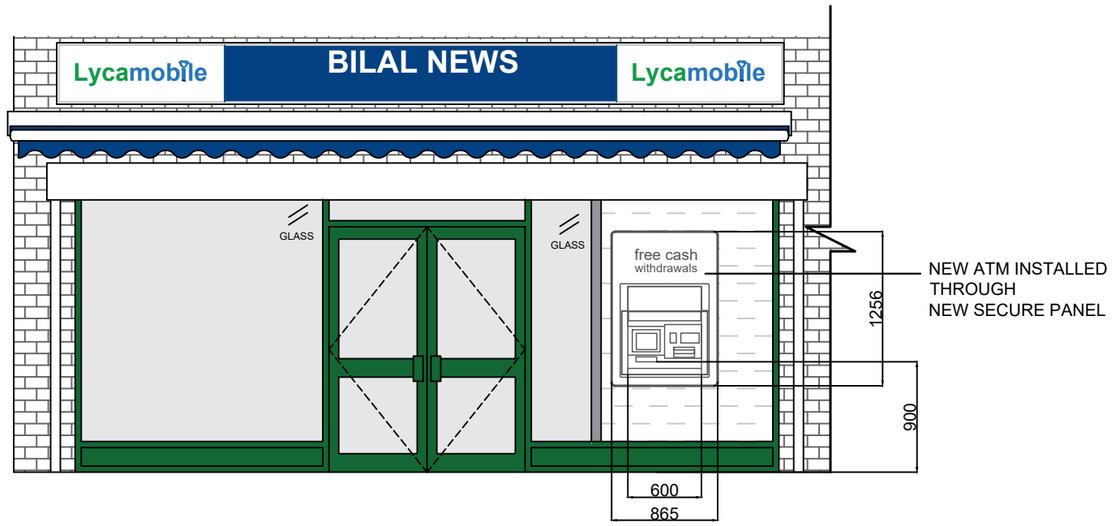



AS INSTALLED FRONT ELEVATION

Scale 1:50

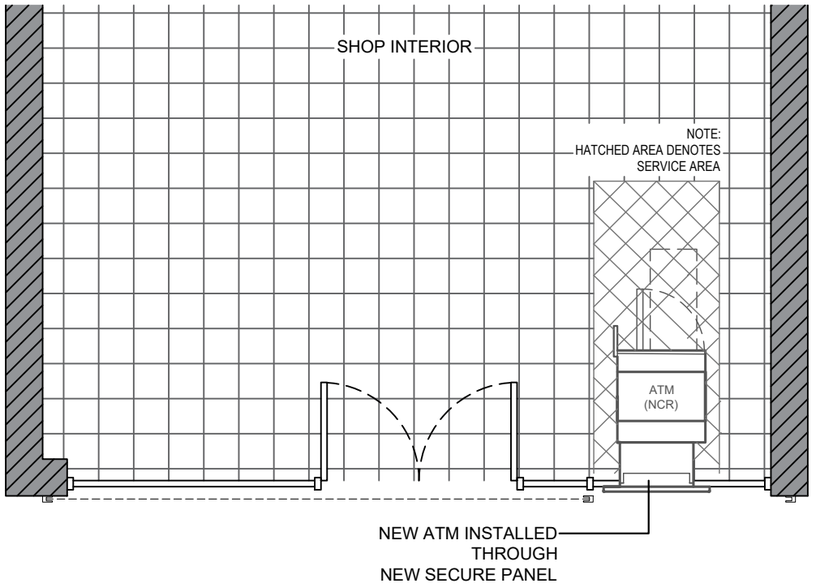

AS INSTALLED PART PLAN

Scale 1:50

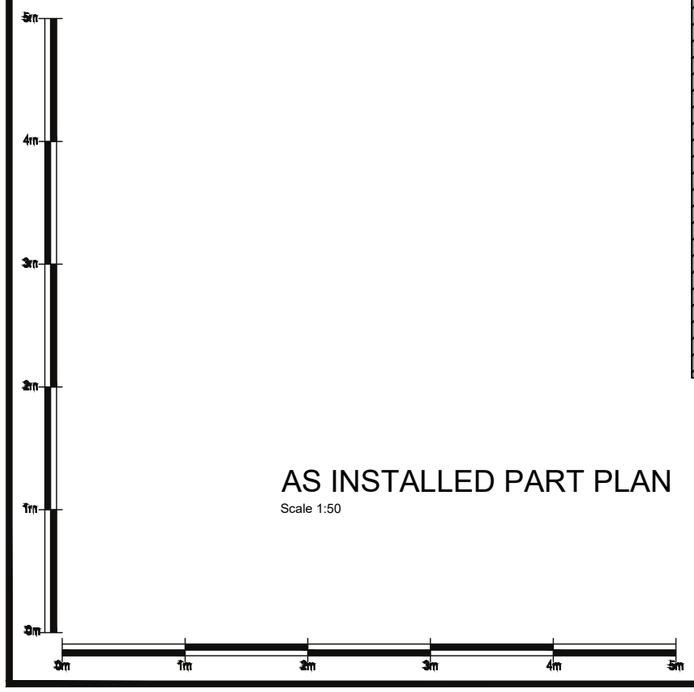

NOTE MACHINE

Date:	Comments:	By:

GENERAL NOTES:

1) All dimensions in millimeters unless otherwise stated.

Site:
Market News
393 Dickenson Road
Manchester
M13 0WG

Drawing Title:
As Installed Plan and Elevation

Ref:	Date: 04/09/2017	Rev:
Scale: 1:50	Paper: A3	Date Rev: