




Section AA - scale 1:200

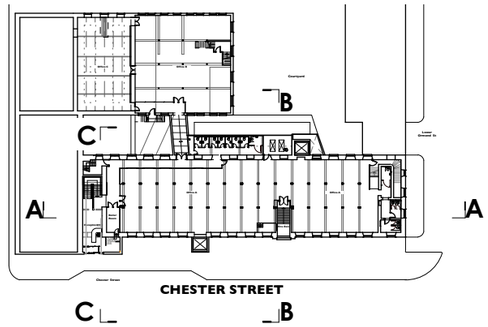


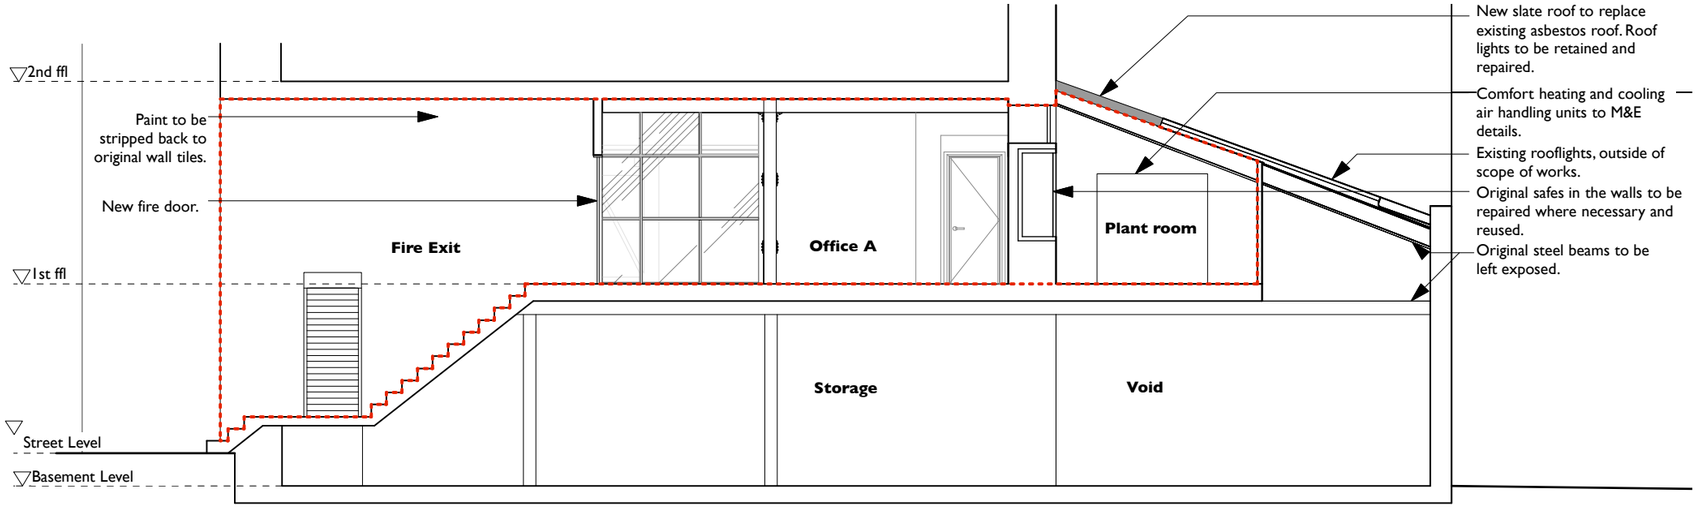

Section BB - scale 1:100

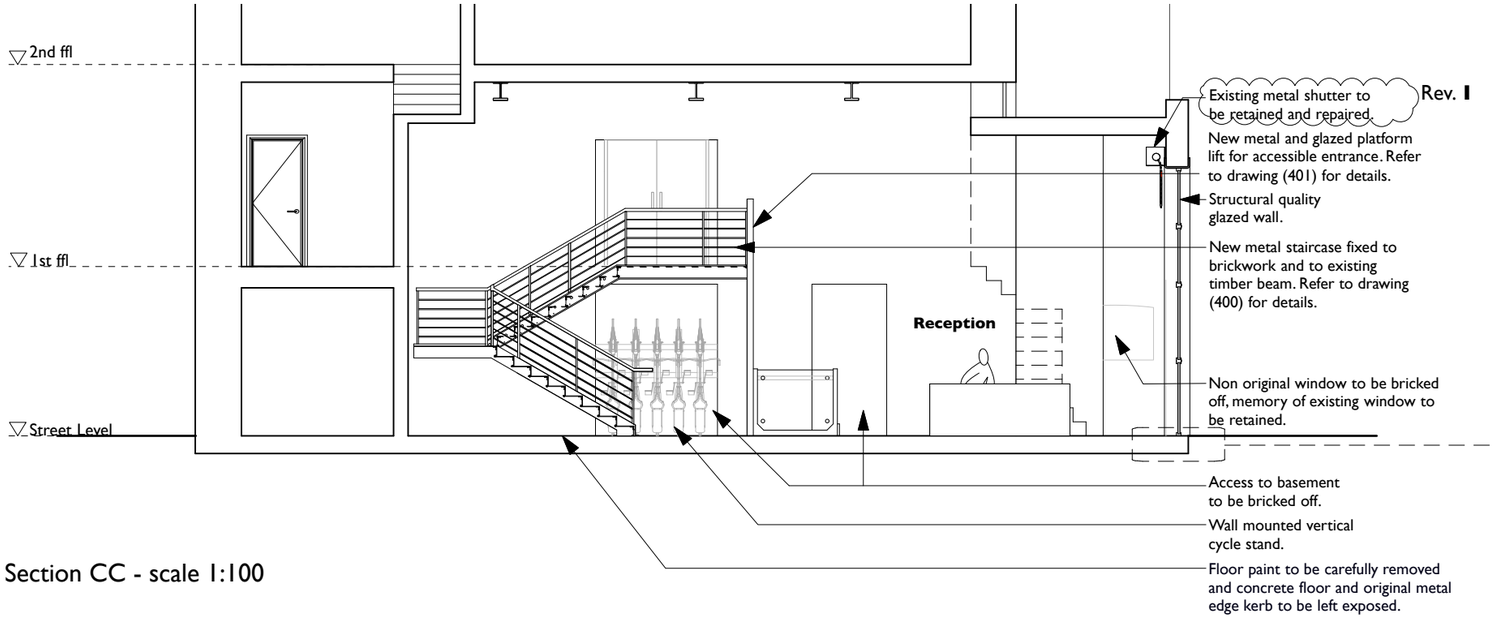

Section CC - scale 1:100

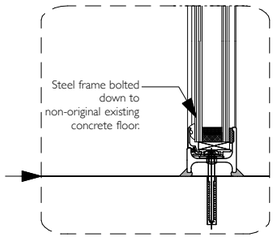

Steel frame detail.
Scale 1:5

Rev. 1

COPYRIGHT OF ATELIER MB LTD
DO NOT SCALE FROM THIS DRAWING
DIMENSIONSTO BE CHECKED ON SITE

Existing
Downstand beams
Extent of works
Proposed

Rev	Note	DRN	CHK
I 23.05.17	Draught lobby removed. Entrance glazing revised.	ZS	AB
H 28.02.17	Draught lobby details revised - overall depth reduced.	ZS	AB
G 24.02.17	Details through draught lobby added.	ZS	AB
F 21.02.17	Staircase in loading bay revised to allow for bike storage underneath.	ZS	RM
E 09.02.17	Staircase revised. Platform lift added. Section BB revised - existing roof lights in lean-to extension shown to be retained.	ZS	AB

D Sept 16	Annotations revised. Plant room roof updated.
C Sept 16	Drawing updated. Kitchenette replaced by a plant room.
B Sept 16	Annotations revised.
A Sept 16	Hatches added, annotations revised.

Chatham Mill
Manchester

Sections
Proposed

scheme 1624
drwg no. **P(300)**
rev I

scale 1:200@A3
date first drawn Apr 16
drawn ZS

SK sketch P proposed T tender C construction AB asbuilt

www.ateliermb.co.uk
t 0161 236 0051
e architect@ateliermb.co.uk

Atelier MB
Urban Architects