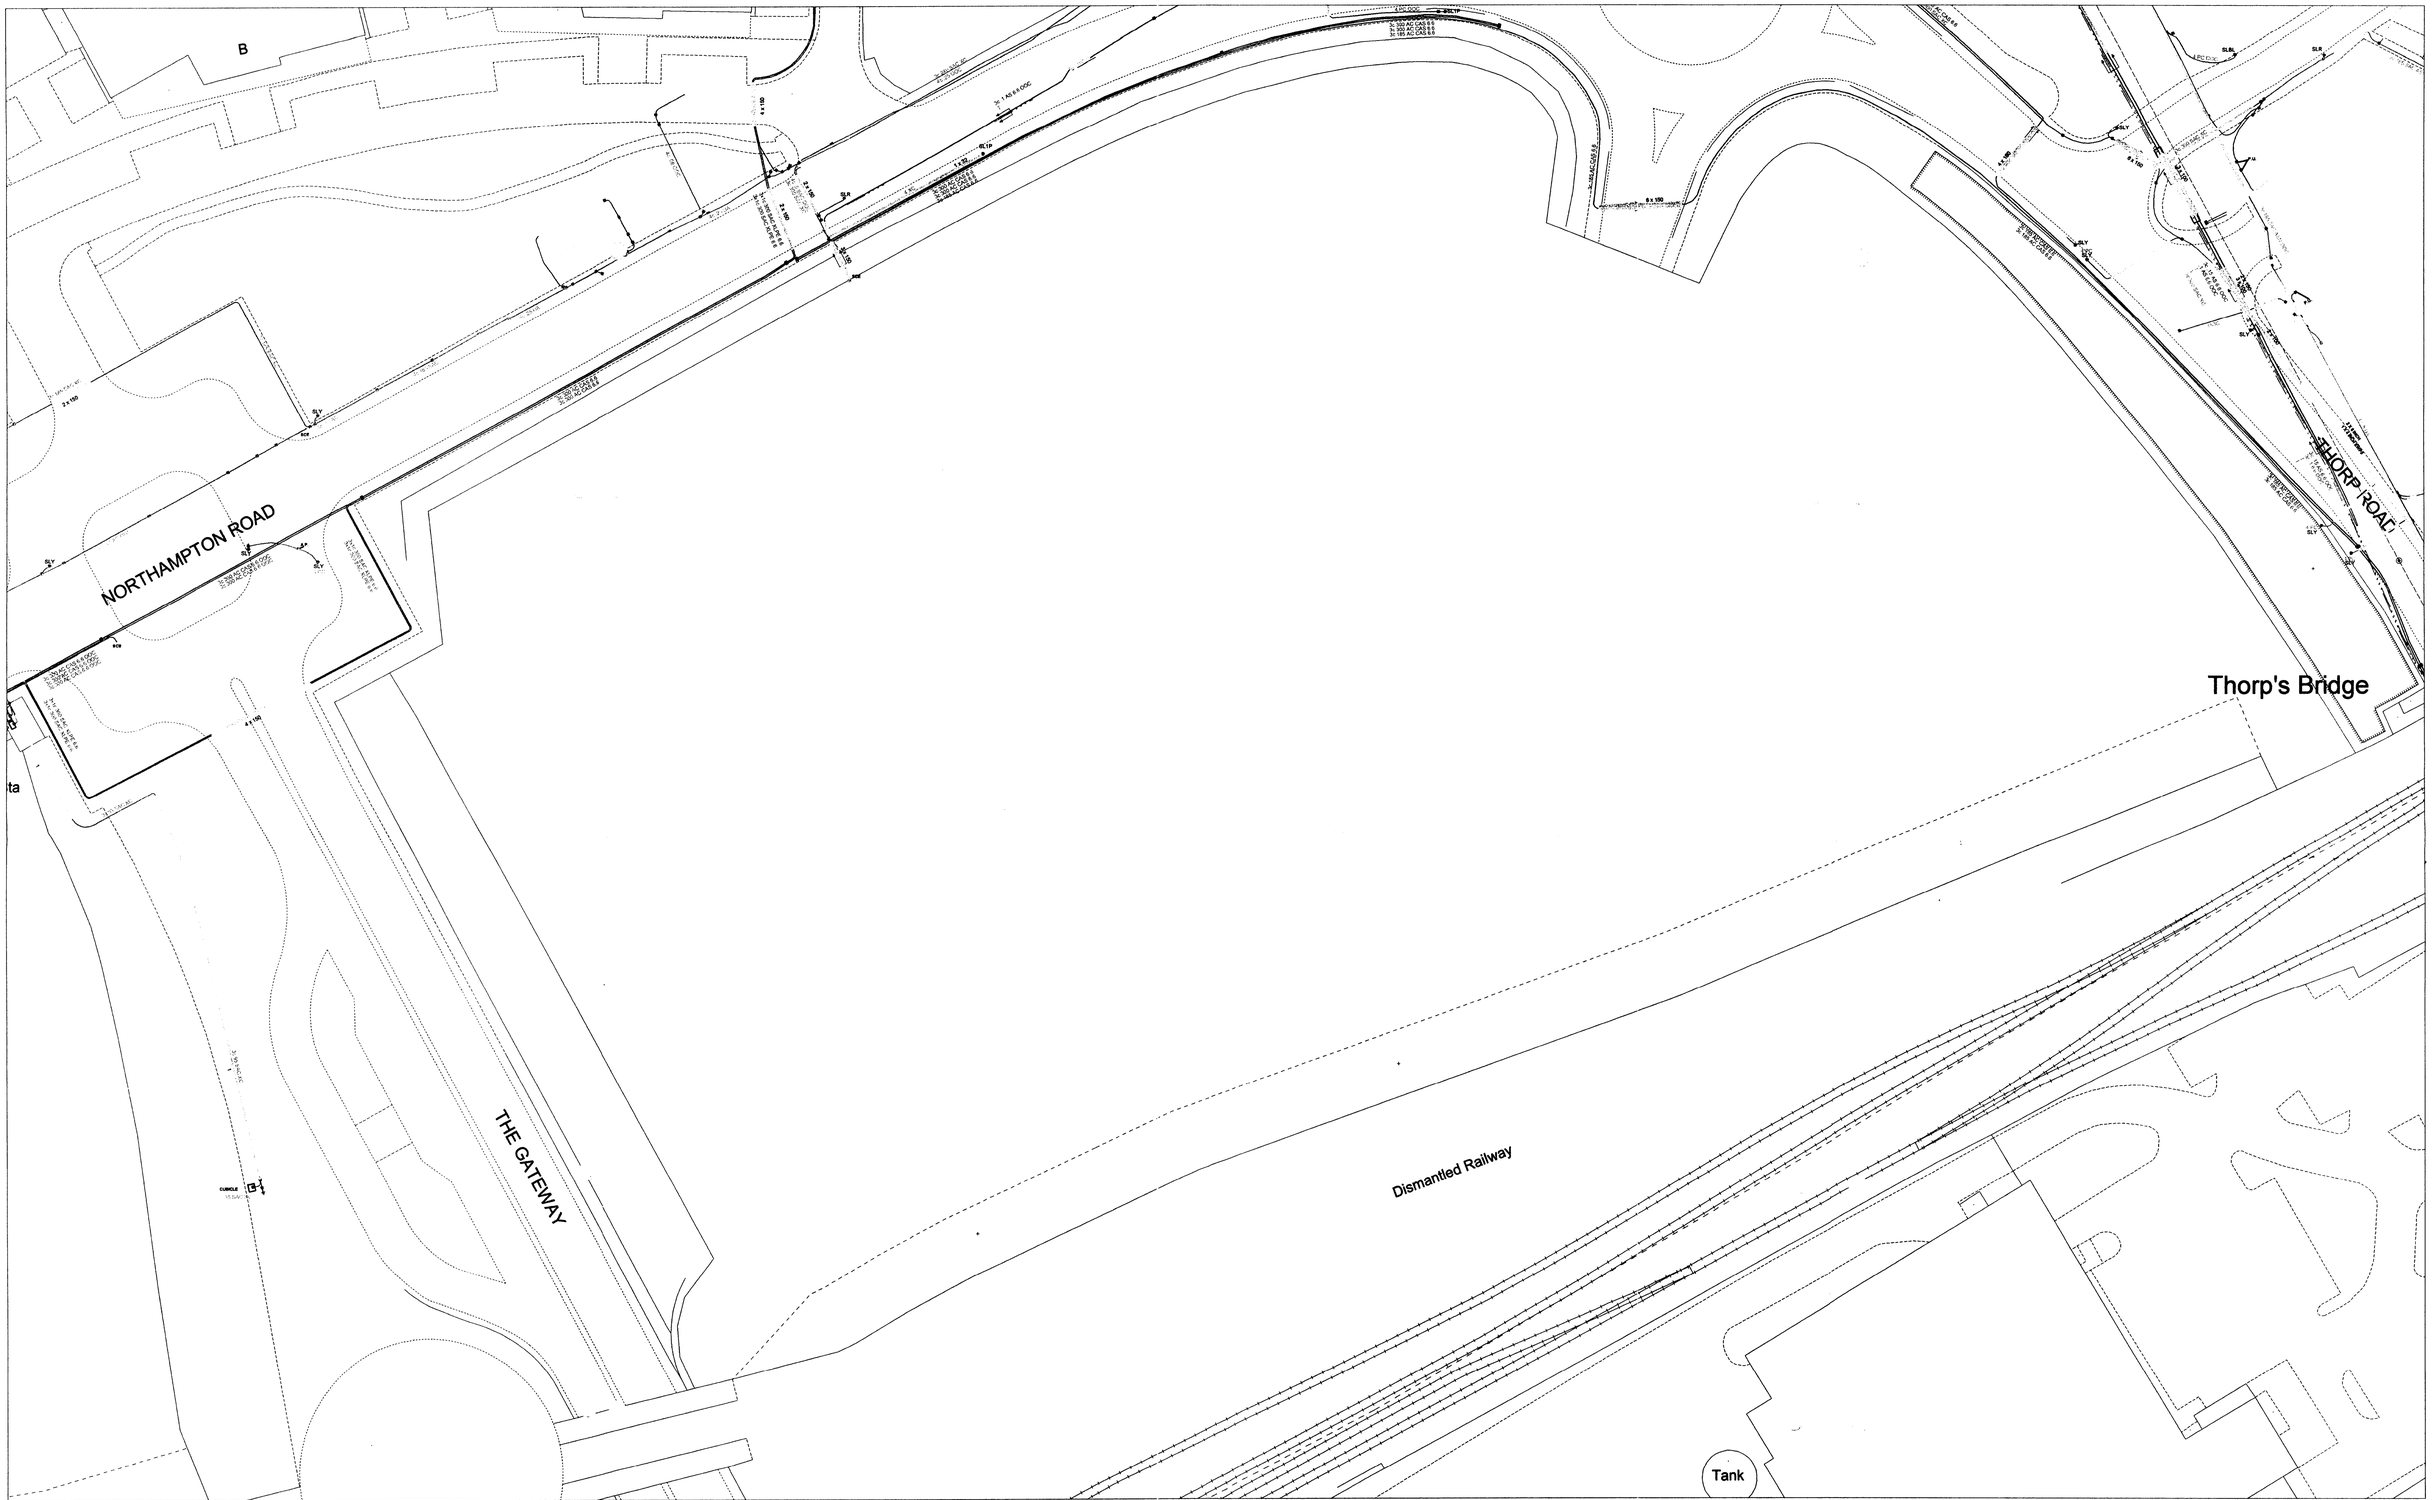


N
W E
S

Unless otherwise indicated the depth of UU Electricity plc cables are in accordance with NJUG (450mm for Low Voltage & 600mm for 11kV cables) 33kV and 132kV cables are laid at depths as marked. The depth and positions of UU Electricity plc equipment was accurate as shown when the equipment was installed. However third parties may have altered the level & other reference data. Therefore UU Electricity plc accept no responsibility for the position of UU Electricity plc equipment being different from shown. No person, body or company, shall be relieved from liability for damage caused to UU Electricity plc equipment by reason of being located differently to the indications on this drawing.
Service cables are not necessarily shown but must be assumed to exist to all premises, streetlights and signs.
There may be other UU Electricity plc apparatus in the vicinity which is not indicated on the cable records. Other apparatus may also be present which is owned by a third party other than UU Electricity plc.
CAUTION - THUS Fibre Optic cables may not be shown on this plan. Please contact THUS for further information.
Reproduced from or based upon Ordnance Survey's map with the permission of Her Majesty's Stationary Office. Crown Copyright Reserved. LICENCE No. NA273147. Unauthorised reproduction may lead to Prosecution or Civil Proceedings. Reference should be made to HSE Guidance, HS(G)47 "Avoiding Danger from Underground Services" and GS6 "Avoidance of Danger from Overhead Power Lines".
UU Registered Office: Haweswater House, Lingley Mere Business Park, Lingley Green Avenue, Great Sankey, Warrington, WA5 3LP Registered No. 2366678

Legend

Operating Voltage	Colour Code	Line Colour
132kV	Black	
33kV	Green	
22kV-25kV	Yellow	
11kV	Red	
6kV-6.6kV	Blue	
1kV-6kV	Violet	
LV	Orange	
Unknown Voltage	Brown	

Scale 1:500

Northampton Road, Manchester

Printed by: LE

Date: 10/09/2008

United Utilities

Electric Records