
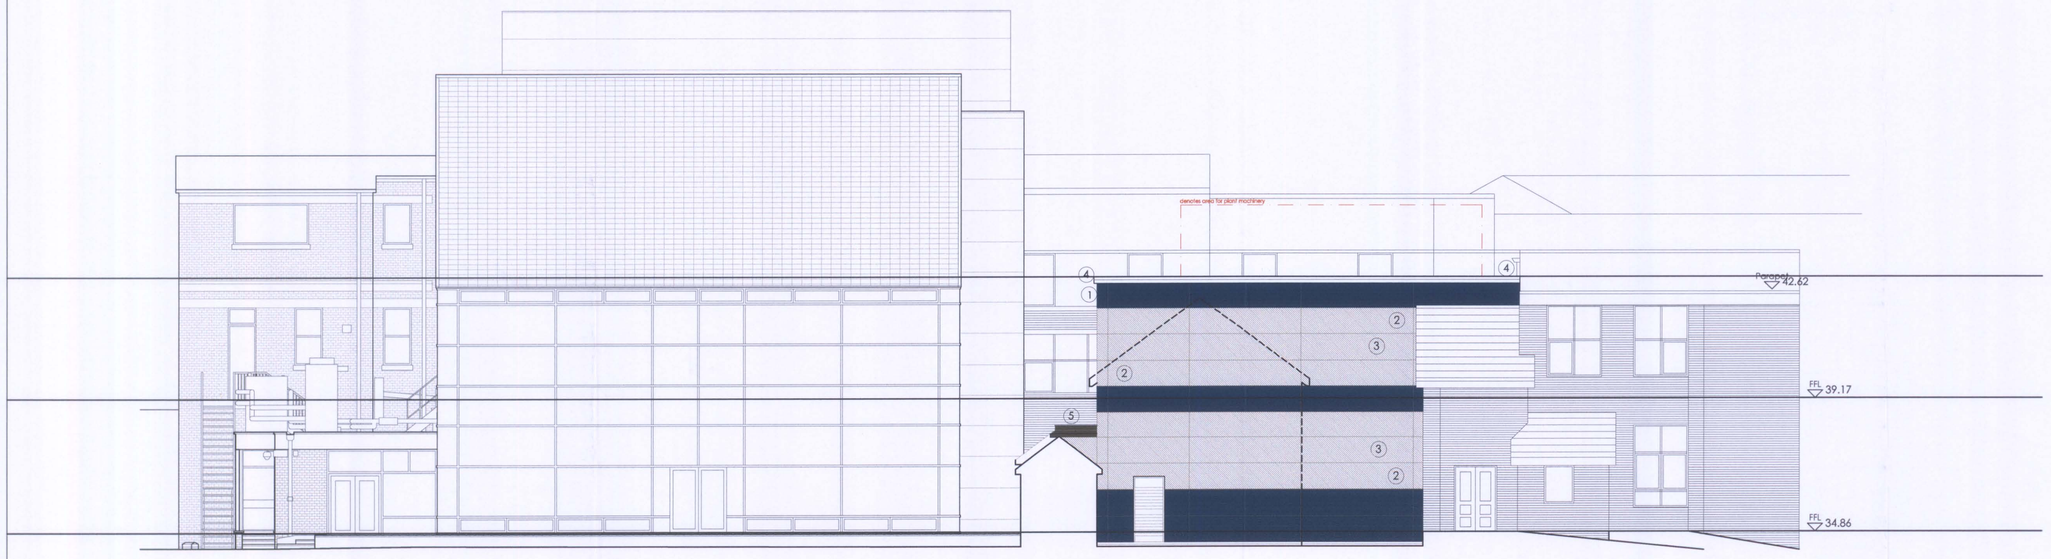


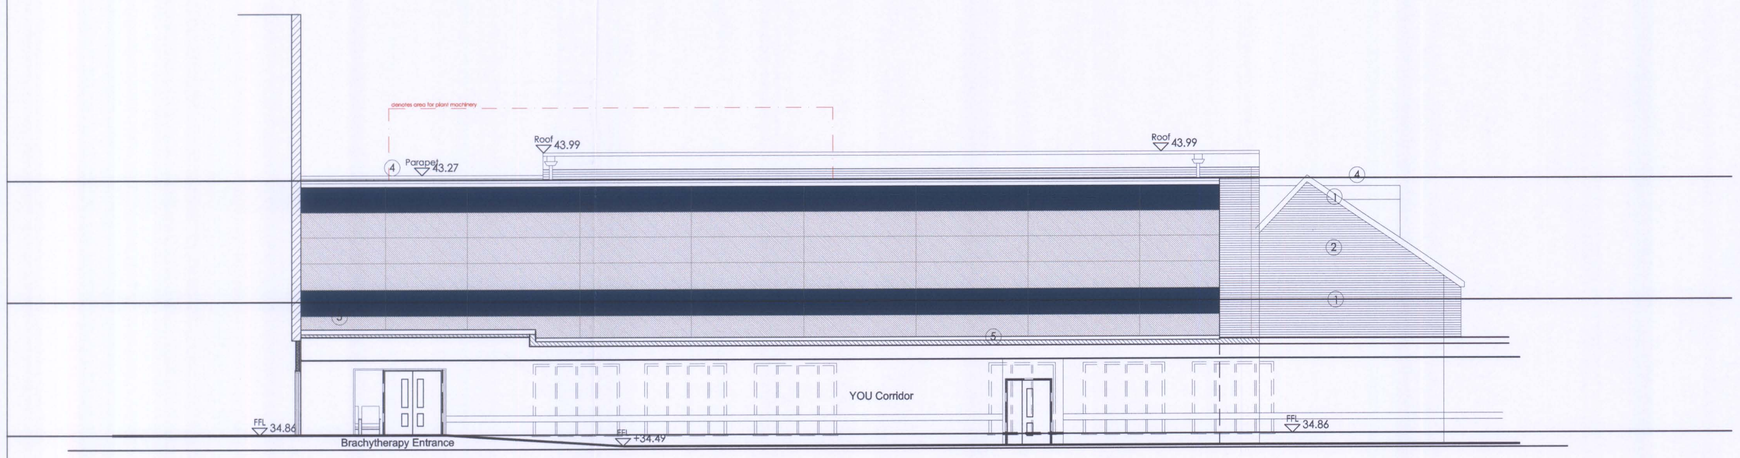

NOTES

ALL DIMENSIONS AND LEVELS ARE TO BE CHECKED ON SITE

ANY DISCREPANCIES ARE TO BE REPORTED TO THE ARCHITECT BEFORE ANY WORK COMMENCES

THIS DRAWING SHALL NOT BE SCALED TO ASCERTAIN ANY DIMENSIONS WORK TO FIGURED DIMS ONLY

THIS DRAWING SHALL NOT BE REPRODUCED WITHOUT EXPRESS WRITTEN PERMISSION FROM AFL LTD.

1. Kingspan Optimo KS1000MR horizontal laid cladding Opal KC 400 with SP10 coloured insert (Opal KC 400).
2. Kingspan Optimo KS1000MR horizontal laid cladding Silver 9006 SP10 coloured insert (Silver)
3. Lourved panel
4. Kingspan aluminium flashing
5. Liquid plastics low pitch Flat roof

rev	date/initls	description
P3	20.04.12 MP	Revised for GMP costing, cladding colours changed
P2	03.02.12 MP	Issued for Costing
P1	30.11.11 MP	Preliminary Issue

project
Brachytherapy Suite

location
Christie Hospital

employer

principal supply chain partner
Christie Hospital NHS Foundation Trust

Interserve Health
George Road, Erdington, Birmingham, B23 7RZ
Tel: 0121 344 4888 Fax: 0121 344 4801

AFL Architects
1st Floor
St Georges House
56 Peter Street
Manchester UK
M2 3NQ
t: +44(0)161 236 6263
f: +44(0)161 236 6484
w: www.afl-uk.com
e: mail@afl-uk.com
Liverpool office
t: +44(0)151 231 6200

AFL ARCHITECTS


key plan

drawing title
Proposed Elevations


dwg purpose
PRELIMINARY

scale	1:100	drawn MP	checked MP
@ sheet size	A1	rev date	23/04/12
103403 job number		AE-70-002 drawing number	P3 revision

PLANNING AND BUILDING CONTROL 17 SEP 2013

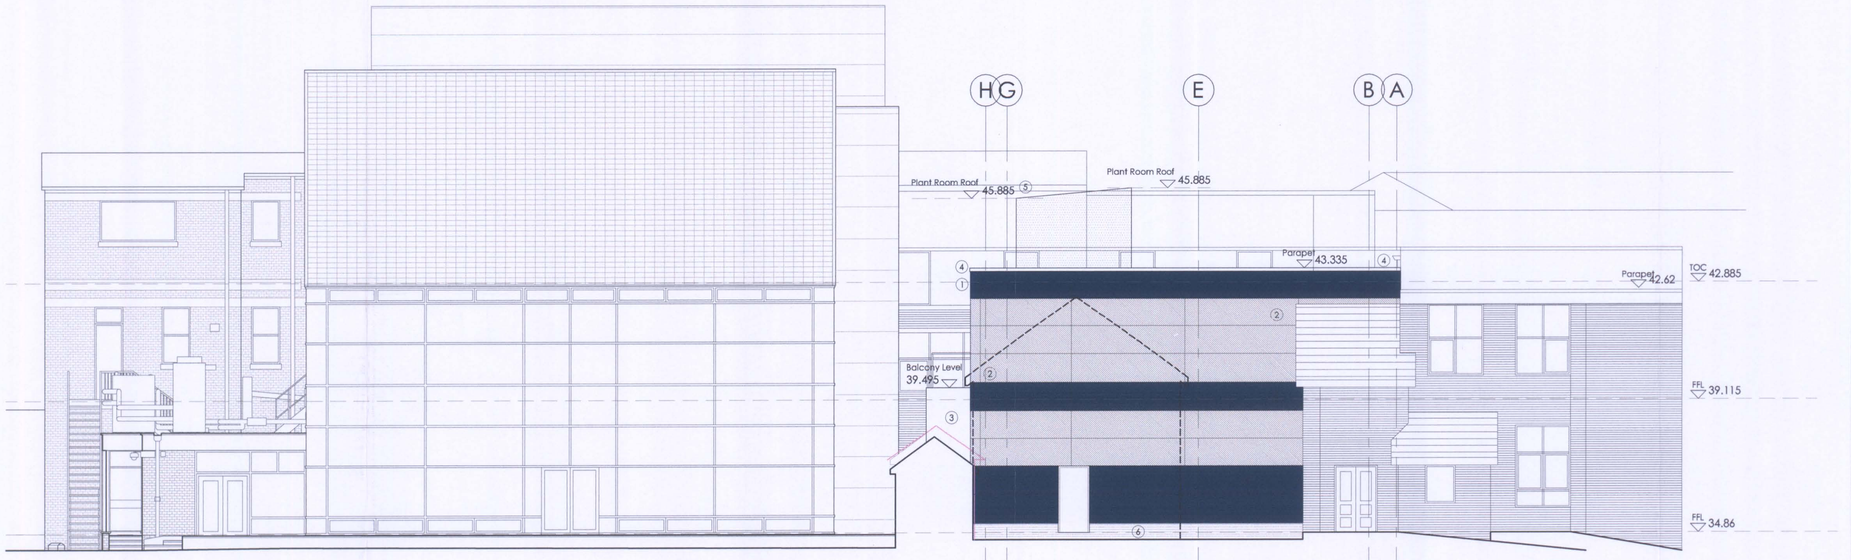

Proposed South Elevation

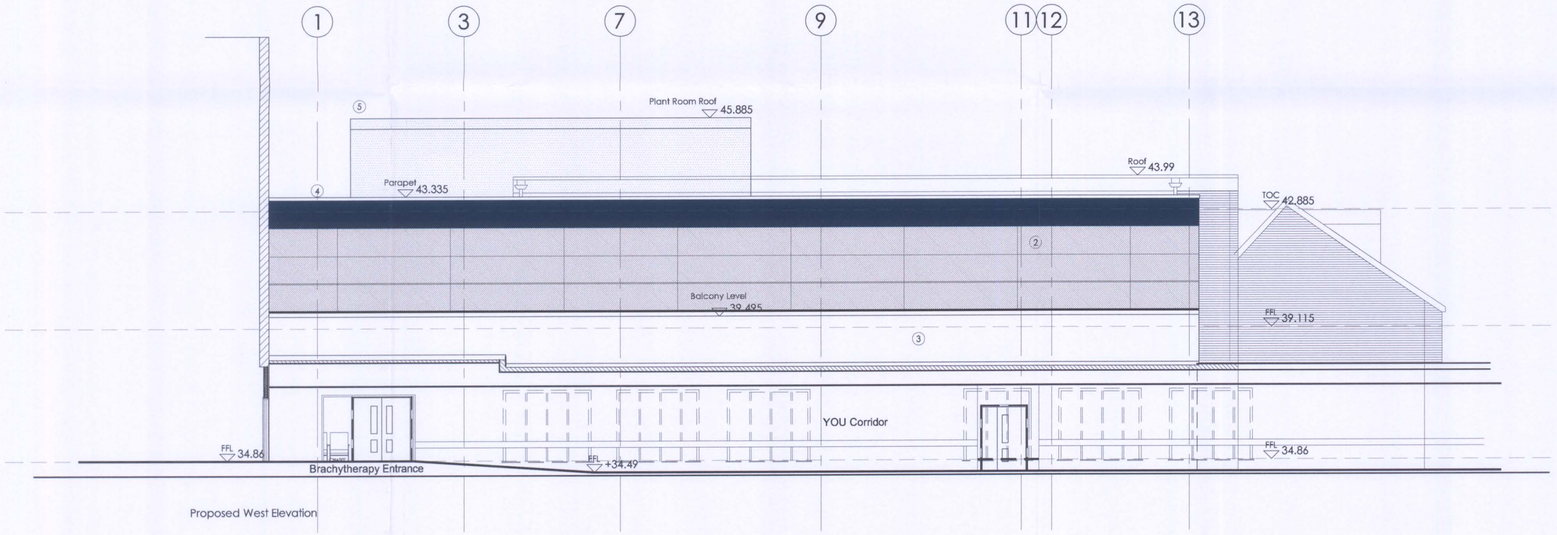

Proposed West Elevation

NOTES

ALL DIMENSIONS AND LEVELS ARE TO BE CHECKED ON SITE

ANY DISCREPANCIES ARE TO BE REPORTED TO THE ARCHITECT BEFORE ANY WORK COMMENCES

THIS DRAWING SHALL NOT BE SCALED TO ASCERTAIN ANY DIMENSIONS WORK TO FIGURED DIMS ONLY

THIS DRAWING SHALL NOT BE REPRODUCED WITHOUT EXPRESS WRITTEN PERMISSION FROM AFL LTD.

1. Kingspan Optimo KS1000MR horizontal laid cladding Opal KC 400 with SP10 coloured insert (Opal KC 400)
2. Kingspan Optimo KS1000MR horizontal laid cladding Silver 9006 SP10 coloured insert (Silver)
3. Liquid plastics low pitch flat roof
4. Kingspan aluminum flashing Colour: RAL 9006
5. Micro-rib panel Colour: RAL 9006
6. IBSTOCK Staffordshire Blue Brindle Smooth

rev	date/init	description
C6	03/06/2013 AJS	As Built
C5	08.05.13 AJS	Plant room updated to co-ordinate with PPS construction set of drawings. Brickwork spec added to key.
C4	20.02.13 AJS	Elevations revised and co-ordinated with plans & sections
C3	26.09.12 DM	Plant room updated.
C2	23.08.12 AJS	GL added as requested by BDP.
C1	27.07.12 MH	Issued for construction
P3	20.04.12 MP	Revised for GMP costing, cladding colours changed
P2	03.02.12 MP	Issued for Costing
P1	15-11-11 MP	Preliminary Issue

PLANNING AND BUILDING CONTROL
17 SEP 2013

project
Brachytherapy Suite

location
Christie Hospital

employer

principal supply chain partner
Christie Hospital NHS Foundation Trust

Interserve Health
George Road, Erdington, Birmingham, B23 7RZ
Tel. 0121 344 4888 Fax: 0121 344 4801

AFL Architects
1st Floor
St Georges House
56 Peter Street
Manchester UK
M2 3NQ
t: +44(0)161 236 6263
f: +44(0)161 236 6484
w: www.afl-uk.com
e: mail@afl-uk.com
Liverpool office
t: +44(0)151 231 6200

AFL ARCHITECTS

key plan

drawing title
Proposed Elevations

dwg purpose
AS BUILT

scale	1:100	drawn AS	checked AS
@ sheet size	A1	rev date	03/06/13
103403 job number		AE-70-002 drawing number	C6 revision